


RECEIVED

FEB 20 2020

OWRD

T.4S., R.4W., W.M.

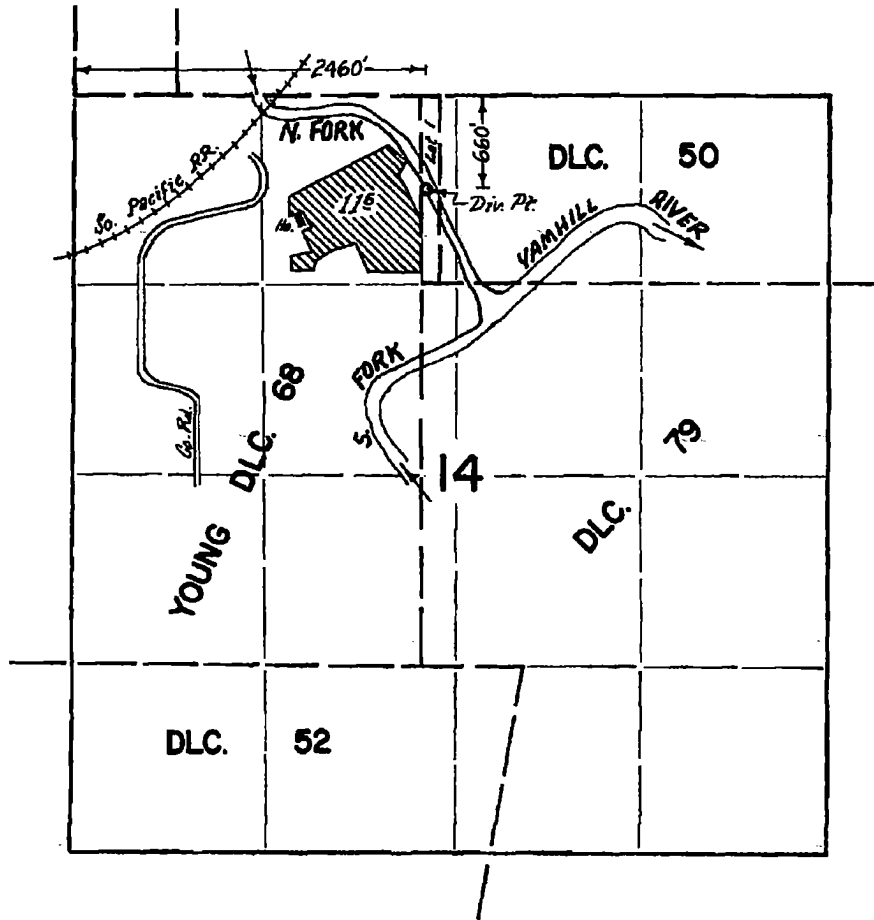

FINAL PROOF SURVEY
UNDER

Application No. 44970 Permit No. 33613
IN NAME OF

CHESTER J. GIBSON

Surveyed 15 Nov. 1972, by D. Norrey

RECEIVED

FEB 20 2020

OWRD

J YOUNG
DLC 68

