



Oregon Water Resources Department
 725 Summer Street NE, Suite A
 Salem, Oregon 97301
 (503) 986-0900
 www.wrd.state.or.us

Request for Assignment

RECEIVED
 JUL 13 2020

OWRD

If the Department determines that the application is incomplete, fees have not been paid, or the required documents are not acceptable, the application and all fees submitted will be returned to the applicant.

If for multiple rights, a separate form and fee for each right will be required.

I, SEVEN HILLS PROPERTIES, LLC
 (Name of Current Holder of Record)
52108 SEVEN HILLS RD MILTON-FREEWATER, OR 97862 541.758.0141
 (Mailing Address) (City) (State) (Zip) (Phone #)

- hereby assign all my interest in and to the entire application/permit/transfer/limited license/groundwater statement; (example, sold all the land authorized under the right)
- hereby assign all my interest in and to a portion of application/permit/transfer/limited license/groundwater statement; (You must include a map showing the portion of the application/permit/transfer order/limited license/groundwater statement to be assigned. Example, sold a portion of the land authorized under the right)
- hereby assign a portion of my interest in and to the entire application/permit/transfer/limited license/groundwater statement; (example, adding an additional person)

 Limited License # _____ ; Groundwater Statement # _____ ;

as filed in the office of the Water Resources Director, to:

 (Name of New Owner)
52108 SEVEN HILLS RD. MILTON-FREEWATER OR 97862 541.938.8941
 (Mailing Address) (City) (State) (Zip) (Phone #)

Note: If there are other owners of the property described in the application, permit, transfer order, limited license, or groundwater statement, you must provide a list of all other owners' names and mailing addresses and attach it to this form. Write the initials (first letters) of your first and last names at the spot indicated below _____.

NM I hereby certify that I have notified all other owners of the property described in this application, permit, transfer order, limited license, or groundwater statement of this Request of Assignment.

Witness my hand this 7th day of July, 2020.
 (Day) (Month) (Year)

Signature of Current Holder of Record Norman McLibben, PepperIDGE Land CO.

Failure to provide any of the required information will result in the return of your application.

This certifies assignment and record change at Oregon Water Resources Department effective 8:00 a.m. on date of receipt at Salem, Oregon.
 Fee receipt # 133038
 For Director by Mary F. Bjork, Program Analyst in Water Rights Division. MFB

The completed "Request for Assignment" form *must* be submitted to the Department along with the recording fee of \$100.

Part: Assign - Approve
 MFB 8-11-2020



Oregon Water Resources Department
 725 Summer Street NE, Suite A
 Salem, Oregon 97301
 (503) 986-0900
 www.wrd.state.or.us

Request for Assignment

RECEIVED

JUL 13 2020

OWRD

If the Department determines that the application is incomplete, fees have not been paid, or the required documents are not acceptable, the application and all fees submitted will be returned to the applicant.

If for multiple rights, a separate form and fee for each right will be required.

I, SEVEN HILLS PROPERTIES, LLC
 (Name of Current Holder of Record)

52108 SEVEN HILLS RD MILTON-FREEWATER, OR 97862 541.938.8941
 (Mailing Address) (City) (State) (Zip) (Phone #)

- hereby assign all my interest in and to the entire application/permit/transfer/limited license/groundwater statement; (example, sold all the land authorized under the right)
- hereby assign all my interest in and to a portion of application/permit/transfer/limited license/groundwater statement; (You must include a map showing the portion of the application/permit/transfer order/limited license/groundwater statement to be assigned. Example, sold a portion of the land authorized under the right)
- hereby assign a portion of my interest in and to the entire application/permit/transfer/limited license/groundwater statement; (example, adding an additional person)

Application # _____; Permit # _____; Transfer # 12234;

Limited License # _____; Groundwater Statement # _____;

as filed in the office of the Water Resources Director, to:

WALLA WALLA VALLEY APPELLATION, LLC
 (Name of New Owner)

52108 SEVEN HILLS RD, MILTON-FREEWATER OR 97862 541.938.8941
 (Mailing Address) (City) (State) (Zip) (Phone #)

Note: If there are other owners of the property described in the application, permit, transfer order, limited license, or groundwater statement, you must provide a list of all other owners' names and mailing addresses and attach it to this form. Write the initials (first letters) of your first and last names at the spot indicated below _____.

_____ I hereby certify that I have notified all other owners of the property described in this application, permit, transfer order, limited license, or groundwater statement of this Request of Assignment.

Witness my hand this _____ day of _____, 20_____.
 (Day) (Month) (Year)

Signature of Current Holder of Record _____


Failure to provide any of the required information will result in the return of your application.


DO NOT WRITE IN THIS BOX



The completed "Request for Assignment" form *must* be submitted to the Department along with the recording fee of \$100.

RECEIVED
JUL 13 2020
OWRD

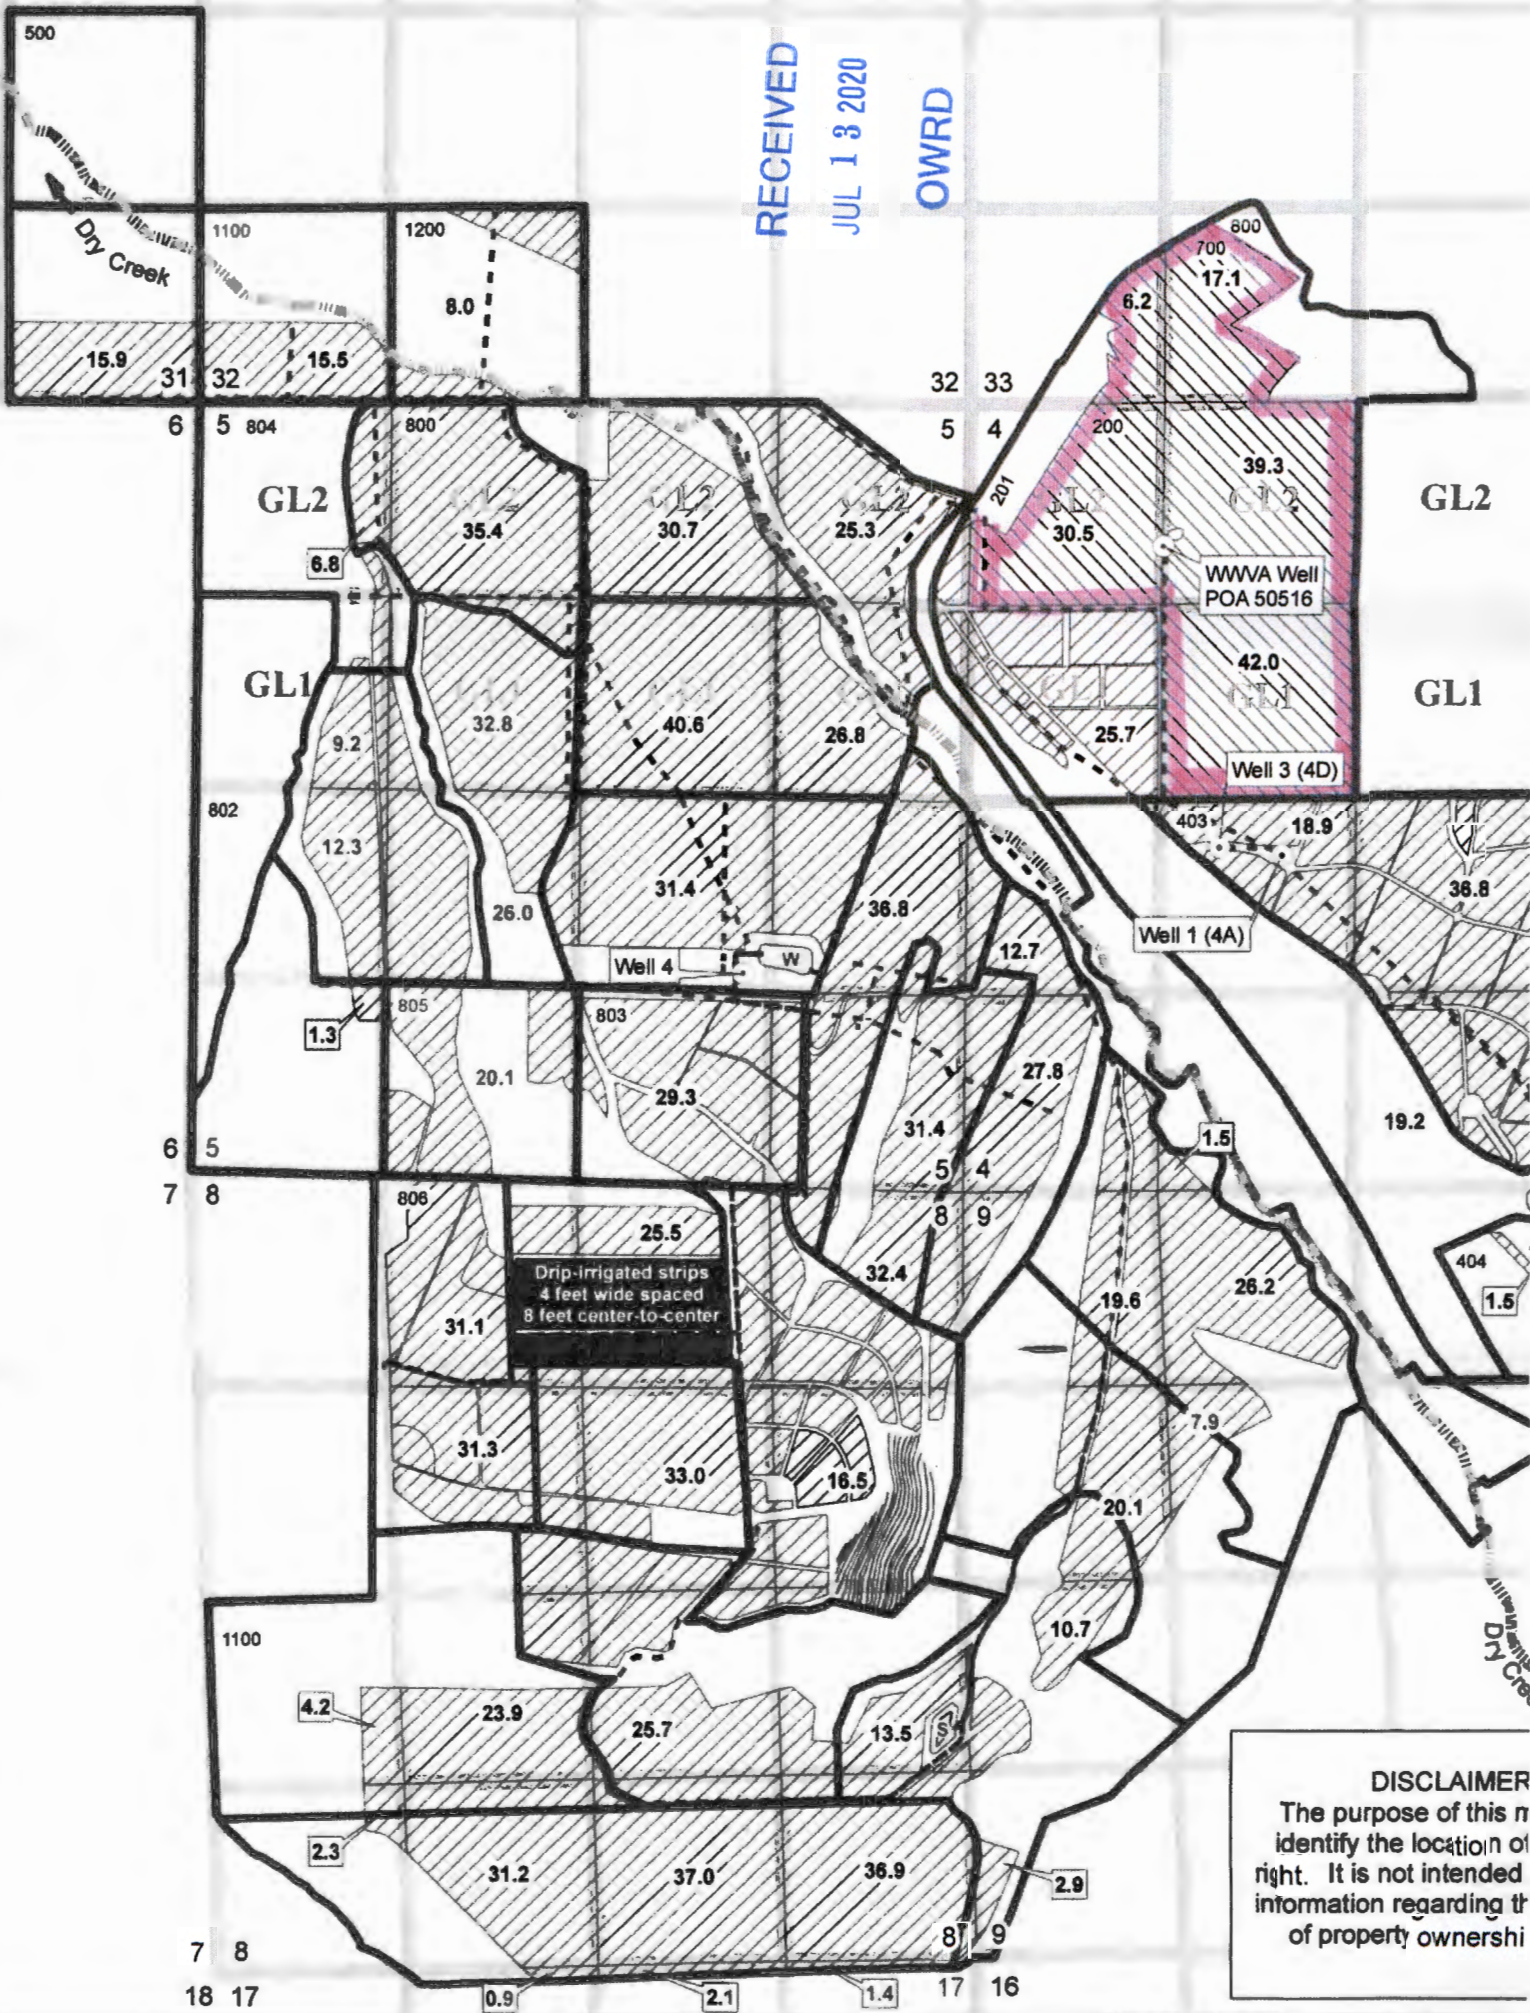

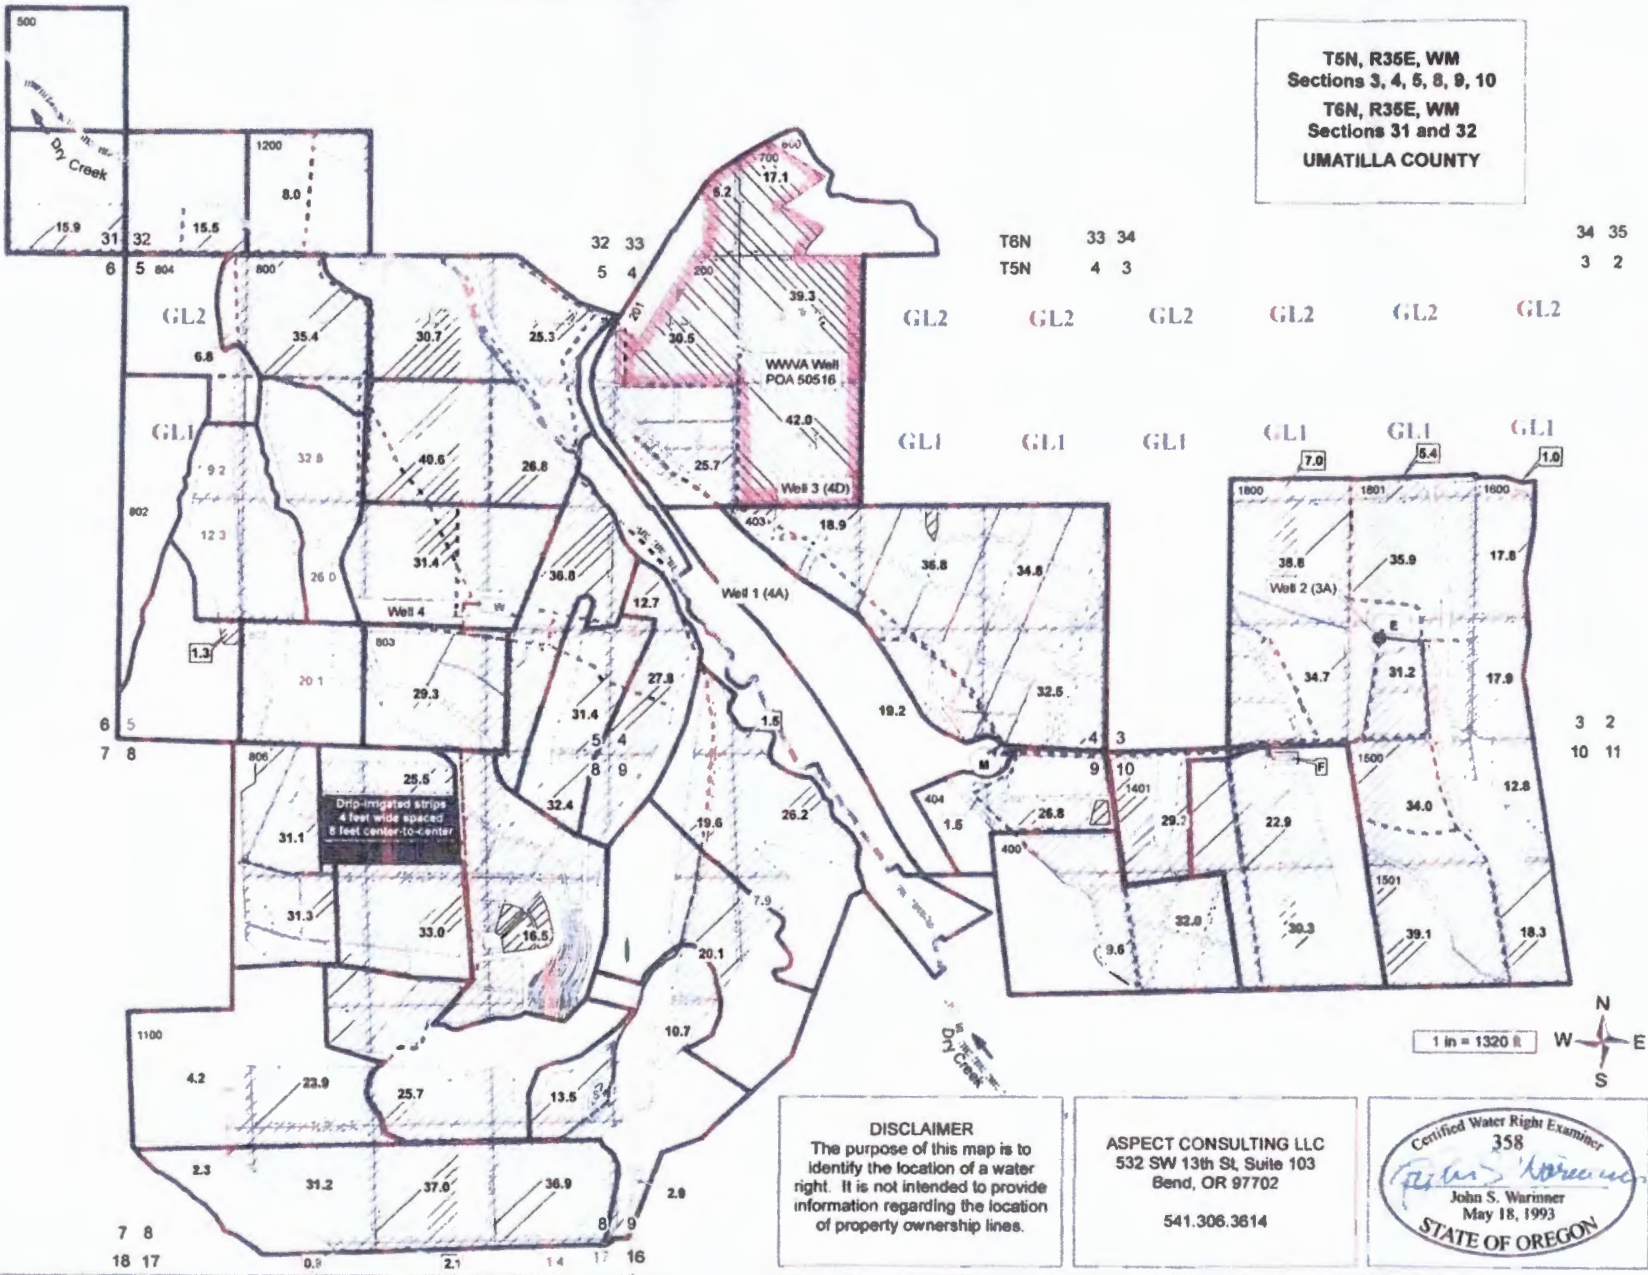

Sections 3, 4, 5, 8, 9, 10
T6N, R35E, WM
Sections 31 and 32
UMATILLA COUNTY**

Place of Use (Cert 86441)

Water used for Primary Irrigation of 1526.0 acres previously authorized by Cert 86441

Place of Use (Cert 86639)

Water used for Supplemental Irrigation of 1526.0 acres previously authorized by Cert 86639

Points of Appropriation

SeVen Well 1 (POA 4A) 415 ft S and 600 ft W from Center of Section 4. Flowmeter in same location. Well Log UMAT 55523

SeVen Well 3 (POA 4D) 375 ft S and 940 ft W from Center of Section 4. Flowmeter in same location. Well Log UMAT 56382

SeVen Well 4 (West Pond Well) 1300 ft N and 1575 ft W from SE Corner of Section 5. Flowmeter in same location. Well Log UMAT 57714

WWVA Well 1 (POA 50516) 930 ft S and 1385 ft E from NW Corner of Section 4. Flowmeter in same location. Well Log UMAT 50516

POA Excluded

SeVen Well 2 (POA 3A) 1156 ft N and 314 ft E from S/4 Corner of Section 3. Flowmeter in same location. Well Log UMAT 55526. Use of this well is now authorized by Certificate 93971

Conveyance

Water distributed in buried pressure pipeline ranging in size from 6 to 15 inches in diameter.

RECEIVED

JUL 13 2020

OWRD

ASSIGNMENT MAP

DISCLAIMER
The purpose of this map is to identify the location of a water right. It is not intended to provide information regarding the location of property ownership lines.

ASPECT CONSULTING LLC
532 SW 13th St Suite 103
Bend, OR 97702
541.306.3614

Certified Water Right Examiner
358
John S. Warriner
John S. Warriner
May 18, 1993
STATE OF OREGON

CLAIM OF BENEFICIAL USE MAP
Transfer 12234
In the name of
SEVEN HILLS PROPERTIES, LLC
Revised: 2020-03-26