



Oregon Water Resources Department
 725 Summer Street NE, Suite A
 Salem, Oregon 97301-1266
 (503) 986-0900
 www.wrd.state.or.us

District Permanent Water Right Transfer Claim of Beneficial Use

1. APPLICANT INFORMATION

District: Santiam Water Control District
 Contact Person: Brent Stevenson Phone: 503-769-2669
 Mailing Address: 284 East Water St
 City: Stayton State: OR Zip: 97383
 E-Mail address: brents.swcd@wvi.com
 Transfer Number: T - 10670

2. WATER RIGHT(S)

Pursuant to OAR Chapter 690, Division 385, the district is submitting to the Water Resources Department this claim of beneficial use, with the appropriate fee, for the following water right(s):

PERMIT NUMBER	CERTIFICATE NUMBER	DECREE (name, volume, and page)	PRIMARY (P) OR SUPP (S)
-	68662		<input checked="" type="checkbox"/> P <input type="checkbox"/> S
-	68663		<input checked="" type="checkbox"/> P <input type="checkbox"/> S
-	68668		<input checked="" type="checkbox"/> P <input type="checkbox"/> S
-			<input type="checkbox"/> P <input type="checkbox"/> S

3. AUTHORIZED POINT(S) OF DIVERSION (POD) / APPROPRIATION (POA)


The authorized point(s) of diversion / appropriation for the water right modified by the transfer are as follows:

PERMIT NUMBER	DECREE or CERTIFICATE	POD / POA #	SOURCE	LOCATION - MEASURED DISTANCES
-	68662		NS River	1800 Feet South + 2830 Feet East From the 1/4 Corner Section 11
-	68663		NS River	"
-	68668		NS River	"
-				

RECEIVED BY OWRD

6. SIGNATURES

The district certifies that it has inspected the place of use listed in Table I, and confirms the change in place of use has been completed consistent with the terms and conditions of the final order approving the transfer.

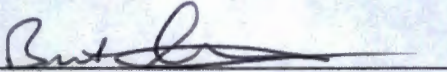

Signature of District Manager
or District Board Chairperson

6-17-15

Date

Brent Stevenson

Type or Print Name of District Manager
or District Board Chairperson

RECEIVED BY OWRD

JUN 23 2015

SALEM, OR

**CLAIM OF BENEFICIAL USE
Site Report**

Transfer Number: T - 10670 District Internal Notice #: _____

User Name: Santiam Golf Course Inc

Place of Use:

USE	POD #	TWP	RNG	SEC	QQ	DLC	GOV'T LOT	TAX LOT	ACRES
<u>I</u>		<u>9S</u>	<u>1W</u>	<u>4</u>	<u>NONE</u>	<u>47</u>		<u>800</u>	<u>9.3</u>
<u>I</u>		<u>8S</u>	<u>1W</u>	<u>33</u>	<u>SESW</u>	<u>63</u>		<u>800</u>	<u>3.0</u>

District Conveyance System:

Description of Delivery System: pump on Salem ditch to
golf course irrigation pond - distribution sprinklers

Headgate: Salem ditch Canal: Salem ditch

Beneficial Use:

Description of Beneficial Use: Irrigation

Method Used to Apply Water: temp sprinkler

Method Used to Calculate Beneficial Use: user interview, ditch
calculation @ 29 cfs 1' freeboard, gaging station
& billing records for Salem ditch

User Interviewed: Yes No Larry Trossi

Beneficial Use Made as Authorized: Yes No

Description of Beneficial Use if Less than Authorized:

RECEIVED BY OWRD

JUN 23 2015

SALEM, OR

Inspected By: 

Date: 6-11-15

Instructions: Attach and label the corresponding final proof map.

CLAIM OF BENEFICIAL USE Site Report

Transfer Number: T - 10670 District Internal Notice #: _____

User Name: Santiam Golf Course Inc

Place of Use:

USE	POD #	TWP	RNG	SEC	QQ	DLC	GOV'T LOT	TAX LOT	ACRES
I		85	1W	33	SWSE	63		800	5.5
		85	1W	33	SESW	60		800	.2

District Conveyance System:

Description of Delivery System: See attached sheet (continuation)

Headgate: _____ Canal: _____

Beneficial Use:

Description of Beneficial Use: _____

Method Used to Apply Water: _____

Method Used to Calculate Beneficial Use: _____

RECEIVED BY OWRD

User Interviewed: () Yes () No

JUN 23 2015

Beneficial Use Made as Authorized: () Yes () No

SALEM, OR


Description of Beneficial Use if Less than Authorized:

Inspected By: [Signature]


Date: 6-11-15

Instructions: Attach and label the corresponding final proof map.


LEGEND.

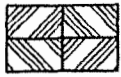

TO LANDS FOR
CERTIFICATE #68668
(0.2 AC)

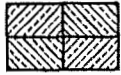

TO LANDS FOR
CERTIFICATE #68662
(1.9 AC)

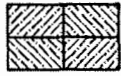

TO LANDS FOR
CERTIFICATE #68663
(15.9 AC)

T8S. R1W., W.M.

SW 1/4 SE 1/4
SE 1/4 SW 1/4
SECTION 33


T9S. R1W., W.M.

NE 1/4 NW 1/4 SECTION 4

Santiam Golf Club
8725 GOLF CLUB RD. SE
AUMSVILLE, OR. 97325



SCALE: 1"=400'

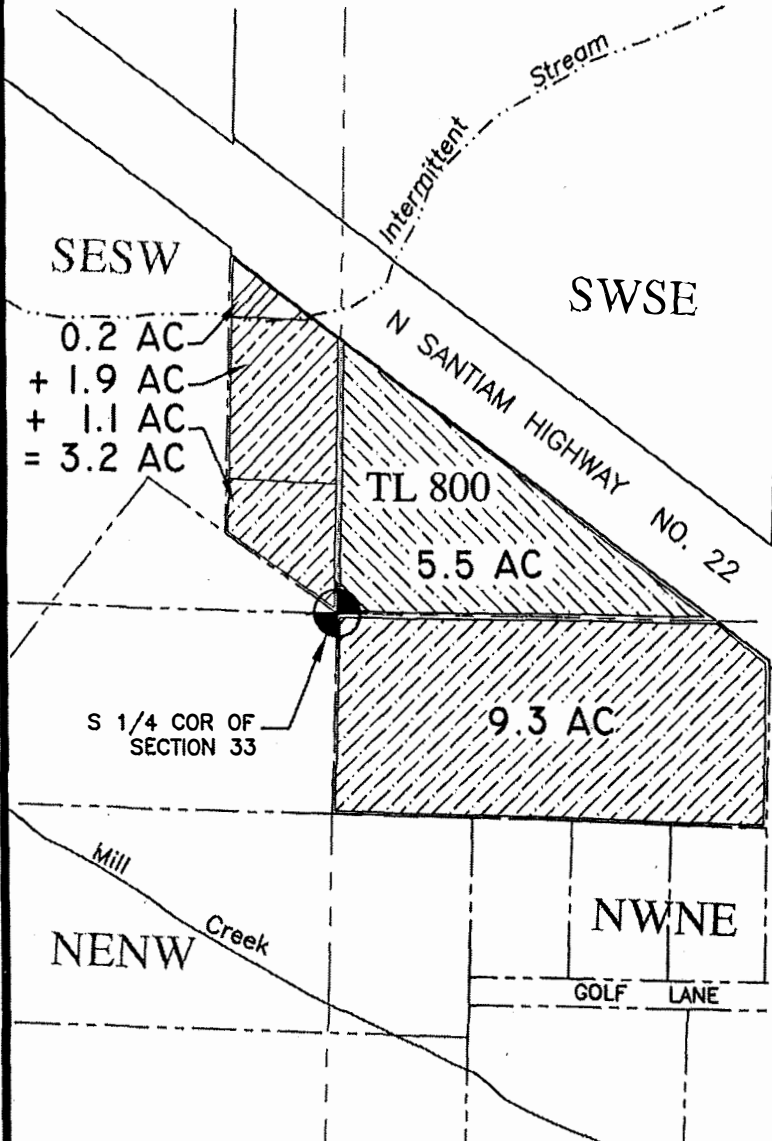


Certified Water Right Examiner
#372 WPR
John E. Borden
John E. Borden
May 11, 1994
STATE OF OREGON
Expires 12/31/2009

TOWNSHIP 8S
TOWNSHIP 9S

T9S. R1W., W.M.

SCALE: 1"=1320'

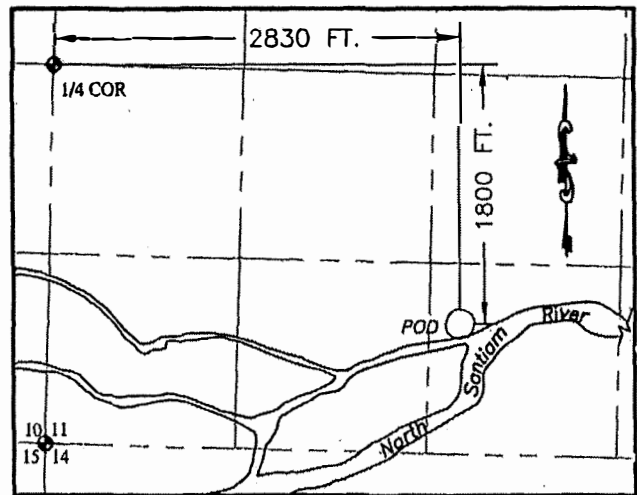

**TRANSFER "TO"
WATER RIGHTS**

WATER PURVEYOR:
SANTIAM WATER CONTROL
DISTRICT

SANTIAM WATER
CONTROL DISTRICT

284 E. WATER ST.
STAYTON, OR. 97383
503-769-2669

TRANSFER APPLICATION MAP

FILE PATH & NAME: F_HART_CO_MAR_STENDEL_TO_SANTIAMGOLF_011309.dwg

**CLAIM OF BENEFICIAL USE
Site Report**

JUN 23 2015

SALEM, OR

Transfer Number: T - 10670 District Internal Notice #: _____User Name: Stephen & Patricia Smith**Place of Use:**

USE	POD #	TWP	RNG	SEC	QQ	DLC	GOV'T LOT	TAX LOT	ACRES
<u>I</u>		<u>9S</u>	<u>2W</u>	<u>3</u>	<u>NW/4</u>	<u>64</u>		<u>800</u>	<u>4.8</u>

District Conveyance System:Description of Delivery System: Stayton / Power Canal diversion pointHeadgate: _____ Canal: Gilbert lateral**Beneficial Use:**Description of Beneficial Use: Hay & pasture irrigationMethod Used to Apply Water: pump + hand lines, some solid setMethod Used to Calculate Beneficial Use: lateral measurement +personal observation of useUser Interviewed: Yes NoBeneficial Use Made as Authorized: Yes No

Description of Beneficial Use if Less than Authorized:

Inspected By: [Signature] Date: 6-17-15**Instructions:** Attach and label the corresponding final proof map.

T9S. R2W., W.M.

Stephen Smith
NW 1/4 NW 1/4 SECTION 3
6806 LITTLE RD SE
TURNER, OR. 97392

RECEIVED BY OWRD

JUN 23 2015

SALEM, OR



SCALE: 1"=400'


LEGEND



"TO" LANDS FOR
CERTIFICATE #54302



"TO" LANDS FOR
CERTIFICATE #68665

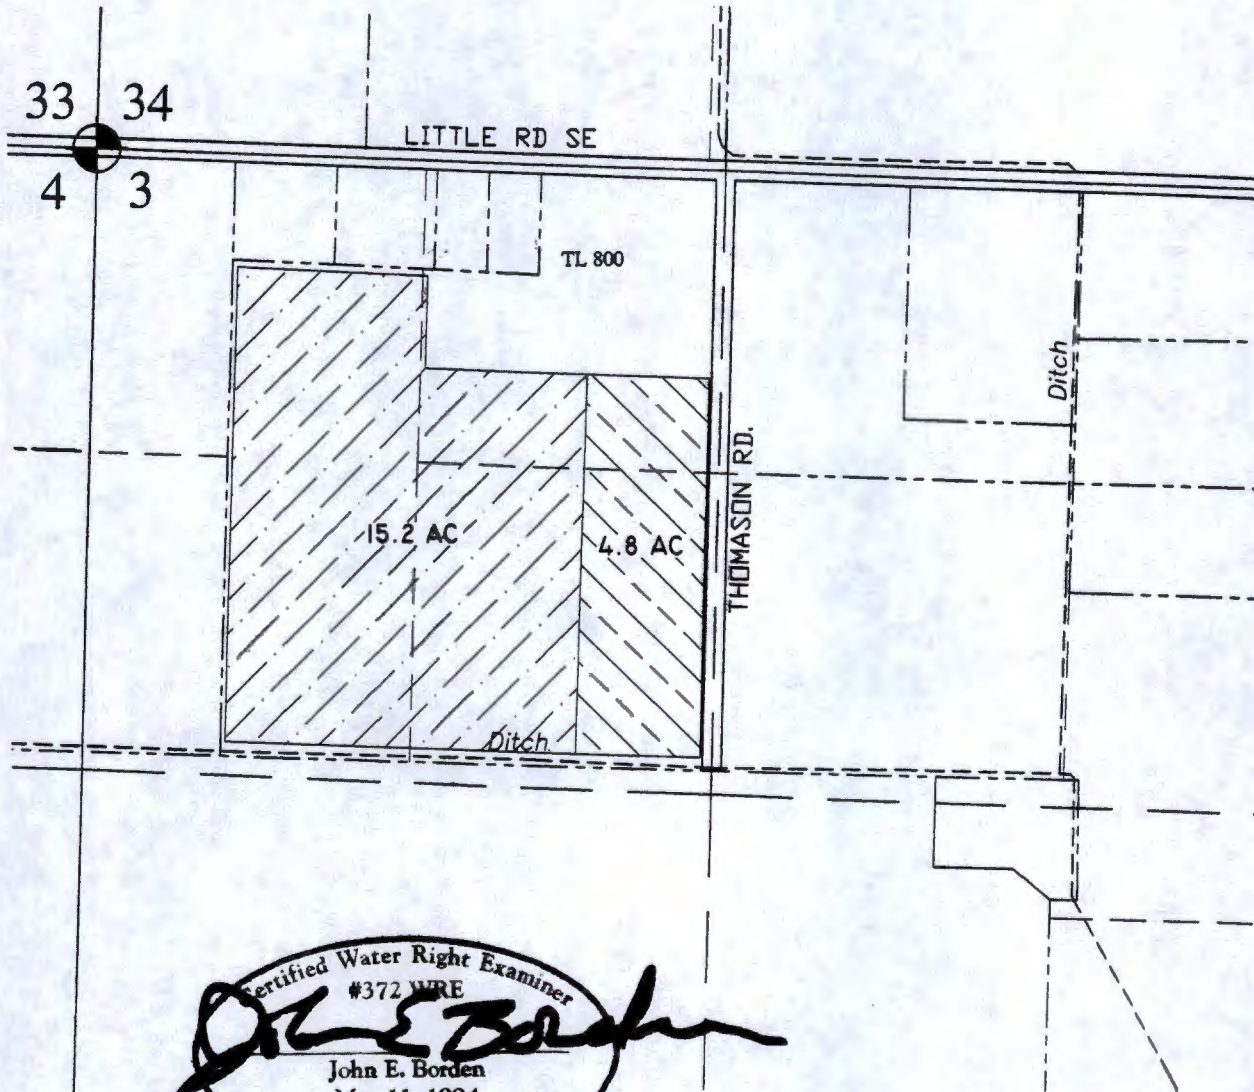

Certified Water Right Examiner
#372 WRE
John E. Borden
John E. Borden
May 11, 1994
STATE OF OREGON

TRANSFER "TO" WATER RIGHTS

SANTIAM WATER
CONTROL DISTRICT

284 E. WATER ST.
STAYTON, OR. 97383
503-769-2669

TRANSFER APPLICATION MAP

FILE PATH & NAME: F:\SWCD\FERS\F_COATES_MUMPER_TO_SMITH_012208.dwg