


T.35S. R.33E. W.M.

HARNEY COUNTY, OREGON

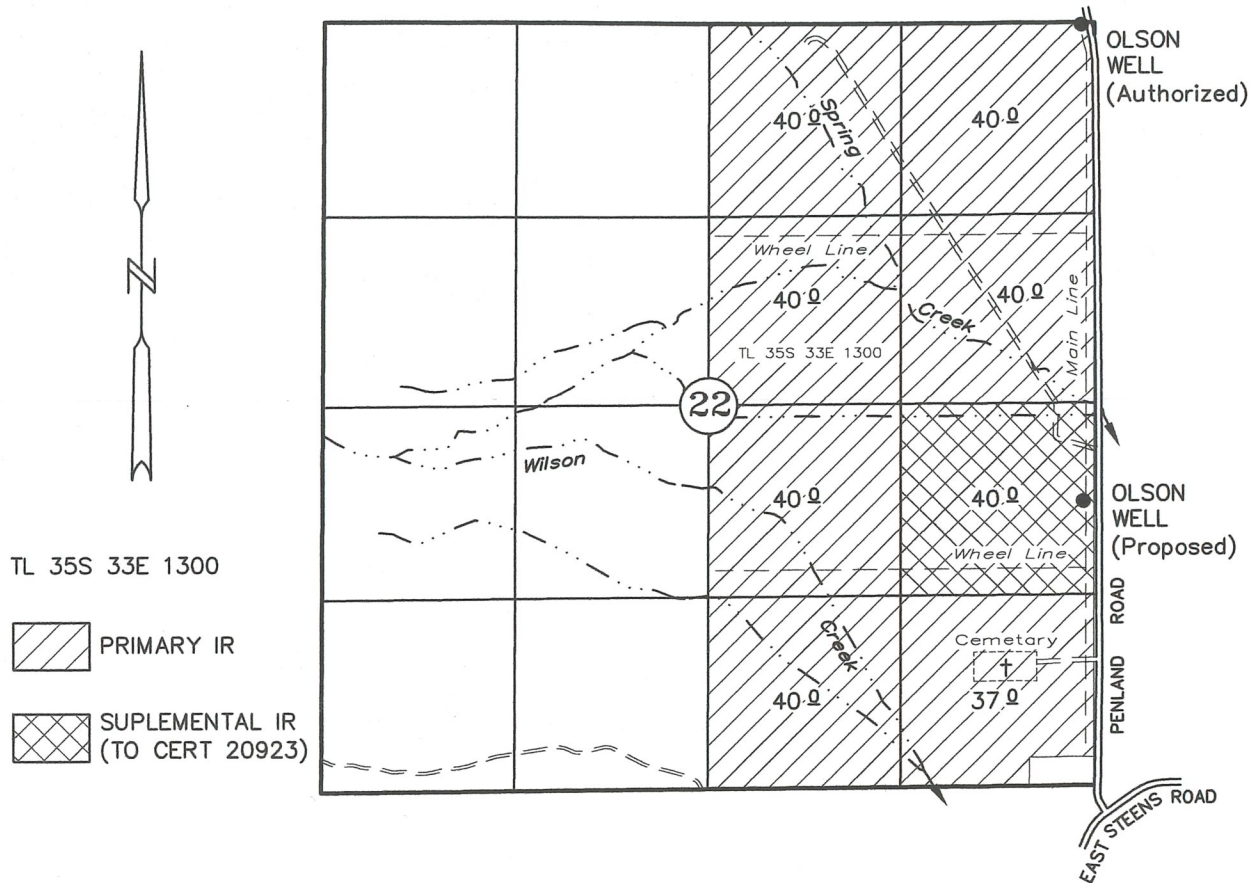

OLSON WELL (authorized): 2620' N & 90' W OF E 1/4 COR SECTION 22
OLSON WELL (proposed): 670' S & 70' W OF E 1/4 COR SECTION 22

APPLICATION FOR PERMIT AMENDMENT

POA

Application No. G-18338 Permit No. G-17779 Transfer No. T-13540

**Olson Living Trust
Philip & Gretchen Olson**

OCTOBER 12, 2020

revised: December 9, 2020

SCALE 1" = 1320'

RECEIVED

DEC 11 2020

OWRD




RENEWALS: 12-31-2021

NOTE: This map is not intended to provide legal dimensions or locations of property ownership lines.

T.35S. R.33E. W.M.

HARNEY COUNTY, OREGON

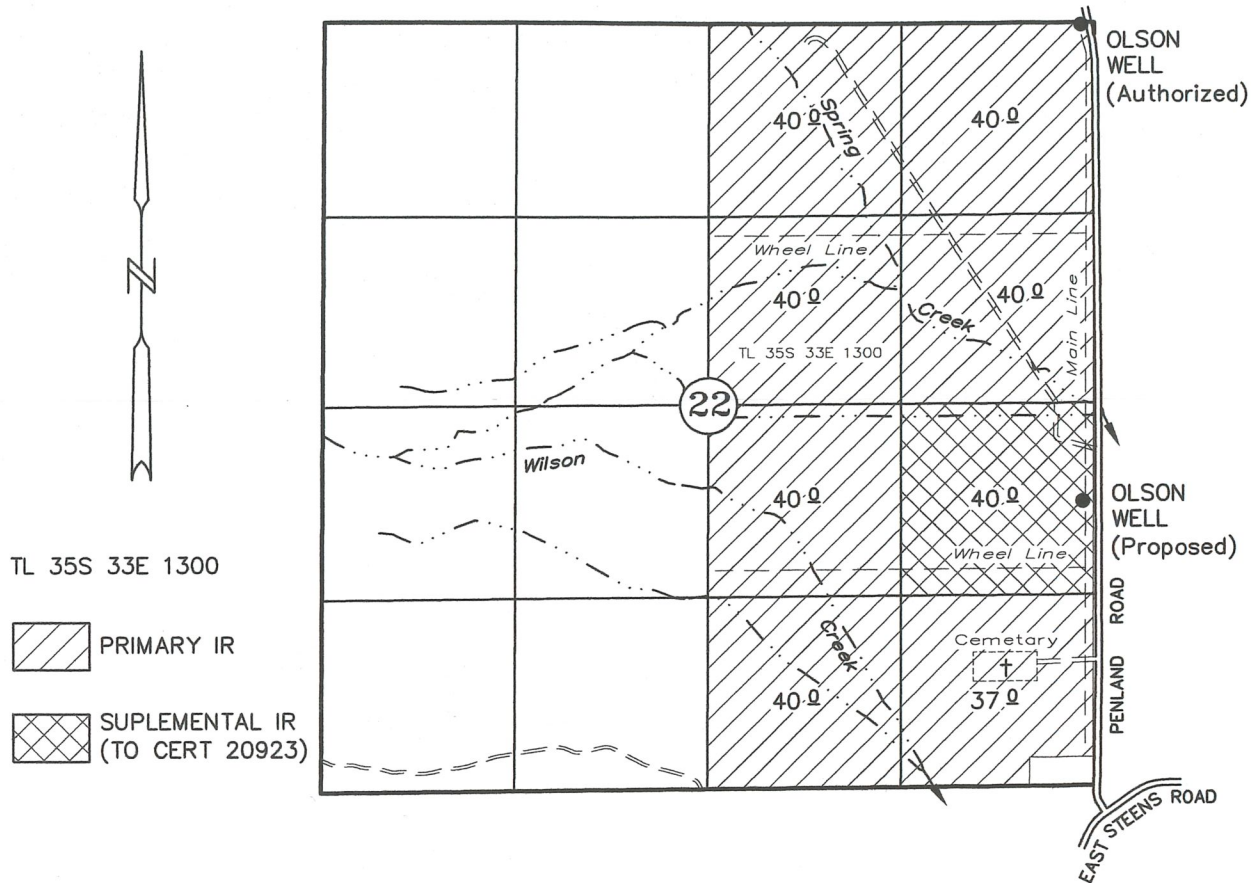

OLSON WELL (authorized): 2620' N & 90' W OF E 1/4 COR SECTION 22
OLSON WELL (proposed): 670' S & 70' W OF E 1/4 COR SECTION 22

APPLICATION FOR PERMIT AMENDMENT

POA

Application No. G-18338 Permit No. G-17779 Transfer No. T-13540

**Olson Living Trust
Philip & Gretchen Olson**

OCTOBER 12, 2020

revised: December 9, 2020

SCALE 1" = 1320'

RECEIVED

DEC 11 2020

OWRD



NOTE: This map is not intended to provide legal dimensions or locations of property ownership lines.

RENEWS: 12-31-2021