

Please use and attach additional pages of Table 2 as needed.
See page 6 for instructions.


Do you have questions about how to fill-out the tables?
Contact the Department at 503-986-0900 and ask for Transfer Staff.




Table 2. Description of Changes to Water Right Certificate # 83328

List the change proposed for the acreage in each ¼ ¼. If more than one change is proposed, specify the acreage associated with each change.
If there is more than one POD/POA involved in the proposed changes, specify the acreage associated with each POD/POA.

AUTHORIZED (the "from" or "off" lands)											PROPOSED (the "to" or "on" lands)																	
The listing that appears on the certificate BEFORE PROPOSED CHANGES											The listing as it would appear AFTER PROPOSED CHANGES																	
List only that part or portion of the water right that will be changed.											are made.																	
Twp	Rng	Sec	¼ ¼	Tax Lot/lot or DLC	Gvt	Acres	Type of USE listed on Certificate	POD(s) or POA(s) (name or number from Table 1)	Priority Date	Proposed Changes (see "CODES" from previous page)	Twp	Rng	Sec	¼ ¼	Tax Lot/lot or DLC	Gvt	Acres	New Type of USE	POD(s) to be used (from Table 1)	Priority Date								
EXAMPLE																												
2	9	9	E	15	NE	NW	160		15.0	Irrigation	POB #1 POB #2	1901		POU/POB	2	5	9	E	1	NW	NW	500	1	10.0		POB #5	1981	
															2	5	9	E	2	SW	NW	800		5.0		POB #6	1981	
37	S	10	E	19	SE	NE	3600		2.3	Primary Irrigation	WELL 3	1990		POU	37	S	10	E	19	SE	NE	3600		2.3		Primary Irrigation	WELL 3	1990
37	S	10	E	19	NE	SE	3600		10.2	Supplemental Irrigation	WELL 3	1990		POU	37	S	10	E	19	SE	NE	3600		2.8		Supplemental Irrigation	WELL 3	1990
37	S	10	E	19	SE	NE	3600		2.3	Supplemental Irrigation	WELL 3	1990		POU	37	S	10	E	20	SW	NW	3600		3.0		Supplemental Irrigation	WELL 3	1990
37	S	10	E	19	SE	NE	3600		2.8	Primary Irrigation	WELL 3	1990		POU	37	S	10	E	20	NW	SW	3600		3.9		Supplemental Irrigation	WELL 3	1990
37	S	10	E	20	SW	NW	3900		3.0	Primary Irrigation	WELL 3	1990		POU	37	S	10	E	20	NE	SW	3600		0.5		Supplemental Irrigation	WELL 3	1990
37	S	10	E	20	NW	SW	3900		3.9	Primary Irrigation	WELL 3	1990		POU	37	S	10	E	19	SE	NE	3600		2.3		Supplemental Irrigation	WELL 3	1990
37	S	10	E	20	NE	SW	3900		0.5	Primary Irrigation	WELL 3	1990		POU	37	S	10	E	19	NE	SE	3600		10.2		Primary Irrigation	WELL 3	1990
37	S	10	E	19	NW	SE	3600		0.8	Primary Irrigation	WELL 3	1990		POU	37	S	10	E	19	SW	NE	3600		0.8		Primary Irrigation	WELL 3	1990
TOTAL ACRES: 25.8											TOTAL ACRES: 25.8																	

Additional remarks: The 12.5 "TO" Supplemental Irrigation acres will be Supplemental to the Certificate 33176 "TO" Primary Irrigation. The 12.5 "FROM" Supplemental Irrigation acres will be Supplemental to the Certificate 33176 "FROM" Primary Irrigation.

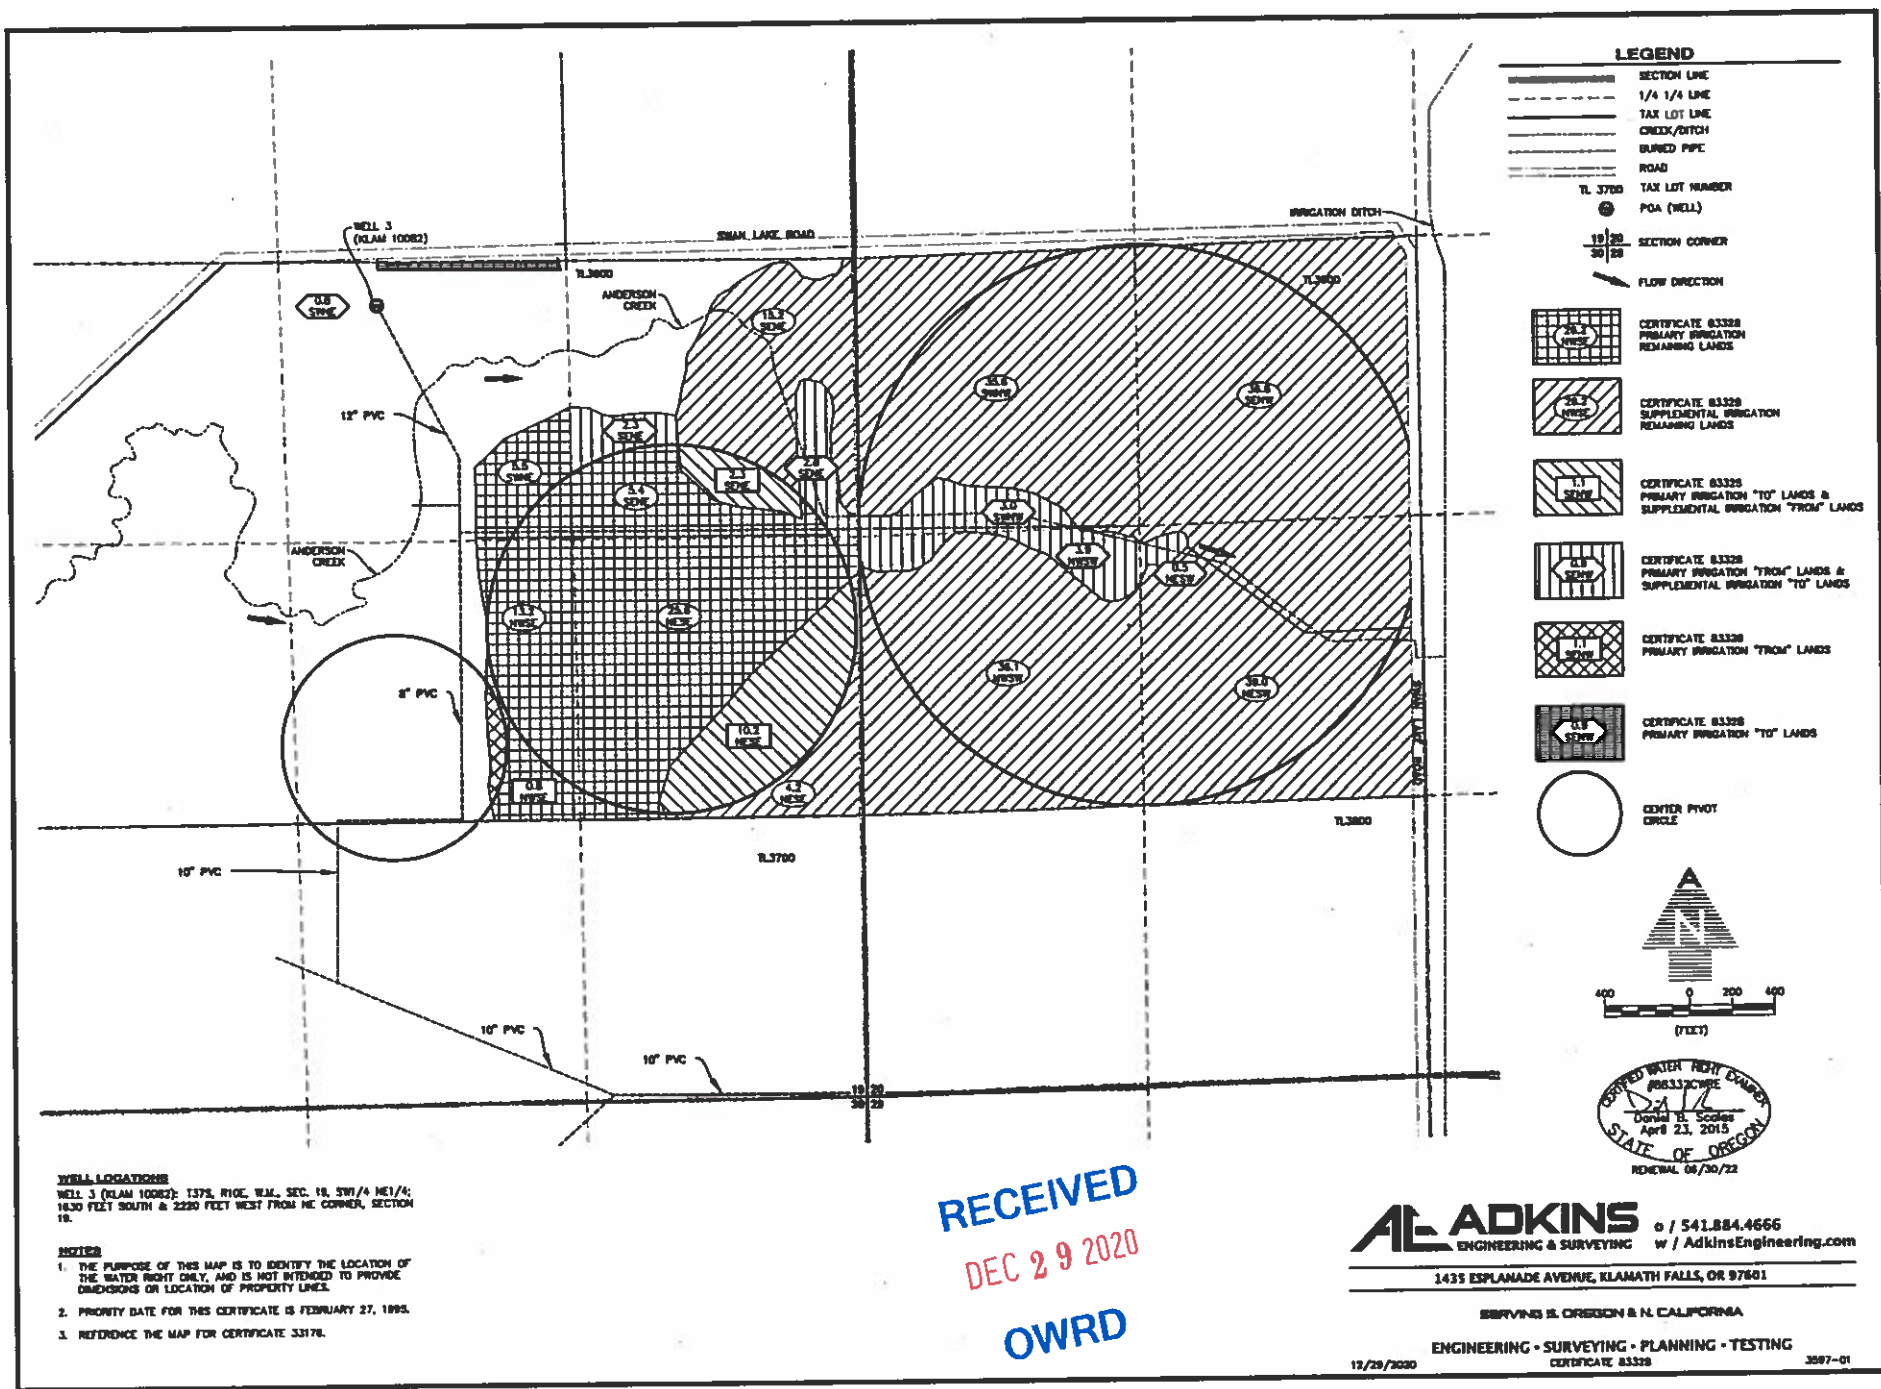

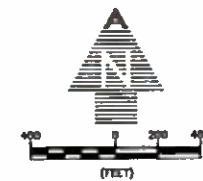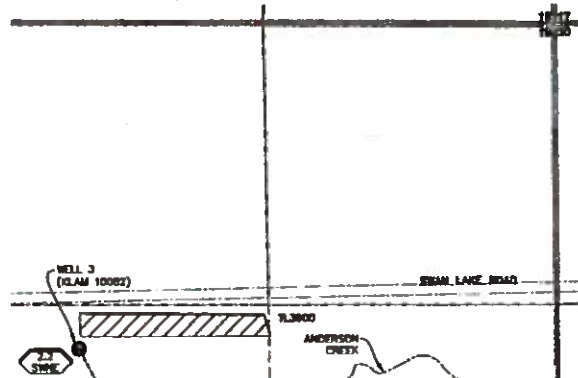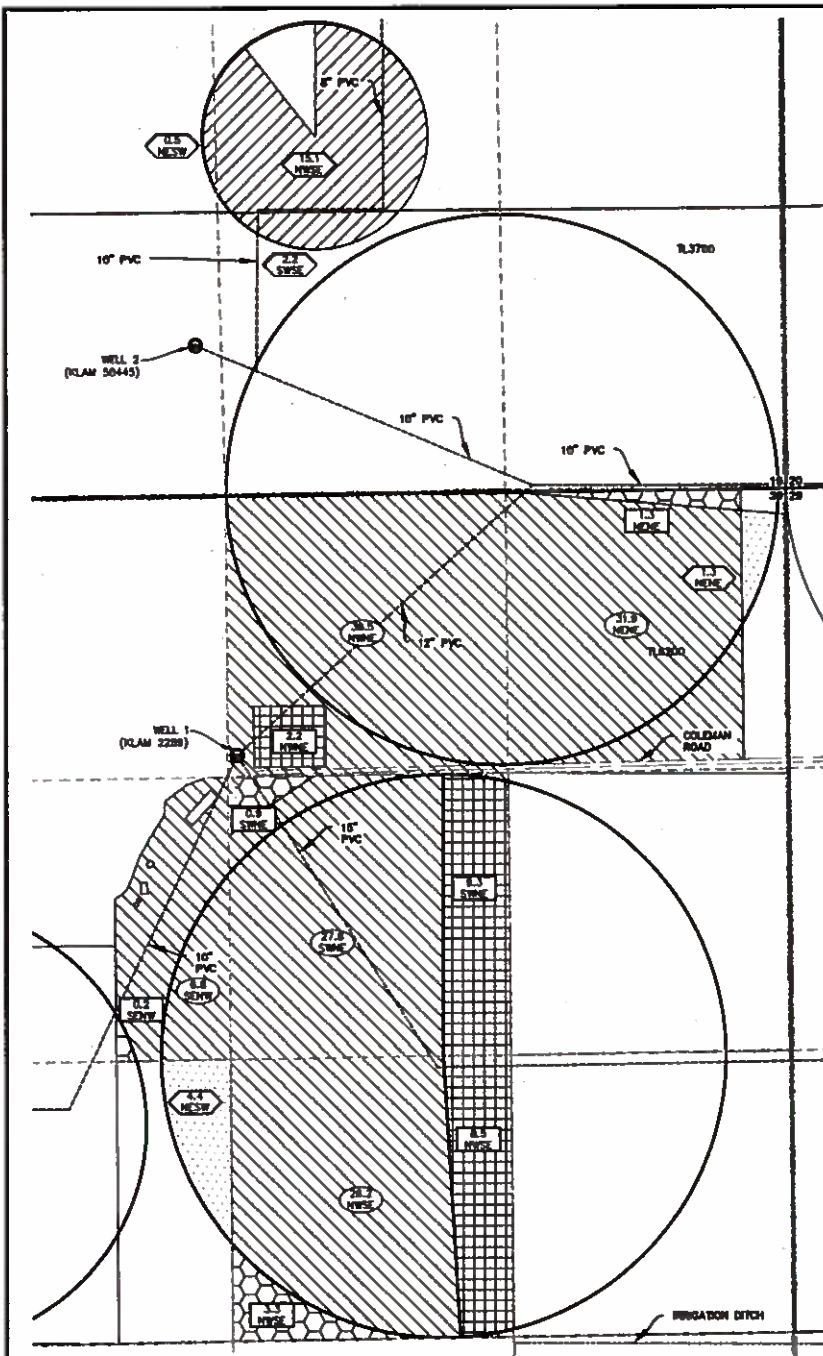

LEGEND

	SECTION LINE
	1/4 1/4 LINE
	TAX LOT LINE
	CREEK/DITCH
	BURIED PIPE
	ROAD
	TAX LOT NUMBER
	POA (WELL)
	SECTION CORNER
	FLOW DIRECTION
	CERTIFICATE 22847 LANDS TO REMAIN UNCHANGED
	CERTIFICATE 22847 TRANSFERRED "TO" LANDS (POU ONLY)
	CERTIFICATE 22847 TRANSFERRED "FROM" LANDS (POU ONLY)
	CERTIFICATE 22847 TRANSFERRED "TO" LANDS (POU & POA)
	CERTIFICATE 22847 TRANSFERRED "FROM" LANDS (POU & POA)
	CENTER PIVOT CIRCLE

WELL LOCATIONS

WELL 1 (KIAM 2288): T37S, R10E, W4M, SEC. 30, NE1/4 NW1/4; 1250 FEET SOUTH & 2560 FEET WEST FROM NE CORNER, SECTION 30.

WELL 2 (KIAM 50445): T37S, R10E, W4M, SEC. 18, SE1/4 SW1/4; 670 FEET NORTH & 2780 FEET WEST FROM SE CORNER, SECTION 18.

WELL 3 (KIAM 10082): T37S, R10E, W4M, SEC. 18, SW1/4 NE1/4; 1630 FEET SOUTH AND 2230 FEET WEST FROM NE CORNER, SECTION 18.

NOTES

1. THE PURPOSE OF THIS MAP IS TO IDENTIFY THE LOCATION OF THE WATER RIGHT ONLY, AND IS NOT INTENDED TO PROVIDE DIMENSIONS OR LOCATION OF PROPERTY LINES.
2. PRIORITY DATE FOR THIS CERTIFICATE IS AUGUST 2, 1946.
3. REFERENCE THE MAP FOR CERTIFICATE 88113.



RECEIVED

DEC 29 2020

OWRD

ADKINS o / 541.884.4666
ENGINEERING & SURVEYING w / AdkinsEngineering.com

1435 ESPLANADE AVENUE, KLAMATH FALLS, OR 97601

SERVING S. OREGON & N. CALIFORNIA

ENGINEERING • SURVEYING • PLANNING • TESTING
CERTIFICATE 22847

12/29/2020

3587-01