



RECEIVED  
DEC 18 2020  
OWRD

December 15, 2020

Ann Reece  
District Transfer Advisor  
Oregon Water Resources Department  
725 Summer St NE Ste A  
Salem, OR 97301-1266

**RE: FINAL PROOFS – Claim of Beneficial Use for T-13239**

Dear Ann,

Central Oregon Irrigation District is submitting our claim of beneficial use for a permanent District transfer ("385").

Enclosed is a list of the authorized lands. Site reports are attached to each map and any specific details about the properties are contained in each site report.

**Please Note:** The below noted properties have had the following changes:

1. F18-13-03 SWNW 00600: Mapping Changes.

The District certifies that it has inspected the place of use and confirms the change in place of use has been completed consistent with the terms and conditions of the final order approving the transfer.

Leslie Clark

Director of Water Rights, Central Oregon Irrigation District

Date: 12-15-20



Oregon Water Resources  
 Department  
 725 Summer Street NE, Suite A  
 Salem, Oregon 97301-1266  
 (503) 986-0900  
 www.wrd.state.or.us

# District Permanent Water Right Transfer Claim of Beneficial Use

RECEIVED

DEC 18 2020

OWRD

## 1. APPLICANT INFORMATION

District: CENTRAL OREGON IRRIGATION DISTRICT

Contact Person: LESLIE CLARK

Phone: 541-548-6047

Mailing Address: 1055 SW LAKE COURT

City: REDMOND

State: OR

Zip: 97756

E-Mail address:

lesliec@coiid.org

Transfer Number: T - 13094

## 2. WATER RIGHT(S)

Pursuant to OAR Chapter 690, Division 385, the district is submitting to the Water Resources Department this claim of beneficial use, with the appropriate fee, for the following water right(s):

PERMIT NUMBER	CERTIFICATE NUMBER	DECREE (name, volume, and page)	PRIMARY (P) OR SUPP (S)
-	83571		<input checked="" type="checkbox"/> P <input type="checkbox"/> S
-	76714		<input type="checkbox"/> P <input checked="" type="checkbox"/> S
-			<input type="checkbox"/> P <input type="checkbox"/> S
-			<input type="checkbox"/> P <input type="checkbox"/> S

## 3. AUTHORIZED POINT(S) OF DIVERSION (POD) / APPROPRIATION (POA)

The authorized point(s) of diversion / appropriation for the water right modified by the transfer are as follows:

PERMIT NUMBER	DECREE or CERTIFICATE	POD / POA #	SOURCE	LOCATION – MEASURED DISTANCES
-	83571	1	Deschutes River	SW ¼ NE ¼ SEC. 13, T. 18 S., R. 11 E., W.M.; 1520' S. & 1535' W. FROM THE NE CORNER OF SEC. 13
-	83571	11	Deschutes River	SE ¼ NE ¼ SEC. 29, T. 17 S., R. 12 E., W.M.; 850' N. AND 630' W. FROM THE E ¼ CORNER OF SEC. 29
-				
-				

T-13239		FINAL PROOF										
Cert/Decree	Cert/Perm	TRANSFER NBR	POD	USE	TWP	RNG	SEC	QO	LOT	ACRES	USER NAME	MAP CHANGE
83571	76714	T-2019-004	#11	IRRI	14	13	15	NENW	00400	0.520	Ralph, Jeff/Jamie	
83571	76714	T-2019-005	#11	IRRI	14	13	26	NWSE	00403	1.370	Russell, Zachary	
83571	76714	T-2019-003	#11	IRRI	15	12	25	SENE	00606	0.150	Whittaker, James/Deborah	
83571	76714	T-2019-003	#11	IRRI	15	12	25	SWNE	00606	0.500	Whittaker, James/Deborah	
83571	76714	T-2019-002	#11	IRRI	17	12	11	NWNE	02100	0.600	Wallace, Dan	
83571	76714	T-2019-006	#11	IRRI	17	12	15	SENW	AC300	0.400	Sickler, Stephen/Fletcher, Lori	
83571	76714	T-2019-009	#1	IRRI	17	12	24	NENE	00101	3.000	Gordon, Joshua	
83571	76714	T-2019-001	#1	IRRI	18	13	03	SWNW	00600	2.350	Berkey, Erik	X
										<b>8.890</b>		

RECEIVED

DEC 18 2020

OWRD

PERMANENT TRANSFER – FINAL PROOF

OWRD #: T-13239  
Petition #: P-2019-001

Property Owner: Ralph, Jeff/Jamie Patron #: 589195

Property Address: 9328 NE 5th St, Terrebonne

USE	BEAT	HG	TWP	RNG	SEC	QQ	TAX LOT	ACRES
IRRIG	PB4	H-8-2-1	14	13	15	NENW	400	0.520
IRRIG								

TYPE OF CROP: grass  
METHOD OF IRRIGATION: Flood

1<sup>st</sup> Review Date: 6/9/20 Initials: AC Used Acres: 0.52 Dry Acres: 0

Photos taken with Collector:  Yes  No Collector Polygons:  Yes  No

Notes: GPS, well established lawn in front. Back pasture Full

Post Card Sent: 6/9/20  Complete  Partial  Dry

2<sup>nd</sup> Review:

Site appointment scheduled w/patron Date: \_\_\_\_\_  Informed of \$150 if not complete 3<sup>rd</sup> visit.  
Initials: \_\_\_\_\_ Used Acres: \_\_\_\_\_ Dry Acres: \_\_\_\_\_

Notes: \_\_\_\_\_  
\_\_\_\_\_  
\_\_\_\_\_

3<sup>rd</sup> Review:

Site appointment scheduled w/patron Date: \_\_\_\_\_  
Initials: \_\_\_\_\_ Used Acres: \_\_\_\_\_ Dry Acres: \_\_\_\_\_

Notes: \_\_\_\_\_  
\_\_\_\_\_  
\_\_\_\_\_

If not complete invoice \$150 fee: \_\_\_\_\_

4<sup>th</sup> Review Date:

Site appointment scheduled w/patron Date: \_\_\_\_\_  
Initials: \_\_\_\_\_ Used Acres: \_\_\_\_\_ Dry Acres: \_\_\_\_\_

Notes: \_\_\_\_\_  
\_\_\_\_\_  
\_\_\_\_\_

Invoice \$150.00 fee: \_\_\_\_\_



# DESCHUTES COUNTY SEC.15 T14S R13E

RECEIVED

DEC 18 2020


SCALE - 1" = 400'

OWRD



NE 1/4 OF THE NW 1/4

OWRD #: T-13239

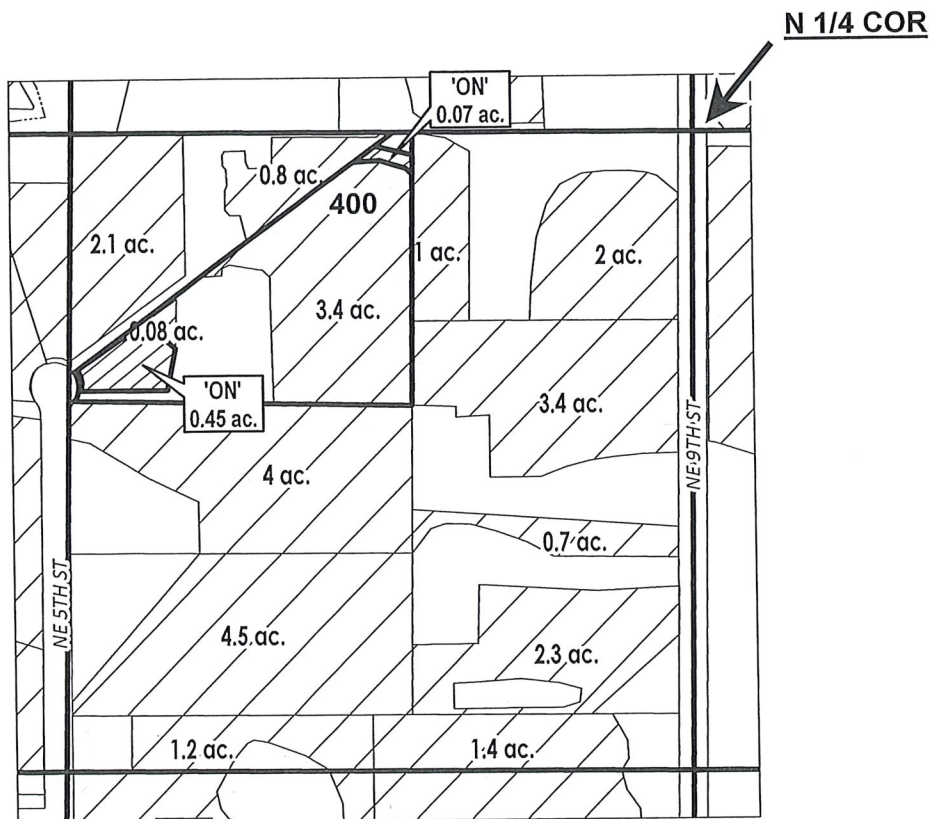

	EXISTING WATER RIGHTS
	ON LANDS

FINAL PROOF MAP

NAME: Ralph, Jeff/Jamie

TAXLOT #: 400

0.52 ACRES



Date: 9/30/2020

PERMANENT TRANSFER – FINAL PROOF

OWRD #: T-13239  
Petition #: P-2019-001

Property Owner: Russell, Zachary Patron #: 4448

Property Address: 3065 NE O'Neil Way, Redmond

USE	BEAT	HG	TWP	RNG	SEC	QQ	TAX LOT	ACRES
IRRIG	PB3	I-2	14	13	26	NWSE	403	1.370
IRRIG								

TYPE OF CROP: pasture  
METHOD OF IRRIGATION: Flood

1<sup>st</sup> Review Date: 6/12/20 Initials: AC Used Acres: 1.37 Dry Acres: 0

Photos taken with Collector:  Yes  No Collector Polygons:  Yes  No

Notes: GIPSEL cows on & eating. Growing in thick

Post Card Sent: 6/15/20  Complete  Partial  Dry

2<sup>nd</sup> Review:

Site appointment scheduled w/patron Date: \_\_\_\_\_  Informed of \$150 if not complete 3<sup>rd</sup> visit. Initials: \_\_\_\_\_ Used Acres: \_\_\_\_\_ Dry Acres: \_\_\_\_\_

Notes: \_\_\_\_\_

3<sup>rd</sup> Review:

Site appointment scheduled w/patron Date: \_\_\_\_\_ Initials: \_\_\_\_\_ Used Acres: \_\_\_\_\_ Dry Acres: \_\_\_\_\_

Notes: \_\_\_\_\_

If not complete invoice \$150 fee: \_\_\_\_\_

4<sup>th</sup> Review Date:

Site appointment scheduled w/patron Date: \_\_\_\_\_ Initials: \_\_\_\_\_ Used Acres: \_\_\_\_\_ Dry Acres: \_\_\_\_\_

Notes: \_\_\_\_\_

Invoice \$150.00 fee: \_\_\_\_\_

DESCHUTES COUNTY  
SEC.26 T14S R13E

RECEIVED

DEC 18 2020

OWRD



SCALE - 1" = 400'



NW 1/4 OF THE SE 1/4

OWRD #: T-13239

C 1/4 COR

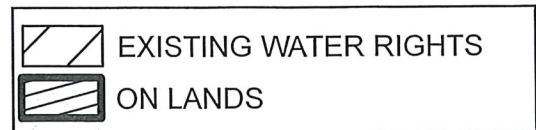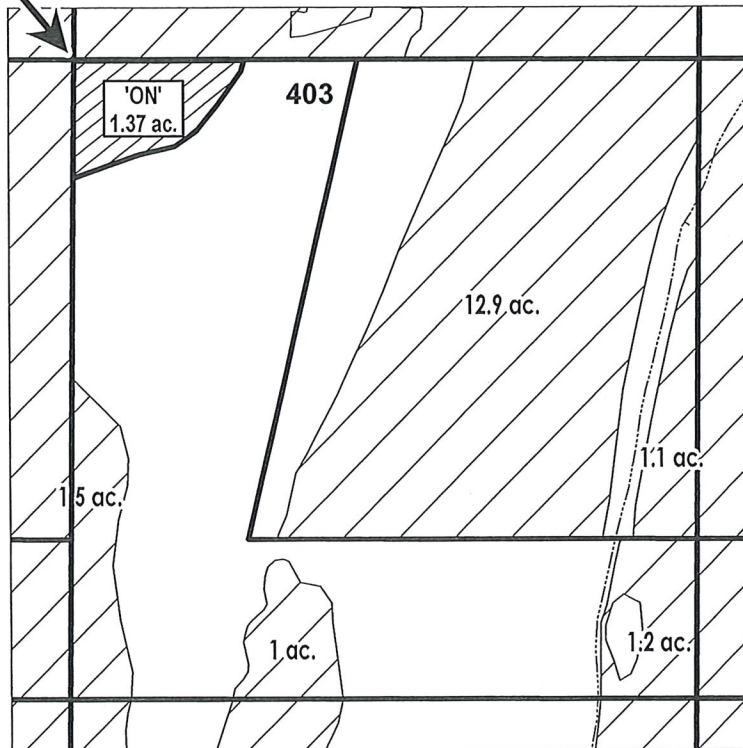

FINAL PROOF MAP

NAME: Russell, Zachary

TAXLOT #: 403

1.37 ACRES

Date: 9/30/2020



PERMANENT TRANSFER – FINAL PROOF

RECEIVED

DEC 18 2020

OWRD

OWRD #: T-13239

Petition #: P-2019-001

Property Owner: Whittaker, James/Deborah Patron #: 4723

Property Address: 5576 SW Hutchinson Way, Redmond

USE	BEAT	HG	TWP	RNG	SEC	QQ	TAX LOT	ACRES
IRRIG	PB1	B-2-15-1	15	12	25	SENE	606	0.150
IRRIG	PB1	B-2-15-1	15	12	25	SWNE	606	0.500

TYPE OF CROP: hay  
METHOD OF IRRIGATION: wheel line

1<sup>st</sup> Review Date: 6/16/20 Initials: AK Used Acres: 0.65 Dry Acres:   
Photos taken with Collector:  Yes  No Collector Polygons:  Yes  No  
Notes: GPSed. Hay is knee high & ready to cut

Post Card Sent: 6/2/20  Complete  Partial  Dry

2<sup>nd</sup> Review:  
Site appointment scheduled w/patron Date: \_\_\_\_\_  Informed of \$150 if not complete 3<sup>rd</sup> visit.  
Initials: \_\_\_\_\_ Used Acres: \_\_\_\_\_ Dry Acres: \_\_\_\_\_  
Notes: \_\_\_\_\_

3<sup>rd</sup> Review:  
Site appointment scheduled w/patron Date: \_\_\_\_\_  
Initials: \_\_\_\_\_ Used Acres: \_\_\_\_\_ Dry Acres: \_\_\_\_\_  
Notes: \_\_\_\_\_

If not complete invoice \$150 fee: \_\_\_\_\_

4<sup>th</sup> Review Date:  
Site appointment scheduled w/patron Date: \_\_\_\_\_  
Initials: \_\_\_\_\_ Used Acres: \_\_\_\_\_ Dry Acres: \_\_\_\_\_  
Notes: \_\_\_\_\_

Invoice \$150.00 fee: \_\_\_\_\_



# DESCHUTES COUNTY SEC.25 T15S R12E

RECEIVED

DEC 18 2020


SCALE - 1" = 400'

OWRD




SW 1/4 OF THE NE 1/4; SE 1/4 OF THE NE 1/4

OWRD #: T-13239

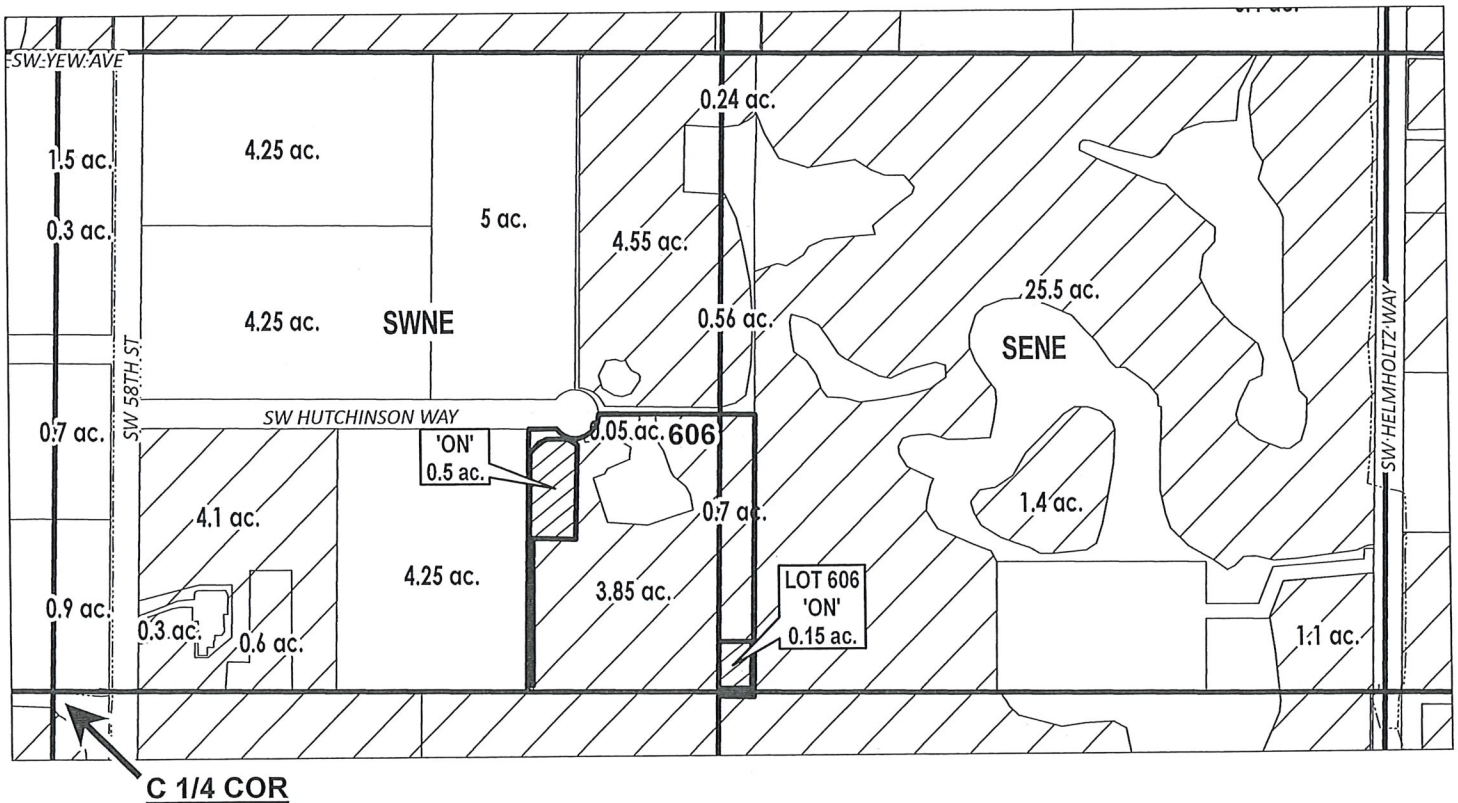

	EXISTING WATER RIGHTS
	ON LANDS
# ac.	PARCELS W/ WATER RIGHTS

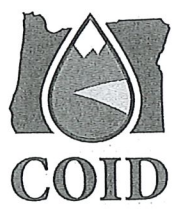

## FINAL PROOF MAP

NAME: Whittaker, James/Deborah

TAXLOT #: 606

0.65 ACRES

Date: 9/30/2020

PERMANENT TRANSFER – FINAL PROOF

OWRD #: T-13239  
Petition #: P-2019-001

Property Owner: Wallace, Dan Patron #: 3563  
Property Address: 63996 Deschutes Market Rd, Bend

USE	BEAT	HG	TWP	RNG	SEC	QQ	TAX LOT	ACRES
IRRIG	PB1	A-4-#3	17	12	11	NWNE	2100	0.600
IRRIG								

TYPE OF CROP: pasture  
METHOD OF IRRIGATION: sprinkler

1<sup>st</sup> Review Date: 6/16/20 Initials: AL Used Acres: 0.6 Dry Acres:

Photos taken with Collector:  Yes  No Collector Polygons:  Yes  No

Notes: GPSet. 4 cows grazing, no bare spots

Post Card Sent: 6/24/20  Complete  Partial  Dry

2<sup>nd</sup> Review:

Site appointment scheduled w/patron Date: \_\_\_\_\_  Informed of \$150 if not complete 3<sup>rd</sup> visit. Initials: \_\_\_\_\_ Used Acres: \_\_\_\_\_ Dry Acres: \_\_\_\_\_

Notes: \_\_\_\_\_

3<sup>rd</sup> Review:

Site appointment scheduled w/patron Date: \_\_\_\_\_  
Initials: \_\_\_\_\_ Used Acres: \_\_\_\_\_ Dry Acres: \_\_\_\_\_

Notes: \_\_\_\_\_

If not complete invoice \$150 fee: \_\_\_\_\_

4<sup>th</sup> Review Date:

Site appointment scheduled w/patron Date: \_\_\_\_\_  
Initials: \_\_\_\_\_ Used Acres: \_\_\_\_\_ Dry Acres: \_\_\_\_\_

Notes: \_\_\_\_\_

Invoice \$150.00 fee: \_\_\_\_\_

RECEIVED

DEC 18 2020

OWRD

# DESCHUTES COUNTY SEC.11 T17S R12E


SCALE - 1" = 400'



NW 1/4 OF THE NE 1/4

OWRD #: T-13239

N 1/4 COR

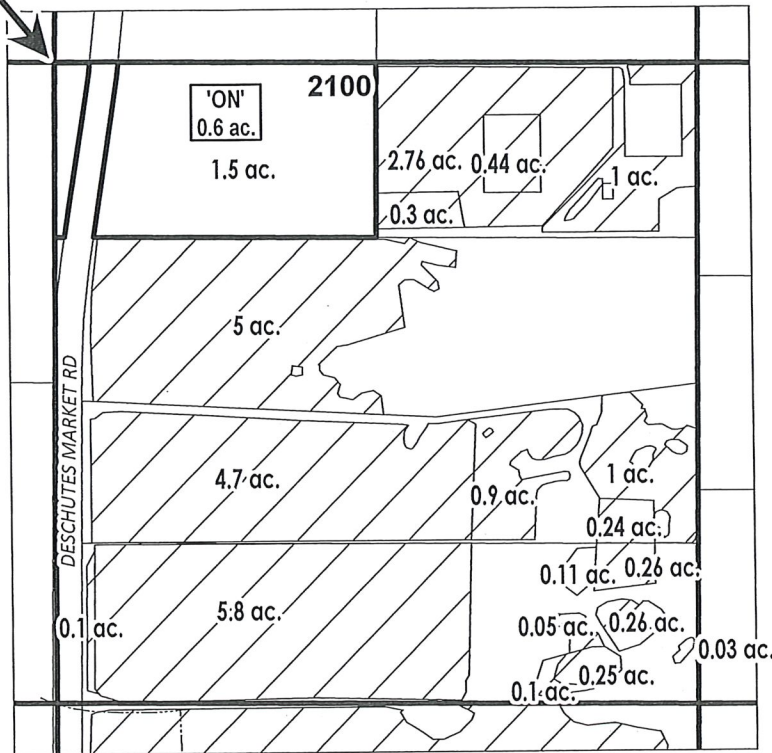

	EXISTING WATER RIGHTS
	'ON' LAND PARCELS
	PARCELS W/ WATER RIGHTS

FINAL PROOF MAP

NAME: Wallace, Dan

TAXLOT #: 2100

0.6 ACRES



Date: 9/30/2020



PERMANENT TRANSFER – FINAL PROOF

OWRD #: T-13239  
Petition #: P-2019-001

Property Owner: Sickler, Stephen/Fletcher, Lori Patron #: 902155  
Property Address: 20985 Scottsdale Dr, Bend

USE	BEAT	HG	TWP	RNG	SEC	QQ	TAX LOT	ACRES
IRRIG	PB1	PBC-3	17	12	15	SENW	0	0.400
IRRIG								

TYPE OF CROP: grass/landscape  
METHOD OF IRRIGATION: sprinkler

1<sup>st</sup> Review Date: 6/16/20 Initials: AE Used Acres: 0.4 Dry Acres: 0  
Photos taken with Collector:  Yes  No Collector Polygons:  Yes  No  
Notes: Grass established

Post Card Sent: 6/24/20  Complete  Partial  Dry

2<sup>nd</sup> Review:  
Site appointment scheduled w/patron Date: \_\_\_\_\_  Informed of \$150 if not complete 3<sup>rd</sup> visit.  
Initials: \_\_\_\_\_ Used Acres: \_\_\_\_\_ Dry Acres: \_\_\_\_\_  
Notes: \_\_\_\_\_

3<sup>rd</sup> Review:  
Site appointment scheduled w/patron Date: \_\_\_\_\_  
Initials: \_\_\_\_\_ Used Acres: \_\_\_\_\_ Dry Acres: \_\_\_\_\_  
Notes: \_\_\_\_\_

If not complete invoice \$150 fee: \_\_\_\_\_

4<sup>th</sup> Review Date:  
Site appointment scheduled w/patron Date: \_\_\_\_\_  
Initials: \_\_\_\_\_ Used Acres: \_\_\_\_\_ Dry Acres: \_\_\_\_\_  
Notes: \_\_\_\_\_

Invoice \$150.00 fee: \_\_\_\_\_



RECEIVED

DEC 18 2020

OWRD


# DESCHUTES COUNTY SEC.15 T17S R12E

SCALE - 1" = 400'



SE 1/4 OF THE NW 1/4

OWRD #: T-13239

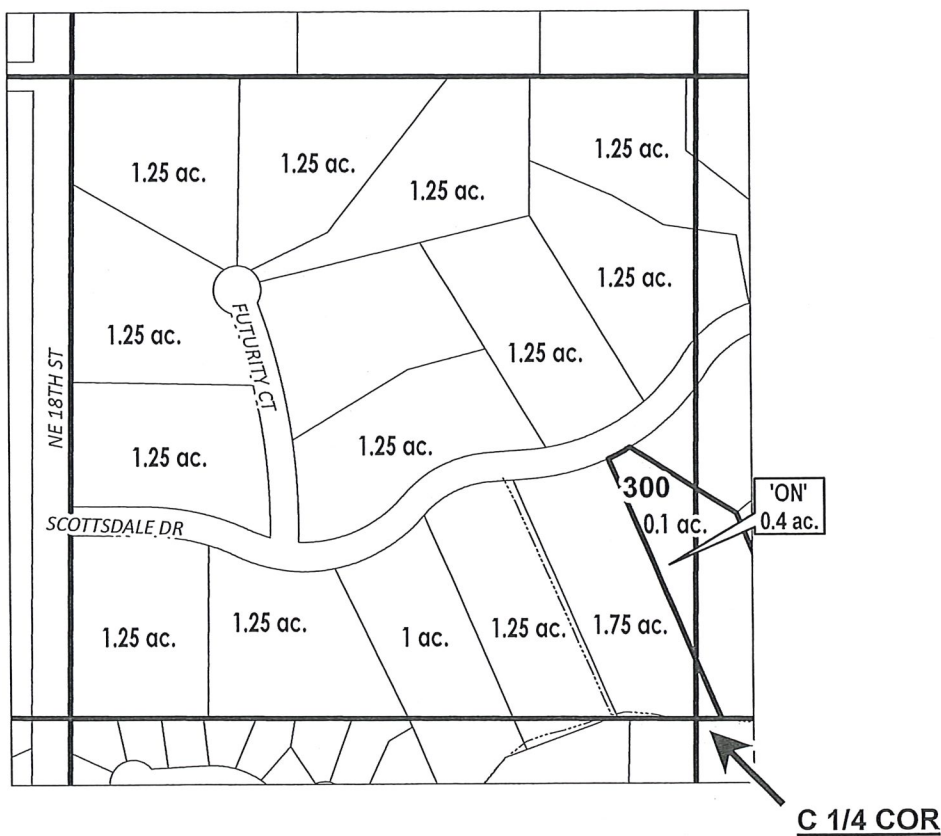

# ac.	PARCELS W/ WATER RIGHTS
# ac.	'ON' LAND PARCELS



## FINAL PROOF MAP

NAME: Sickler, Stephen/Fletcher, Lori

TAXLOT #: 300

0.4 ACRES

Date: 9/30/2020

RECEIVED

DEC 18 2020

PERMANENT TRANSFER - FINAL PROOF

OWRD #: T-13239

Petition #: P-2019-001

OWRD

Property Owner: Gordon, Joshua Patron #: 4869

Property Address: 63135 Dickey Rd, Bend

USE	BEAT	HG	TWP	RNG	SEC	QQ	TAX LOT	ACRES
IRRIG	CO1	A-24-26	17	12	24	NENE	101	3.000
IRRIG								

TYPE OF CROP: Vegetables in row crop. Tomatoes, pumpkins, cantalope, peppers & squash  
METHOD OF IRRIGATION: Drip irrigation

1<sup>st</sup> Review Date: 9/14/20 Initials: CP Used Acres: 3.00 Dry Acres: \_\_\_\_\_

Photos taken with Collector:  Yes  No Collector Polygons:  Yes  No

Notes: Vegetables in row crops with plastic & Drip.

Completed full use CP 9/18/20

Post Card Sent: \_\_\_\_\_  Complete  Partial  Dry

2<sup>nd</sup> Review:

Site appointment scheduled w/patron Date: \_\_\_\_\_  Informed of \$150 if not complete 3<sup>rd</sup> visit. Initials: \_\_\_\_\_ Used Acres: \_\_\_\_\_ Dry Acres: \_\_\_\_\_

Notes: \_\_\_\_\_

3<sup>rd</sup> Review:

Site appointment scheduled w/patron Date: \_\_\_\_\_

Initials: \_\_\_\_\_ Used Acres: \_\_\_\_\_ Dry Acres: \_\_\_\_\_

Notes: \_\_\_\_\_

If not complete invoice \$150 fee: \_\_\_\_\_

4<sup>th</sup> Review Date:

Site appointment scheduled w/patron Date: \_\_\_\_\_

Initials: \_\_\_\_\_ Used Acres: \_\_\_\_\_ Dry Acres: \_\_\_\_\_

Notes: \_\_\_\_\_

Invoice \$150.00 fee: \_\_\_\_\_

# DESCHUTES COUNTY SEC.24 T17S R12E

SCALE - 1" = 400'




NE 1/4 OF THE NE 1/4

RECEIVED

DEC 18 2020

OWRD

OWRD #: T-13239

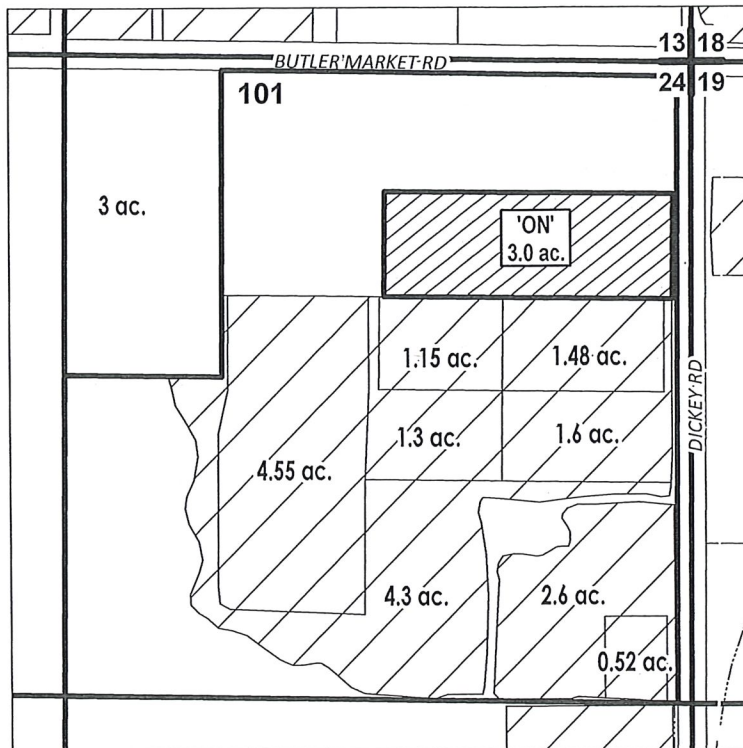

# ac.	PARCELS W/ WATER RIGHTS
	EXISTING WATER RIGHTS
	ON LANDS



**FINAL PROOF MAP**

**NAME: Gordon, Joshua**

**TAXLOT #: 101**

**3.0 ACRES**

Date: 9/30/2020

PERMANENT TRANSFER – FINAL PROOF

OWRD #: T-13239  
Petition #: P-2019-001

Property Owner: Berkey, Erik Patron #: 4433

Property Address: 23285 Bear Creek Rd, Bend

USE	BEAT	HG	TWP	RNG	SEC	QQ	TAX LOT	ACRES
IRRIG	CO2	D-1-3-2	18	13	3	SWNW	600	2.350
IRRIG								

TYPE OF CROP: grass  
METHOD OF IRRIGATION: sprinkler

1<sup>st</sup> Review Date: 6/29/20 Initials: AC Used Acres: 2.35 Dry Acres: 0

Photos taken with Collector:  Yes  No Collector Polygons:  Yes  No

Notes: GPSed = temp water in past. Looks great

Post Card Sent: 7/1/20  Complete  Partial  Dry Some changes

2<sup>nd</sup> Review:  
Site appointment scheduled w/patron Date: \_\_\_\_\_  Informed of \$150 if not complete 3<sup>rd</sup> visit.  
Initials: \_\_\_\_\_ Used Acres: \_\_\_\_\_ Dry Acres: \_\_\_\_\_  
Notes: \_\_\_\_\_

3<sup>rd</sup> Review:  
Site appointment scheduled w/patron Date: \_\_\_\_\_  
Initials: \_\_\_\_\_ Used Acres: \_\_\_\_\_ Dry Acres: \_\_\_\_\_  
Notes: \_\_\_\_\_

If not complete invoice \$150 fee: \_\_\_\_\_

4<sup>th</sup> Review Date:  
Site appointment scheduled w/patron Date: \_\_\_\_\_  
Initials: \_\_\_\_\_ Used Acres: \_\_\_\_\_ Dry Acres: \_\_\_\_\_  
Notes: \_\_\_\_\_

Invoice \$150.00 fee: \_\_\_\_\_



# DESCHUTES COUNTY SEC.03 T18S R13E

RECEIVED

DEC 1 8 2020


OWRD

SCALE - 1" = 400'



SW 1/4 OF THE NW 1/4

OWRD #: T-13239

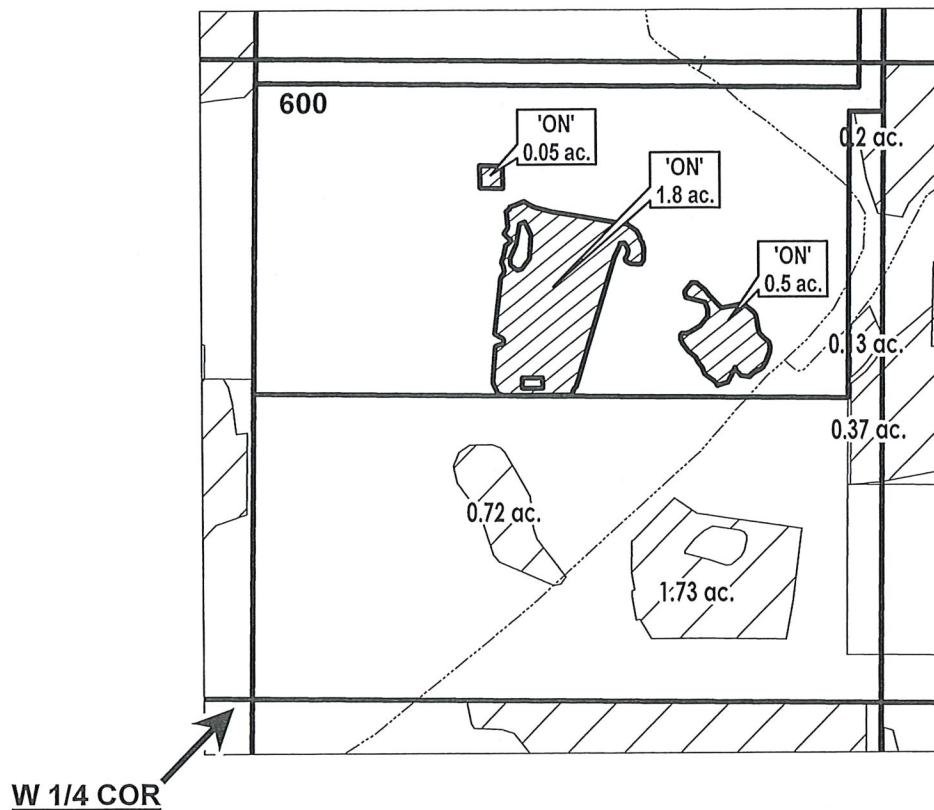

	EXISTING WATER RIGHTS
	ON LANDS



FINAL PROOF MAP

NAME: Berkey, Erik

TAXLOT #: 600

2.35 ACRES

Date: 9/30/2020