Groundwater Transfer Review Summary Form

Transfer/PA # T- <u>13558</u>
GW Reviewer Phillip Marcy Date Review Completed: 01/13/2021
Summary of Same Source Review:
☐ The proposed change in point of appropriation is not within the same aquifer as per OAR 690-380-2110(2).
Summary of Injury Review:
☐ The proposed transfer will result in another, existing water right not receiving previously available water to which it is legally entitled or result in significant interference with a surface water source as per 690-380-0100(3).
Summary of GW-SW Transfer Similarity Review:
\Box The proposed SW-GW transfer doesn't meet the definition of "similarly" as per OAR 690-380-2130.
This is only a summary. Documentation is attached and should be read thoroughly to understand the

Version: 20201202

OREGON


WATER RESOURCES DEPARTMENT	Oregon Water Reso 725 Summer Street N Salem, Oregon 9730 (503) 986-0900 www.wrd.state.or.us	VE, Suite A	☐ Water Righ ☐ Permit Am ☐ GR Modific ☐ Other	endment
Application: T-1	13558 App	plicant Name: <u>O</u>	regon State Universi	ty College of Agriculture
Proposed Chang	ges: \square POA \square USE	⊠ APOA □ POU	□ SW→GW □ OTHER	□ RA
Reviewer(s): P	Phillip I. Marcy Date	Reviewed by GV		te of Review: <u>01/13/2021</u> d to WRSD: <u>JTI 2/2/2021</u>
	provided in the a approved because		ufficient to evaluate	whether the proposed
	well reports provio the transfer.	led with the app	lication do not corre	spond to the water rights
			-	on of the well construction proposed to be developed
☐ Other	_			
correct the l well as addi applicant ha GR-2994, a	location of the exi ing other existing as contemporaneo	sting authorized wells to allow o usly submitted C der to allow use	well under GR-2993 peration of the syste GR modifications inv	plication proposes to 3 (no log identified), as m as a well field. The colving rights GR-2992, rized wells on any and all
4675in addi BENT 4675 database, m 2", as it is a	ition to the current is the currently a satching the specific	tly authorized POA suthorized POA sications in the oport. Considering	OA. This raises an is well under GR-2993 riginal document, wight these details, this r	wells, including BENT sue based on the fact that as assigned in the GWIS here it is labeled "Well # eview will proceed
⊠ Yes ☐ involved in	No Commenthe consolidation	ts: All existing a of the aforemen	authorized wells asso	existing authorized POA? ociated with water rights e from shallow alluvium, described.
<u> </u>	nore than one sou: ☑ No	rce developed ur	nder the right (e.g., b	asalt and alluvium)?


Page 1 of 3 Version: 20201202

Transfer Application: T- 13558

	limitations that will need to be placed on the proposed change (rate, duty, etc.): <u>NA</u>
4.	a) Will this proposed change, at its maximum allowed rate of use, likely result in an increase in interference with another ground water right ?
	⊠ Yes ☐ No Comments: Moving a portion of pumping authorized under GR-2993 to
	APOA wells closer to nearby GR-400 to the southwest is anticipated to increase interference
	from this right to a minor extent. However, effects will likely be offset by a share of
	pumping from rights GR-2994 and GR-2995 (transfers currently under review) being moved
	to wells currently authorized under this right and GR-2992.
	b) If yes, would this proposed change, at its maximum allowed rate of use, likely result in another groundwater right not receiving the water to which it is legally entitled?
	☐ Yes ☒ No If yes, explain: <u>See 4a.</u>
5.	a) Will this proposed change, at its maximum allowed rate of use, likely result in an increase in interference with another surface water source ?
	☐ Yes ☐ No Comments: No proposed APOA is significantly closer to any surface
	water source than the existing authorized POA well.
	b) If yes, at its maximum allowed rate of use, what is the expected change in degree of interference with any surface water sources resulting from the proposed change?
	Stream: Owl Creek Minimal Significant
	Stream:
	Provide context for minimal/significant impact: None of the proposed APOA locations are significantly closer to Owl Creek than the authorized POA location.
6.	For SW-GW transfers, will the proposed change in point of diversion affect the surface water source similarly (as per OAR 690-380-2130) to the authorized point of diversion specified in the water use subject to transfer? \[\sum \text{Yes} \text{No} \text{Comments: NA} \]
7.	What conditions or other changes in the application are necessary to address any potential issues identified above: <u>None.</u>
8.	Any additional comments:

b) If yes, estimate the portion of the right supplied by each of the sources and describe any

Page 2 of 3 Version: 20201202

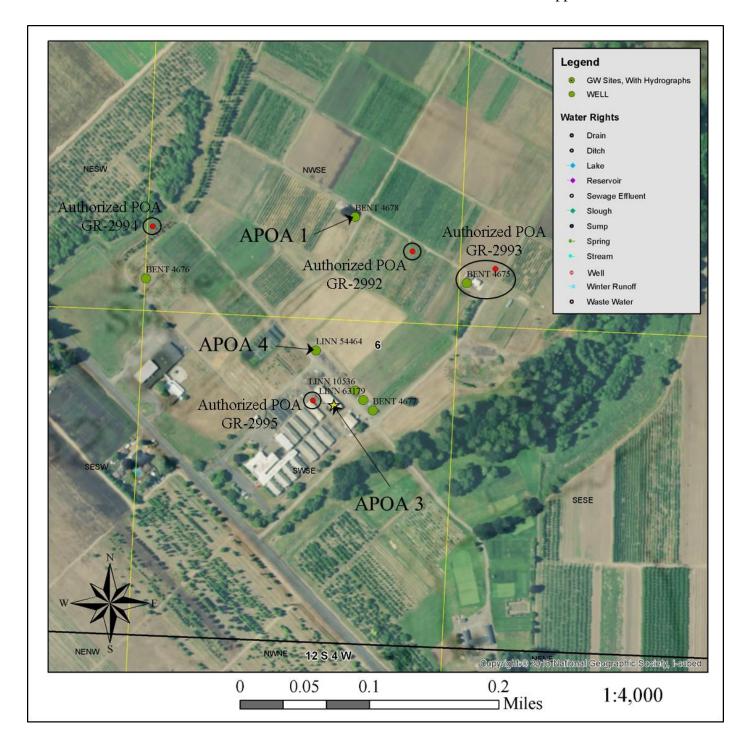

Page 3 of 3 Version: 20201202