

REVISED

T25S R33E, WM,
HARNEY COUNTY, OR



0 1,320 Feet

1" = 1320'

Received by OWRD

MAR 25 2021


Salem, OR

- ⊙ APOA Well
- Authorized Well
- POU IR
- Township
- Section
- Quarter Quarter
- Tax Lot


Well Locations:

Well #1 (HARN 50238/L-21128:
1324' S, 1349' W of NE Cor Sec 25

Well #2 (HARN 51629/L-84791:
100' S, 510' W of NE Cor Sec 25

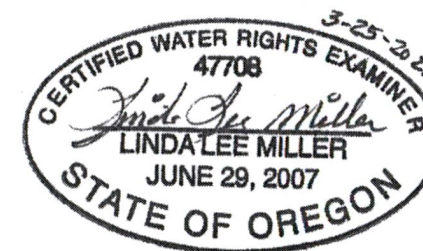

RENEWAL DATE 12/31/2022

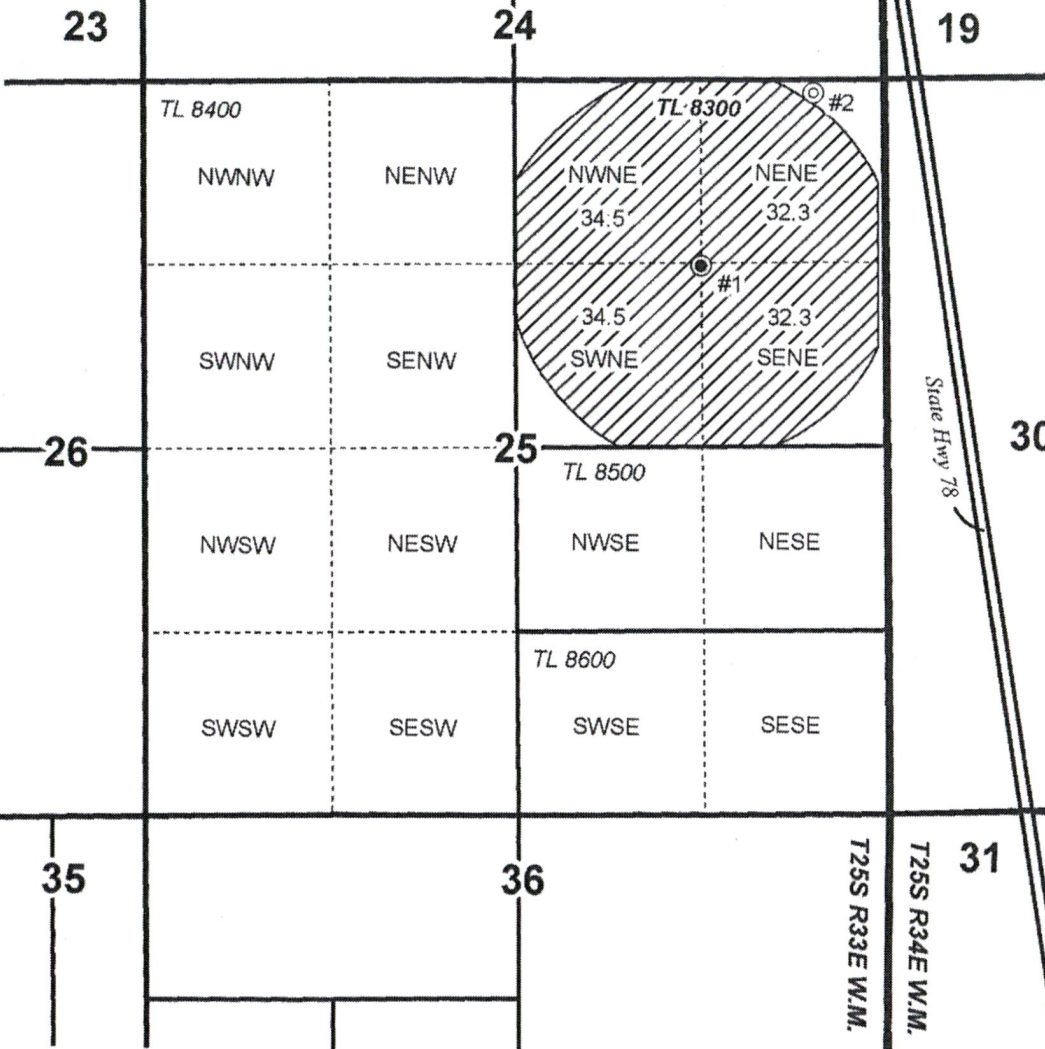

PERMANENT APOA TRANSFER MAP
BOWYER-PECK RANCHES, LLC

C-90398

Date: 3/24/2021

This map is not intended
to provide legal dimensions
or locations of property
ownership lines.

WATER RIGHT SERVICES, LLC
PO BOX 1830, BEND, OR 97709
WWW.OREGONWATER.US CCB # 197121
johnshort@usa.com 541-389-2837