



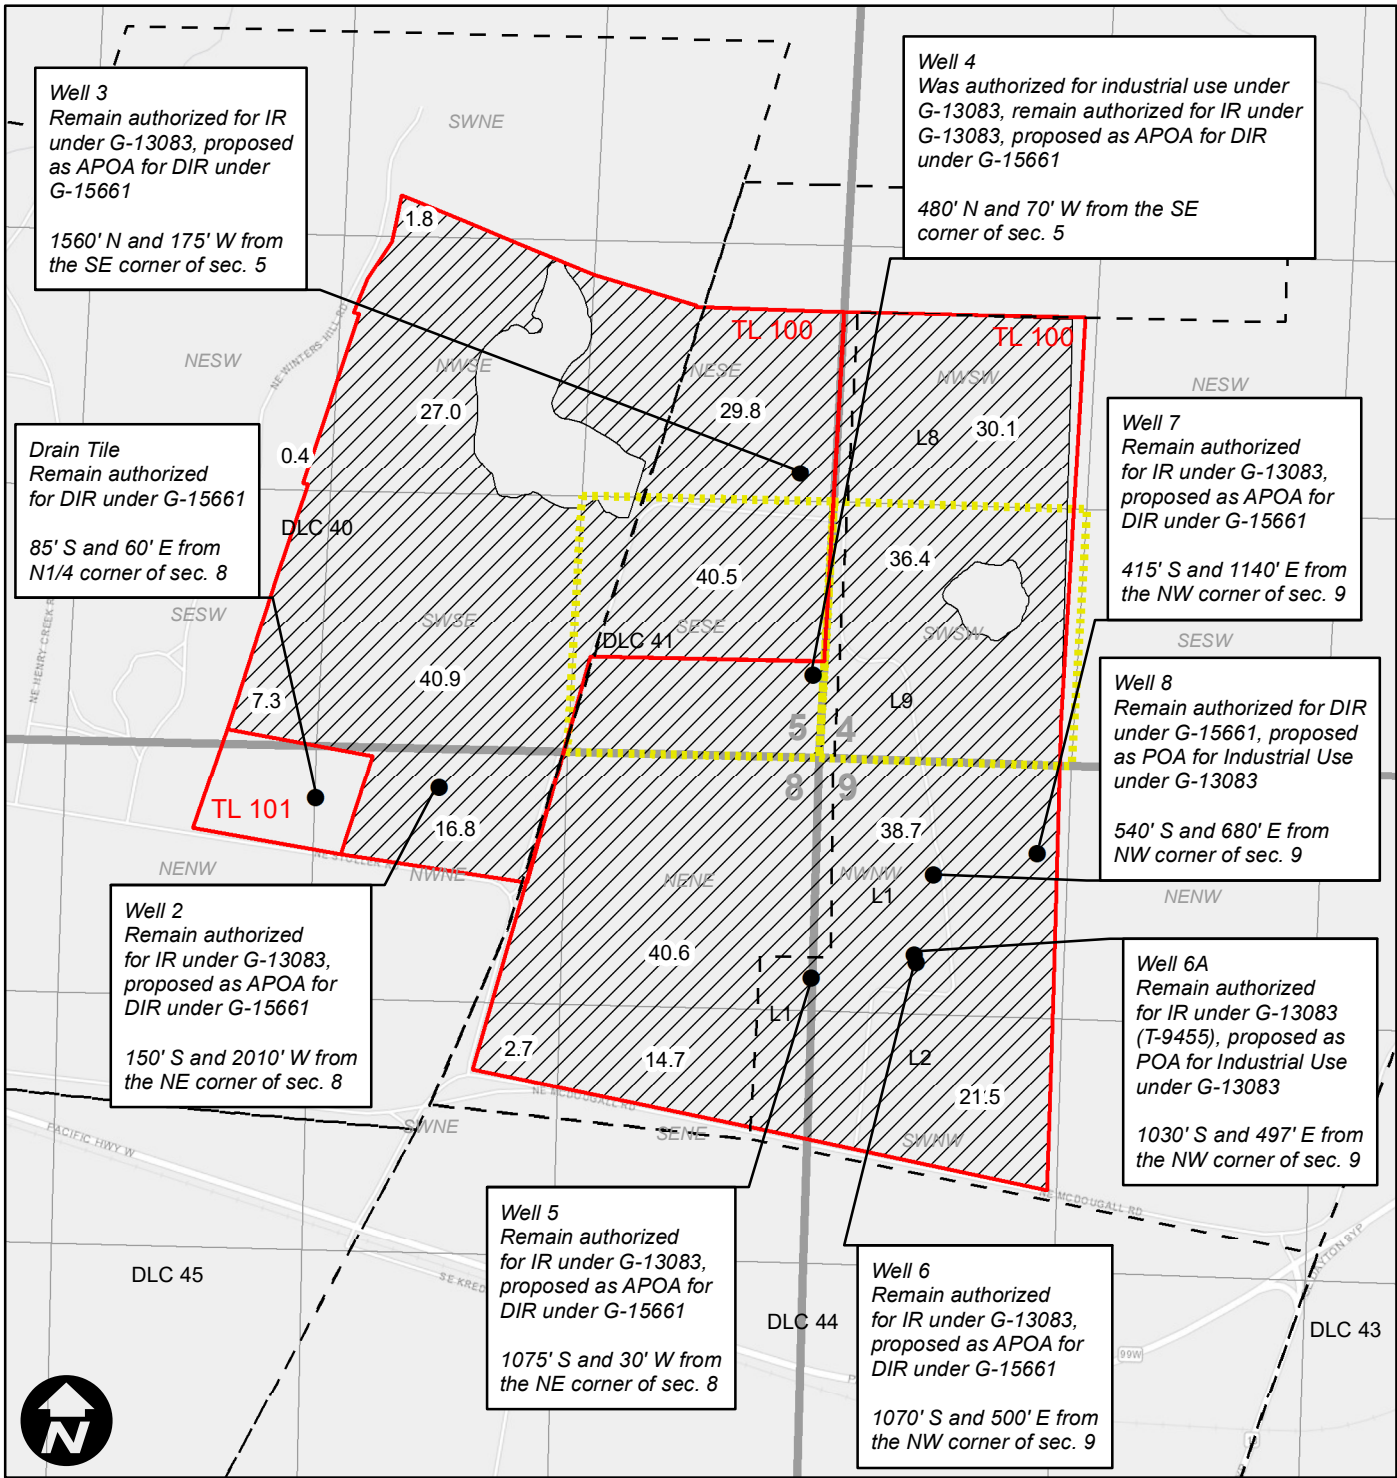


# Permit Amendment William H. Stoller / Red Hills Farm LLC Permits G-13083 & G-15661

Township 4S, Range 3W, W.M.

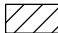

### Legend

-  IR Place of Use G-13083 & G-15661
-  Industrial (Winery) Place of Use G-13083
-  Tax Lot
-  DLC