



TRANSFER T-13471 MEASURING DEVICE PLAN  
 SECTION 26, 27, & 34, TOWNSHIP 25 SOUTH, RANGE 12 WEST, W.M.  
 COOS COUNTY, OREGON

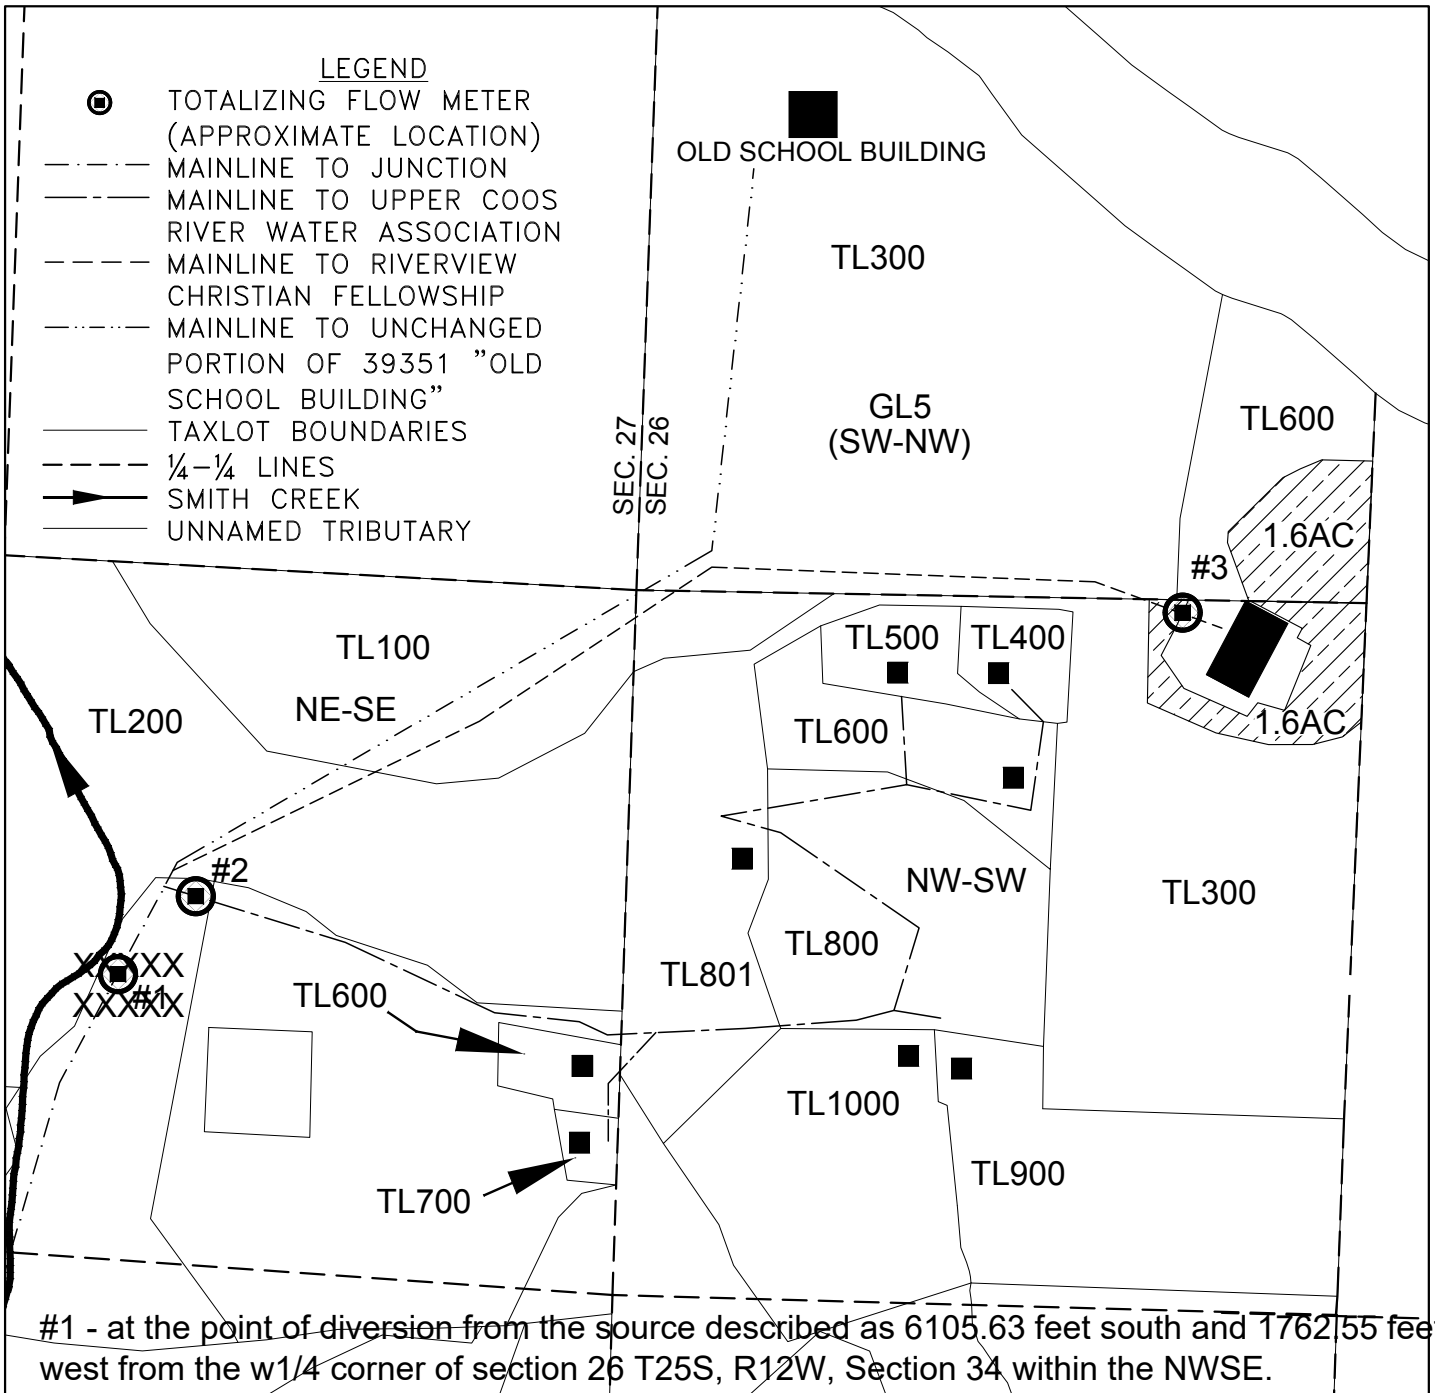

SCALE: 1" = 400'

DISCLAIMER: THIS MAP WAS PREPARED FOR THE PURPOSE OF IDENTIFYING THE LOCATION OF WATER RIGHT ONLY AND IS NOT INTENDED TO PROVIDE LEGAL DESCRIPTIONS OR LOCATIONS OF PROPERTY LINES.

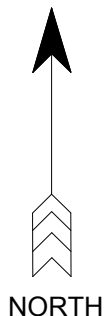

P.O. Box 995  
 Coos Bay, OR 97420  
 (541) 297-1880  
 vancampconsulting@gmail.com

Prepared For:  
 Upper Coos River Water Association  
 64170 Solari Rd.  
 Coos Bay, OR 97420

Project:  
 T-13471 Measurement Device Plan

Date: 12/10/2020