


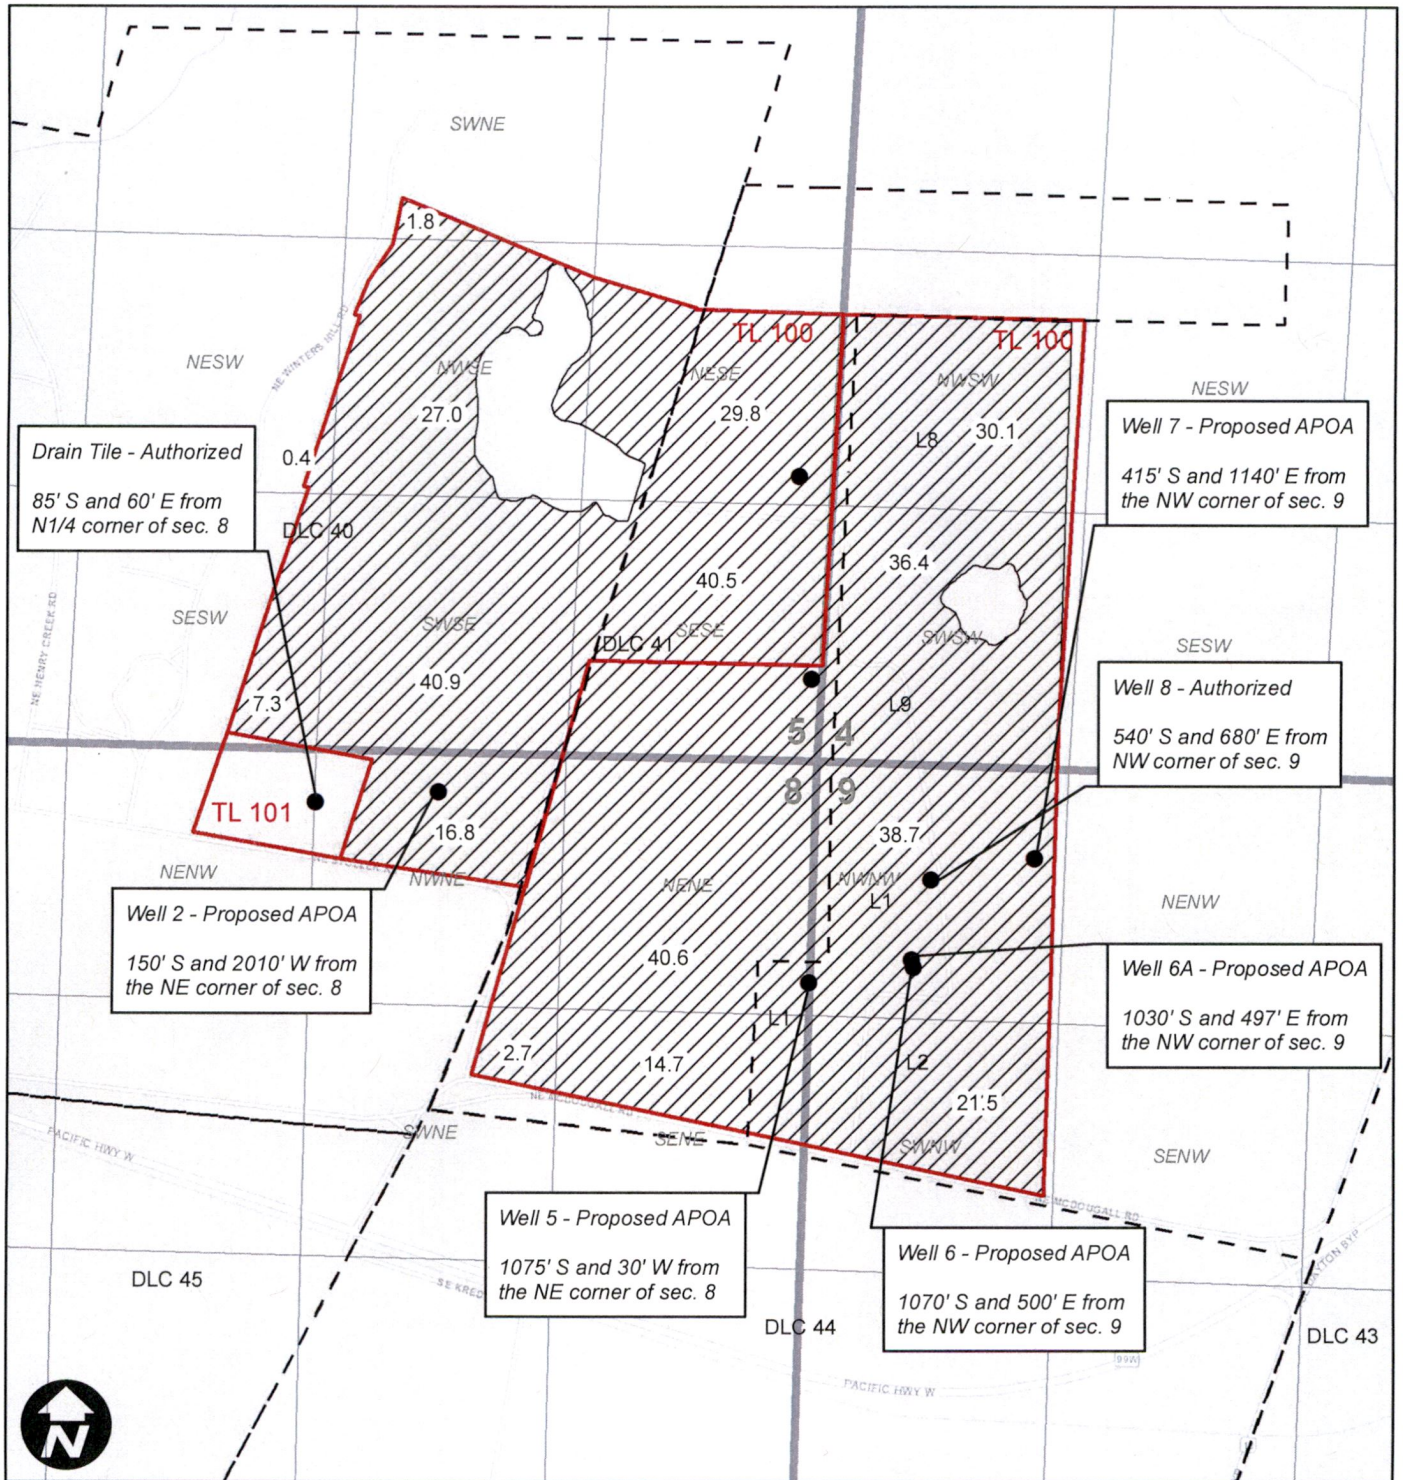


Permit Amendment William H. Stoller / Red Hills Farm LLC Permits G-15661

Township 4S, Range 3W, W.M.



Legend

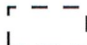-  DIR Place of Use G-15661
-  Tax Lot
-  DLC

Received by OWRD

APR 21 2021

Salem, OR

