


CERTIFIED WATER RIGHT EXAMINER
85503
JOANN HAMILTON
MAY 10, 2012
STATE OF OREGON
16 APR 30, 2023

T.2S. R.4E. Section 21, W.M.

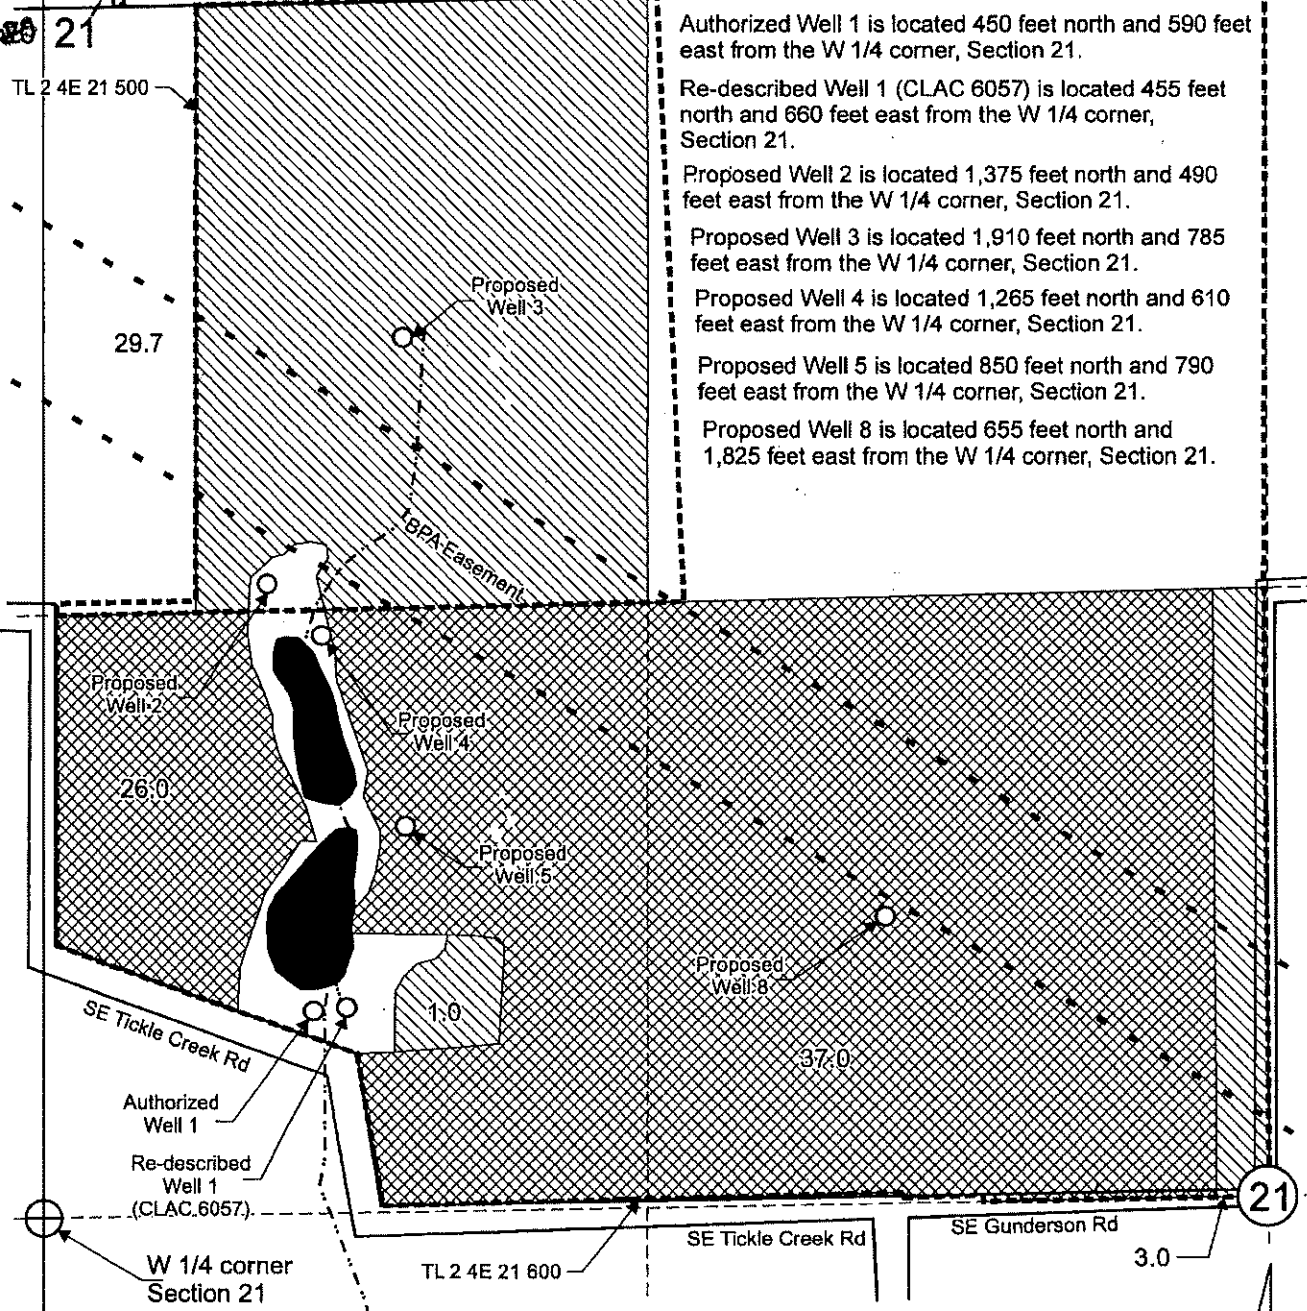

Authorized Well 1 is located 450 feet north and 590 feet east from the W 1/4 corner, Section 21.

Re-described Well 1 (CLAC 6057) is located 455 feet north and 660 feet east from the W 1/4 corner, Section 21.

Proposed Well 2 is located 1,375 feet north and 490 feet east from the W 1/4 corner, Section 21.

Proposed Well 3 is located 1,910 feet north and 785 feet east from the W 1/4 corner, Section 21.

Proposed Well 4 is located 1,265 feet north and 610 feet east from the W 1/4 corner, Section 21.

Proposed Well 5 is located 850 feet north and 790 feet east from the W 1/4 corner, Section 21.

Proposed Well 8 is located 655 feet north and 1,825 feet east from the W 1/4 corner, Section 21.

----- Tax lot boundary

..... Water main line

Scale: 1" = 400'

0 400 800 Feet

Unnamed tributary to Deep Creek

Area (33.7 Acres) of primary irrigation under Certificate 65961, priority date, 5-18-1982, affected by this transfer.

Area (63.0 Acres) of supplemental irrigation under Certificate 65961, priority date, 5-18-1982, affected by this transfer. Primary Certificate 24380 & 24381.

This map was prepared for the purpose of identifying the location of a water right only and is not intended to provide legal dimensions or location of property ownership lines.

Pacific Hydro-Geology Inc.

11/2020
Rev. 06/2021

Transfer Application Map
Certificate 65961

Townsend HB LLC
T.2S. R.4E. Section 21, W.M.

TownsendCert65961TransMap.cdr