



Helm Instream Lease Tax lot 1200

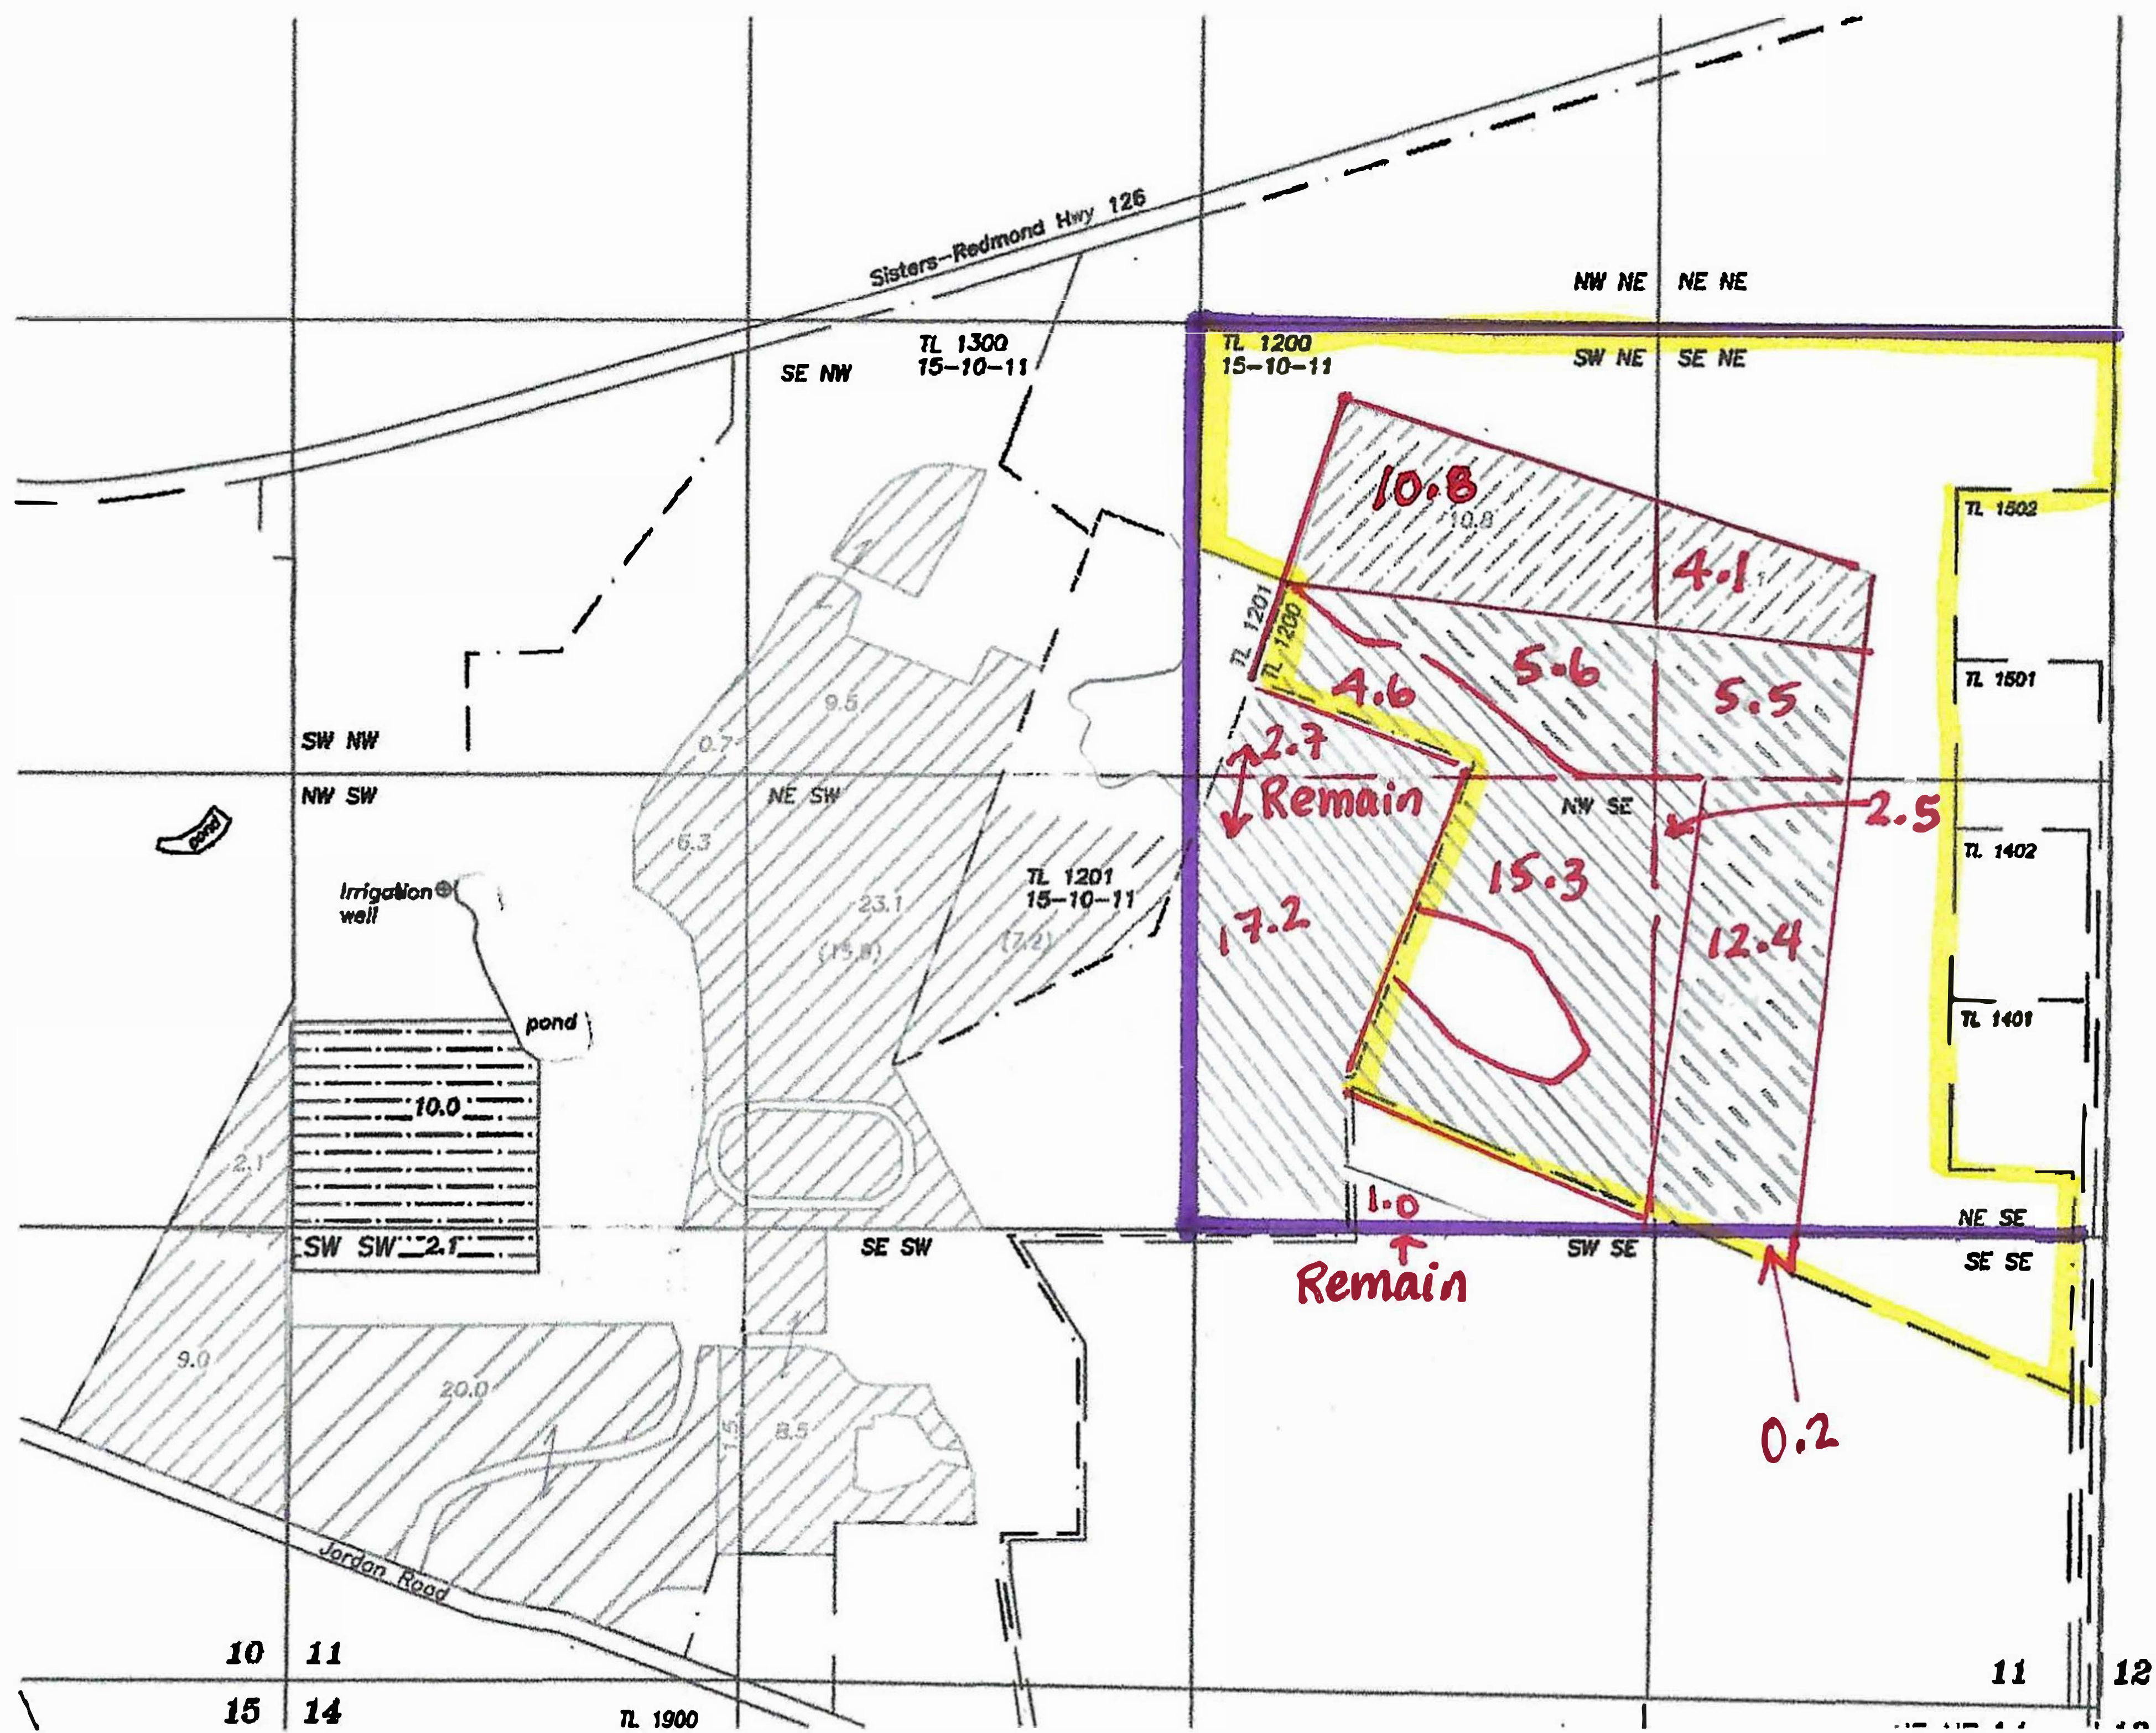

Water Rights Summary
 Tax Lots 1300, 1200, 1201
 Portions of Sections 10 & 11
 T15S, R10E, W.M
 Deschutes County, Oregon

- Parcel boundary
- Approximate well location
- Three Sisters ID water 20.0 acres
Priority date 1889
- Three Sisters ID water 71.2 acres
Priority date 1895
- Cert. 74135
Priority date 1903
- Cert. 93690
Priority date 1908
- Cert. 93692
Priority date 1912
- Cert. 93688
Priority date 1908
- Cert. 85431 (groundwater)
Priority date 8/25/1970

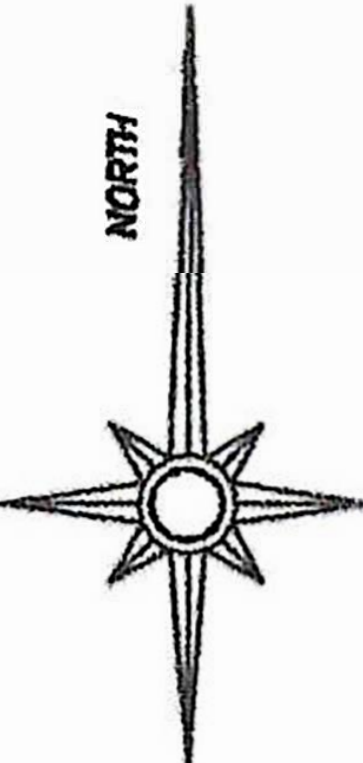

T15S, R10E, W.M.
 Deschutes County Oregon

