

TOWNSHIP 1 SOUTH RANGE 38 EAST, W.M.

SECTION 21

SECTION 22

RECEIVED

JUL 14 2021


OWRD

NWSW

NESE

NWSE

Tax Lot 1000

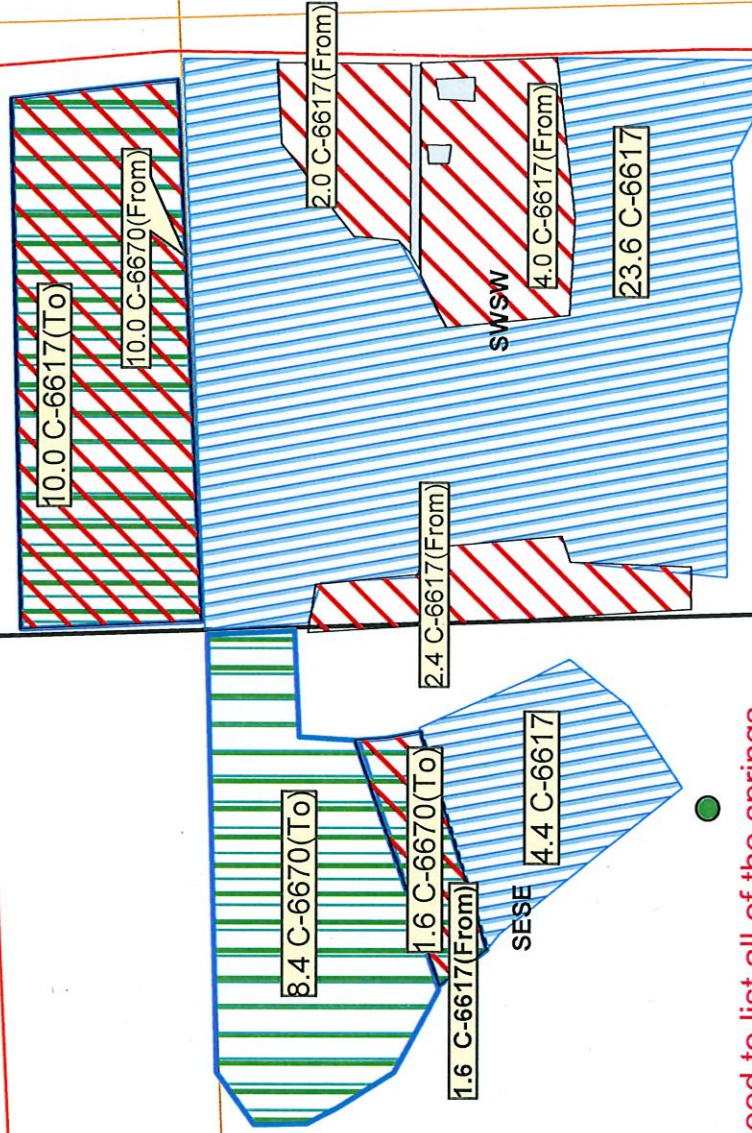

Need to list all of the springs associated with Cert 6617

SECTION 27

NWNW

Legend

5 YEAR TEMPORARY TRANSFER
IN THE NAME OF TERRY AND
SANDRA MCCOY

REVISED Date: 6/15/2021

1 inch = 400 feet



Point of Diversion for Cert 6617
and is located in SESE,
Section 21, T 1S R 38E



Point of Diversion for Cert 6670
and is located in NESE,
Section 21, T 1S R 38E



From Lands CERTS 6617
& 6670

To Lands CERTS 6617
& 6670

Remaining Rights CERTS
6617

This product is for informational purposes
and may not have been prepared for, or be
suitable for legal, engineering, or surveying
purposes. Users of this information should
review or consult the primary data and
information sources to ascertain the usability
of the information.

TOWNSHIP 1 SOUTH RANGE 38 EAST, W.M.

SECTION 21

SECTION 22

Tax Lot 1000

NESE

SESE

10.0 C-6617(To)

10.0 C-6670(From)

8.4 C-6670(To)

1.6 C-6670(To)

1.6 C-6617(From)

4.4 C-6617

2.4 C-6617(From)

2.0 C-6617(From)

4.0 C-6617(From)

23.6 C-6617

SWSW

Legend

5 YEAR TEMPORARY TRANSFER
IN THE NAME OF TERRY AND
SANDRA McCOY

REVISED Date: 6/15/2021

1 inch = 400 feet



Point of Diversion for Cert 6617
and is located in SESE, ●
Section 21, T 1S R 38E

Point of Diversion for Cert 6670
and is located in NESE, ▲
Section 21, T 1S R 38E

From Lands CERTS 6617
& 6670

To Lands CERTS 6617
& 6670

Remaining Rights CERTS
6617

This product is for informational purposes
and may not have been prepared for, or be
suitable for legal, engineering, or surveying
purposes. Users of this information should
review or consult the primary data and
information sources to ascertain the usability
of the information.

RECEIVED
JUL 14 2021
TOWNSHIP

SECTION 27