




# DESCHUTES COUNTY, OR T22S R10E, WM



0 400 Feet  
1" = 400'

RENEWAL DATE 12/31/2022

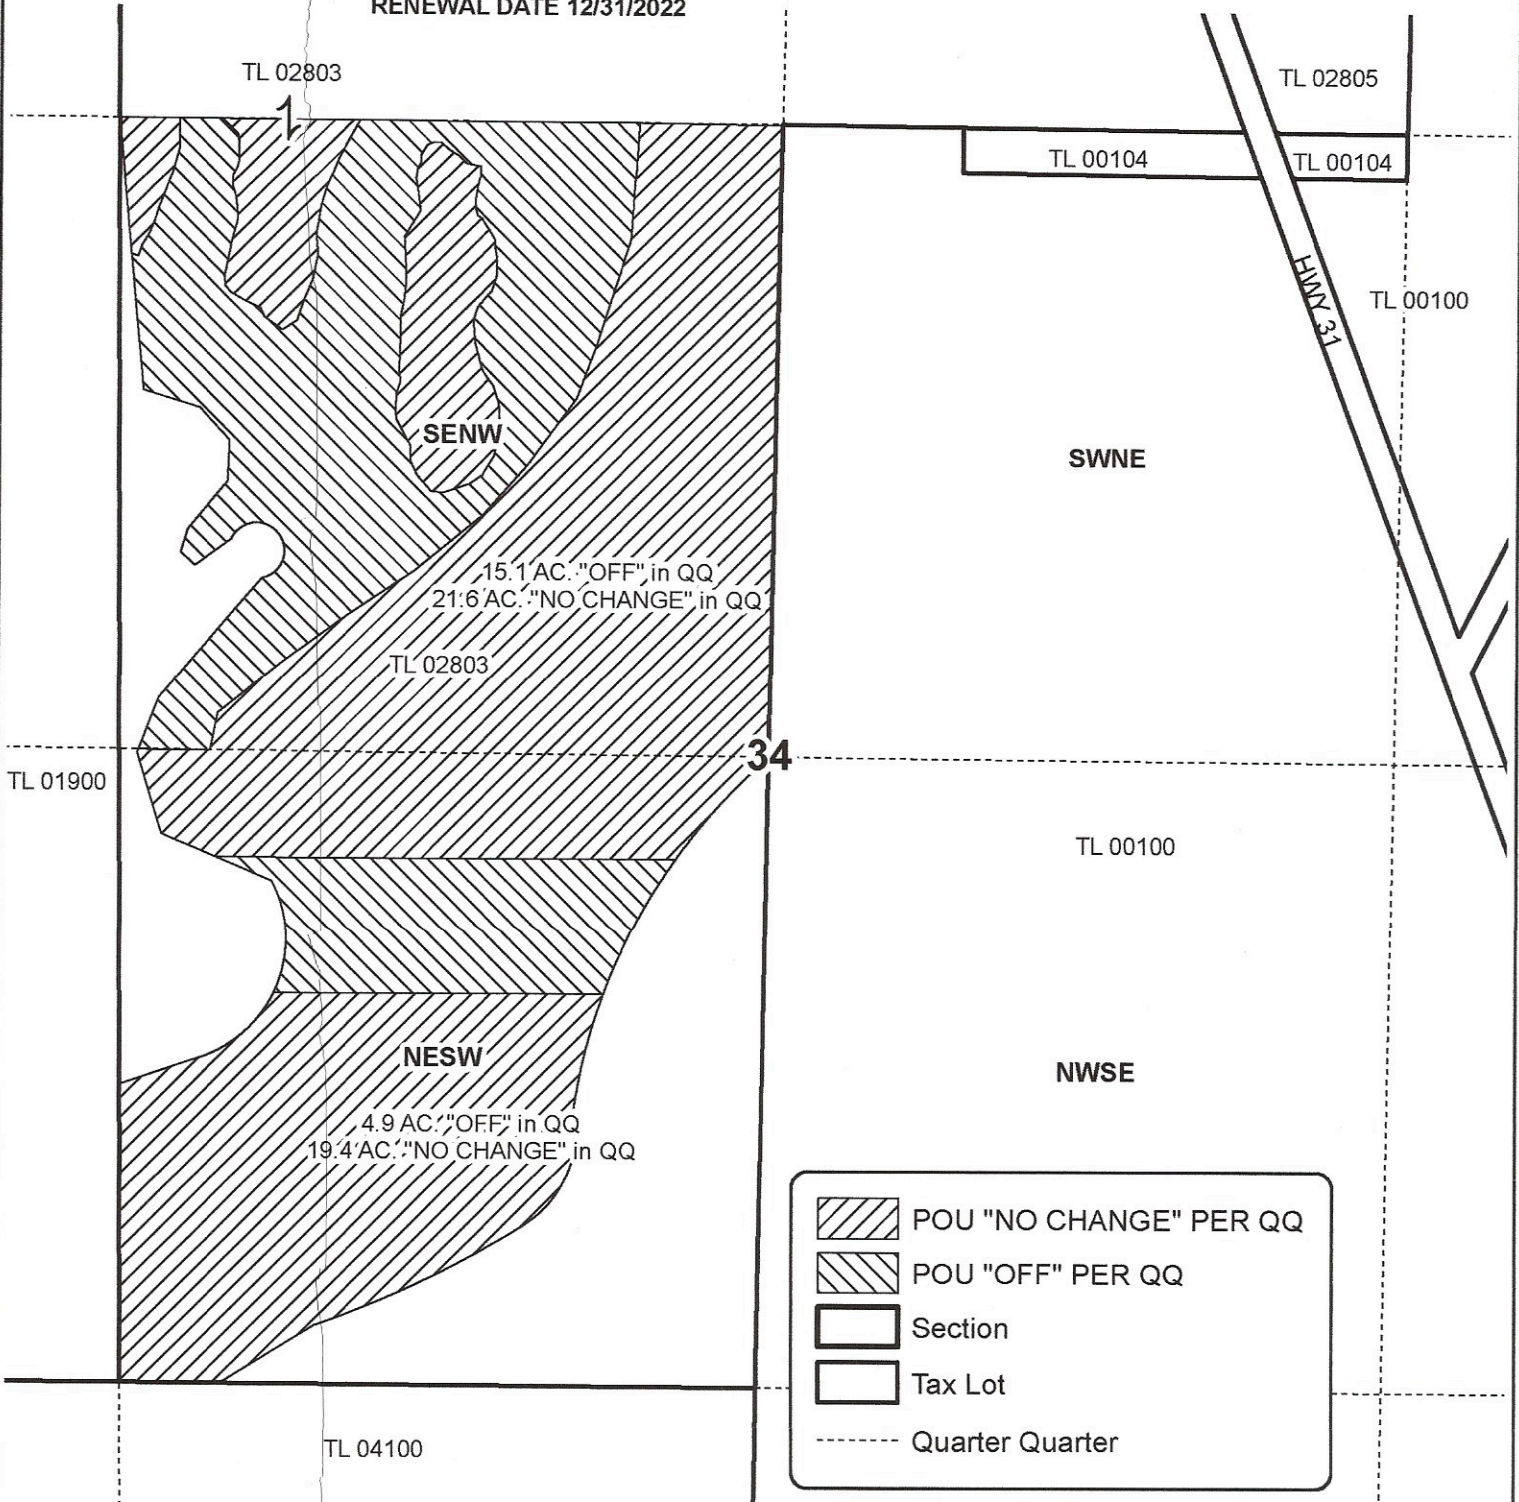

	POU "NO CHANGE" PER QQ
	POU "OFF" PER QQ
	Section
	Tax Lot
	Quarter Quarter

**INSTREAM TRANSFER OFF MAP**  
**James & Jean Verheyden**

This map is not intended to provide legal dimensions or locations of property ownership lines.

**WATER RIGHT SERVICES, LLC**

PO BOX 1830, BEND, OR 97709

**WWW.OREGONWATER.US 541-389-2837**

johnshort@usa.com

CCB # 197121

Date: 9/8/2021

C-90239