


RECEIVED

SEP 28 2021

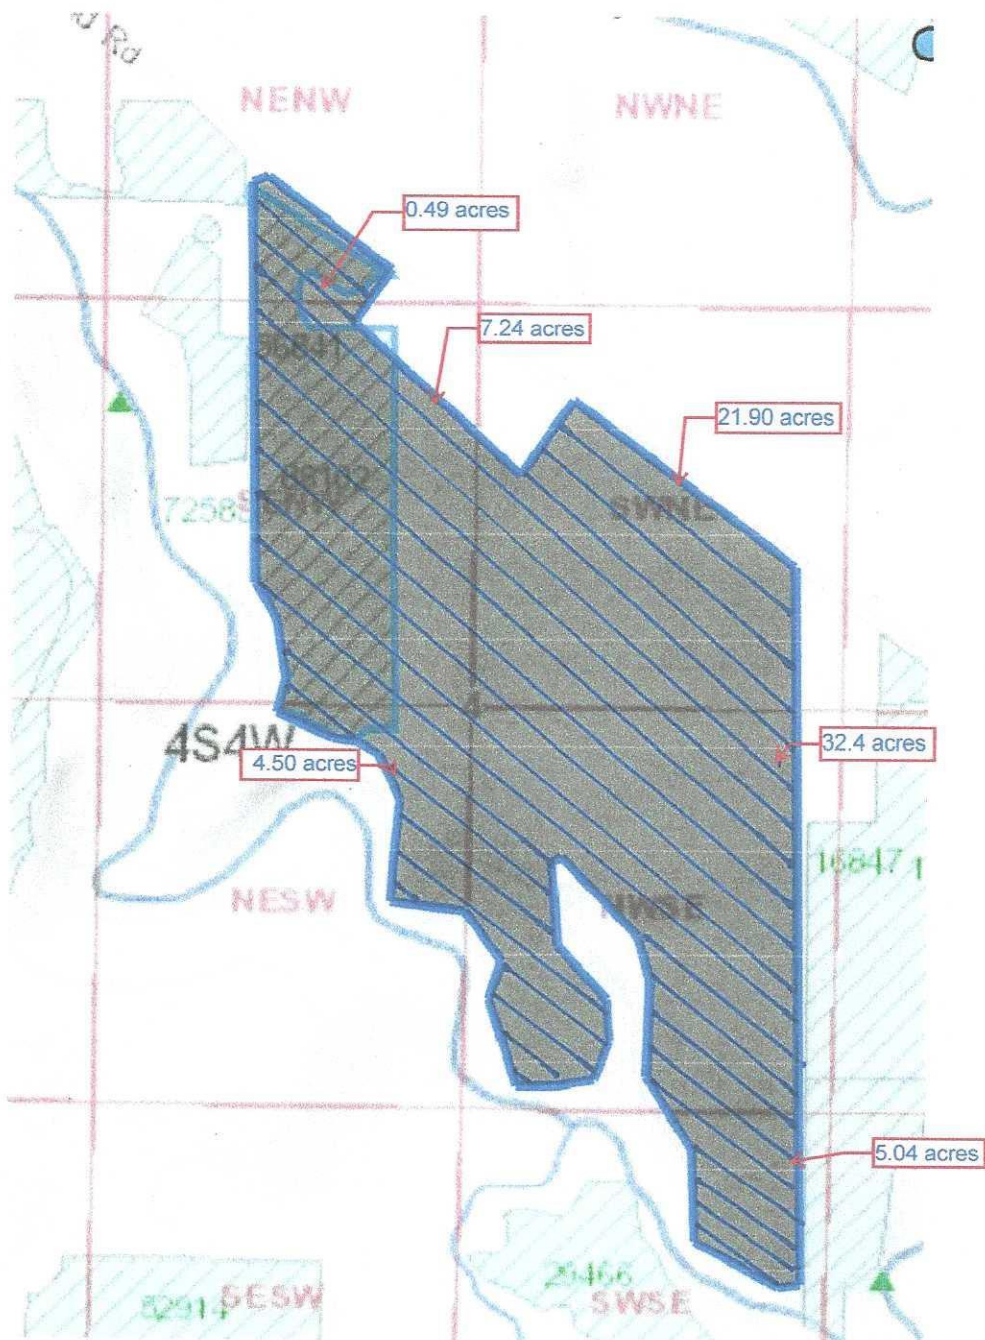

Certificate 88102	18.3 acres
Additional acres	<u>71.57 acres</u>
Total	89.87 acres