

RECEIVED

SEP 29 2021

OWRD



Oregon Water Resources Department
725 Summer Street NE, Suite A
Salem, Oregon 97301
(503) 986-0900
www.wrd.state.or.us

Request for Assignment By Proof of Ownership (If Water Right Holder is Not Available)

If the Department determines that the application is incomplete, fees have not been paid, or the required documents are not acceptable, the application and all fees submitted will be returned to the applicant.

If for multiple rights, a separate form and fee for each right will be required.

1. GREGORY COLONIA RACHELLE LEQUERICA
(Name of Party Requesting Assignment)
64028 MT GLEN RD LAGRANGE OR 97850 541-910-9100
(Mailing Address) (City) (State) (Zip) (Phone #)

NO ☒ I hereby request assignment of an entire application/permit/transfer/limited license/groundwater statement; hereby request assignment of a portion of application/permit/transfer/limited license/groundwater statement; (You must include a map showing the portion of the application/permit/transfer/limited license/groundwater statement to be assigned.)

Application # _____; Permit # _____; Transfer # T-8323;

Limited License # _____; Groundwater Statement # _____;

GARY PRICE (DECEASED) AND JOANNE PRICE
(Name of Current Holder of Record)
6374 MT GLEN RD LAGRANGE OR 97850 N/A
(Mailing Address) (City) (State) (Zip) (Phone #)

Note: Write the initials (first letters) of your first and last names at the spots indicated below GC.

- 1) GC I certify that I am the current owner of the property described in this application, permit, transfer order, limited license, or groundwater statement. I have attached proof of ownership that may include but not be limited to: a copy of the deed to the land, a copy of a land sales contract, a court order or decree, documentation of survivorship of property held jointly. The Department cannot accept a copy of a tax statement.
- 2) GC I have the legal right to request assignment under OAR 690-310-0280 and 690-320-0060.
- 3) GC I have not been able to contact the owner(s) of record for the above referenced transaction. I have attached proof acceptable to the Department that notice of the assignment has been given or attempted for each identified property owner not a party to the assignment. ORS 537.220(2) Failure to submit this proof will result in the return of your request. (Proof may include but not be limited to: a copy of returned certified mailing, copy of a Death Certificate, or a court order.)
- 4) GC I further certify that the information provided herein is true and correct to the best of my knowledge.

Witness my hand this 22 day of JUNE, 2021.
(Day) (Month) (Year)

Signature of Party Requesting Assignment Rachelle Lequerica


Failure to provide any of the required information will result in the return of your application.

This certifies assignment and record change at Oregon Water Resources Department effective 8:00 a.m. on date of receipt at Salem, Oregon.
Fee receipt # 135046
For Director by Mary Bjork, Program Analyst in Water Rights Division. MJB

The completed "Request for Assignment" form must be submitted to the Department along with the recording fee of \$100.

RECEIVED
JUN 25 2021
OWRD


Approved by Proof - Approve
7-16-2021
HJB

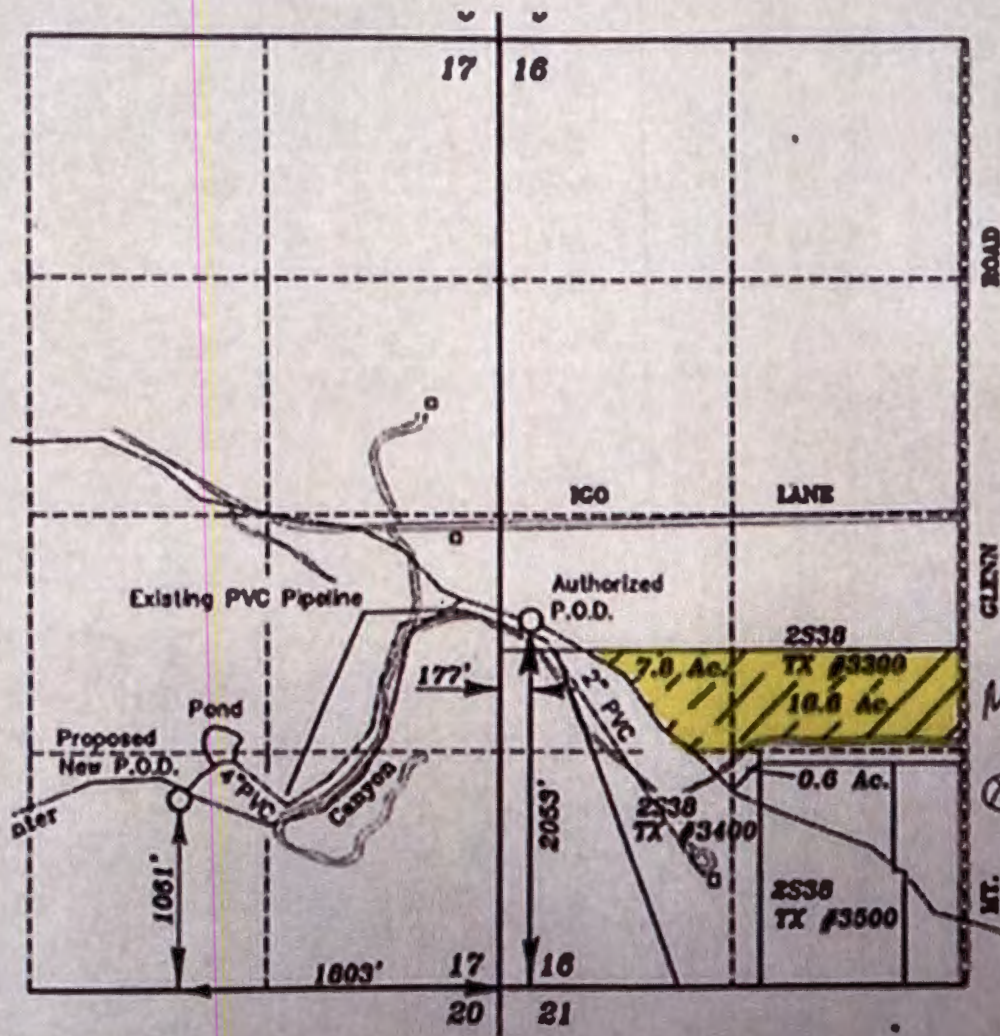

RECEIVED
SEP 29 2021
OWRD

MAP IS CORRECT

ⓧ *[Signature]*

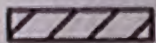

Water irrigated under Permit number 20009.
Certificate number 27149.