


Water Right Place of Use Map

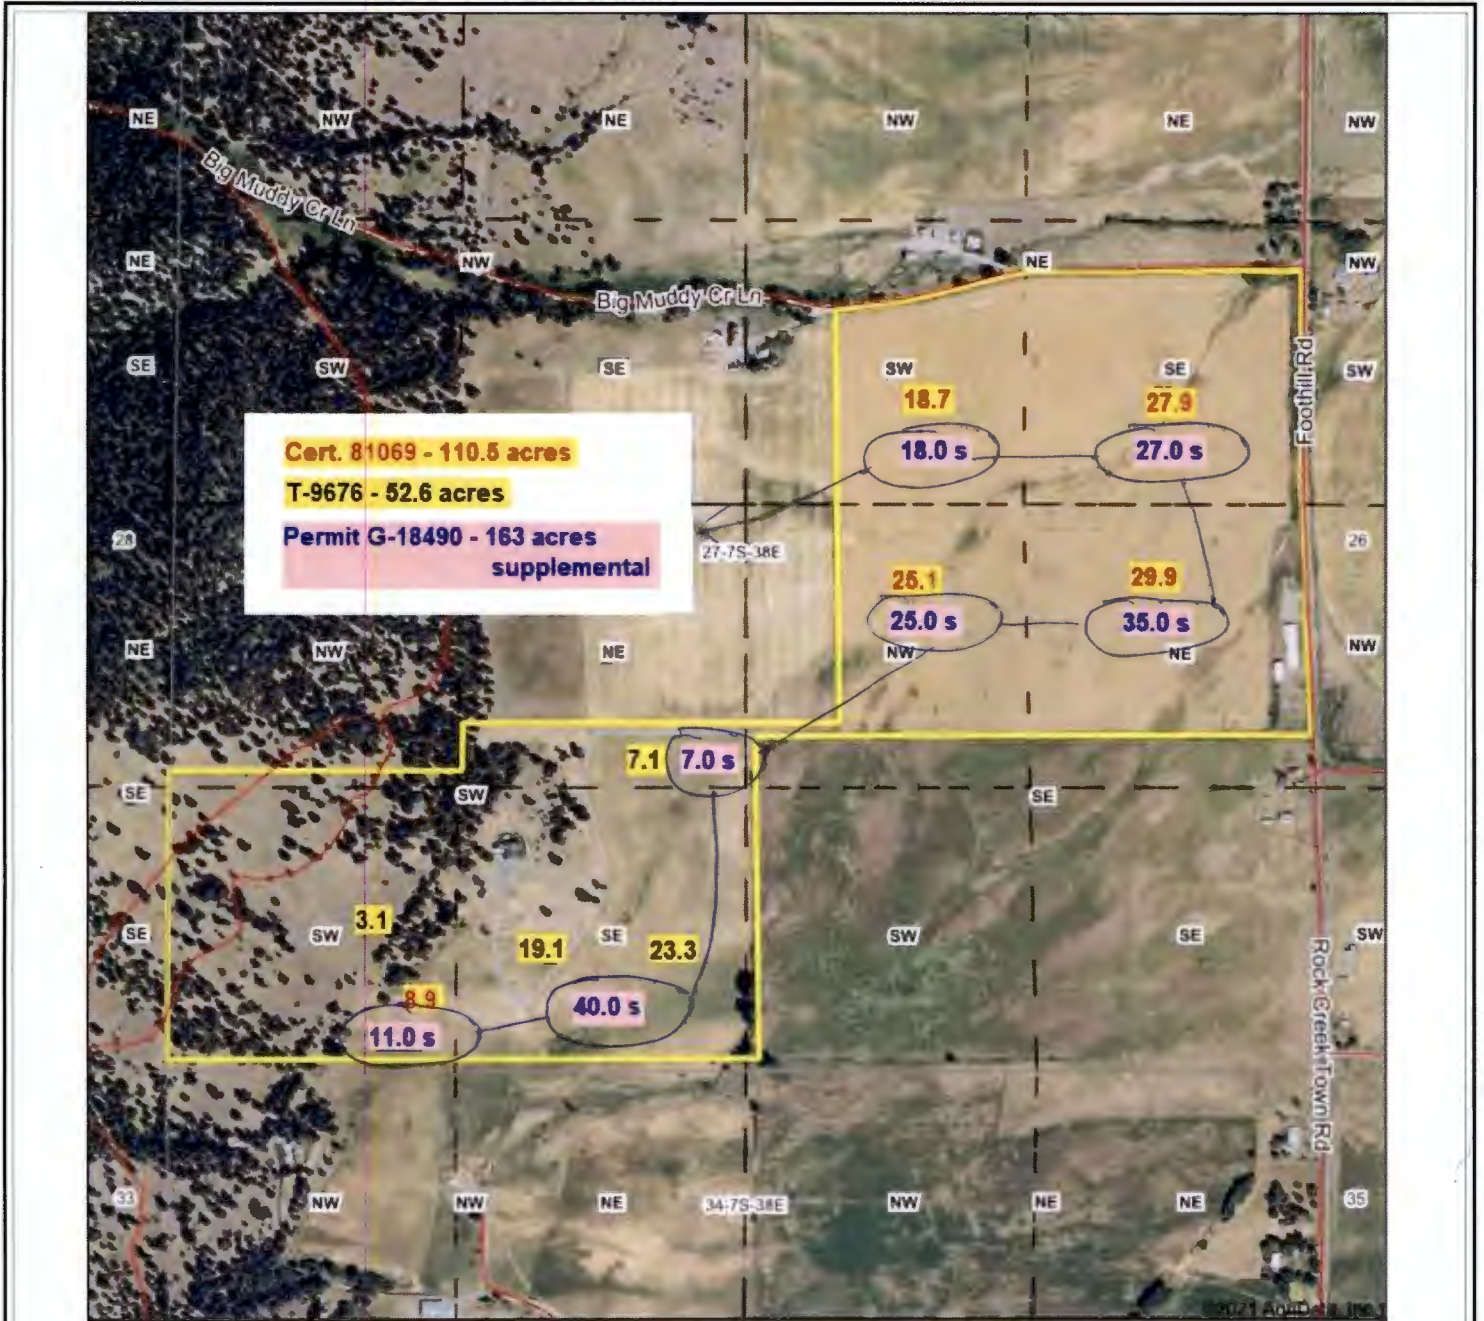

Cert. 81069 - 110.5 acres
T-9676 - 52.6 acres
Permit G-18490 - 163 acres supplemental

Map Center: 44° 55' 28.25, -118° 2' 40.12



27-7S-38E
Baker County
Oregon

RECEIVED
SEP 02 2021

RECEIVED
SEP 21 2021
OWRD
 4/14/2021