

# Request for Assignment



Oregon Water Resources Department  
 725 Summer Street NE, Suite A  
 Salem, Oregon 97301-1266  
 (503) 986-0900  
[www.oregon.gov/owrd](http://www.oregon.gov/owrd)

If the Department determines that the application is incomplete, fees have not been paid, or the required documents are not acceptable, the application and all fees submitted will be returned to the applicant.

RECEIVED

AUG 31 2021

If for multiple rights, a separate form and fee for each right will be required.

I, Big Falls Ranch Co.  
 (Name of Current Holder of Record)  
PO Box 434 Terrebonne, OR 97760 541-948-6325  
 (Mailing Address) (City) (State) (Zip) (Phone #)

OWRD

- hereby assign all my interest in and to the entire application/permit/transfer order/limited license/groundwater statement; (example, sold all the land authorized under the right)
- hereby assign all my interest in and to a portion of application/permit/transfer order/limited license/groundwater statement; (*You must include a map showing the portion of the application/permit/transfer order/limited license/groundwater statement to be assigned.* Example, sold a portion of the land authorized under the right)
- hereby assign a portion of my interest in and to the entire application/permit/transfer order/limited license/groundwater statement; (example, adding an additional person)

Application # \_\_\_\_\_; Permit # \_\_\_\_\_; Transfer Order # T-12651 (Cert. 88027);  
 Limited License # \_\_\_\_\_; Groundwater Statement # \_\_\_\_\_;

as filed in the office of the Water Resources Director, to:

Pinnacle Utilities, LLC (Kameron DeLashmutt, Member)

(Name of New Owner)  
2447 NW Canyon Drive Redmond, OR 97756 541-350-8479  
 (Mailing Address) (City) (State) (Zip) (Phone #)

**Note:** If there are other owners of the property described in the application, permit, transfer order, limited license, or groundwater statement, you must provide a list of all other owners' names and mailing addresses and attach it to this form. Write the initials (first letters) of your first and last names at the spot indicated below.

RB I hereby certify that I have notified all other owners of the property described in this application, permit, transfer order, limited license, or groundwater statement of this Request of Assignment.

Witness my hand this 24 day of August, 2021.  
 (Day) (Month) (Year)

Signature of Current Holder of Record [Signature]

**Failure to provide any of the required information will result in the return of your application.**

Part. Ass: 21- APPROVE  
MJB 9-24-2021

This certifies assignment and record change at Oregon Water Resources Department effective 8:00 a.m. on date of receipt at Salem, Oregon.  
 Fee receipt # 136314  
 For Director by Mary F. Bjork, Program Analyst in Water Rights Division. MJB

The completed "Request for Assignment" form *must* be submitted to the Department along with the recording fee of \$120.

# Request for Assignment

RECEIVED

AUG 31 2021

OWRD

OREGON



WATER RESOURCES DEPARTMENT

Oregon Water Resources Department  
725 Summer Street NE, Suite A  
Salem, Oregon 97301-1266  
(503) 986-0900  
[www.oregon.gov/owrd](http://www.oregon.gov/owrd)

If the Department determines that the application is incomplete, fees have not been paid, or the required documents are not acceptable, the application and all fees submitted will be returned to the applicant.

If for multiple rights, a separate form and fee for each right will be required.

I, Big Falls Ranch Co. (certificate originally in name of Deschutes Valley Farms)  
(Name of Current Holder of Record)  
PO Box 434 Terrebonne, OR 97760 541-948-6325  
(Mailing Address) (City) (State) (Zip) (Phone #)

- hereby assign all my interest in and to the entire application/permit/transfer order/limited license/groundwater statement; (example, sold all the land authorized under the right)
- hereby assign all my interest in and to a portion of application/permit/transfer order/limited license/groundwater statement; (*You must include a map showing the portion of the application/permit/transfer order/limited license/groundwater statement to be assigned.* Example, sold a portion of the land authorized under the right)
- hereby assign a portion of my interest in and to the entire application/permit/transfer order/limited license/groundwater statement; (example, adding an additional person)

Application # \_\_\_\_\_; Permit # \_\_\_\_\_; Transfer Order # T-12651 (Cert. 76371)  
Limited License # \_\_\_\_\_; Groundwater Statement # \_\_\_\_\_

as filed in the office of the Water Resources Director, to:

Pinnacle Utilities, LLC (Kameron DeLashmutt, Member)  
(Name of New Owner)  
2447 NW Canyon Drive Redmond, OR 97756 541-350-8479  
(Mailing Address) (City) (State) (Zip) (Phone #)

**Note:** If there are other owners of the property described in the application, permit, transfer order, limited license, or groundwater statement, you must provide a list of all other owners' names and mailing addresses and attach it to this form. Write the initials (first letters) of your first and last names at the spot indicated below.

RB I hereby certify that I have notified all other owners of the property described in this application, permit, transfer order, limited license, or groundwater statement of this Request of Assignment.

Witness my hand this 24 day of August, 20 21.  
(Day) (Month) (Year)

Signature of Current Holder of Record [Signature]

**Failure to provide any of the required information will result in the return of your application.**

Part. Assign. - Approve  
HOB 9-24-2021

This certifies assignment and record change at Oregon Water Resources Department effective 8:00 a.m. on date of receipt at Salem, Oregon.  
Fee receipt # 136314  
For Director by Mary F. Bjork, Program Analyst in Water Rights Division. MFB

The completed "Request for Assignment" form *must* be submitted to the Department along with the recording fee of \$120.

RECEIVED

AUG 31 2021

OWRD


**WATER RIGHT TRANSFER MAP  
CHANGE IN POD TO POA**

Located in Sections 3, 4, 8, 9, 17, 18, and 20,  
Township 14 South, Range 12 East, Willamette Meridian  
Deschutes County, Oregon

**NOTES**

1. This map was prepared for the purpose of identifying the location of water rights only and is not intended to provide legal dimensions or locations of property ownership lines.
2. This map is based on Claim of Beneficial Use Map submitted with the COBU prepared by Newton Consultants, Inc., May 2012.
3. Tax lot lines are based on Deschutes County Assessor Maps dated Feb. 2, 2010.
4. Acres irrigated are identified in each 1/4-1/4 by total acres and by Tax Lot.
5. Place of Use and Character of Use will not Change.

RECEIVED  
APR 21 2017  
OWRD

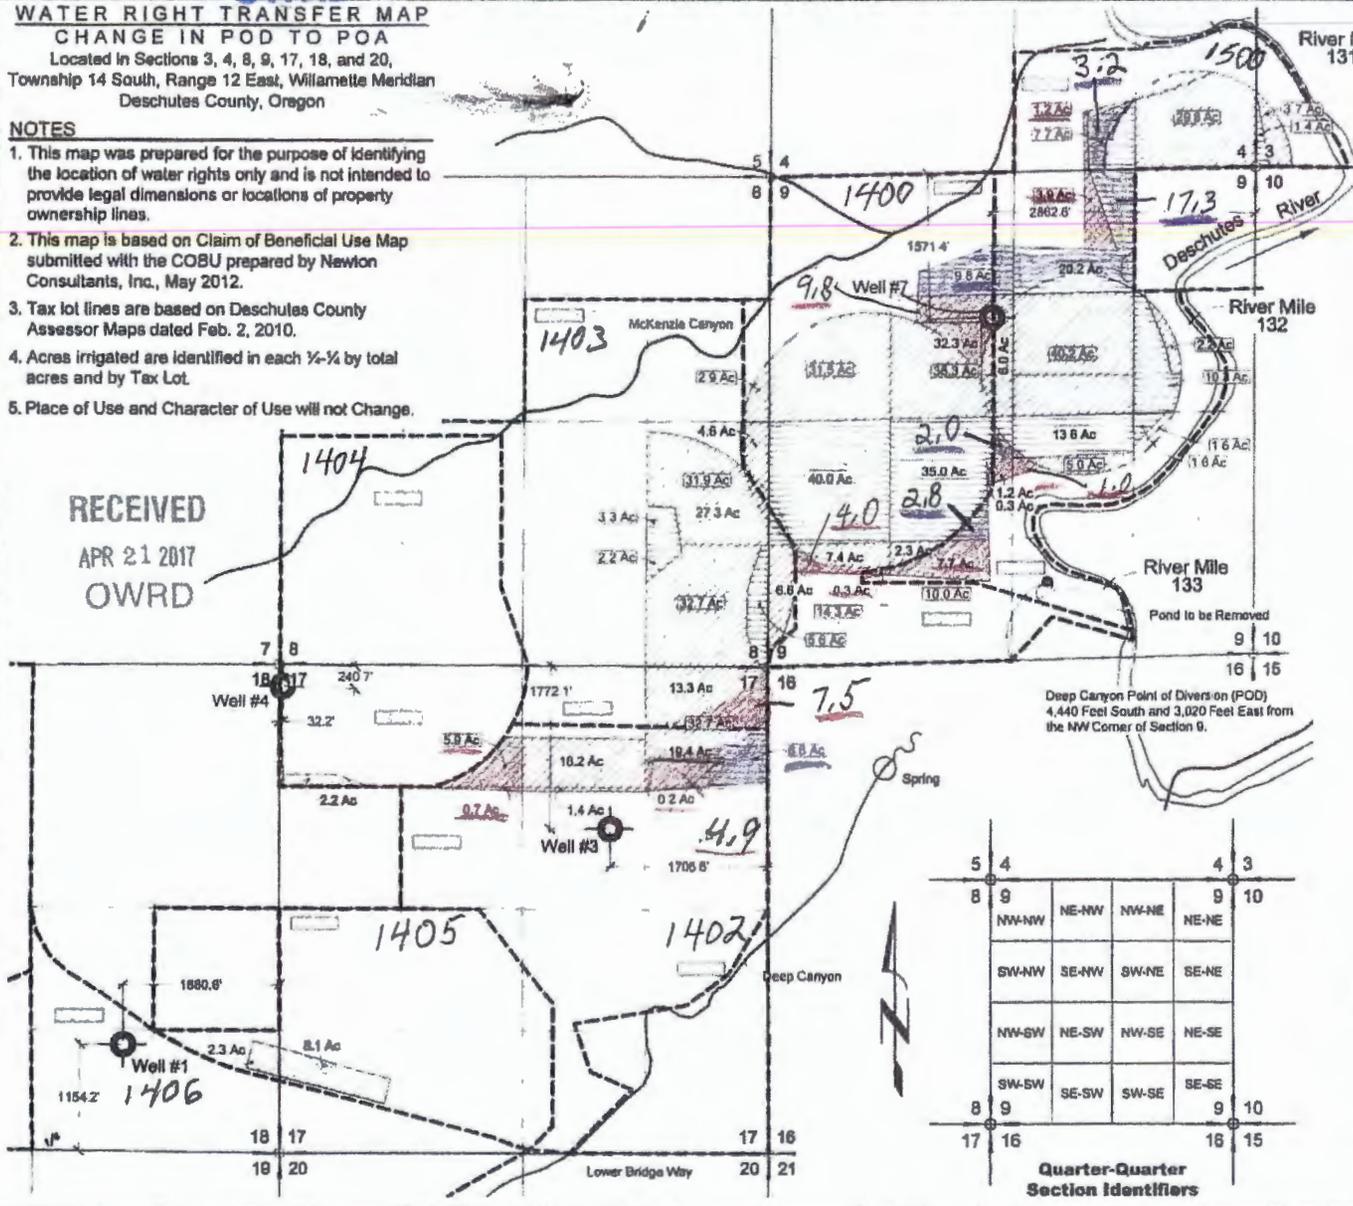

- Locations Of Proposed Point of Appropriation**
- POA 1 - Well #1**  
1880.6 Ft West and 1154.2 Ft North from the SE Corner of Section 18.
  - POA 2 - Well #3**  
1706.6 Ft West and 1772.1 Ft South from the NE Corner of Section 17.
  - POA 3 - Well #4**  
32.2 Ft East and 240.7 Ft South from the NW Corner of Section 17.
  - POA 4 - Well #7**  
2862.6 Ft West and 1571.4 Ft South from the NE Corner of Section 9.

- LEGEND**
- Primary Certificate 88027, Permit 32049 (307.8 Ac Total) irrigation April 13 1987
  - Supplemental Certificate 88027 Permit 32049 (12.6 Ac Total) irrigation April 13, 1987
  - Primary Certificate 76371 Permit 32049 (157.1 Ac Total) irrigation April 13 1987
  - Tax Lot Boundary Line
  - Tax Lot ID Number
  - Location of Areas Not Specified in Permit S-37342 Certificate C-44283
  - Total Number of Acres Irrigated in 1/4-1/4

Deep Canyon Point of Diversion (POD)  
4,440 Feet South and 3,020 Feet East from the NW Corner of Section 9.

Spring

Quarter-Quarter Section Identifiers

5	4	4	3
8	9	9	10
NW-NW	NE-NW	NW-NE	NE-NE
SW-NW	SE-NW	SW-NE	SE-NE
NW-SW	NE-SW	NW-SE	NE-SE
SW-SW	SE-SW	SW-SE	SE-SE
8	9	9	10
17	16	16	15

DAVID J. NEWTON  
JAN 16 1986  
STATE OF OREGON

EXPIRES: 31 Dec 2018  
RENEW: 01 Dec 2018

0' 1,320' 2,640'  
SCALE: 1" = 1,320'

Surface Water POD to Groundwater POA Transfer Map  
Big Falls Ranch Co.  
Deschutes County, Oregon

DESIGNED BY: J. Bannion  
DRAWN BY: S. Schenck  
DATE: MAR 2017  
PROJECT NO: 556-103  
FIGURE: 2

**NEWTON CONSULTANTS INC.**  
Earth, Water and Rock Specialists  
P.O. Box 550  
Prineville, OR 97671

T 12651

88027

76371

Kam 210819  
90.0 AC

G:\0000\556-103\COB\Map\556-103-F2-COBU-IB88027-10-17-03-210\2017-55