



Transfer TO Map

S35 & S2, T4 & 5S, R2W, Marion County
Certificate 90946

The Smith-Sleepy Hollow property

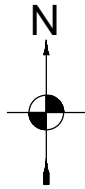

1 IN = 1320 FT
0 660 1320

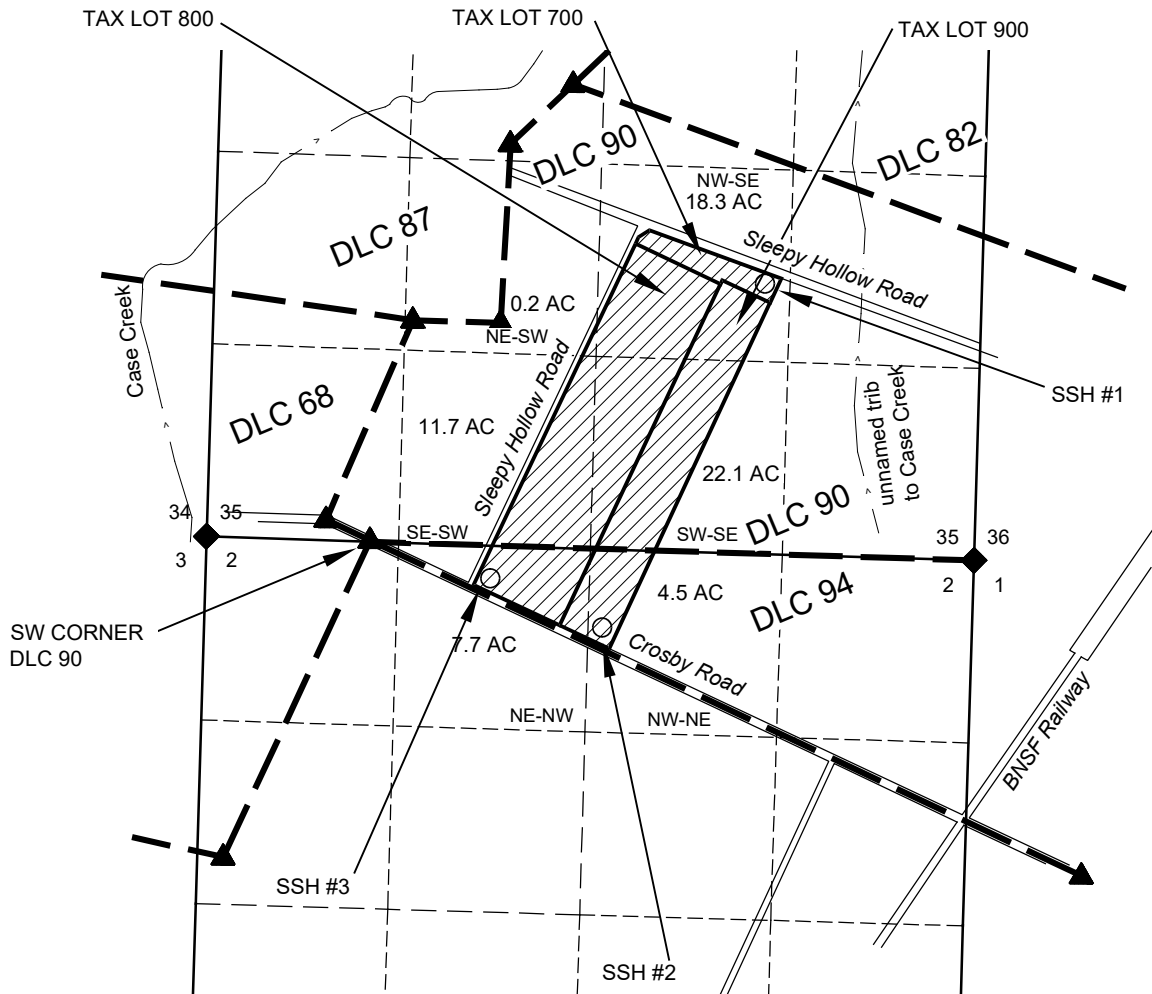


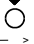

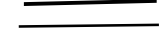
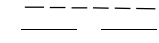
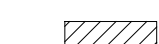
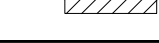

 
LOCATIONS OF POINTS OF APPROPRIATION (WELLS)

SSH #1 is 1765' N & 2715' E;
SSH #2 is 600' S & 1595' E;
SSH #3 is 260' S & 825' E;
ALL FROM SW CORNER DLC 90

NOTES:

THIS MAP IS NOT INTENDED TO PROVIDE LEGAL DIMENSIONS OR LOCATIONS OF PROPERTY OWNERSHIP LINES.
-PROPERTY LINES, QUARTER-QUARTER LINES, DONATION LAND CLAIM LINES ARE BASED ON THE TAX ASSESSOR MAPS FOR SECTIONS 35 & 2 OF T4 & 5S, R2W.
-WATER CONVEYANCE LINES SHALL BE ALL WITHIN THE PROPERTY AND THEREFORE ARE NOT SHOWN.

LEGEND

-  DONATION LAND CLAIM (DLC) CORNER
-  SECTION CORNER
-  POINT OF APPROPRIATION (WELL)
-  STREAM OR SURFACE DRAINAGE
-  TAX LOT LINE
-  SECTION LINE
-  QUARTER-QUARTER LINE
-  DLC LINEM
-  TO LANDS



MAP BY:
ASPEN RURAL LAND CONSULTING
ERIC URSTADT, PE, PLS
971-250-1520
Oct 2021
BISky-SleepyHollow2A