

Please use and attach additional pages of Table 2 as needed.  
See page 6 for instructions.

Do you have questions about how to fill-out the tables?  
Contact the Department at 503-986-0900 and ask for Transfer Staff.

**Table 2. Description of Changes to Water Right Certificate # C-89306**

List the change proposed for the acreage in each 1/4 1/4. If more than one change is proposed, specify the acreage associated with each change.  
If there is more than one POD/POA involved in the proposed changes, specify the acreage associated with each POD/POA.

AUTHORIZED (the "from" or "off" lands)										PROPOSED (the "to" or "on" lands)													
The listing that appears on the certificate BEFORE PROPOSED CHANGES										The listing as it would appear AFTER PROPOSED CHANGES													
List only that part or portion of the water right that will be changed.										are made.													
Twp	Rng	Sec	1/4	Tax Lot	Gvt Lot or DLC	Acres	Type of USE listed on Certificate	POD(s) or POA(s) (name or number from Table 1)	Priority Date	Twp	Rng	Sec	1/4	Tax Lot	Gvt Lot or DLC	Acres	New Type of USE	POD(s)/ POA(s) to be used (from Table 1)	Priority Date				
23	S	31	E	11	SE	SW	1000	9.43	IR	Well Auth.	1956	23	S	31	E	11	SE	SW	1000	9.43	IR	Well APOA, Well Auth.	1956
"	"	"	"	"	SE	SW	1100	4.49	IR	"	"	"	"	"	SE	SW	1100	4.49	IR	"	"	"	"
"	"	"	"	"	NE	SW	1000	0.50	IS	"	"	"	"	NE	SW	1000	0.50	IS	"	"	"	"	"
"	"	"	"	"	NW	SW	1100	0.50	IS	"	"	"	"	NW	SW	1100	0.50	IS	"	"	"	"	"
"	"	"	"	"	SE	SW	1100	4.12	IS	"	"	"	"	SE	SW	1100	4.12	IS	"	"	"	"	"
TOTAL ACRES: 19.04										TOTAL ACRES: 19.04													

Additional remarks: \_\_\_\_\_.

RECEIVED

OCT 22 2021

Permanent Transfer Application Form - Page 7 of 8

Revised 11/6/2019

TACS


OWRD







RENEWAL DATE 12/31/2022

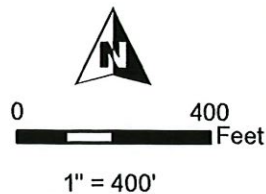


# T23S R31E, WM, HARNEY COUNTY, OR

- Authorized Well HARN 441
- ⊙ APOA Well HARN 436
- POU IR APOA
- POU (IS) APOA
- POU IR UNCHANGED
- POU (IS) UNCHANGED
- POU IR VOL. CANCELLATION
- POU (IS) VOL. CANCELLATION
- Section
- - - Quarter Quarter
- Tax Lot

RECEIVED  
OCT 22 2021

OWRD  
NWSE

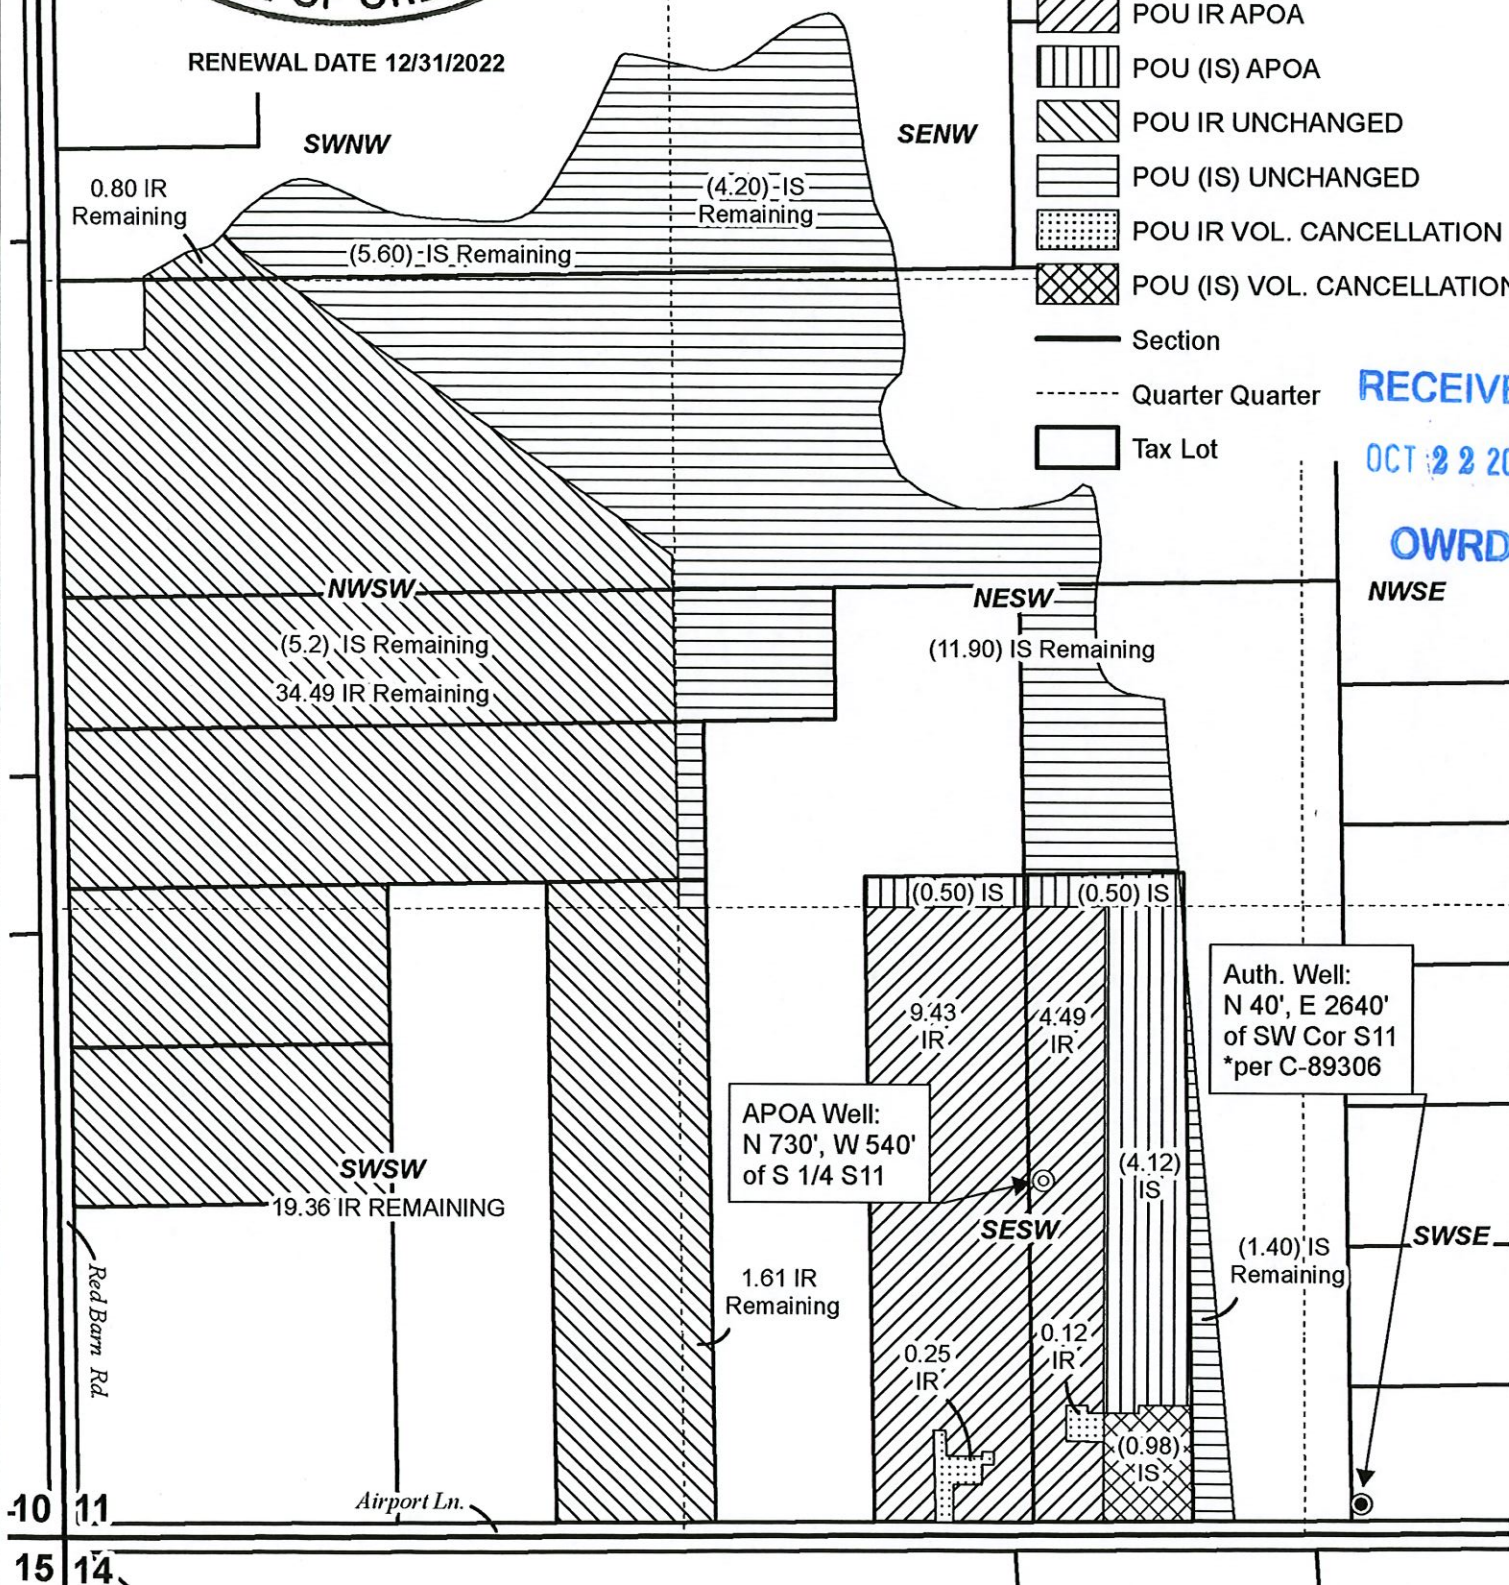

## PERMANENT APOA TRANSFER MAP BEAUBIEN

Date: 9/30/2021

C-89306

This map is not intended to provide legal dimensions or locations of property ownership lines.

**WATER RIGHT SERVICES, LLC**  
PO BOX 1830, BEND, OR 97709  
[WWW.OREGONWATER.US](http://WWW.OREGONWATER.US) CCB # 197121  
johnshort@usa.com 541-389-2837