


RECEIVED

NOV 05 2021


OWRD

Partial Claim of Beneficial Use Map Portion of T- 13496 Deborah Wallace

T 41 S, R 10 E, WM
Sec 5 & 8

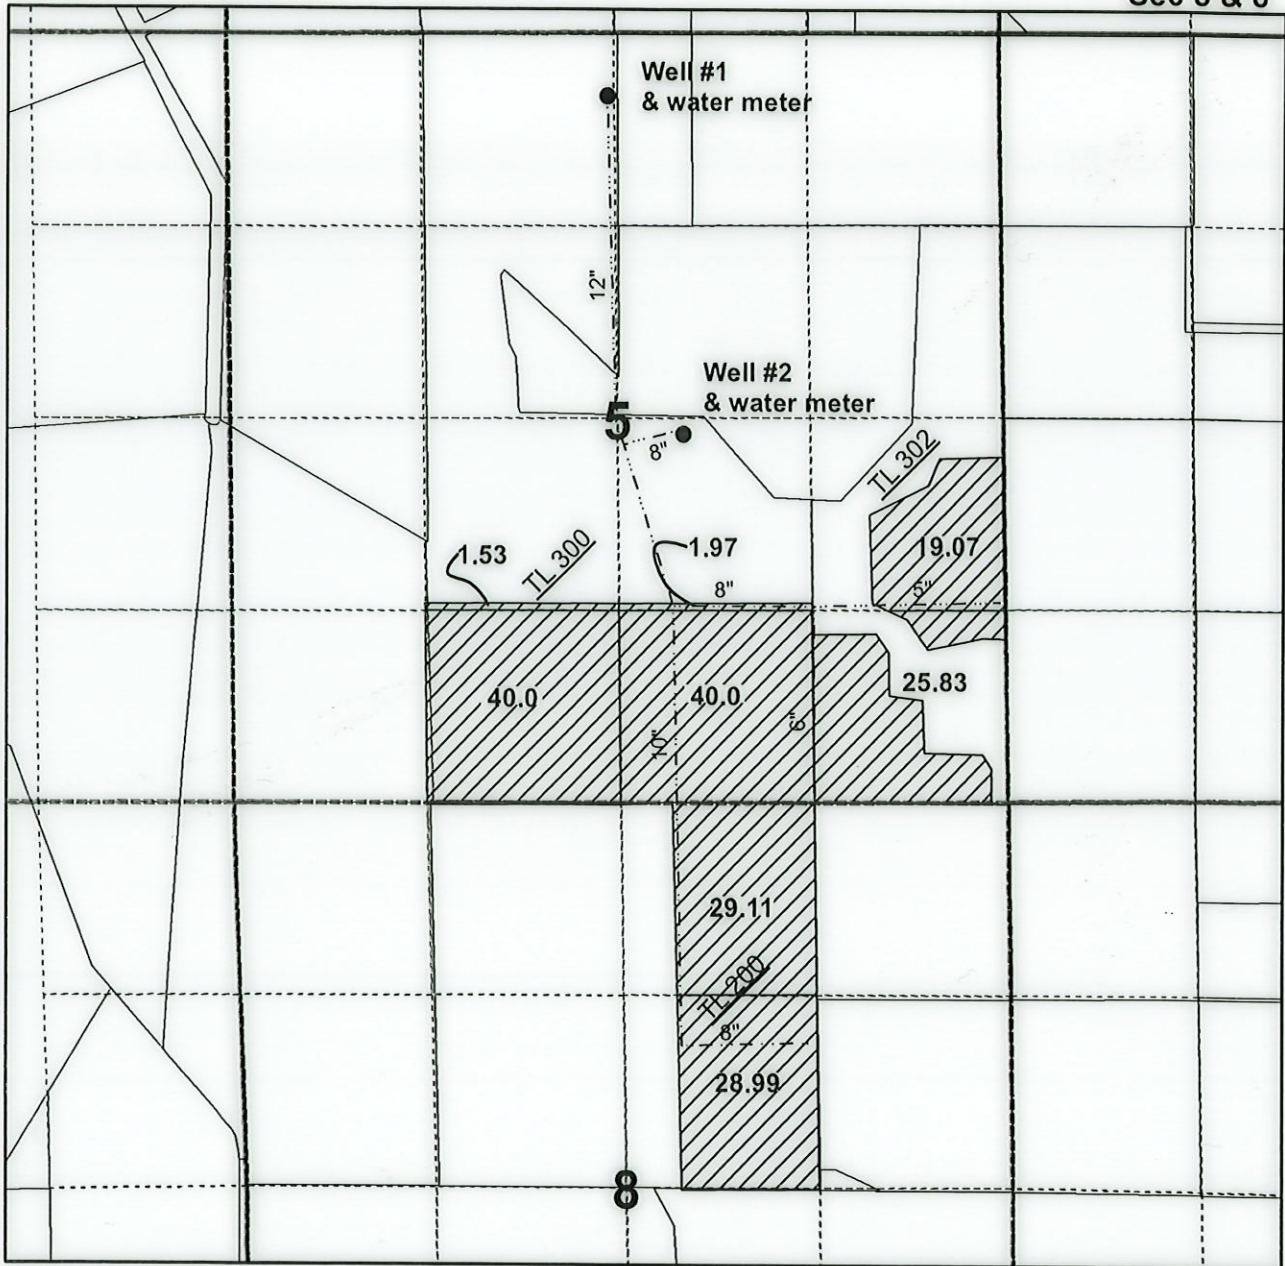

Legend


 Place of Use 186.5 ac

● Wells

--- Pipelines

Well #1 Klam 14690 Existing POA
784 Ft North & 30 Ft West From the
Center North 1/16th Cor. Sec 5

Well #2 Klam 51848 Add POA
2694.6 Ft South & 460 Ft East From
the North 1/4 Cor. Sec 5
Both in T 41 S. R 10 E. WM

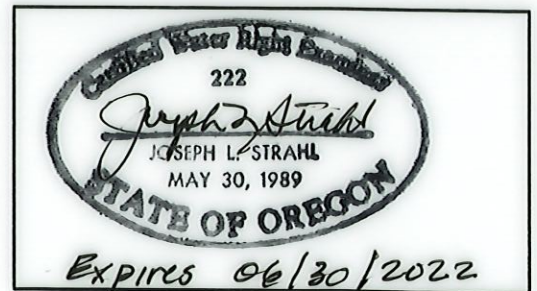

1 inch = 1,320 feet

Note: This map is not intended to provide legal dimensions or locations of property ownership lines.