


**Evans Ranch Land LLC
Claim of Beneficial Use Map
T-13502
Certificate 53146, 87093 & 95027**

T 40 S, R 18 E, WM
Section 36





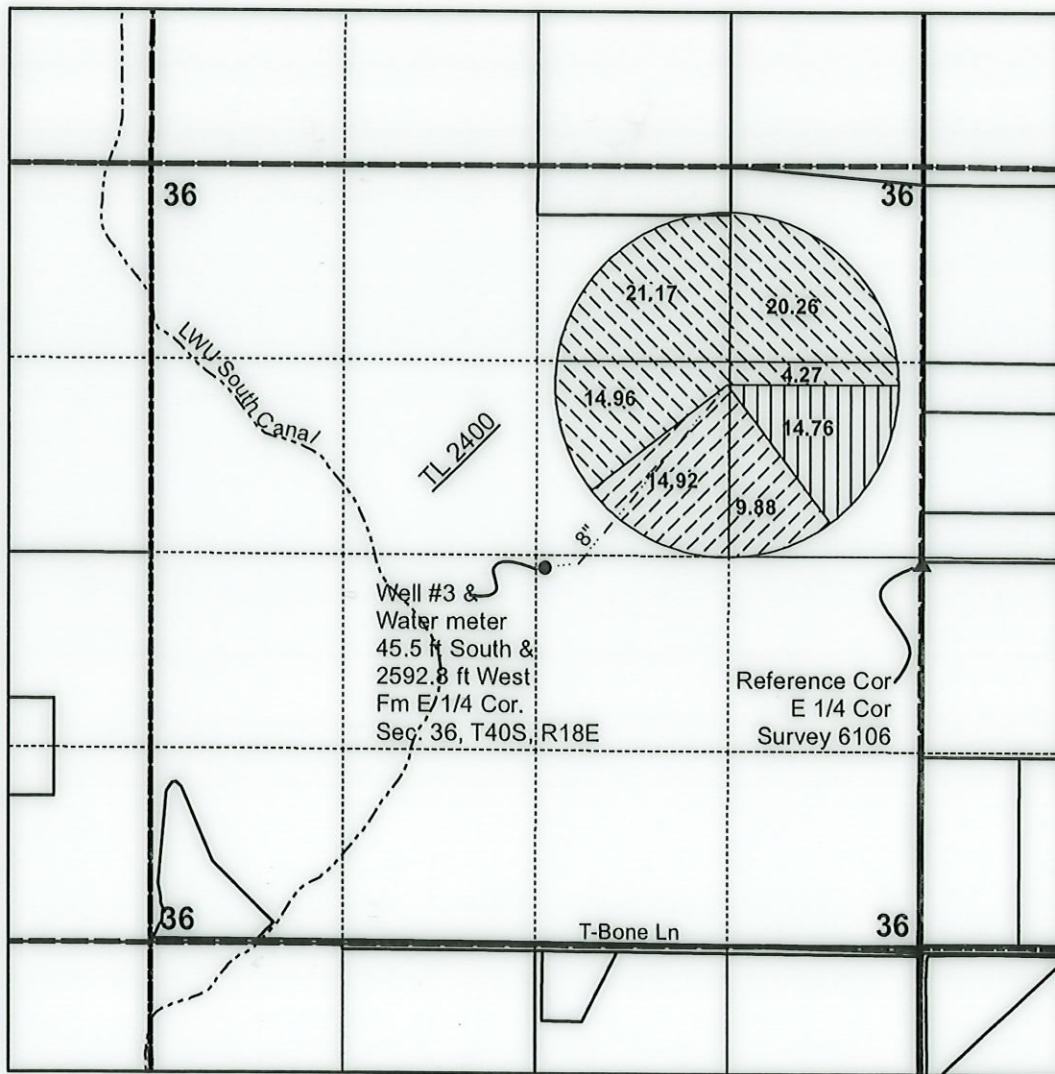

RECEIVED

NOV 05 2021

OWRD



Legend

-  T13502 C 53146 place of use 24.8 ac
-  T-13502 C 87093 Place of use 60.66 ac
-  T-13502 C 95027 place of use 14.76 ac
-  Pipeline
-  Well
-  Ref Cor LCS 6106



1 inch = 1,320 feet



Expires 06/30/2022

Note: This map is not intended to provide legal dimensions or locations of property ownership lines.