



 
T.6S. R.1W. Sec. 22, 23, 26 & 27, W.M.

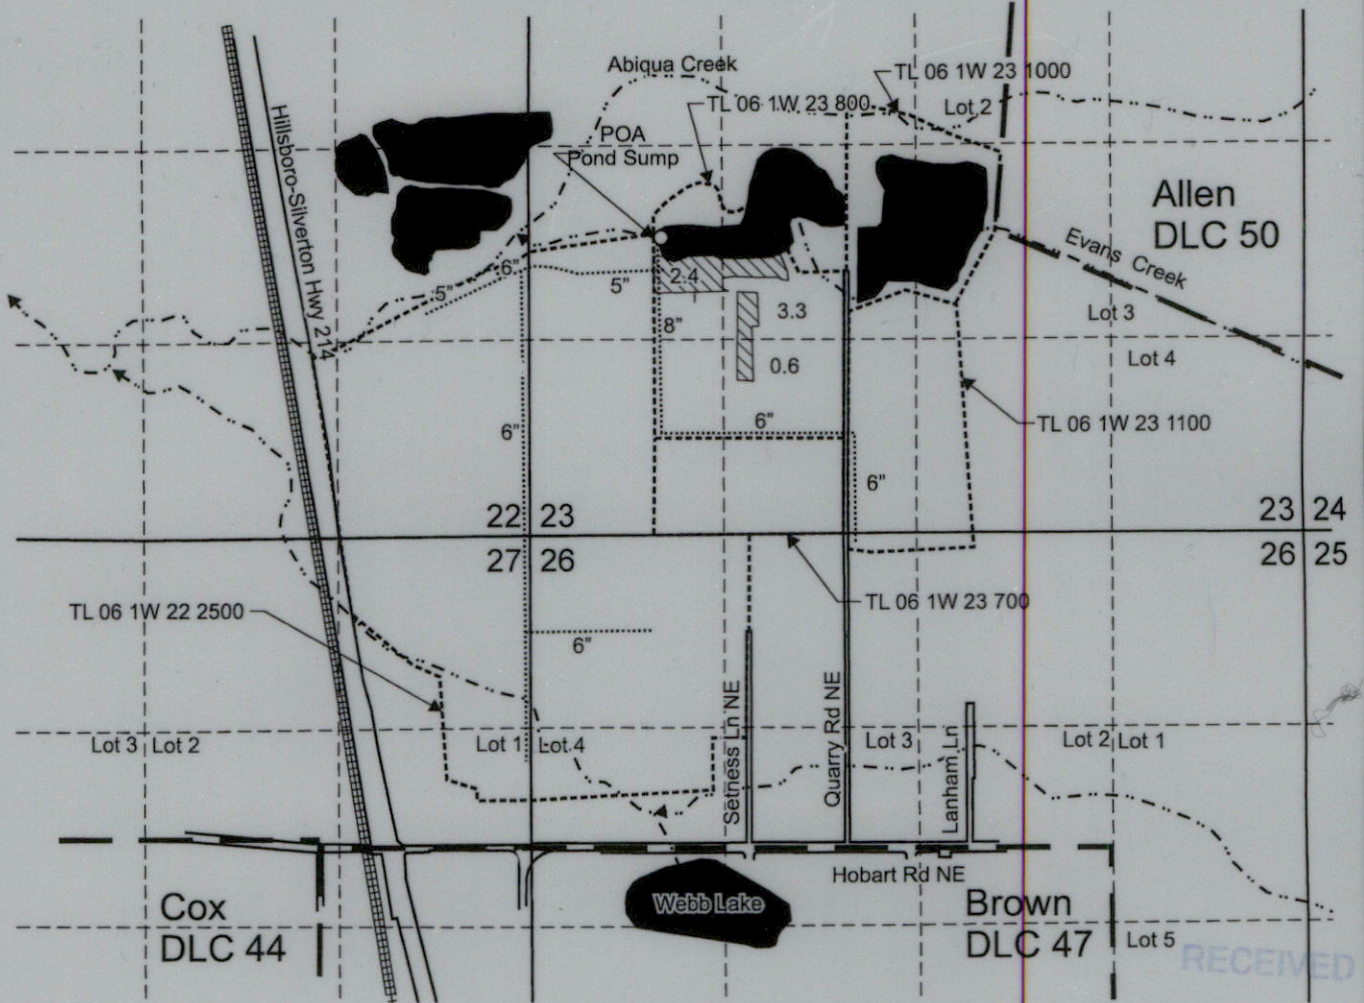


 
RECEIVED
FEB 16 2022
OWRD

POA Pond Sump is located 2,035 feet north and 900 feet east from the SW corner, Section 23.

 Area (6.3 Acres) irrigated under T-12969, formerly Certificate 75599, priority date 5-6-1952.


 Tax lot boundary

 Donation Land Claim boundary

 Water main line



EXPIRES: *June 30, 2023*

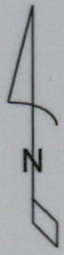

Scale: 1" = 1,320'



This map was prepared for the purpose of identifying the location of a water right only and is not intended to provide legal dimensions or location of property ownership lines.

Claim of Beneficial Use Map
T-12969, formerly Certificate 75599

Pacific Hydro-Geology Inc.

Blue Line Farms, Inc.
T.6S. R.1W. Sec. 22, 23, 26 & 27, W.M.

01/2022



Pacific Hydro-Geology Inc.

0125055


Blue Line Farms, Inc.

Claim of Beneficial Use Map

This map was prepared for the purpose of identifying the dimensions or location of property ownership lines, location of a water right only and is not intended to provide legal

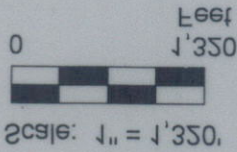


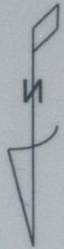


- Water main line
- • — Donation Land Claim boundary
- - - - Tax lot boundary



RECEIVED

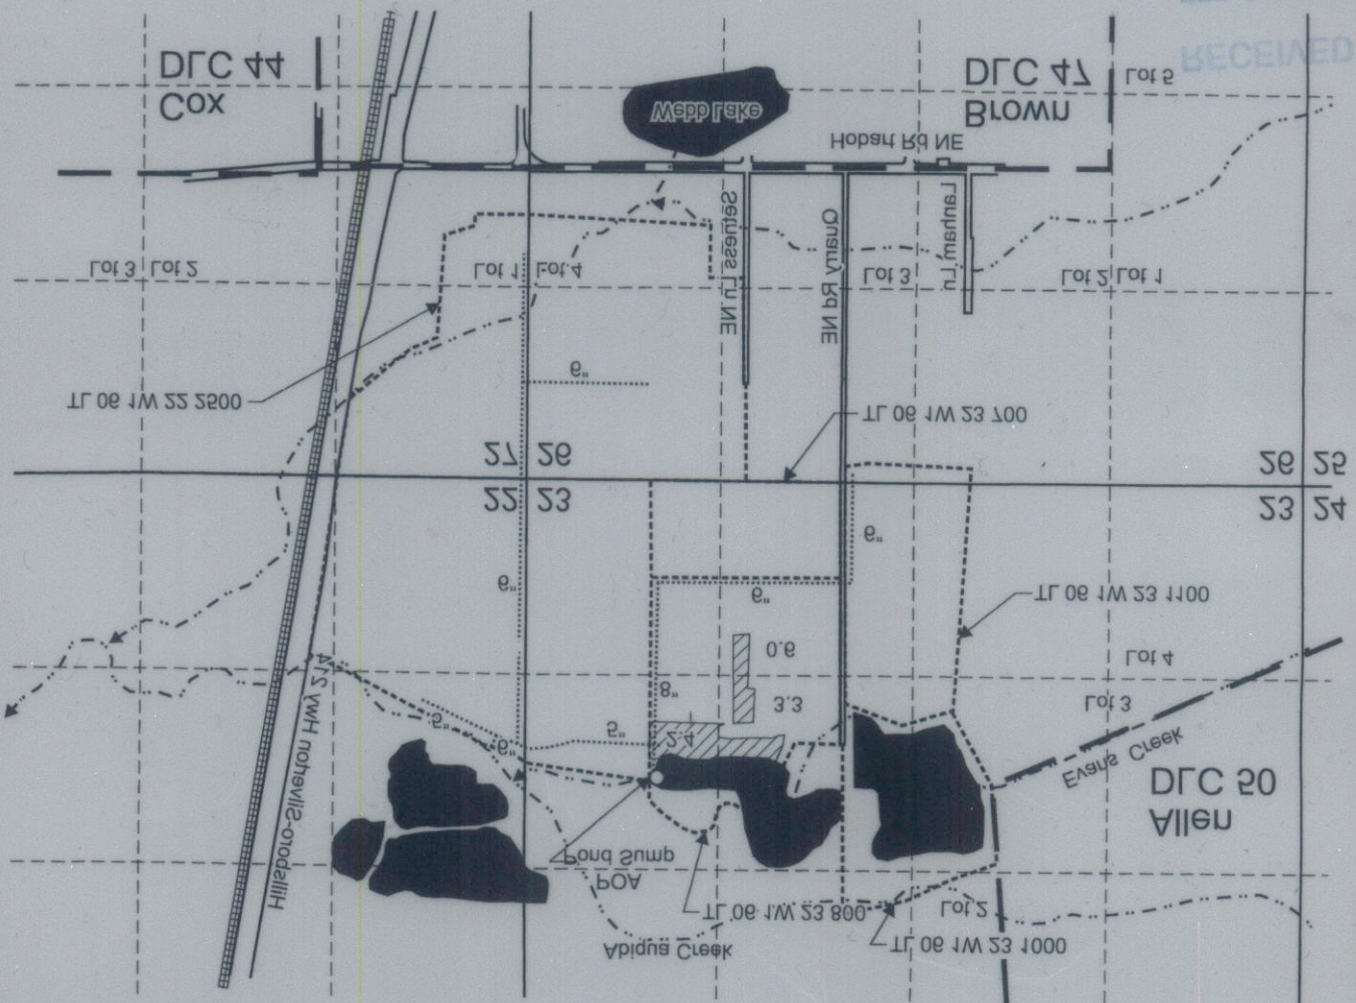

