

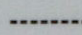



T.6S. R1W. Sec. 22, 23, 26 & 27, W.M.

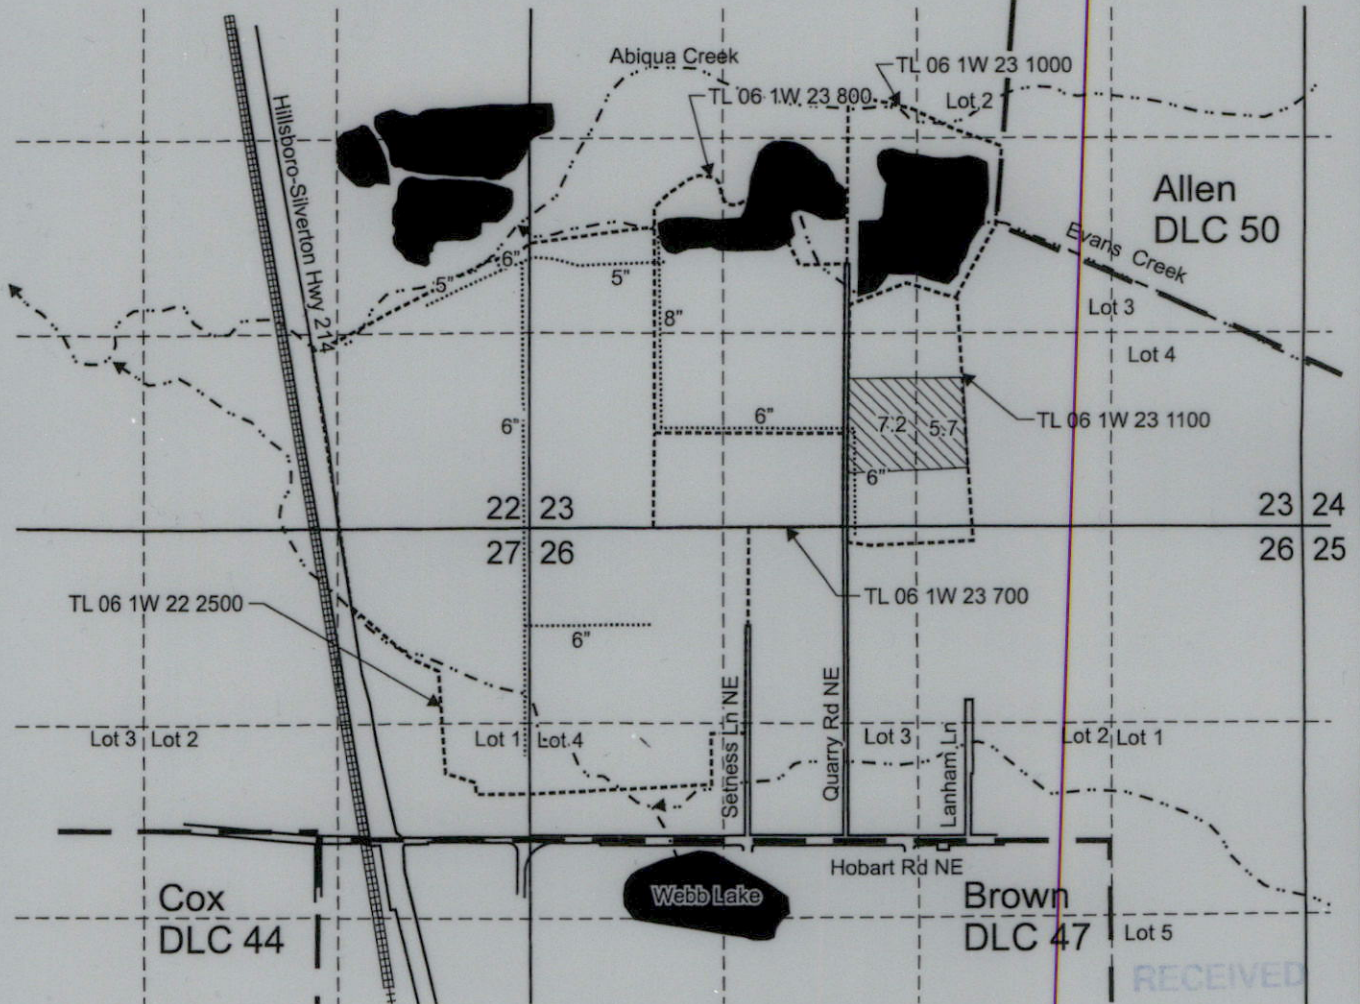


POA is located 2,035 feet north and 900 feet east from the SW corner, Section 23.

 Area (12.9 Acres) irrigated under T-12969, formerly Certificate 87462, priority date 5-6-1952

 Tax lot boundary

 Donation Land Claim boundary

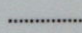
 Water main line



EXPIRES: June 30, 2023

This map was prepared for the purpose of identifying the location of a water right only and is not intended to provide legal dimensions or location of property ownership lines.

Scale: 1" = 1,320'

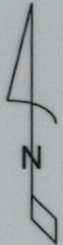

Claim of Beneficial Use Map
T-12969, formerly Certificate 87462

Pacific Hydro-Geology Inc.

Blue Line Farms, Inc.
T.6S. R.1W. Sec. 22, 23, 26 & 27, W.M.

01/2022

RECEIVED
FEB 16 2022
OWRD



Pacific Hydro-Geology Inc.


Blue Line Farms, Inc.



This map was prepared for the purpose of identifying the location of a water right only and is not intended to provide legal dimensions or location of property ownership lines.

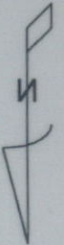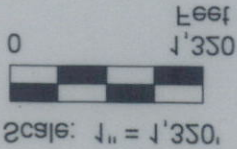

- Water main line
- • — Donation Land Claim boundary
- - - - Tax lot boundary


RECEIVED

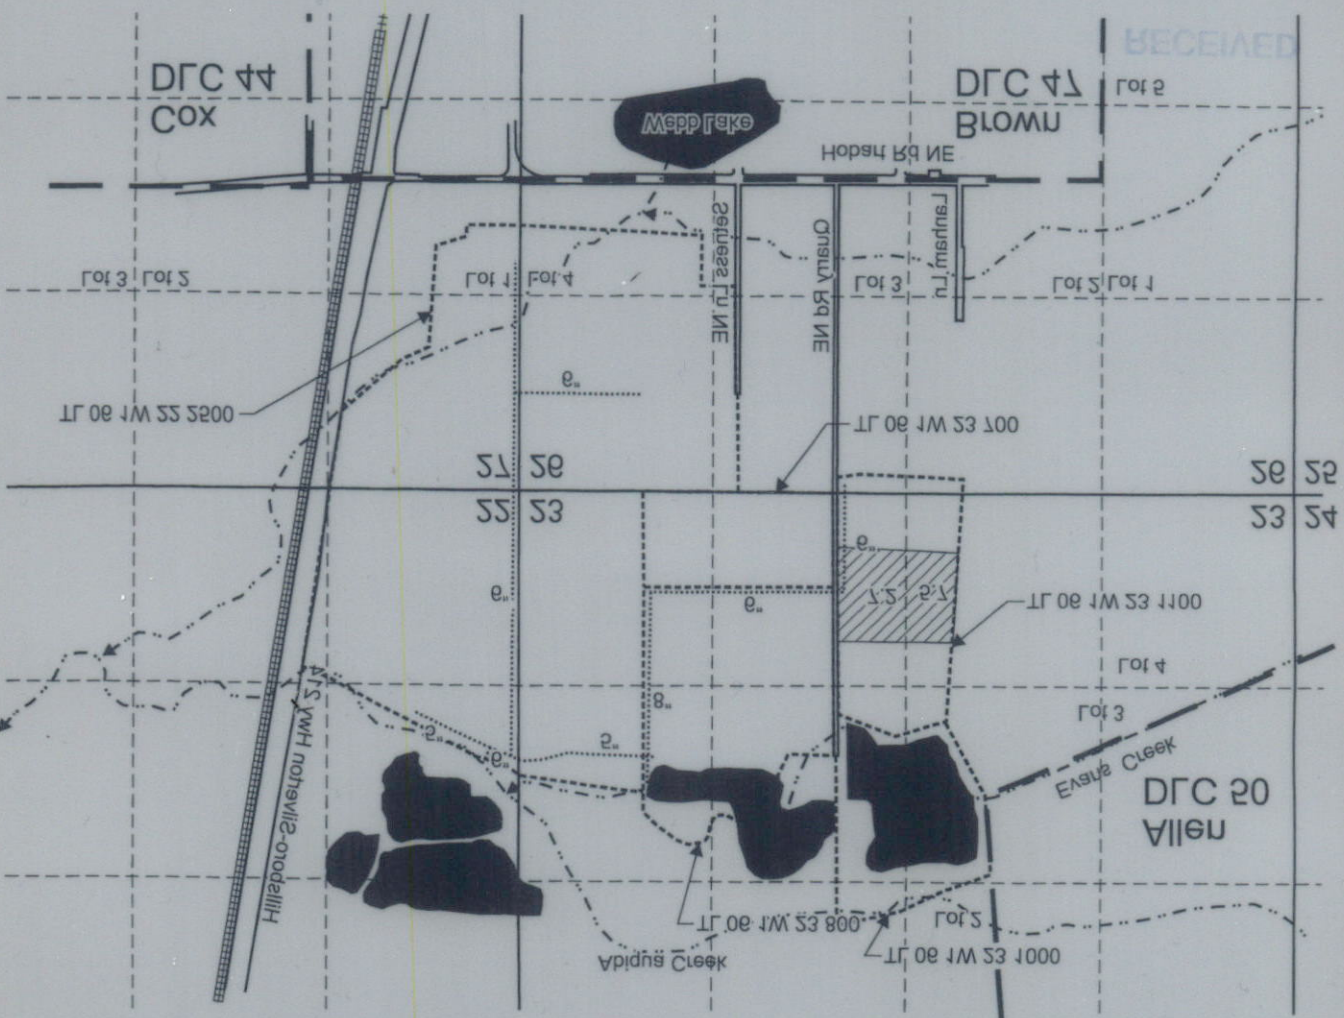

