



Oregon Water Resources Department
 725 Summer Street NE, Suite A
 Salem, Oregon 97301-1266
 (503) 986-0900
 www.wrd.state.or.us

E-RECEIVED
 07/06/2022
 OWRD

District Permanent Water Right Transfer Claim of Beneficial Use

1. APPLICANT INFORMATION

District: EAGLE POINT IRRIGATION DISTRICT

Contact Person: David Ford

Phone: 541 826-3411

Mailing Address: P.O. Box 157

City: Eagle Point

State: OR

Zip: 97524

E-Mail address: deford@centurtylink.net

Transfer Number: T - 13874

2. WATER RIGHT(S)

Pursuant to OAR Chapter 690, Division 385, the district is submitting to the Water Resources Department this claim of beneficial use, with the appropriate fee, for the following water right(s):

NOTE: Fees do not apply if the priority date is prior to July 9, 1987.

PERMIT NUMBER	CERTIFICATE NUMBER	DECREE (name, volume, and page)	PRIMARY (P) OR SUPP (S)
-	89373		<input checked="" type="checkbox"/> P <input type="checkbox"/> S
-	49921		<input type="checkbox"/> P <input checked="" type="checkbox"/> S
-			<input type="checkbox"/> P <input type="checkbox"/> S
-			<input type="checkbox"/> P <input type="checkbox"/> S

3. AUTHORIZED POINT(S) OF DIVERSION (POD) / APPROPRIATION (POA)

The authorized point(s) of diversion / appropriation for the water right modified by the transfer are as follows:

PERMIT NUMBER	DECREE or CERTIFICATE	POD / POA #	SOURCE	LOCATION – MEASURED DISTANCES
-	89373	1	Big Butte Creek	1130 FEET SOUTH & 700 FEET WEST FROM THE NE COR. SEC. 10, NE-NE, Sec. 10, T35S, R2E WM
-	89373	2	Big Butte Creek	1030 FEET SOUTH & 290 FEET EAST FROM THE NW COR. SEC. 3, NW-NW, Lot 4, Sec. 3, T35S, R2E, WM
-	49921	6	N. Fk. Reese Cr.	1220 FEET NORTH & 520 FEET EAST FROM THE W1/4 COR. SEC. 12, SW-NW, T35S, R1W Sec. 12 WM
-				

4. AUTHORIZED PLACE OF USE

The summary of the perfected change in place of use authorized by the final order approving the water right transfer is listed in Table 1.

CERTIFICATE DECREASE or PERMIT	POD / POA #	PRIORITY DATE	USE	LEGAL DESCRIPTION								ACRES	USER NAME	
				TWP	RNG	SEC	QQ	DLC	GOV'T LOT	TAX LOT				
89373	1,2	8/21/1915	IR	35 S	1W	11	SE NE					500	5.2	DDD, LLC
89373	1,2	8/21/1915	IR	35 S	1 W	27	SE SE					1402	4.0	TERBECK
49921	6	3/4/1965	IR	35 S	1 W	11	SE NE					500	3.0(S)	DDD, LLC
TOTAL:											9.2 PRI 3.0 SUP			

5. MAP AND SITE REPORT

Attached is a map and site report for each water right listed in Table 1 that satisfies the requirements of OAR 690-385-7400.

6. SIGNATURES

The district certifies that it has inspected the place of use listed in Table I, and confirms the change in place of use has been completed consistent with the terms and conditions of the final order approving the transfer.



Signature of District Manager
or District Board Chairperson

7-6-22
Date

David Ford Manager
Type or Print Name of District Manager
or District Board Chairperson


CLAIM OF BENEFICIAL USE
EAGLE POINT IRRIGATION DISTRICT
SECTION 11, T.35S, R.1W, W.M.
JACKSON COUNTY, OREGON

MAP 1 OF 2

2021 PERMANENT TRANSFER
Certificates 89373, 49921

Assessor Map T-35S-R1W-11

TRANSFER T-13874

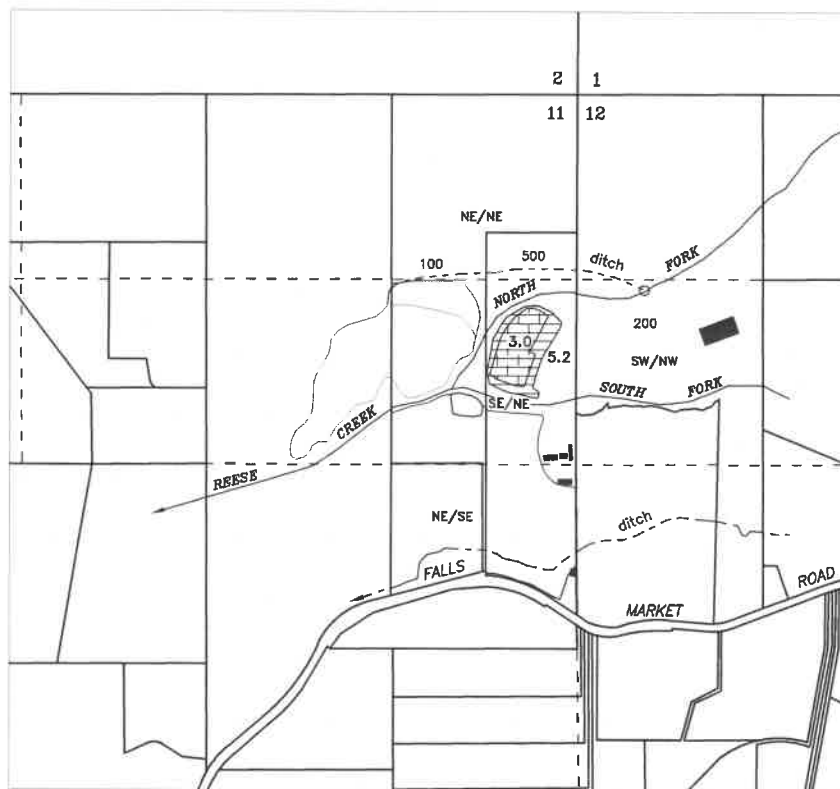

Legend



Certificate 89373
5.2 Acres Primary



Certificate 49921
3.0 Acres Supplemental

Scale
1 inch = 1320 feet



07/05/2022 n.e.d..

Water User :
DDD, LLC
P.O. Box 1696
El Granada, CA 94018

EAGLE POINT IRRIGATION DISTRICT
2329 BROPHY ROAD - P.O. BOX 157
EAGLE POINT, OR 97524
PHONE 541-826-3411 - FAX 541-826-8738


CLAIM OF BENEFICIAL USE
EAGLE POINT IRRIGATION DISTRICT
SECTION 26, 27, T.35S, R.1W, W.M.
JACKSON COUNTY, OREGON

MAP 2 OF 2

2021 PERMANENT TRANSFER
Certificate 89373

Assessor Map T-35S-R1W-26, 27

TRANSFER T-13874

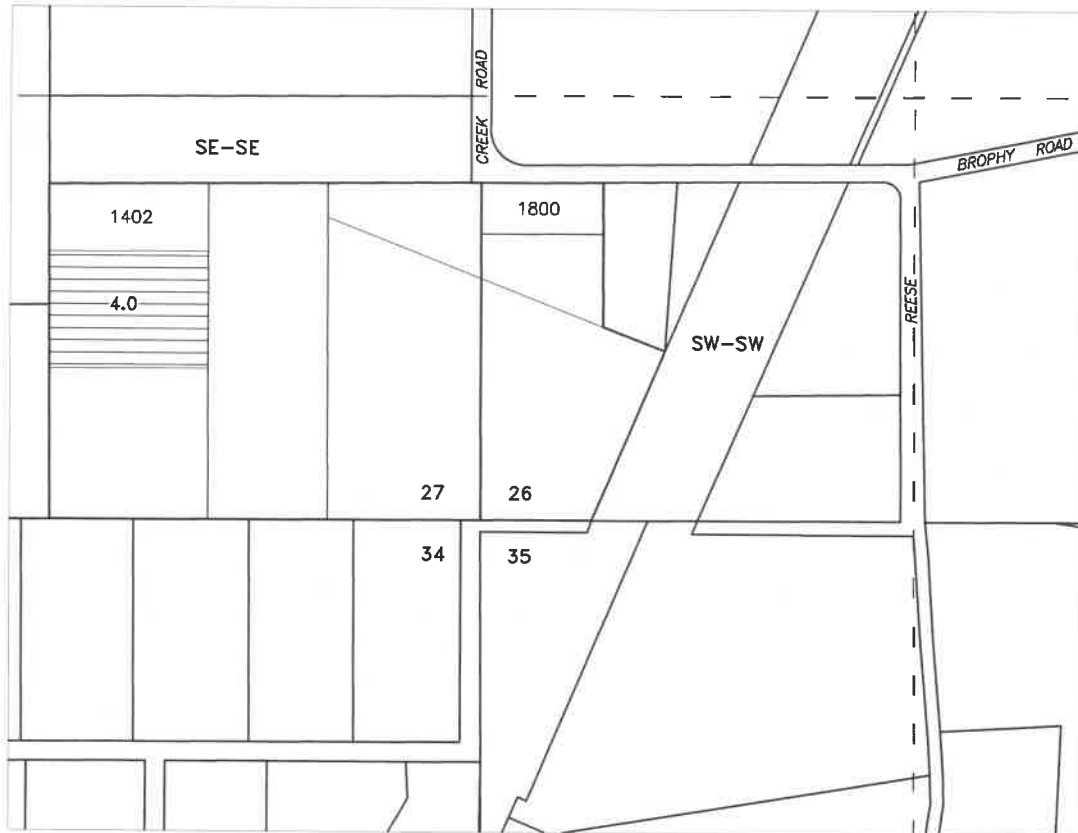

Legend



Scale
1 inch = 400 feet



Water User :

THOMAS TERBECK
1421 REESE CREEK ROAD
EAGLE POINT, OR 97524

EAGLE POINT IRRIGATION DISTRICT
2329 BROPHY ROAD - P.O. BOX 157
EAGLE POINT, OR 97524
PHONE 541-826-3411 - FAX 541-826-8738



CLAIM OF BENEFICIAL USE Site Report

Transfer Number: T - 13874

District Internal Notice #: 2021-002

User Name: DDD LLC

Place of Use:

USE	POD #	TWP	RNG	SEC	QQ	DLC	GOV'T LOT	TAX LOT	ACRES
IR	1,2	35S	1 W	11	SE NE			500	5.2

District Conveyance System:

Description of Delivery System: EPID canal and delivery ditch.

Headgate: Hammel DDD

Canal: Hammel ditch

Beneficial Use:

Description of Beneficial Use: For irrigation purpose, 5.2 acres irrigated as mapped.

Method Used to Apply Water: Water delivered by District thru main canal to open ditch "Hammel ditch" and pumped from bulge to the irrigated area.

Method Used to Calculate Beneficial Use: Weirs, gages thru District system on 14-day rotational basis, not exceeding the rate and duty during irrigation season of District certificate 89373.

User Interviewed: (X) Yes () No

Beneficial Use Made as Authorized: (X) Yes () No

Description of Beneficial Use if Less than Authorized:

Inspected By: [Signature]

Date: 6-30-22

Instructions: Attach and label the corresponding final proof map.



CLAIM OF BENEFICIAL USE Site Report

Transfer Number: T - 13874

District Internal Notice #: 2021-002

User Name: Terbeck

Place of Use:

USE	POD #	TWP	RNG	SEC	QQ	DLC	GOV'T LOT	TAX LOT	ACRES
IR	1,2	35S	1 W	27	SE SE			1400	4

District Conveyance System:

Description of Delivery System: EPID canal and delivery ditch.

Headgate: Brown ditch, Terbeck Canal: Brown ditch

Beneficial Use:

Description of Beneficial Use: For irrigation purpose, 4 acres irrigated as mapped.

Method Used to Apply Water: Water delivered by District thru main canal to open ditch "Brown ditch" to tax lot 1402 irrigated area.

Method Used to Calculate Beneficial Use: Weirs, gages thru District system on 14-day rotational basis, not exceeding the rate and duty during irrigation season of District certificate 89373.

User Interviewed: (X) Yes () No

Beneficial Use Made as Authorized: (X) Yes () No

Description of Beneficial Use if Less than Authorized:

Inspected By: *[Signature]*

Date: 6-30-22

Instructions: Attach and label the corresponding final proof map.