



July 20, 2022

Ann Reece
District Transfer Advisor
Oregon Water Resources Department
725 Summer St NE Ste A
Salem, OR 97301-1266

RE: FINAL PROOFS – Claim of Beneficial Use for T-13589

Dear Ann,

Central Oregon Irrigation District is submitting our claim of beneficial use for a permanent District transfer ("385").

Enclosed is a list of the authorized lands. Site reports are attached to each map and any specific details about the properties are contained in each site report.

Please Note: The below noted properties have had the following changes:

1. 14-15-32 SESE 100: Ownership change from Gilbertson to Michael and Holly McLane
2. 14-15-32 SWSE 1301: Ownership change from Gilbertson to Steak on the Hoof
3. 15-12-12 SESE 401: Mapping change
4. 15-15-04 NWNW 1301: Ownership change from Gilbertson to Steak on the Hoof
5. 15-15-04 SWNW 1301: Ownership change from Gilbertson to Steak on the Hoof
6. 17-12-14 SENW 803: Ownership change from Gasper to Nathan and Amy Holcomb
7. 17-12-14 SWNE 803: Ownership change from Gasper to Nathan and Amy Holcomb

The District certifies that it has inspected the place of use and confirms the change in place of use has been completed consistent with the terms and conditions of the final order approving the transfer.



Craig Horrell
Managing Director, Central Oregon Irrigation District

Date: 7.20.22



Oregon Water Resources Department
725 Summer Street NE, Suite A
Salem, Oregon 97301-1266
(503) 986-0900
www.wrd.state.or.us

District Permanent Water Right Transfer Claim of Beneficial Use

1. APPLICANT INFORMATION

District: CENTRAL OREGON IRRIGATION DISTRICT

Contact Person: LESLIE CLARK

Phone: 541-548-6047

Mailing Address: 1055 SW LAKE COURT

City: REDMOND

State: OR

Zip: 97756

E-Mail address: lesliec@coid.org

Transfer Number: T - 13589

2. WATER RIGHT(S)

Pursuant to OAR Chapter 690, Division 385, the district is submitting to the Water Resources Department this claim of beneficial use, with the appropriate fee, for the following water right(s):

NOTE: Fees do not apply if the priority date is prior to July 9, 1987.

PERMIT NUMBER	CERTIFICATE NUMBER	DECREE (name, volume, and page)	PRIMARY (P) OR SUPP (S)
-	94956		<input checked="" type="checkbox"/> P <input type="checkbox"/> S
-	76714		<input type="checkbox"/> P <input checked="" type="checkbox"/> S
-			<input type="checkbox"/> P <input type="checkbox"/> S
-			<input type="checkbox"/> P <input type="checkbox"/> S

3. AUTHORIZED POINT(S) OF DIVERSION (POD) / APPROPRIATION (POA)

The authorized point(s) of diversion / appropriation for the water right modified by the transfer are as follows:

PERMIT NUMBER	DECREE or CERTIFICATE	POD / POA #	SOURCE	LOCATION – MEASURED DISTANCES
-	94956	1	Deschutes River	SW ¼ NE ¼ SEC. 13, T. 18 S., R. 11 E., W.M.; 1520' S. & 1535' W. FROM THE NE CORNER OF SEC. 13
-	94956	11	Deschutes River	SE ¼ NE ¼ SEC. 29, T. 17 S., R. 12 E., W.M.; 850' N. AND 630' W. FROM THE E ¼ CORNER OF SEC. 29
-				
-				

6. SIGNATURES

The district certifies that it has inspected the place of use listed in Table I, and confirms the change in place of use has been completed consistent with the terms and conditions of the final order approving the transfer.



Craig Horrell
Managing Director, Central Oregon Irrigation District

7.20.22

Date

14	13	09	SENW	00901	0.320	Kirchmeier, S E	
14	15	32	SESE	00100	0.750	Gilbertson, Leif	Ownership Change to McLane, Holly/Michael
14	15	32	SWSE	01301	0.400	Gilbertson, Leif	Ownership Change to Steak on the Hoof, LLC
15	12	12	SESE	00401	1.000	Larkin, Jeffrey A. & Julie M.	Mapping Change
15	13	06	NENW	00100	2.000	Walker, Aaron	
15	15	04	NWNW	01301	1.650	Gilbertson, Leif	Ownership Change to Steak on the Hoof, LLC
15	15	04	SWNW	01301	4.180	Gilbertson, Leif	Ownership Change to Steak on the Hoof, LLC
16	12	02	SESE	01302	1.400	Shear, Roger Lee II	
17	12	14	SENW	00803	0.430	Gasper, Grant Anthony	Ownership Change to Holcomb, Nathan/Amy
17	12	14	SWNE	00803	0.570	Gasper, Grant Anthony	Ownership Change to Holcomb, Nathan/Amy
17	13	31	NESW	00200	1.970	Rich & Ellingson Hwy 20 Residence Trust	
					14.67		

FINAL PROOF SITE REPORT

Claim of Beneficial Use

Property Owner (Applicant): Kirchmeier, SE

Petition #: P-2020-002

Current Owner:

OWRD#: T-13589

Property Address: 10701 Whimp Way Terrebonne

Notice #:

POD	USE	HG	TWP	RNG	SEC	QQ	TAX LOT	ACRES
11	IRRIG	H-13-0-1	14	13	09	SEW	901	0.32

- Person interviewed (if any): Neighbor
- Method of irrigation (pump, flood, etc): pump-sprinkle
- Use (crops produced): Lawn
- Method used to calculate area irrigated: visual-fill in + field maps
- Is beneficial use achieved: Yes - 0.32ac
- Dated photos of beneficial use: 5/3/22
- Are there any mapping changes: No
 - Submit map changes to mapping for updates to ARC. Date submitted: _____
 - Update QQ/TL changes in WWIN: _____
- Enter use into WWIN: 5/3/22

IF INCOMPLETE:

- Failure to Prove up _____ acres of transferred water right
- Extension Filed: _____

NOTES:

1st Review:

Full Bl. freshly mowed.

2nd Review:

3rd Review (if not complete assess \$150 fee)

Final Inspection by:

Jalbo

Date:

5/3/22

DESCHUTES COUNTY SEC.09 T14S R13E


E-RECEIVED
07/20/2022
OWRD

SCALE - 1" = 400'




SE 1/4 OF THE NW 1/4

OWRD: T-13589

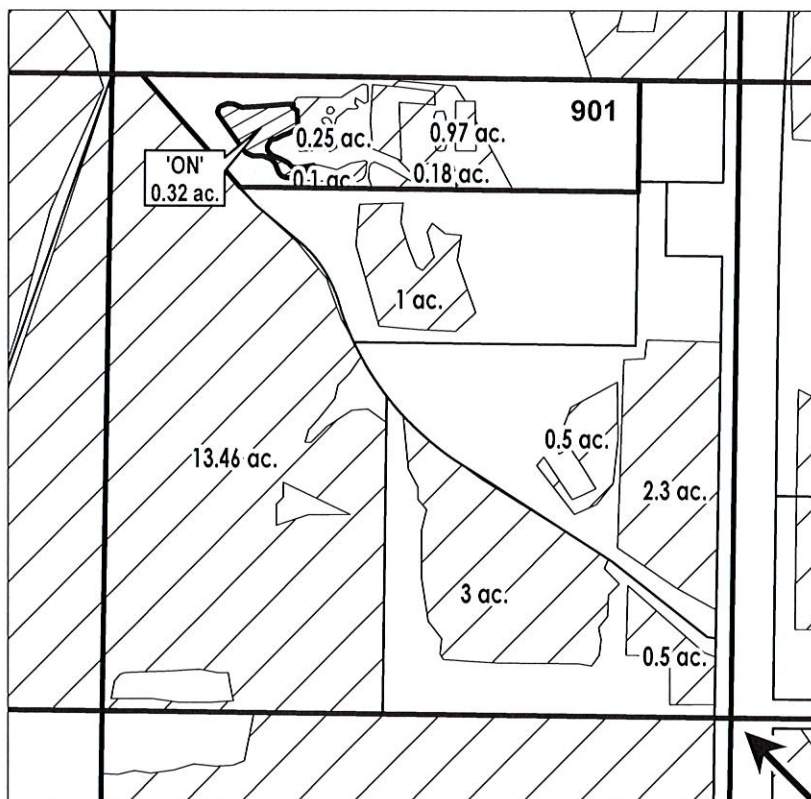

C 1/4 COR

	EXISTING WATER RIGHTS
	ON LANDS

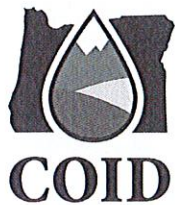

FINAL PROOF MAP

NAME: Kirchmeier, S.E

TAXLOT #: 901

0.32 ACRES

DATE: 7/12/2022

FINAL PROOF SITE REPORT

Claim of Beneficial Use

Property Owner (Applicant): Steak on the Hoof / McLane

Petition #: P-2020-002

Previous Owner: Leif Gilbertson

OWRD#: T-13589

Property Address: 8883 / 8121 Houston Lake Rd

Notice #:

Michael & Holly McLane

POD	USE	HG	TWP	RNG	SEC	QQ	TAX LOT	ACRES
1	IRRIG	COC-75-1	14	15	32	SESE	100	0.75ac

Steak on the Hoof LLC

POD	USE	HG	TWP	RNG	SEC	QQ	TAX LOT	ACRES
1	IRRIG	COC-75-1	14	15	32	SWSE	1301	0.40ac
1	IRRIG	COC-75-1	15	15	04	NWNW	1301	1.65ac
1	IRRIG	COC-75-1	15	15	04	SWNW	1301	4.18ac

- Person interviewed (if any): None
- Method of irrigation (pump, flood, etc): Pivot / sprinkle
- Use (crops produced): orchard grass
- Method used to calculate area irrigated: field maps + GPS (tremble)
- Is beneficial use achieved: yes
 - Dated photos of beneficial use: 8/19/21
 - Are there any mapping changes: NO
 - Submit map changes to mapping for updates to ARC. Date submitted: _____
 - Update QQ/TL changes in WWIN: _____
 - Enter use into WWIN: 7/12/22

IF INCOMPLETE:

- Failure to Prove up _____ acres of transferred water right
- Extension Filed: _____

NOTES:

1st Review:

Irrigated and growing Orchard grass.
Documented w/ photos in field maps and
GPS.

2nd Review:

3rd Review (if not complete assess \$150 fee)

Final Inspec by JF. 8/19/21

CROOK COUNTY SEC.32 T14S R15E


E-RECEIVED
07/20/2022
OWRD



SCALE - 1" = 400'




SE 1/4 OF THE SE 1/4

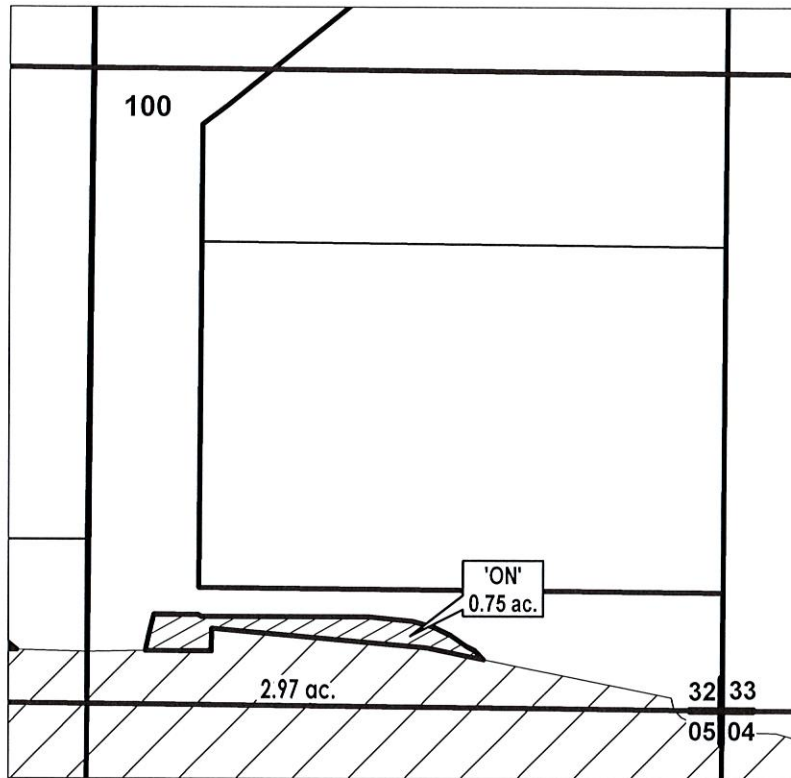OWRD#: T-13589



	ON LANDS
	EXISTING WATER RIGHTS

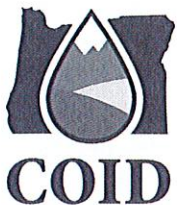

FINAL PROOF MAP

NAME: McLane, Michael/Holly

TAXLOT #: 100

0.75 ACRES

Date: 7/13/2022

CROOK COUNTY SEC.32 T14S R15E


E-RECEIVED
07/20/2022
OWRD



SCALE - 1" = 400'



SW 1/4 OF THE SE 1/4

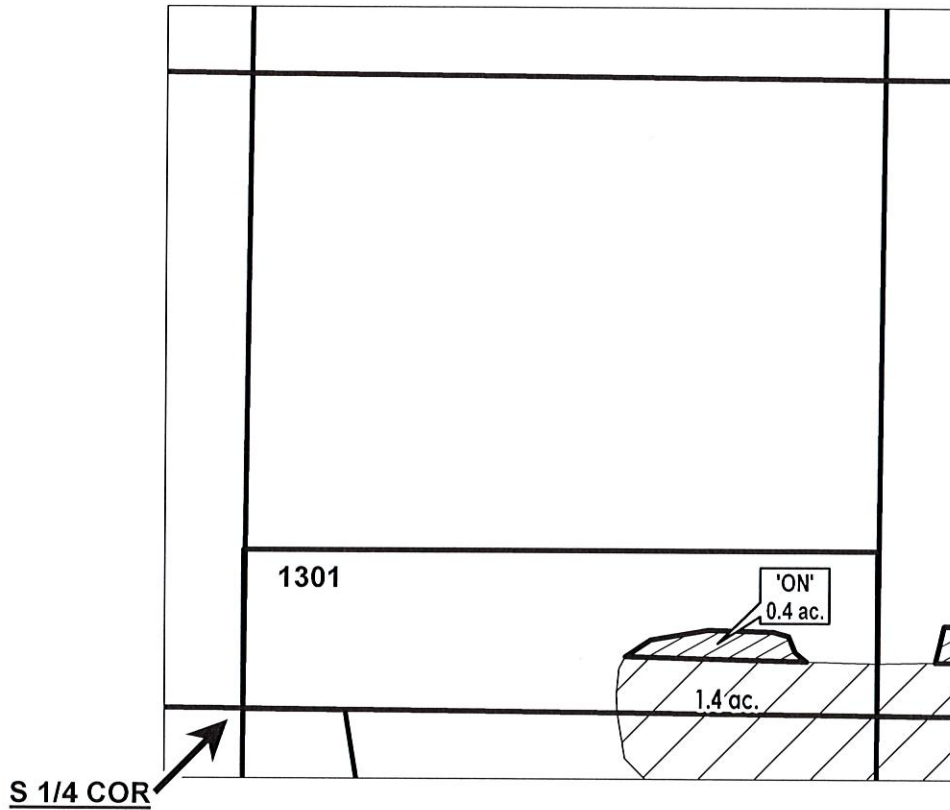OWRD#: T-13589



	ON LANDS
	EXISTING WATER RIGHTS



FINAL PROOF MAP

NAME: Steak on the Hoof, LLC

TAXLOT #: 1301

0.4 ACRES

Date: 7/13/2022

CROOK COUNTY SEC.04 T15S R15E


E-RECEIVED
07/20/2022
OWRD


SCALE - 1" = 400'




NW 1/4 OF THE NW 1/4; SW 1/4 OF THE NW 1/4

OWRD #: T-13589

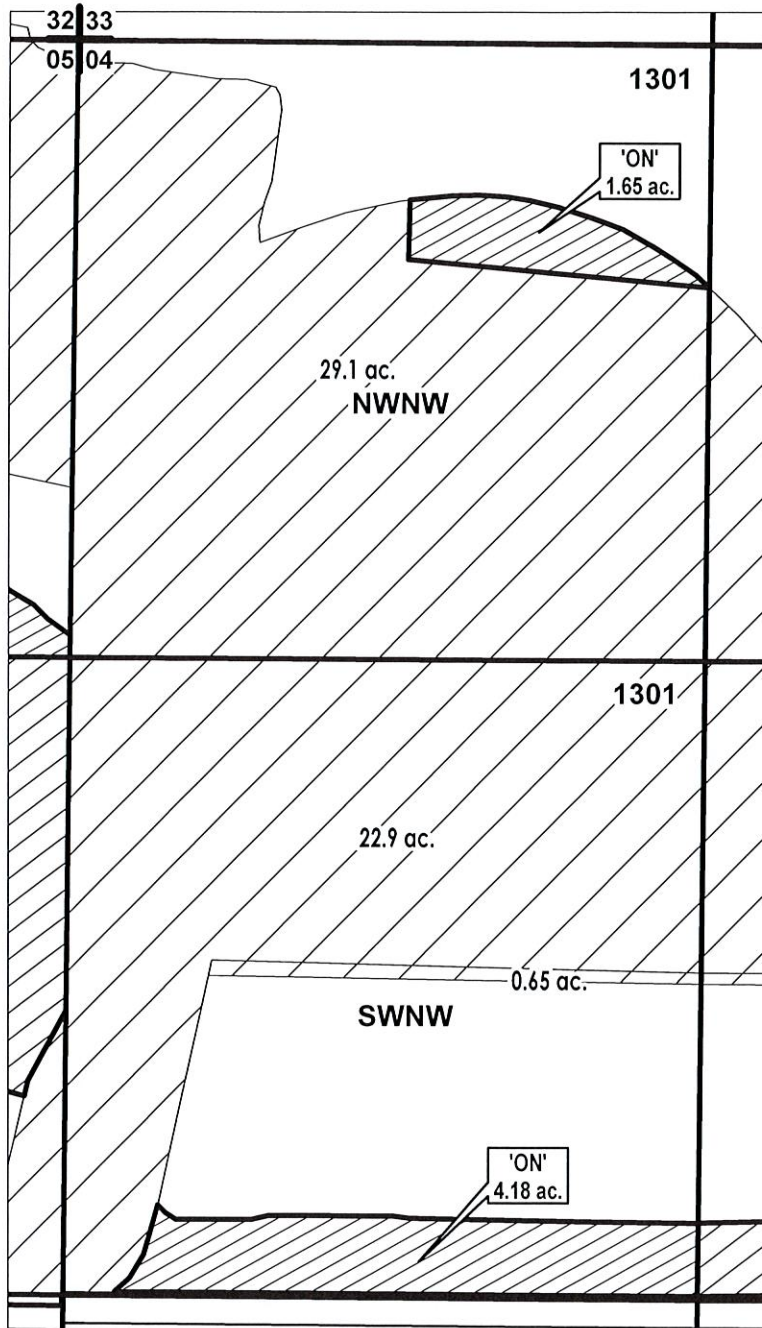

 ON LANDS
EXISTING WATER RIGHTS

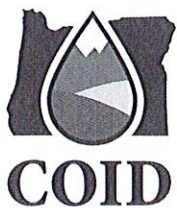

FINAL PROOF MAP

NAME: Steak on the Hoof, LLC

TAXLOT #: 1301

5.83 ACRES

Date: 7/12/2022

FINAL PROOF SITE REPORT

Claim of Beneficial Use

Property Owner (Applicant): Larkin, Jeff/Julie

Petition #: P-2020-002

Current Owner:

OWRD#: T-13589

Property Address: 5190 NW Elm Ave Redmond

Notice #:

POD	USE	HG	TWP	RNG	SEC	QQ	TAX LOT	ACRES
11	IRRIG	B-19-1-2	15	12	12	SESE	401	1.0

- Person interviewed (if any): Jeff
- Method of irrigation (pump, flood, etc): pump/sprinkle
- Use (crops produced): Pasture
- Method used to calculate area irrigated: Tremble GPS
- Is beneficial use achieved: Yes
- Dated photos of beneficial use: 8-5-21
- Are there any mapping changes: No Yes
 - Submit map changes to mapping for updates to ARC. Date submitted: _____
 - Update QQ/TL changes in WWIN: N/A
- Enter use into WWIN: 7/12/22

IF INCOMPLETE:

- Failure to Prove up _____ acres of transferred water right
- Extension Filed: _____

NOTES:

1st Review: Bu achieved thick pasture grass. 4-5 inches

2nd Review: _____

3rd Review (if not complete assess \$150 fee) _____

Final Inspection by: SS Date: 8-5-21

DESCHUTES COUNTY SEC.12 T15S R12E


E-RECEIVED
07/20/2022
OWRD

SCALE - 1" = 400'



SE 1/4 OF THE SE 1/4

OWRD #: T-13589

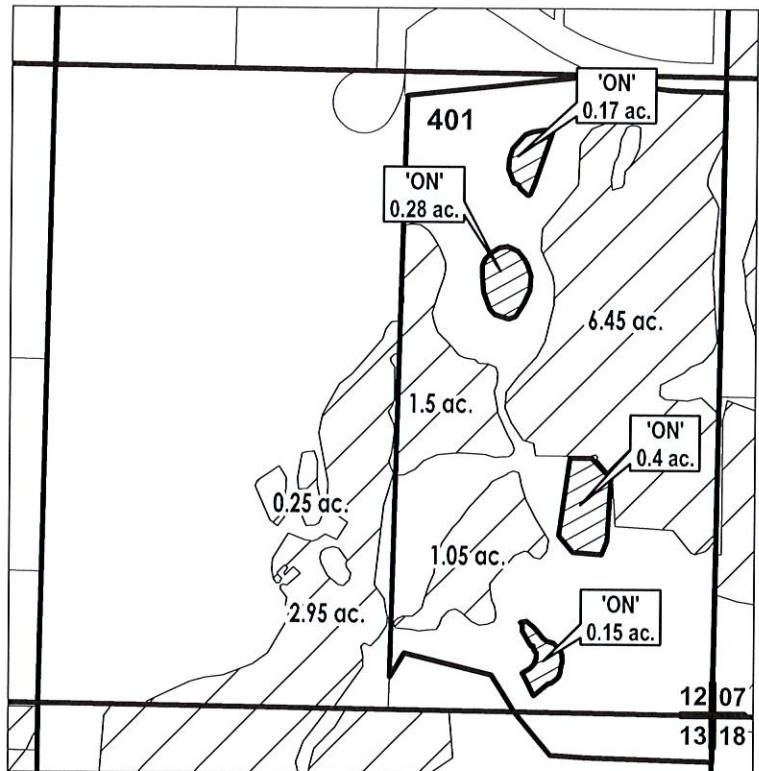

	EXISTING WATER RIGHTS
	ON LANDS



FINAL PROOF MAP

NAME: Jeffrey A. & Julie M. Larkin

TAXLOT #: 401

1.0 ACRES

Date: 7/12/2022

FINAL PROOF SITE REPORT

Claim of Beneficial Use

Property Owner (Applicant): Walker, Aaron

Petition #: P-2020-002

Current Owner:

OWRD#: T-13589

Property Address: 2827 NW Helmholtz Way Redmond

Notice #:

POD	USE	HG	TWP	RNG	SEC	QQ	TAX LOT	ACRES
11	IRRIG	B-32-3	15	13	06	NENW	100	2

- Person interviewed (if any): None
- Method of irrigation (pump, flood, etc): Pump/sprinkle
- Use (crops produced): Pasture 5/5/22
- Method used to calculate area irrigated: Collector
- Is beneficial use achieved: NO — Yes as of 5/5/22
- Dated photos of beneficial use: 5/5/22
- Are there any mapping changes: No
 - Submit map changes to mapping for updates to ARC. Date submitted: _____
 - Update QQ/TL changes in WWIN: _____
- Enter use into WWIN: 7/12/22

IF INCOMPLETE:

- Failure to Prove up 2 acres of transferred water right 5/5/22 Full use
- Extension Filed: _____

NOTES:

1st Review: No BU. No areas were growing anything but weeds. Photos in collector and GIS map of weeded area

2nd Review: 5/5/22 New seed growing 2"! Area covered well and really taking on.

3rd Review (if not complete assess \$150 fee)

Final Inspection by: [Signature] Date: 7/12/22

DESCHUTES COUNTY SEC.06 T15S R13E


E-RECEIVED
07/20/2022
OWRD

SCALE - 1" = 400'



NE 1/4 OF THE NW 1/4

OWRD #: T-13589

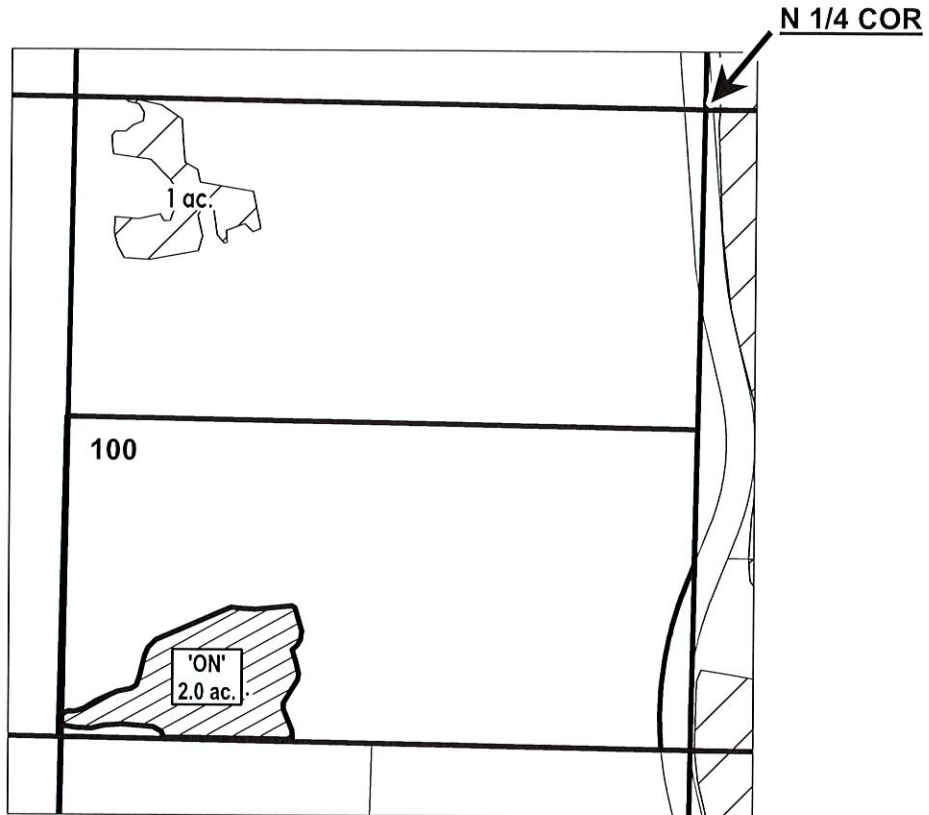

	EXISTING WATER RIGHTS
	ON LANDS



FINAL PROOF MAP

NAME: Walker, Aaron

TAXLOT #: 100

2.0 ACRES

Date: 7/12/2022

FINAL PROOF SITE REPORT

Claim of Beneficial Use

Property Owner (Applicant): Shear, Roger Lee

Petition #: P-2020-002

Current Owner:

OWRD#: T-13589

Property Address: 6635 SW 61st St Redmond

Notice #:

POD	USE	HG	TWP	RNG	SEC	QQ	TAX LOT	ACRES
11	IRRIG	A-21-11-2	16	12	02	SESE	1302	1.4

- Person interviewed (if any): Colei
- Method of irrigation (pump, flood, etc): spinkle-underground system
- Use (crops produced): Lawn
- Method used to calculate area irrigated: collector

Is beneficial use achieved: yes

Dated photos of beneficial use: 5/10/22

Are there any mapping changes: NO

o Submit map changes to mapping for updates to ARC. Date submitted: _____

o Update QQ/TL changes in WWIN: yes

Enter use into WWIN: yes

IF INCOMPLETE:

Failure to Prove up _____ acres of transferred water right

Extension Filed: _____

NOTES:

1st Review:

Full Bl. 5-6" of thick grass down sides of driveway and around pond. Area next to shop seeded. Back pasture thick.

2nd Review:

3rd Review (if not complete assess \$150 fee)

Final Inspection by: [Signature]

Date: 5/10/22

DESCHUTES COUNTY SEC.02 T16S R12E


E-RECEIVED
07/20/2022
OWRD

SCALE - 1" = 400'



SE 1/4 OF THE SE 1/4

OWRD #: T-13589

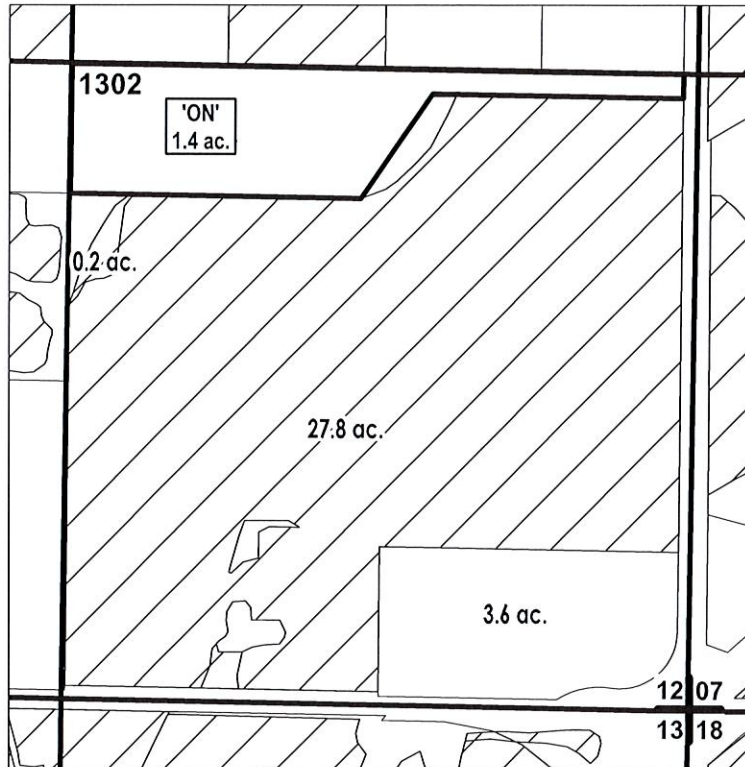

# ac.	PARCELS W/ WATER RIGHTS
	EXISTING WATER RIGHTS
	ON LANDS



FINAL PROOF MAP

NAME: Shear, Roger Lee II

TAXLOT #: 1302

1.4 ACRES

Date: 7/12/2022

FINAL PROOF SITE REPORT

Claim of Beneficial Use

Property Owner (Applicant): Gasper, Grant Anthony

Petition #: P-2020-002

Current Owner: Nathan & Amy Holcomb (#5801)

OWRD#: T-13589

Property Address: 21370 View Lane Bend

Notice #:

POD	USE	HG	TWP	RNG	SEC	QQ	TAX LOT	ACRES
11	IRRIG	A-4-10-1	17	12	14	SENW	803	0.43
11	IRRIG	A-4-10-1	17	12	14	SWNE	803	0.57

- Person interviewed (if any): None
- Method of irrigation (pump, flood, etc): pump/sprinkle
- Use (crops produced): Irrigation
- Method used to calculate area irrigated: collector

Is beneficial use achieved: Yes

Dated photos of beneficial use: 8-9-21

- Are there any mapping changes: No
 - o Submit map changes to mapping for updates to ARC. Date submitted: _____
 - o Update QQ/TL changes in WWIN: _____

Enter use into WWIN: 7/12/22

IF INCOMPLETE:

- Failure to Prove up _____ acres of transferred water right
- Extension Filed: _____

NOTES:

1st Review: BU achieved. Irrigation around house. Photos in collector

2nd Review: _____

3rd Review (if not complete assess \$150 fee) _____

Final Inspection by: SS Date: 8-9-21

DESCHUTES COUNTY SEC.14 T17S R12E


E-RECEIVED
07/20/2022
OWRD

SCALE - 1" = 400'



SE 1/4 OF THE NW 1/4; SW 1/4 OF THE NE 1/4

OWRD #: T-13589

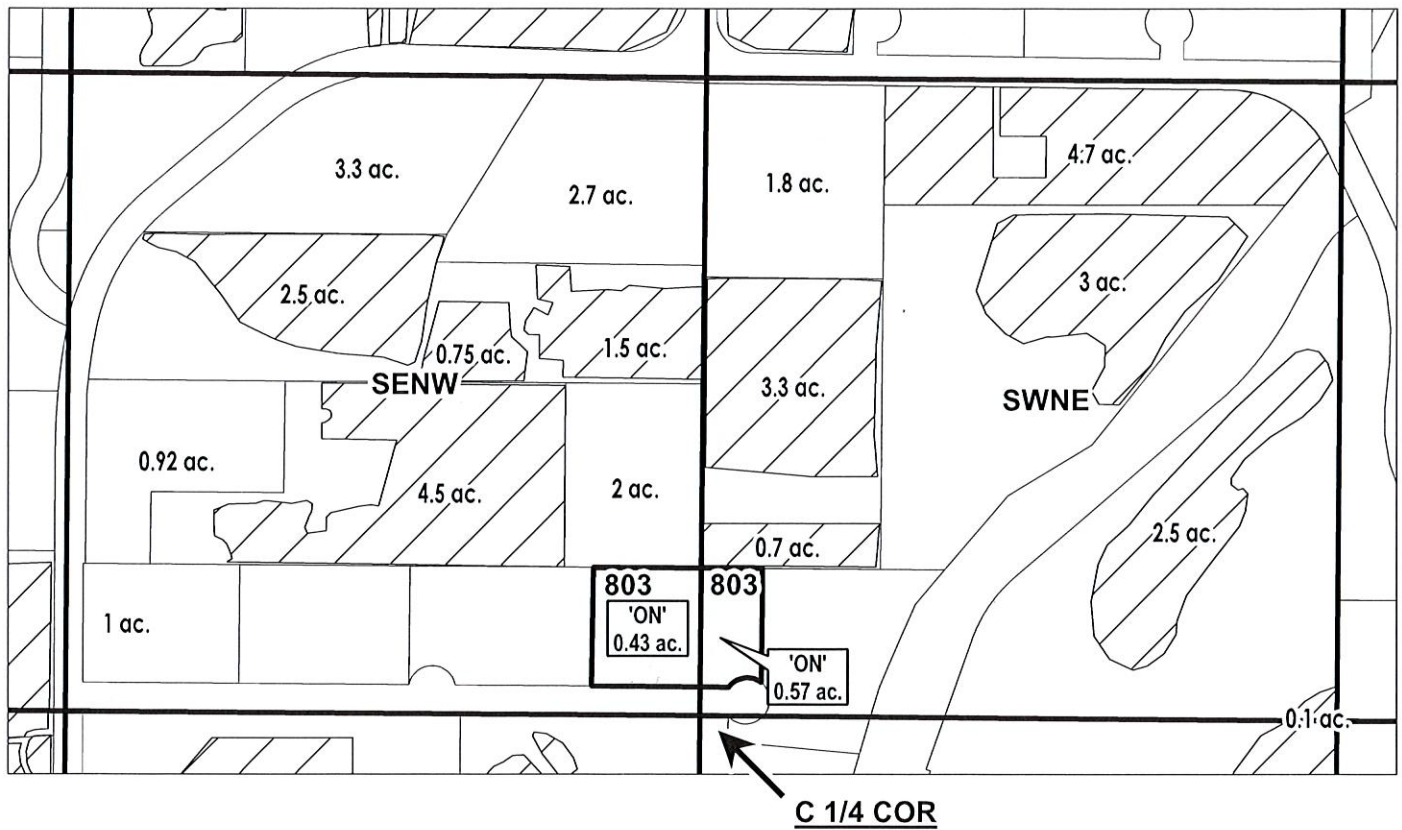

# ac.	PARCELS W/ WATER RIGHTS
	EXISTING WATER RIGHTS
# ac.	'ON' LAND PARCELS



FINAL PROOF MAP

NAME: Holcomb, Nathan/Amy

TAXLOT #: 803

1.0 ACRES

Date: 7/12/2022

FINAL PROOF SITE REPORT

Claim of Beneficial Use

Property Owner (Applicant): Rich & Ellingson HWY 20 Residence Trust **Petition #:** P-2020-002

Current Owner:

OWRD#: T-13589

Property Address: 22185 HWY 20 Bend

Notice #:

POD	USE	HG	TWP	RNG	SEC	QQ	TAX LOT	ACRES
11	IRRIG	C-1-2	17	13	31	NESW	200	1.97

- Person interviewed (if any): None
- Method of irrigation (pump, flood, etc): Pump/sprinkle
- Use (crops produced): Pasture Grass
- Method used to calculate area irrigated: field maps
- Is beneficial use achieved: Yes as of 7/12/22
- Dated photos of beneficial use: 7/12/22 and 8/9/21
- Are there any mapping changes: NO
 - Submit map changes to mapping for updates to ARC. Date submitted: _____
 - Update QQ/TL changes in WWIN: _____
- Enter use into WWIN: 7/12/22

IF INCOMPLETE:

- Failure to Prove up 0.36 acres of transferred water right Full use as of 7/12/22
- Extension Filed: _____

NOTES:

1st Review: 8-9-21. SR, Western transfer areas good, producing

Pasture grass. Eastern transfers closest to house
 2nd Review: dry. photos in collector 5/11/22 spoke w/ Dan. He is
planting area by the house. ~ JT

7/12/22 New seed w/ 2" growth.
Full use.

3rd Review (if not complete assess \$150 fee)

Final Inspection by: J. Galbo Date: 7/12/22

DESCHUTES COUNTY SEC.31 T17S R13E


E-RECEIVED
07/20/2022
OWRD

SCALE - 1" = 400'



NE 1/4 OF THE SW 1/4

OWRD #: T-13589

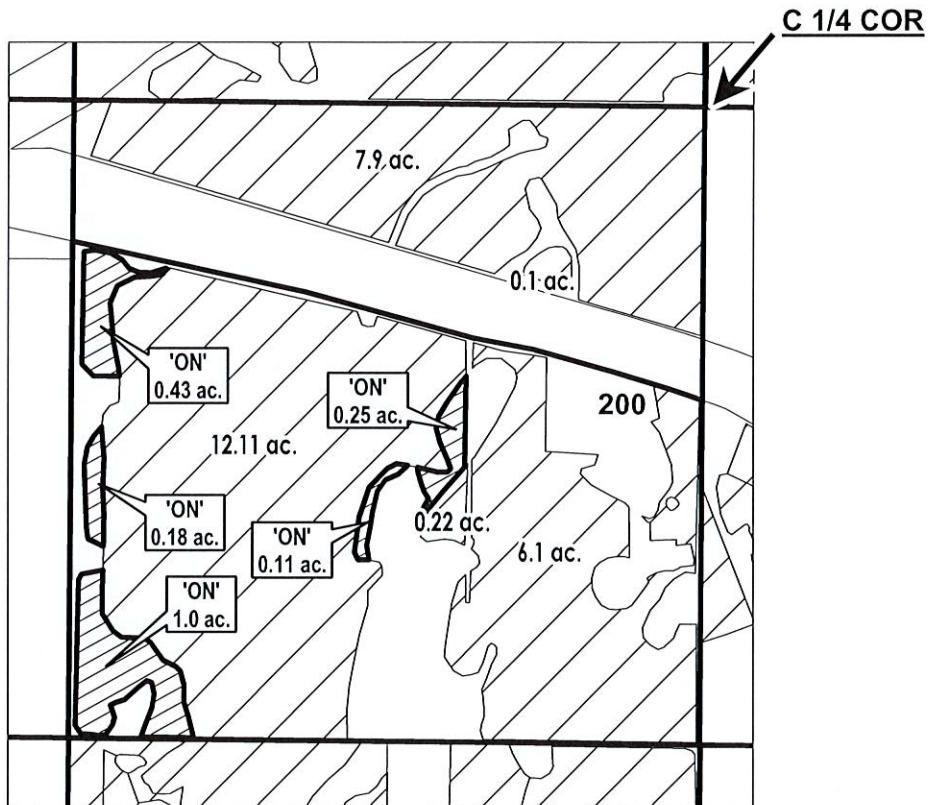

	EXISTING WATER RIGHTS
	ON LANDS



FINAL PROOF MAP

NAME: Rich & Ellingson Hwy 20 Residence Trust

TAXLOT #: 200

1.97 ACRES

Date: 7/12/2022