


RIDGEVIEW IRRIGATION DISTRICT

Permanent OFF Transfer Map For Paul Shenk Certificate 81012

OWRD RECEIVED
 Ann Recce: 1/20/2022 4:04:46 PM


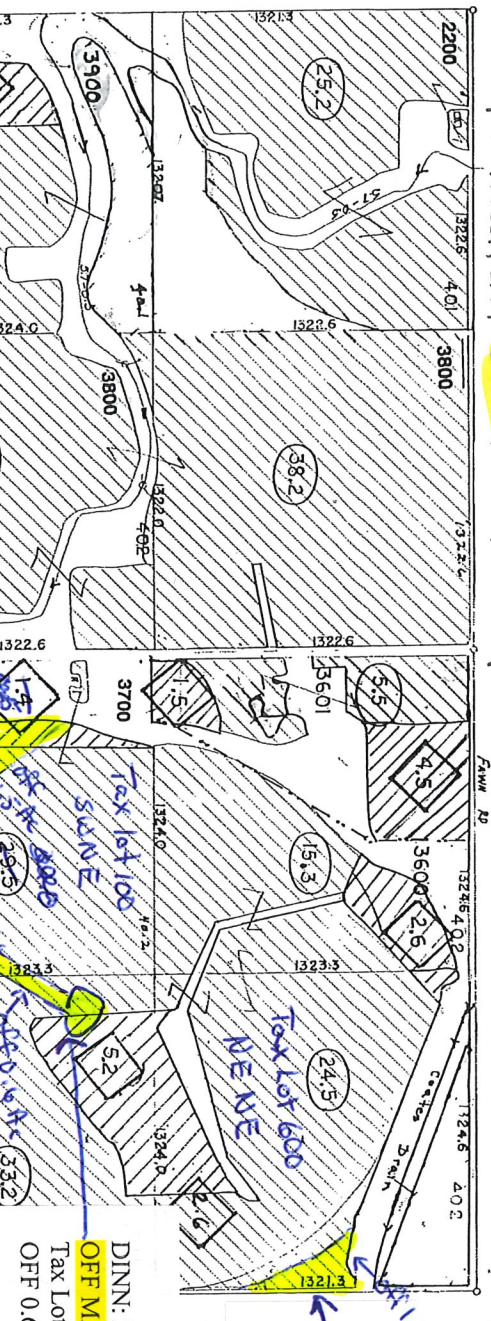


DINN: 2021-02
OFF MAP
 Tax Lot 100 22S46E36 SWNE
 1.5 acres and 0.9 acres OFF
 OFF 2.4 Acres Total

DINN: 2021-02
OFF MAP
 Tax Lot 100 22S46E36 SENE
 OFF 0.6 Acre Total

DINN: 2021-02
OFF MAP
 Tax Lot 600 22S46E36 NENE
 OFF 1.0 Acre Total

Now Approved In.

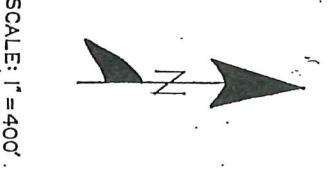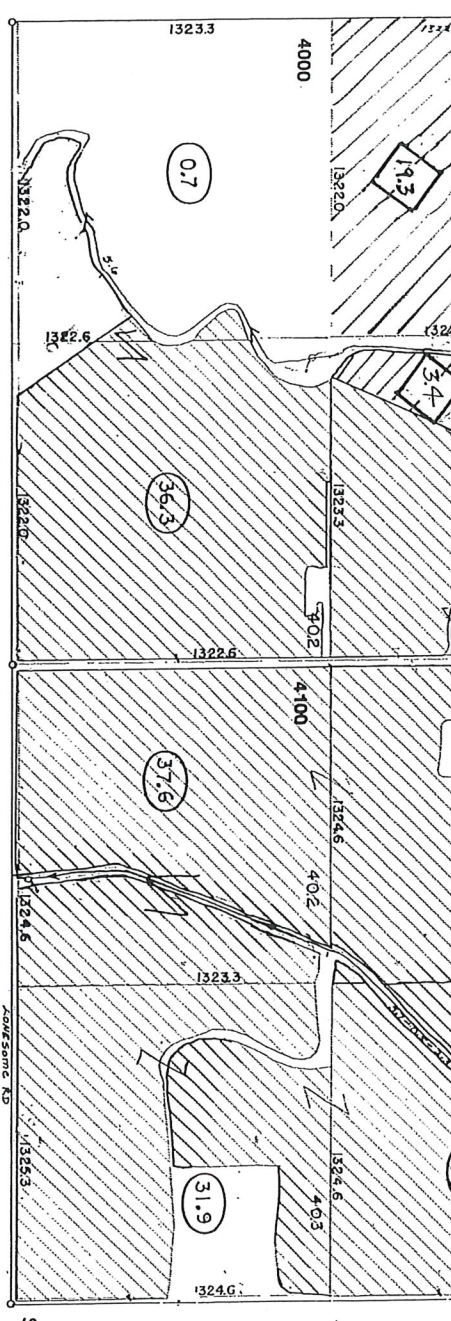


SEC. 36, T:22 S., R.46 E., W.M.

Traced: R.E.
 Checked: H.G. 5-13-55
 5-27-55

RIDGEVIEW IRRIGATION DISTRICT

Permanent on Transfer Map For Paul Sheink Ceth Acct 81012

DINN:2021-02
ON MAP
Tax Lot 100 22S46E36 SWNE
ON 4.0 Acres Total

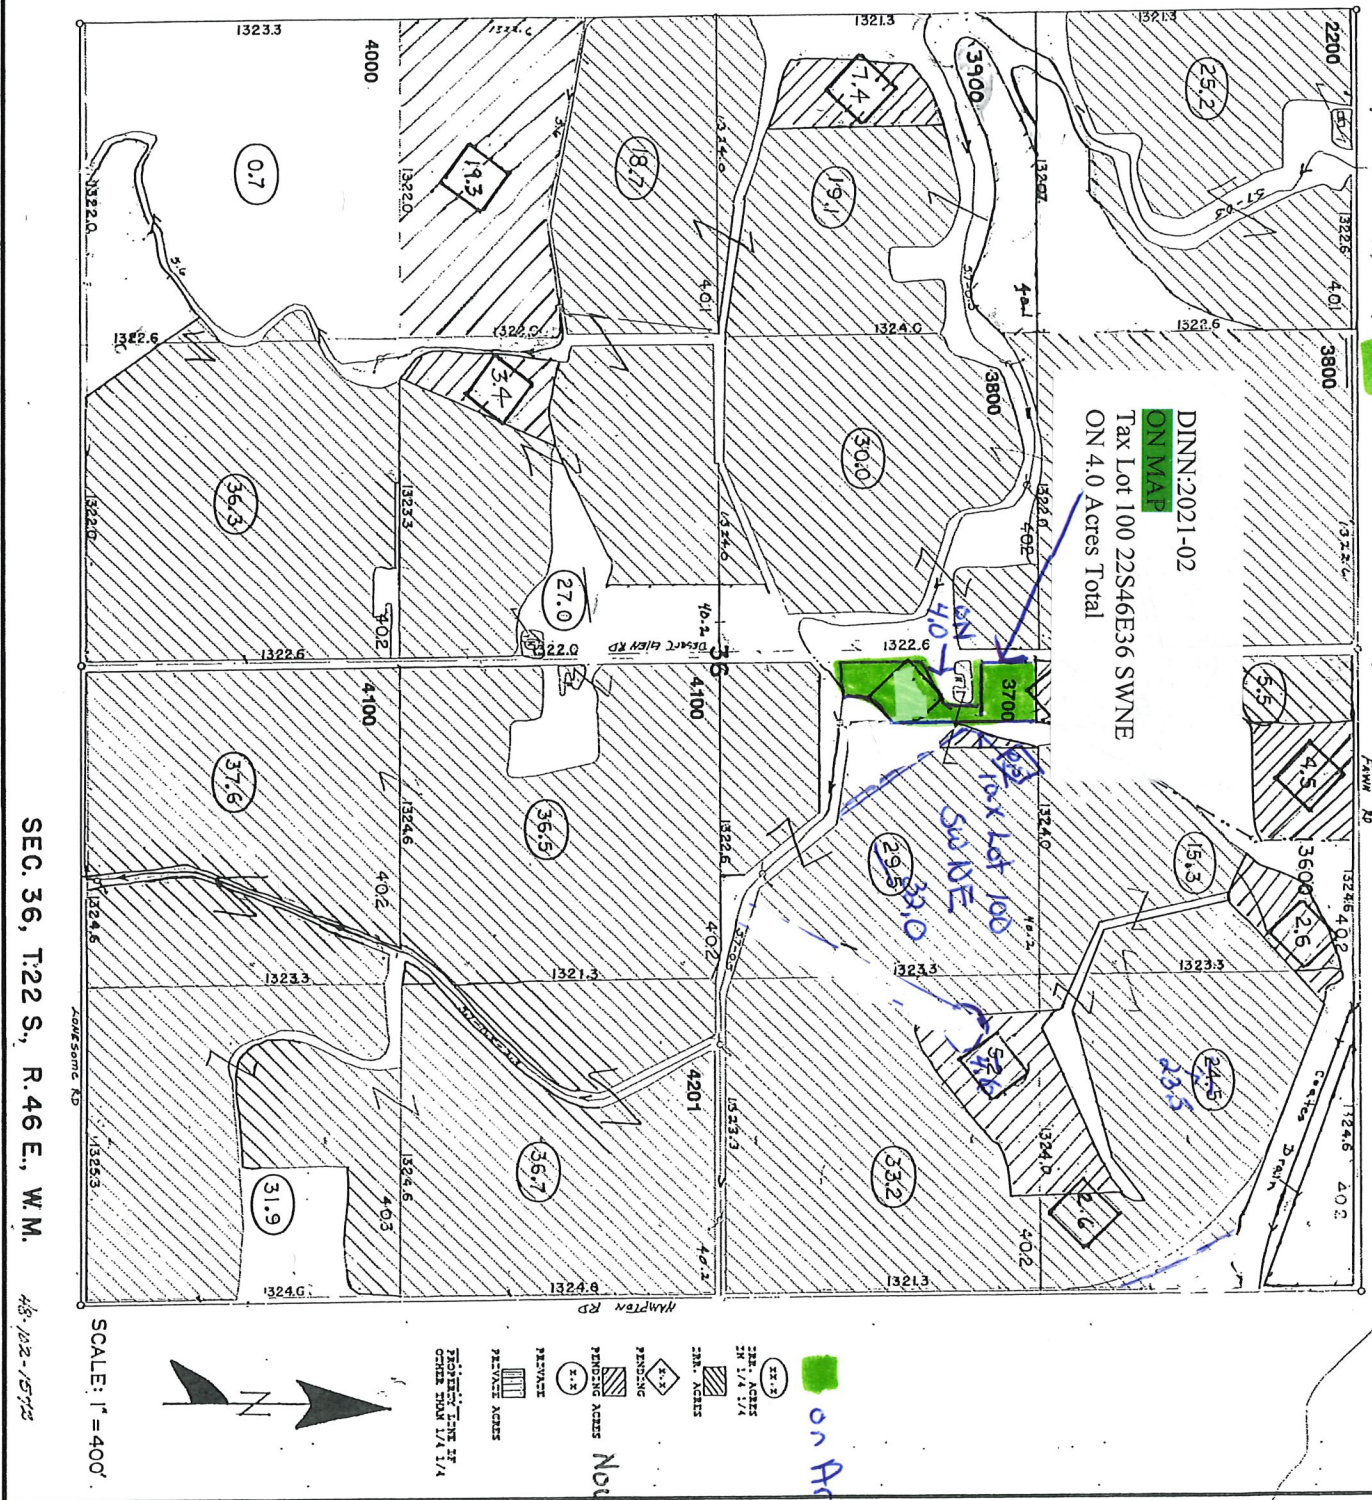

Now Approved Inc.

OWRD RECEIVED
Ann Reece, 1/20/2022, 4:04:46 PM

Trace d: R.E. 5-13-55
Checked: H.G. 5-27-55

SEC. 36, T:22 S., R. 46 E., W.M.

48-122-15722

OWRD RECEIVED
Ann Reece, 1/20/2022, 4:03:23 PM

RIDGEVIEW IRRIGATION DISTRICT

Permanent on Transfer Map for Price Seed Farm Certificate 8101A

DINN: 2021-0003
ON VAT
Tax Lot 100 22S46E10 NENW
ON 1.4 Acres Total

Un Area

RECEIVED
AUG 29 2003
WATER RESOURCES DEPT.
SALEM, OREGON

Not Approved



SCALE: 1" = 400'

- REG. ACRES IN 1/4 1/4
- REG. ACRES
- PENDING ACRES
- PENDING
- PRIVATE
- PRIVATE ACRES
- PROPERTY LINE IF OTHER THAN 1/4 1/4

SOUTHWEST CORNER OF SECTION 10


Traced: BWR 4-15-53
Checked: RFE 5-20-55

SEC. 10, T.22 S., R. 46 E., W. M. 48-102-155B

RIDGEVIEW IRRIGATION DISTRICT

Permanent **off** Transfer Map
 For Rice Seed Farm
 Certificate 81012

OWWRD RECEIVED
 Ann Reece, 1/20/2022, 4:03:06 PM

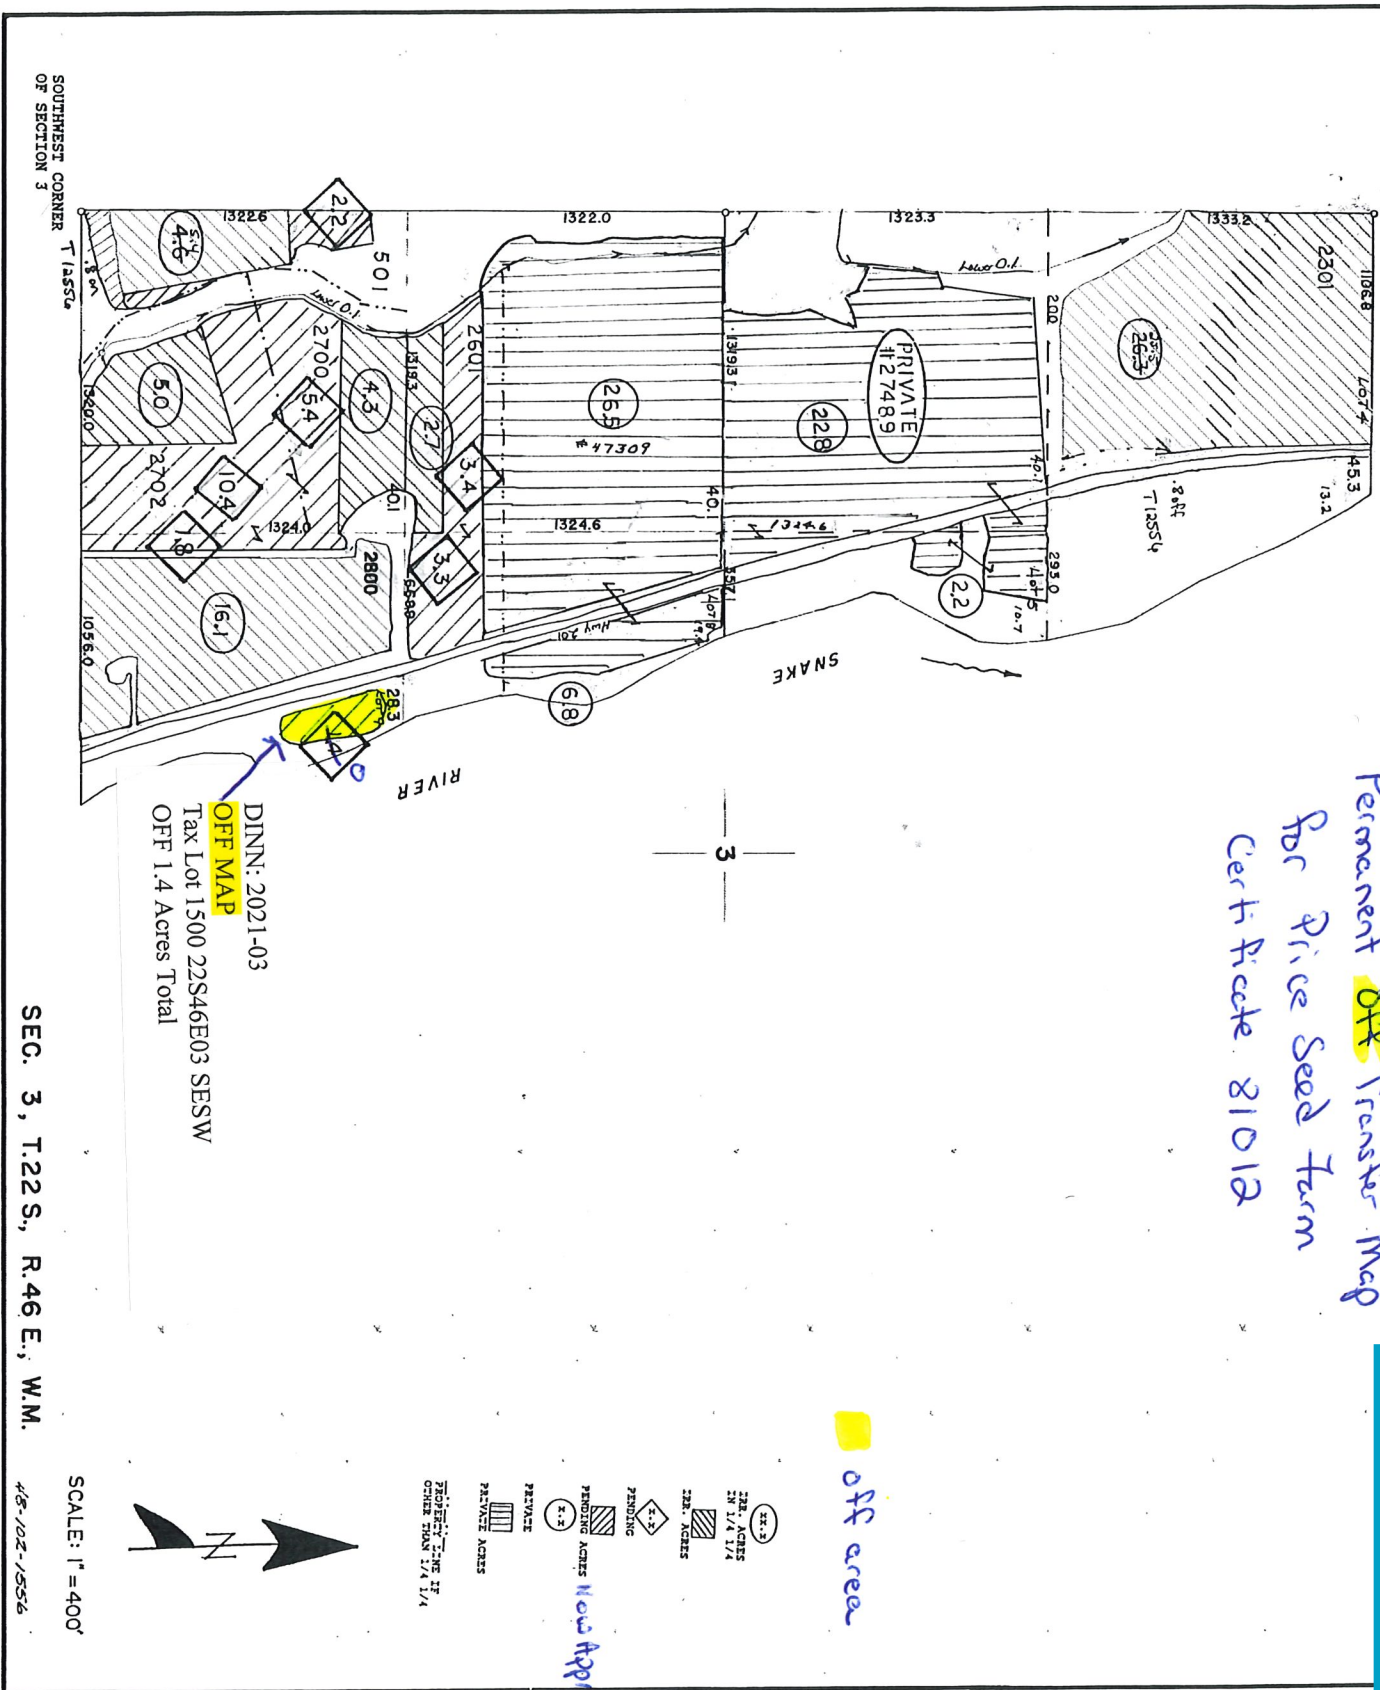

DINNI: 2021-03
OFF MAP
 Tax Lot 1500 22S46E03 SESW
 OFF 1.4 Acres Total

SEC. 3, T.22 S., R.46 E., W.M.

Traced: R.W.R. 4-15-53
 Checked: R.F. 6-20-55


SCALE: 1" = 400'

48-102-1556

SUPERSEDED

RIDGEVIEW IRRIGATION DISTRICT

Permanent Transfer - ON Paul Shank

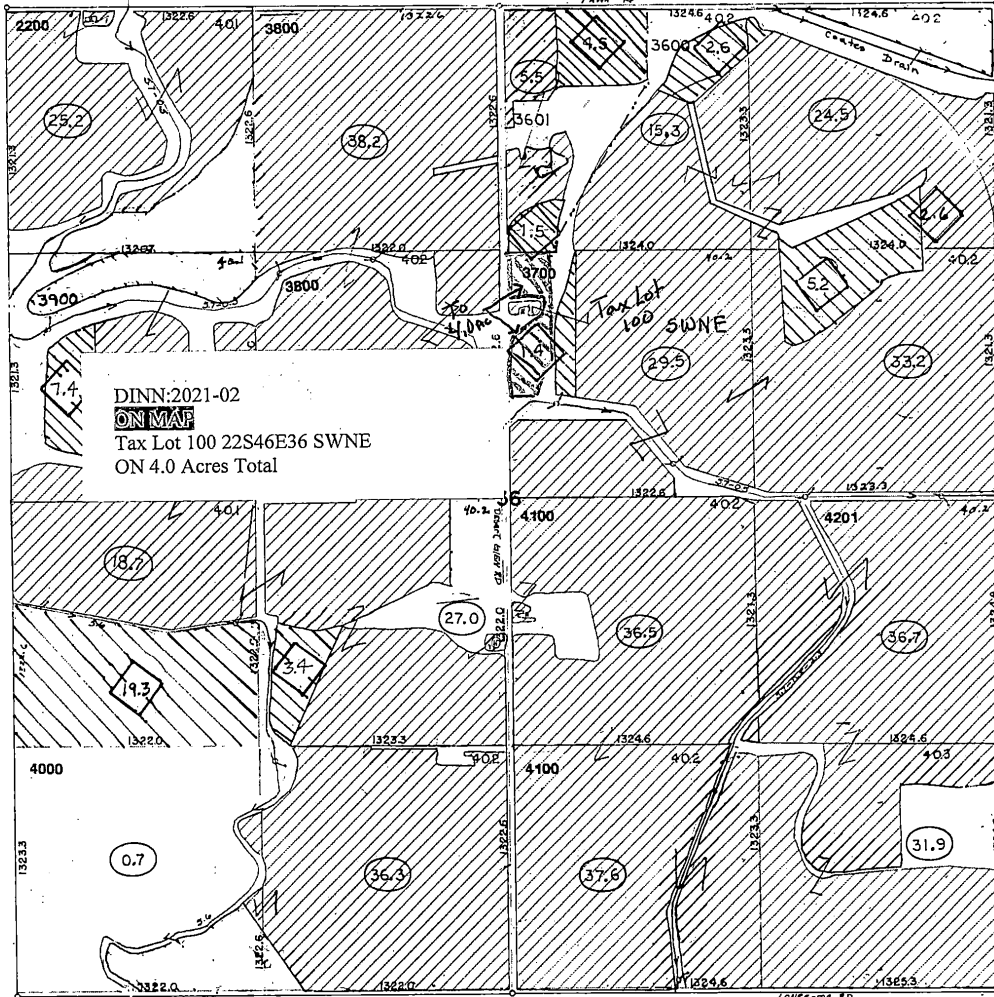

98861

SEC. 36, T.22 S., R. 46 E., W.M.

Traced: R.E. 6-13-55
Checked: H.G. 8-27-55


RECEIVED
JAN 03 2022
OWRD

SUPERSEDED

RIDGEVIEW IRRIGATION DISTRICT

Permanent Transfer - ON Price Seed
To: 1.4 Ac

DINN: 2021-02
ON MAP
Tax Lot 100 22S46E10 NENW
ON 1.4 Acres Total

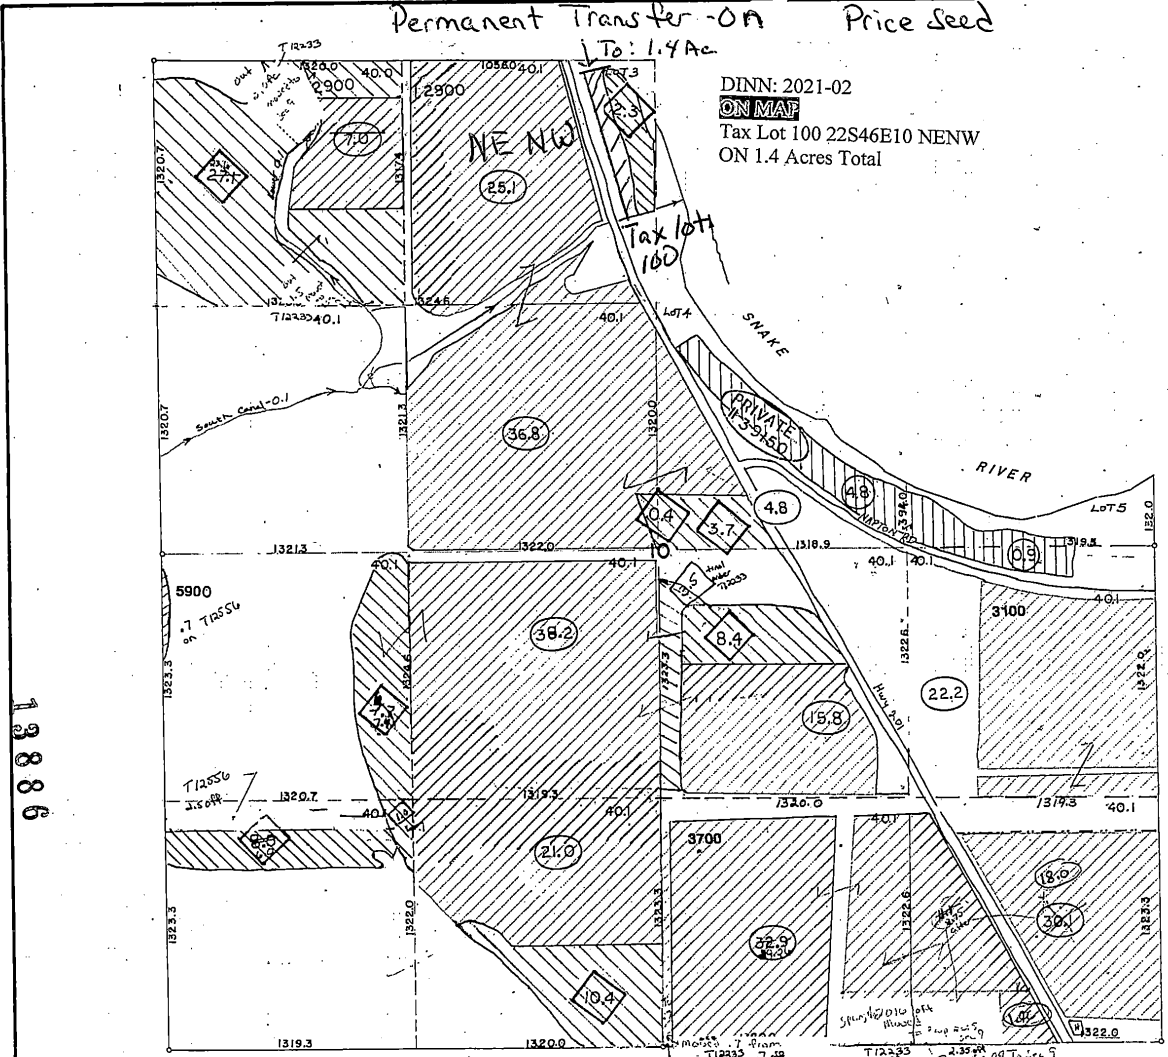

- XX.X IRR. ACRES OR 1/4 1/4
- IRR. ACRES
- PENDING ACRES
- PENDING ACRES
- PRIVATE
- PRIVATE ACRES
- PROPERTY LINE IF OTHER THAN 1/4 1/4



RECEIVED
JAN 03 2022

SCALE: 1" = 400'

OWRD

13886

SOUTHWEST CORNER
OF SECTION 10


SEC. 10, T.22 S., R.46 E., W.M. 48-102-1558

Traced: R.W.R. 4-15-53
Checked: R.F. 6-20-55

SUPERSEDED

RIDGEVIEW IRRIGATION DISTRICT

Permanent Transfer Off Price Seed

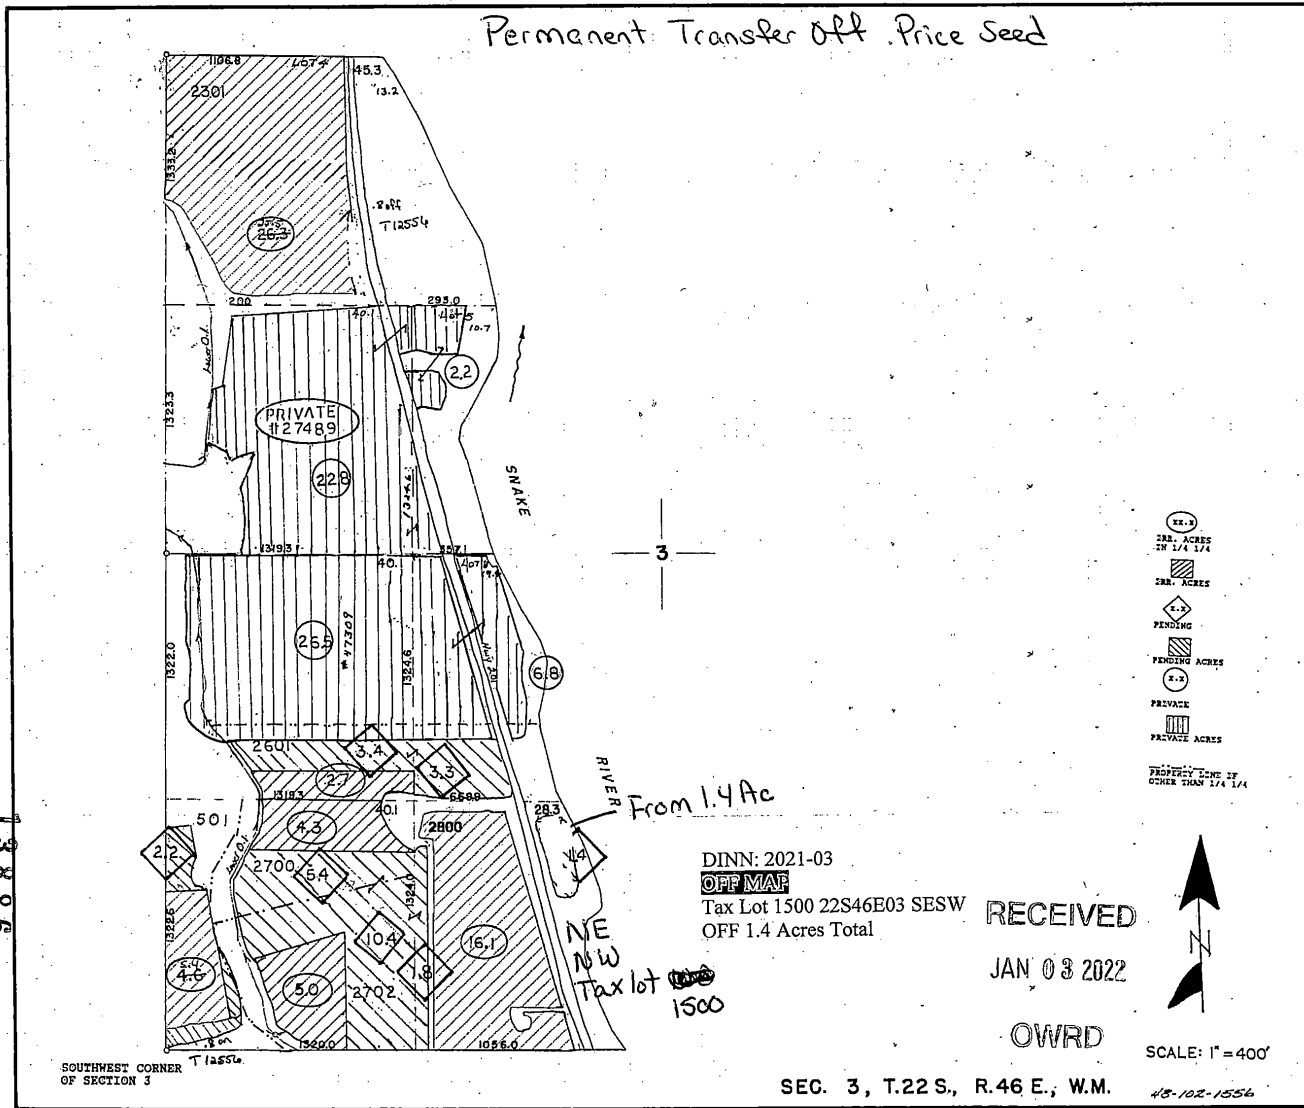

- EX. 1
- PENDING
- PENDING ACRES
- PRIVATE
- PRIVATE ACRES
- PROPERTY LINE IS OTHER THAN 1/4 1/4

DINN: 2021-03
OFF MAP
 Tax Lot 1500 22S46E03 SESW
 OFF 1.4 Acres Total

RECEIVED

JAN 03 2022

OWRD

SCALE: 1"=400'

SEC. 3, T.22 S., R.46 E., W.M.

18-102-1556

SOUTHWEST CORNER OF SECTION 3

Traced: R.M.P. 4-16-53
 Checked: R.F. 6-20-55

13886

SUPERSEDED

RIDGEVIEW IRRIGATION DISTRICT

Paul Shank Permanent Transfer - off

DINN: 2021-02

OFF MAP

Tax Lot 600 22S46E36 NENE
OFF 1.0 Acre Total

RECEIVED
JAN 03 2022
OWRD

13886

DINN: 2021-02


OFF MAP

Tax Lot 100 22S46E36 SENE
OFF 0.6 Acre Total

DINN: 2021-02

OFF MAP

Tax Lot 100 22S46E36 SWNE
OFF 2.4 Acres Total

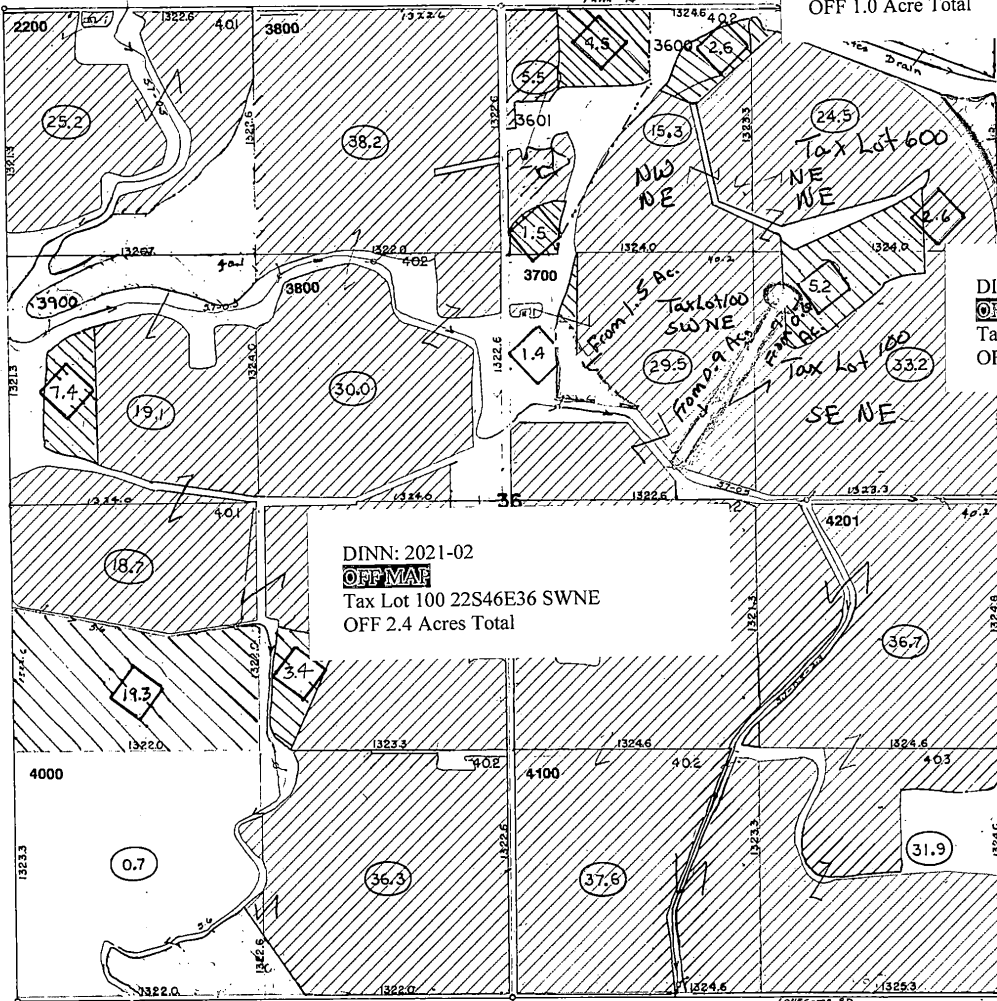

SEC. 36, T:22 S., R. 46 E., W.M.


45-202-15722

Traced: R.E. 6-13-55
Checked: H.G. 6-27-55

RIDGEVIEW IRRIGATION DISTRICT

Permanent Transfer - ON Paul Shank

RECEIVED
JAN 08 2022
OW RD

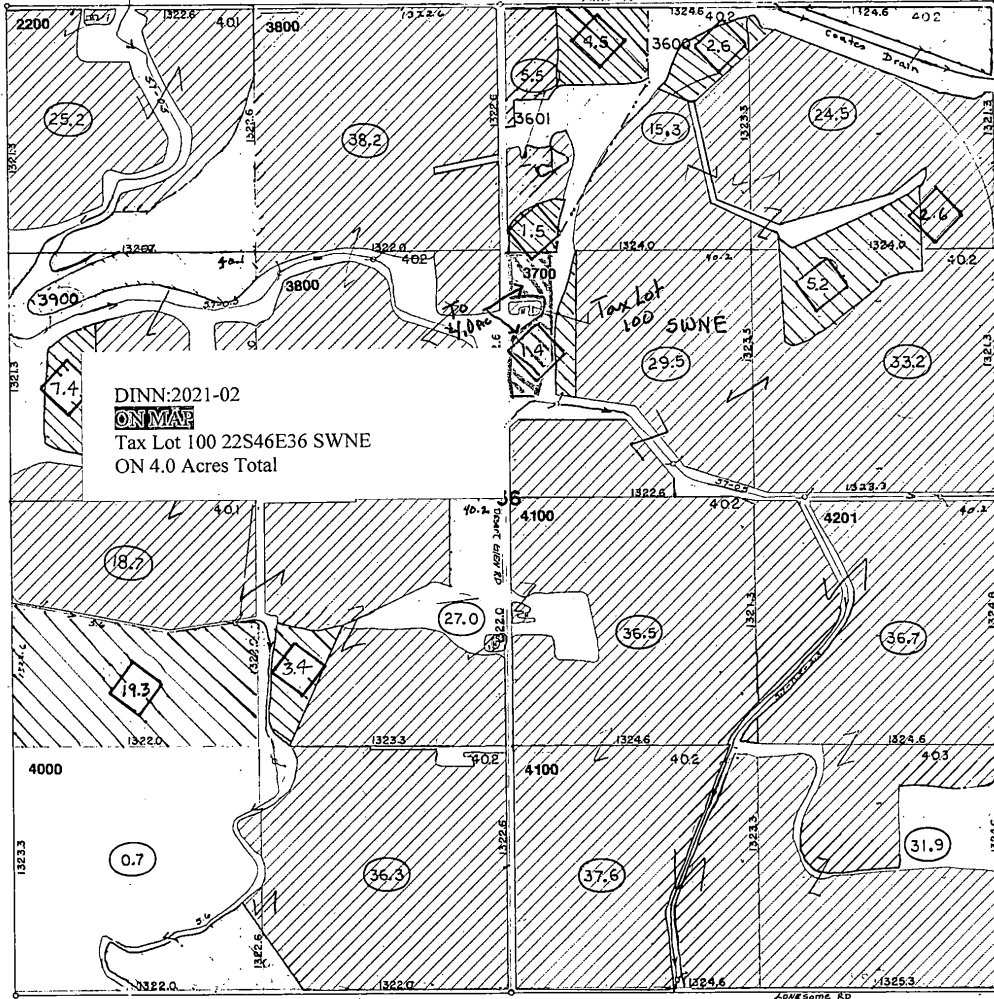

DINN:2021-02
ON MAP
 Tax Lot 100 22S46E36 SWNE
 ON 4.0 Acres Total

- 1/4 ACRES IN 1/4 1/4
- 1/2 ACRES
- PENDING ACRES
- PRIVATE ACRES
- PROPERTY LESS THAN 1/4 1/4

See Copy of
 Sale Map of
 Office of
 Public Rights
 Thomas

SCALE: 1" = 400'

SEC. 36, T:22 S., R. 46 E., W.M.


Traced: R.E. 6-13-55
 Checked: H.G. 6-21-55

13886

RECEIVED
 JAN 03 2022
 OWRD

RIDGEVIEW IRRIGATION DISTRICT

Permanent Transfer off Price Seed

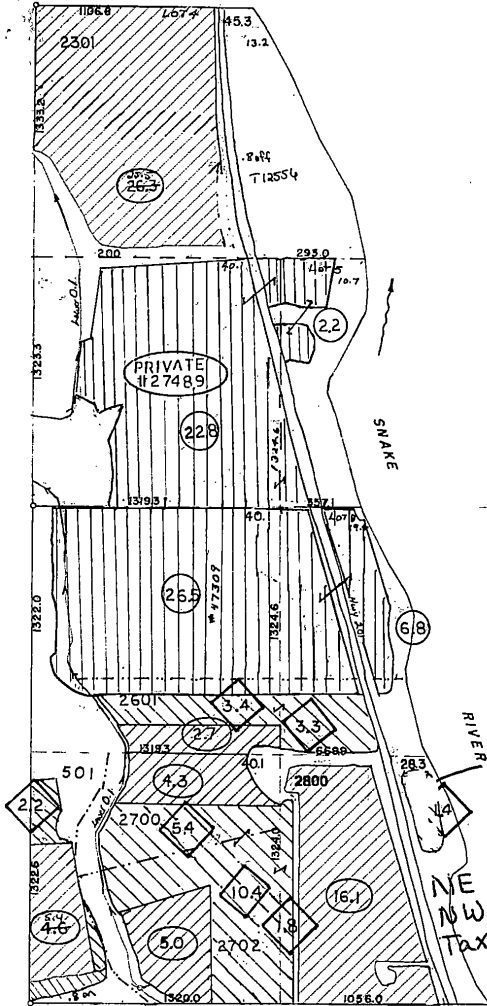

3

From 1.4 Ac

NE NW Tax lot 1500

DINN: 2021-03
OFF MAP
 Tax Lot 1500 22S46E03 SESW
 OFF 1.4 Acres Total

- EX-1
- IRR. ACRES IN 1/4 1/4
- IRR. ACRES
- PENDING
- PENDING ACRES
- PRIVATE
- PALVATE ACRES
- PROPERTY LINE OF OTHER THAN 1/4 1/4



SCALE: 1" = 400'

SOUTHWEST CORNER OF SECTION 3

SEC. 3, T.22 S., R.46 E., W.M.

45-102-1556

Traced: R.W.F. 4-15-53
 Checked: R.E. 6-20-55

13886

RIDGEVIEW IRRIGATION DISTRICT

Permanent Transfer - ON Price Seed

To: 1.4 Ac.

DINN: 2021-02


ON MAE

Tax Lot 100 22S46E10 NENW

ON 1.4 Acres Total

RECEIVED
JAN 03 2022
OWRD

13886

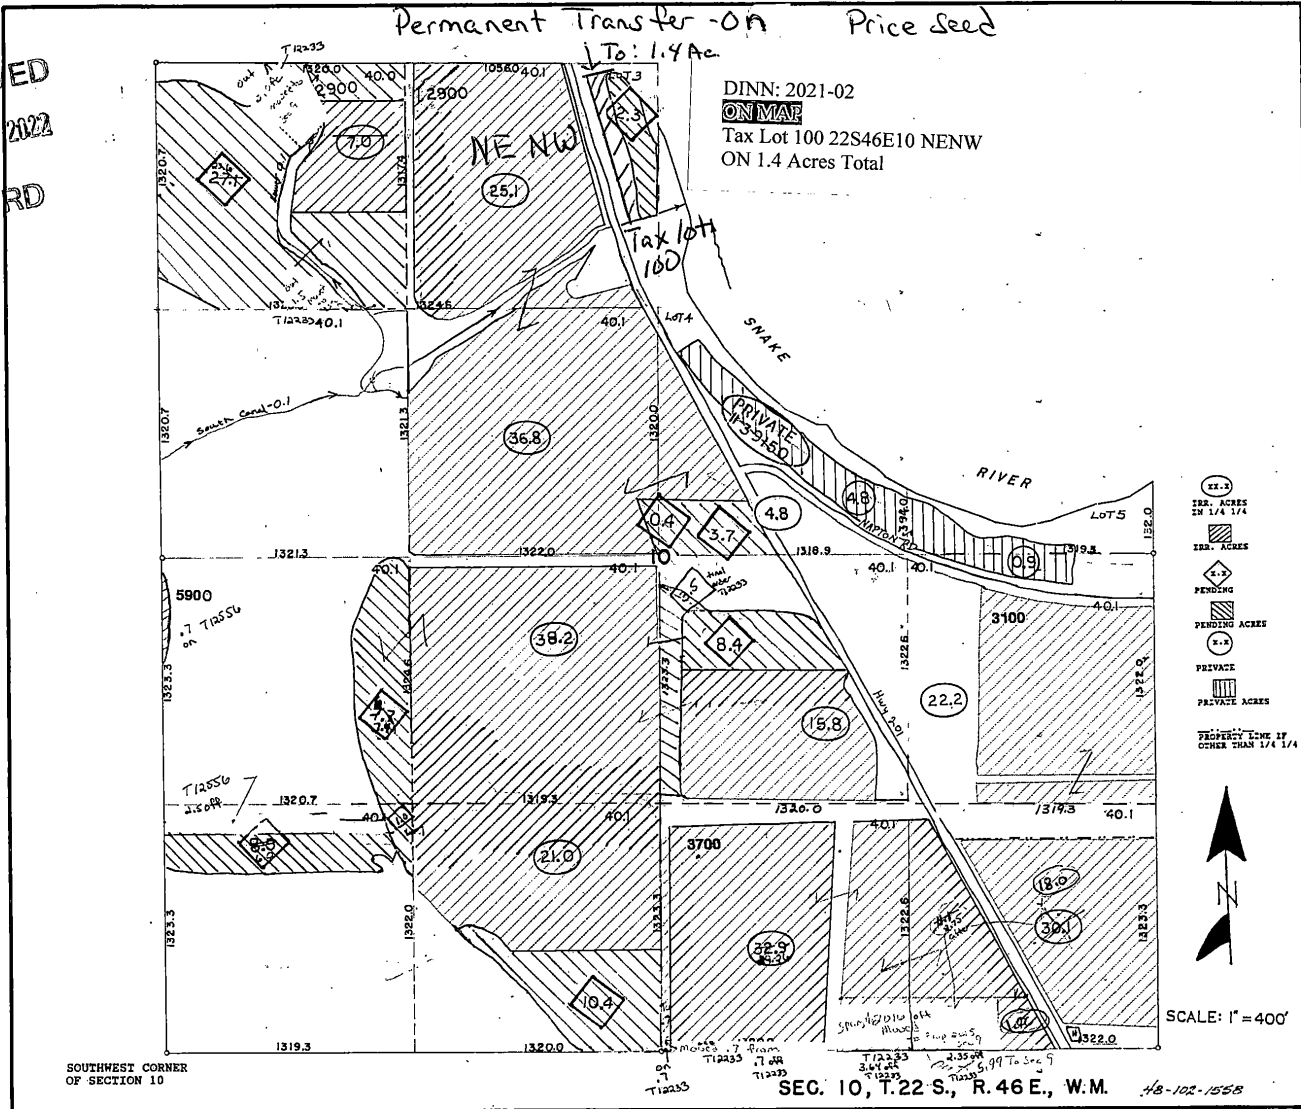

SOUTHWEST CORNER
OF SECTION 10

SEC. 10, T.22 S., R. 46 E., W.M.

48-102-1558

Traced: R.W.R. 4-15-53
Checked: R.F. 6-20-55