

RECEIVED
FEB 21 1995
WATER RESOURCES DEPT.
SALEM, OREGON


EXHIBIT
B

TYE ENGINEERING, INC.
725 NW HILL - BEND, OREGON 97701 - (503) 389-6959
SCALE: 1"=400' DATE: FEB. 13, 1995 DRAWN: P.A.T. DWG #: 267

WATER RIGHTS TRANSFER
T. 17 S., R. 15 E., W.M.,
CROOK COUNTY, OREGON


REVISION TO T-7123
APPLICATION NO. G-10003
CERTIFICATE NO. 64772
PERMIT NO. G-10319

IN THE NAME OF
WAYNE P. SINGHOSE

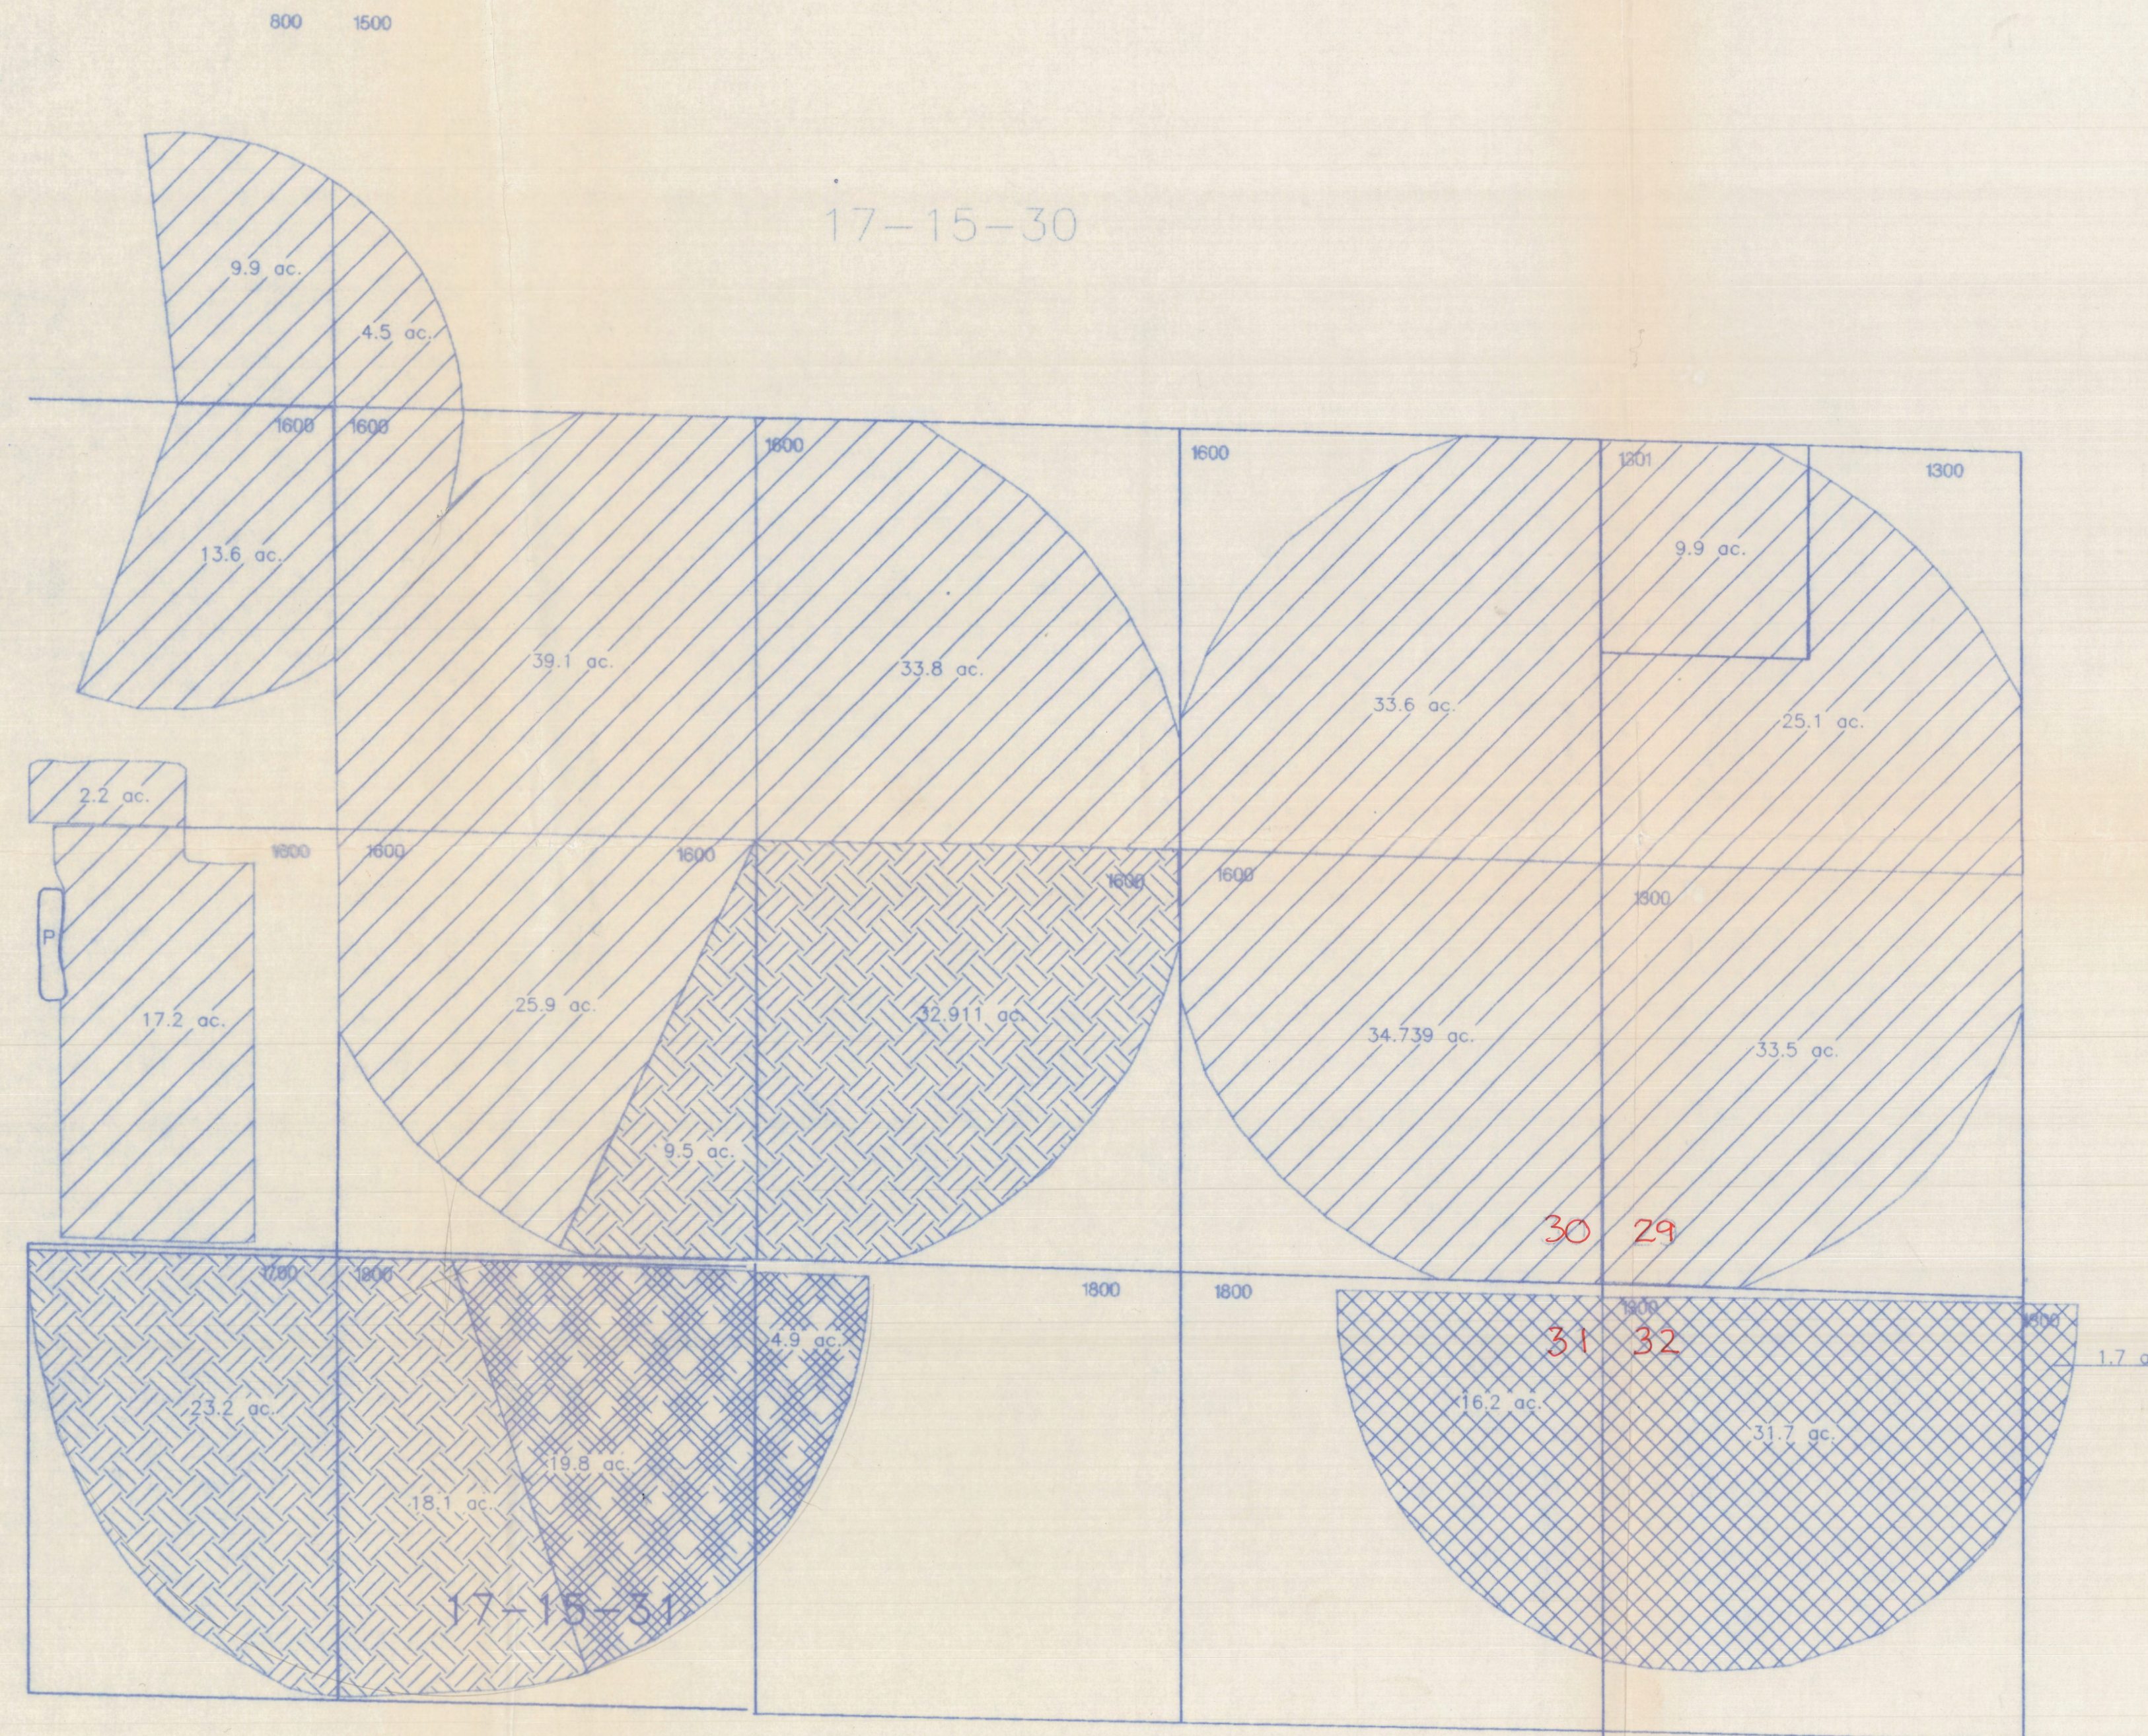

WELL LOCATIONS:
WELL # 1 IS LOCATED 1300 FEET NORTH AND 630 FEET EAST OF THE SW CORNER OF SECTION 30.
WELL # 2 IS LOCATED 2600 FEET NORTH AND 400 FEET EAST OF THE SW CORNER OF SECTION 30.
WELL # 3 IS LOCATED 20 FEET SOUTH AND 30 FEET EAST OF THE SW CORNER OF SECTION 30.
WELL # 4 IS LOCATED 50 FEET NORTH AND 2350 FEET EAST OF THE SW CORNER OF SECTION 30.

Supplemental 1 & 2
JRS WPS

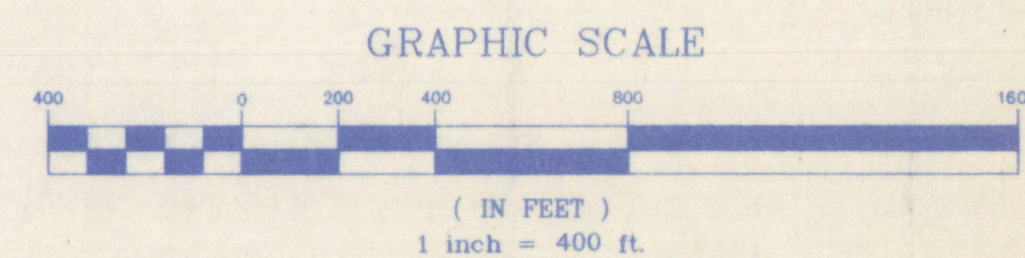

I, William R. Tye, Certified Water Right Examiner in the State of Oregon, hereby certify the above transfer map was prepared under my direct supervision.
The preparation of this map is for the purpose of identifying the location of the water right only and has no intent to provide dimensions or locations of property ownership lines.

STATE OF OREGON
WATER RESOURCES DEPT.
SALEM, OREGON

RECEIVED
MAR 14 2001
WATER RESOURCES DEPT.
SALEM, OREGON

WAYNE SINGHOSE
62500 COUNTY LINE
BEND, OR 97701
WATER RIGHTS TRANSFER
REVISION OF T-7123

SHEET 1 OF 1
DWG NAME: 267-22R

Revised ON T-8724