


S-88388
Central & West Permit Place of Use
Map Frame B

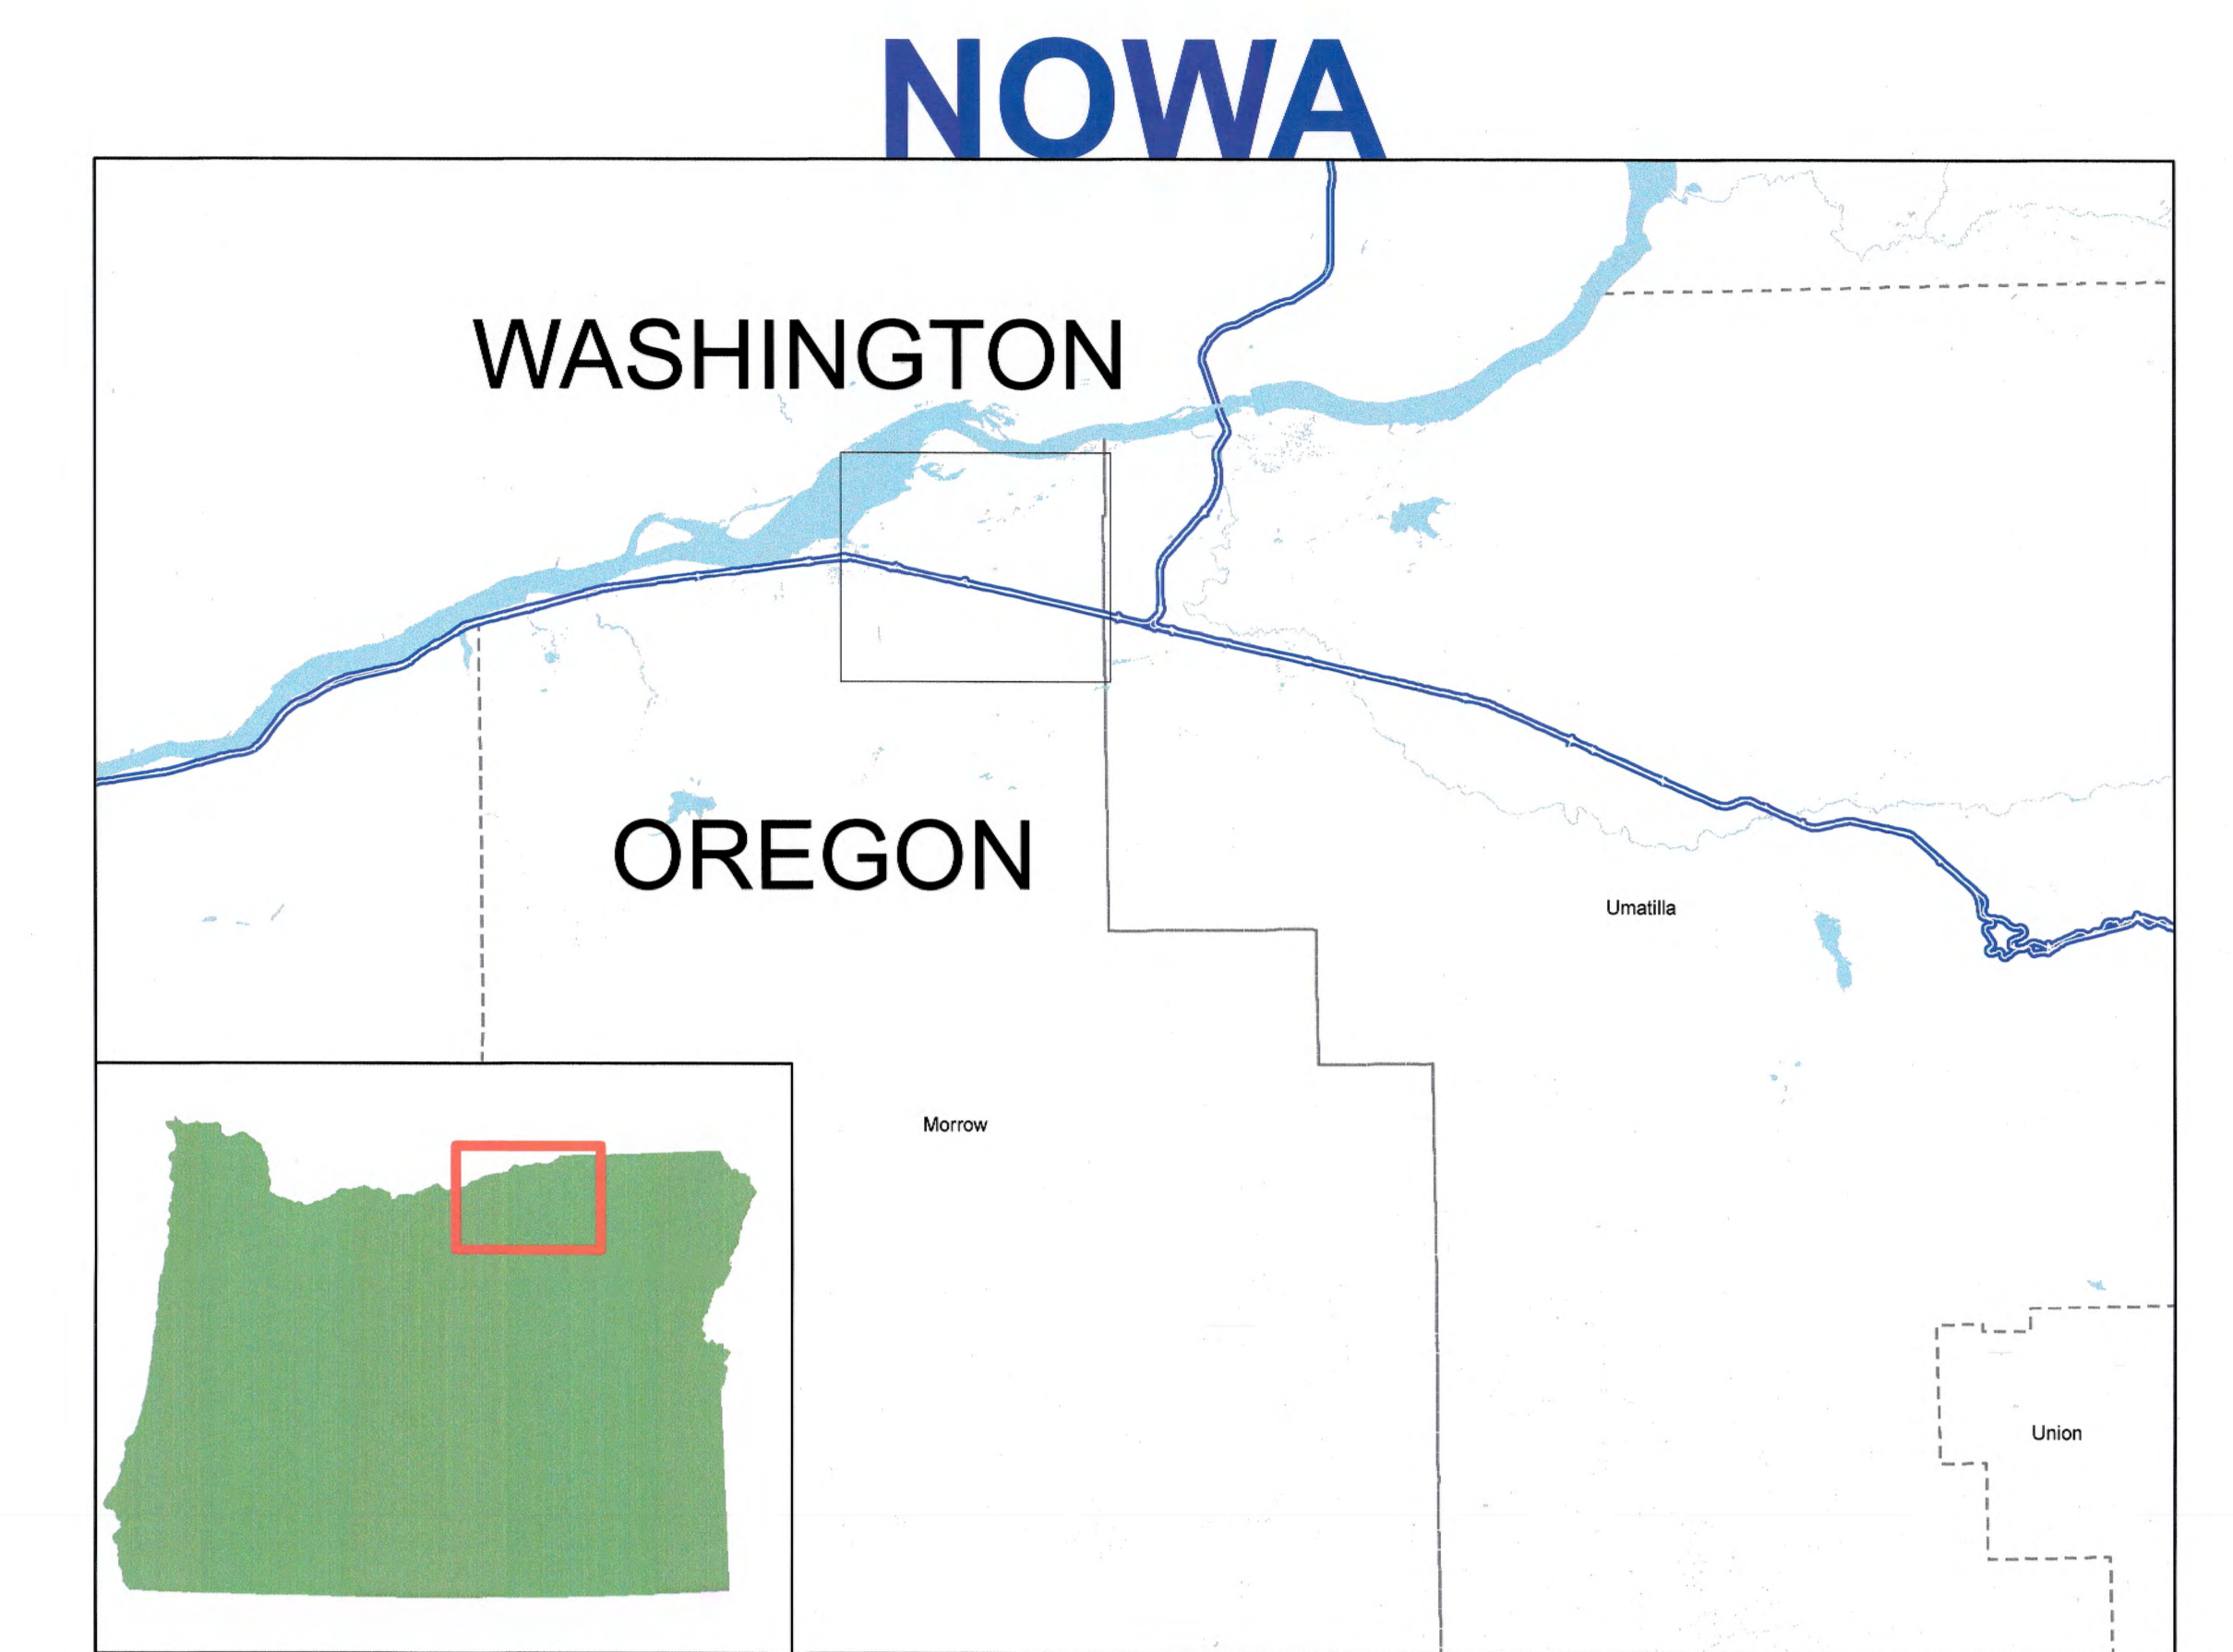


Legend

- Proposed Delivery Point
- Proposed Pump Station
- Proposed Pipeline Route
- Existing Pump Stations
- Existing Delivery Systems
- ▨ Proposed Place of Use S-88288
- ▨ Proposed Place of Use S-88288 Removed Area
- ▨ Proposed Place of Use S-88288 Added Area
- Surface water
- Groundwater
- Storage
- ▨ Surface water, primary
- ▨ Surface water, supplemental
- ▨ Groundwater, primary
- ▨ Groundwater, supplemental
- ▨ Storage, primary
- ▨ Storage, supplemental
- Surface Water
- Groundwater
- Storage

This map was prepared for the purpose of identifying the location of a water right only and it is not intended to provide legal dimension or locations of property ownership lines.

1 inch = 0.25 miles

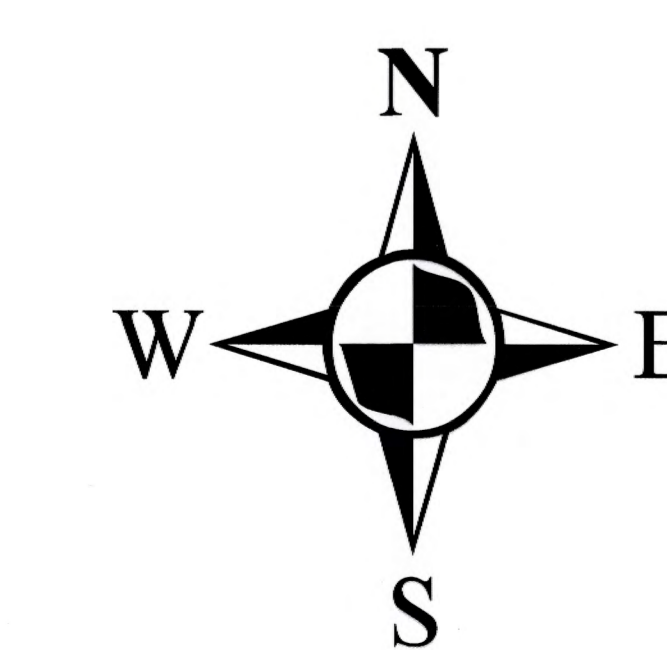

Projection: OR State Plane North
 Datum: NAD 1983
 Date 12/7/2018
 Data Sources:

