


SHOULD BE 4N.


MIKE KELLEY  
GROUND WATER APPLICATION MAP  
SEC 6, T3N, R29E W.M.  
LOT 9 - NW 1/4 SW 1/4

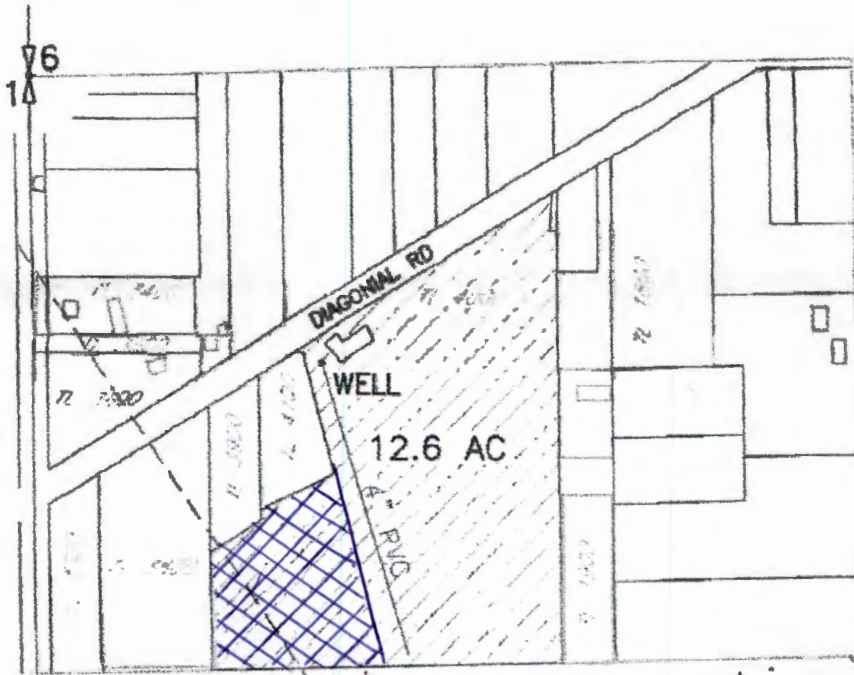

my ownership interest  
Permit G17089

POINT OF APPROPRIATION WELL LOCATED  
650'S AND 640'E FROM THE W 1/4 COR,  
SEC 6

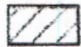

 AREA OF IRRIGATION

ORIGINAL

RECEIVED

NOV 07 2022

OWRD

RECEIVED

JAN 12 2011

WATER RESOURCES DEPT  
SALEM, OREGON

G17448