



August 31, 2022

Ann Reece
District Transfer Advisor
Oregon Water Resources Department
725 Summer St NE Ste A
Salem, OR 97301-1266

RE: FINAL PROOFS – Claim of Beneficial Use for T-13298

Dear Ann,

Central Oregon Irrigation District is submitting our claim of beneficial use for a permanent District transfer ("385").

Enclosed is a list of the authorized lands. Site reports are attached to each map and any specific details about the properties are contained in each site report.

Please Note: The below noted properties have had the following changes:

1. Ownership change for **all** Authorized Place of Use: Ranch at the Canyons Association Inc
2. 14-13-03 SESE 701: Mapping change. Please note, this final proof mapping adjustment is to reflect the actual place of use at the time the final proof site visit was completed. The ownership is Ranch at the Canyons Association Inc.

The District certifies that it has inspected the place of use and confirms the change in place of use has been completed consistent with the terms and conditions of the final order approving the transfer.



Craig Horrel

Date: 8.31.22

Managing Director, Central Oregon Irrigation District



Oregon Water Resources Department
725 Summer Street NE, Suite A
Salem, Oregon 97301-1266
(503) 986-0900
www.wrd.state.or.us

District Permanent Water Right Transfer Claim of Beneficial Use

1. APPLICANT INFORMATION

District: CENTRAL OREGON IRRIGATION DISTRICT

Contact Person: LESLIE CLARK

Phone: 541-548-6047

Mailing Address: 1055 SW LAKE COURT

City: REDMOND

State: OR

Zip: 97756

E-Mail address: lesliec@coid.org

Transfer Number: T - 13298

2. WATER RIGHT(S)

Pursuant to OAR Chapter 690, Division 385, the district is submitting to the Water Resources Department this claim of beneficial use, with the appropriate fee, for the following water right(s):

NOTE: Fees do not apply if the priority date is prior to July 9, 1987.

PERMIT NUMBER	CERTIFICATE NUMBER	DECREE (name, volume, and page)	PRIMARY (P) OR SUPP (S)
-	94956		<input checked="" type="checkbox"/> P <input type="checkbox"/> S
-	76714		<input type="checkbox"/> P <input checked="" type="checkbox"/> S
-			<input type="checkbox"/> P <input type="checkbox"/> S
-			<input type="checkbox"/> P <input type="checkbox"/> S

3. AUTHORIZED POINT(S) OF DIVERSION (POD) / APPROPRIATION (POA)

The authorized point(s) of diversion / appropriation for the water right modified by the transfer are as follows:

PERMIT NUMBER	DECREE or CERTIFICATE	POD / POA #	SOURCE	LOCATION – MEASURED DISTANCES
-	94956	1	Deschutes River	SW ¼ NE ¼ SEC. 13, T. 18 S., R. 11 E., W.M.; 1520' S. & 1535' W. FROM THE NE CORNER OF SEC. 13
-	94956	11	Deschutes River	SE ¼ NE ¼ SEC. 29, T. 17 S., R. 12 E., W.M.; 850' N. AND 630' W. FROM THE E ¼ CORNER OF SEC. 29
-				
-				

6. SIGNATURES

The district certifies that it has inspected the place of use listed in Table I, and confirms the change in place of use has been completed consistent with the terms and conditions of the final order approving the transfer.



Craig Horrell
Managing Director, Central Oregon Irrigation District



Date

T-13298

TRS	QQ	Tax Lot	# Acres	Transferring Owner	Current Owner	Notes
141309	NENE	301	2.55	Canyons Land & Cattle Co.	Ranch at the Canyons Association Inc	Pond Right
141303	SENW	400	0.61	Canyons Land & Cattle Co.	Ranch at the Canyons Association Inc	
141303	SENW	302	0.26	Canyons Land & Cattle Co.	Ranch at the Canyons Association Inc	
141303	SENW	300	0.09	Canyons Land & Cattle Co.	Ranch at the Canyons Association Inc	
141303	NESW	302	0.53	Canyons Land & Cattle Co.	Ranch at the Canyons Association Inc	
141303	NESW	300	0.3	Canyons Land & Cattle Co.	Ranch at the Canyons Association Inc	
141303	NWSW	300	0.81	Canyons Land & Cattle Co.	Ranch at the Canyons Association Inc	
141303	NWSW	302	0.12	Canyons Land & Cattle Co.	Ranch at the Canyons Association Inc	
141303	SWSW	300	0.1	Canyons Land & Cattle Co.	Ranch at the Canyons Association Inc	
141303	SESW	200	1.83	Canyons Land & Cattle Co.	Ranch at the Canyons Association Inc	
141303	SESE	701	0.4	Canyons Land & Cattle Co.	Ranch at the Canyons Association Inc	Remap to 141303NWSE00700 (0.25ac) and 141303SWSE00700 (0.15ac)
141303	SESE	700	0.1	Canyons Land & Cattle Co.	Ranch at the Canyons Association Inc	
141309	NENE	301	0.79	Canyons Land & Cattle Co.	Ranch at the Canyons Association Inc	
141309	SENE	301	0.05	Canyons Land & Cattle Co.	Ranch at the Canyons Association Inc	
141310	NENE	400	0.3	Canyons Land & Cattle Co.	Ranch at the Canyons Association Inc	
141310	NWNE	503	0.3	Canyons Land & Cattle Co.	Ranch at the Canyons Association Inc	
141310	NWNE	506	0.2	Canyons Land & Cattle Co.	Ranch at the Canyons Association Inc	
141310	NWNE	400	0.1	Canyons Land & Cattle Co.	Ranch at the Canyons Association Inc	
141310	SWNE	503	1	Canyons Land & Cattle Co.	Ranch at the Canyons Association Inc	
141310	SENE	100	0.12	Canyons Land & Cattle Co.	Ranch at the Canyons Association Inc	
141310	NENW	506	0.07	Canyons Land & Cattle Co.	Ranch at the Canyons Association Inc	
141310	NWNW	500	0.35	Canyons Land & Cattle Co.	Ranch at the Canyons Association Inc	
141310	NWNW	515	0.24	Canyons Land & Cattle Co.	Ranch at the Canyons Association Inc	
141310	SWNW	505	0.85	Canyons Land & Cattle Co.	Ranch at the Canyons Association Inc	
141310	SENW	504	0.75	Canyons Land & Cattle Co.	Ranch at the Canyons Association Inc	
141310	SENW	505	0.25	Canyons Land & Cattle Co.	Ranch at the Canyons Association Inc	
141310	SENW	510	0.07	Canyons Land & Cattle Co.	Ranch at the Canyons Association Inc	
141310	NWSE	500	0.7	Canyons Land & Cattle Co.	Ranch at the Canyons Association Inc	
141310	NWSE	513	0.19	Canyons Land & Cattle Co.	Ranch at the Canyons Association Inc	
141310	NWSE	600	0.02	Canyons Land & Cattle Co.	Ranch at the Canyons Association Inc	
			11.50			

DESCHUTES COUNTY SEC.09 T14S R13E

E-RECEIVED
08/31/2022
OWRD


SCALE - 1" = 400'



NE 1/4 OF THE NE 1/4

OWRD: T-13298

MAP 2.

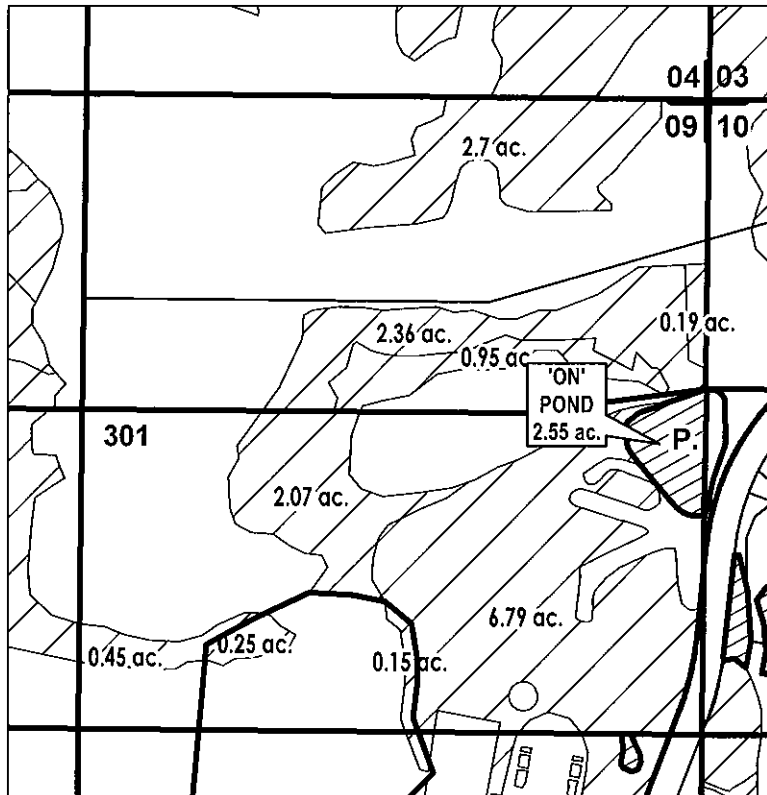

	POND
	EXISTING WATER RIGHTS
	ON LANDS



FINAL PROOF MAP

NAME: Ranch at the Canyons Association Inc

TAXLOT #: 301

2.55 ACRES

DATE: 8/24/2022

PERMANENT TRANSFER – FINAL PROOF

Property Owner: Canyons Land & Cattle Co. Patron #: 1438

Property Address: Canyons Ranch Drive

USE	BEAT	HG	TWP	RNG	SEC	QQ	TAX LOT	ACRES
POND RRIG	PB4	H-12-5	14	13	9	NENE	301	2.55

TYPE OF CROP: N/A

METHOD OF IRRIGATION: N/A

1st Review Date: 6-8-21 Initials: BD Used Acres: 2.55 Dry Acres: 0

Photos taken with Collector: Yes No Collector Polygons: Yes No

Notes: Pond matches GPO polygon. Approved - Full

Post Card Sent: Complete Partial Dry

2nd Review:

Site appointment scheduled w/patron Date: Informed of \$150 if not complete 3rd visit. Initials: Used Acres: Dry Acres:

Notes: _____

3rd Review:

Site appointment scheduled w/patron Date: _____
Initials: _____ Used Acres: _____ Dry Acres: _____

Notes: _____

If not complete invoice \$150 fee: _____

4th Review Date:

Site appointment scheduled w/patron Date: _____
Initials: _____ Used Acres: _____ Dry Acres: _____

Notes: _____

Invoice \$150.00 fee: _____

DESCHUTES COUNTY SEC.03 T14S R13E


E-RECEIVED
08/31/2022
OWRD

SCALE - 1" = 400'



SE 1/4 OF THE NW 1/4

OWRD: T-13298

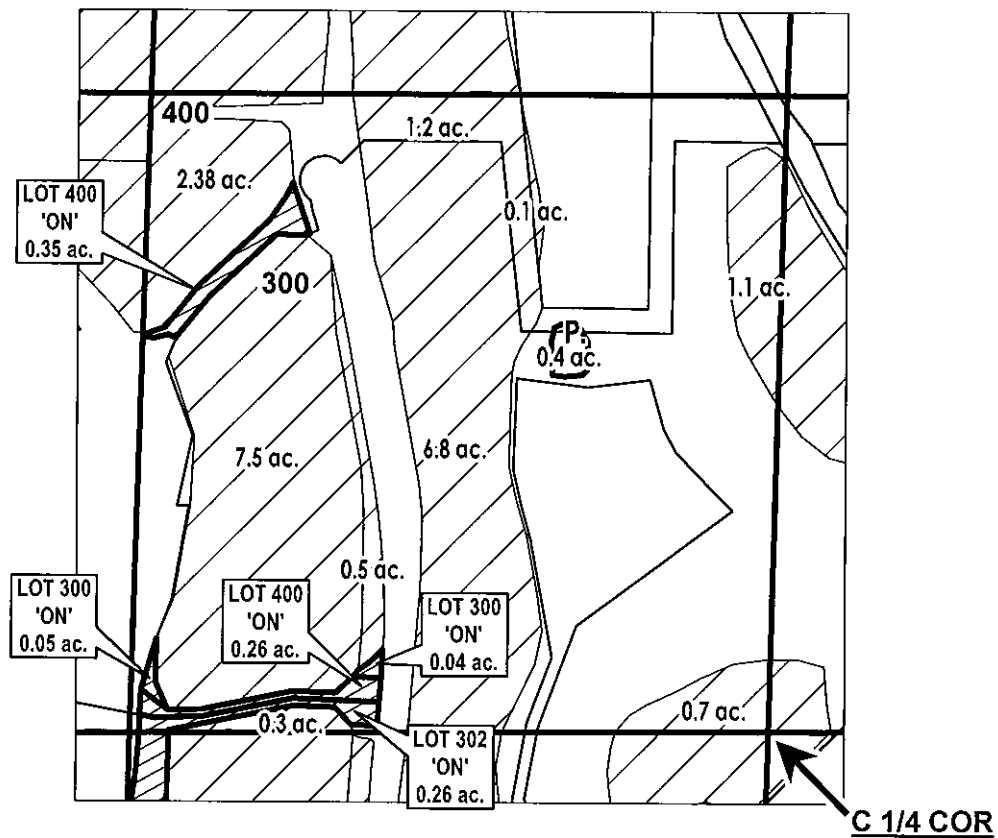

	POND
	EXISTING WATER RIGHTS
	ON LANDS



FINAL PROOF MAP

NAME: Ranch at the Canyons Association Inc

TAXLOT #: 300, 302, 400

0.96 ACRES

DATE: 8/24/2022

PERMANENT TRANSFER – FINAL PROOF

Property Owner: Canyons Land & Cattle Co. Patron #: 1438

Property Address: Canyons Ranch Drive

USE	BEAT	HG	TWP	RNG	SEC	QQ	TAX LOT	ACRES
IRRIG	PB4	H-12-6-2	14	13	3	SENW	400	0.61

TYPE OF CROP: Hay

METHOD OF IRRIGATION: Handline / Wheel-line

1st Review Date: 6-8-21 Initials: BD Used Acres: 0.61 Dry Acres: _____

Photos taken with Collector: Yes No Collector Polygons: Yes No

Notes: Needs slight polygon adjusted. See weed polygon collected, remove section within final proof polygon to OI area to the NW. Achieved full beneficial use
slight polygon adjustment- does not qualify as remap

Post Card Sent: _____ Complete Partial Dry

2nd Review:

Site appointment scheduled w/patron Date: _____ Informed of \$150 if not complete 3rd visit. Initials: _____ Used Acres: _____ Dry Acres: _____

Notes: _____

3rd Review:

Site appointment scheduled w/patron Date: _____
Initials: _____ Used Acres: _____ Dry Acres: _____

Notes: _____

If not complete invoice \$150 fee: _____

4th Review Date:

Site appointment scheduled w/patron Date: _____
Initials: _____ Used Acres: _____ Dry Acres: _____

Notes: _____

Invoice \$150.00 fee: _____

PERMANENT TRANSFER – FINAL PROOF

Property Owner: Canyons Land & Cattle Co. Patron #: 1438
Property Address: Canyons Ranch Drive

USE	BEAT	HG	TWP	RNG	SEC	QQ	TAX LOT	ACRES
IRRIG	PB4	H-12-6-2	14	13	3	SENW	302	0.26

TYPE OF CROP: Hay
METHOD OF IRRIGATION: Wheel-Line

1st Review Date: 6-8-21 Initials: BD Used Acres: 0.26 Dry Acres: _____
Photos taken with Collector: Yes No Collector Polygons: Yes No
Notes: Full beneficial use achieved.

Post Card Sent: _____ Complete Partial Dry

2nd Review:

Site appointment scheduled w/patron Date: _____ Informed of \$150 if not complete 3rd visit.
Initials: _____ Used Acres: _____ Dry Acres: _____
Notes: _____

3rd Review:

Site appointment scheduled w/patron Date: _____
Initials: _____ Used Acres: _____ Dry Acres: _____
Notes: _____

If not complete invoice \$150 fee: _____

4th Review Date:

Site appointment scheduled w/patron Date: _____
Initials: _____ Used Acres: _____ Dry Acres: _____
Notes: _____

Invoice \$150.00 fee: _____

PERMANENT TRANSFER – FINAL PROOF

Property Owner: Canyons Land & Cattle Co. Patron #: 1438

Property Address: Canyons Ranch Drive

USE	BEAT	HG	TWP	RNG	SEC	QQ	TAX LOT	ACRES
IRRIG	PB4	H-12-6-2	14	13	3	SENW	300	0.09

TYPE OF CROP: Hay

METHOD OF IRRIGATION: Wheel-Line

1st Review Date: 6.8.21 Initials: BD Used Acres: .09 Dry Acres: _____

Photos taken with Collector: Yes No Collector Polygons: Yes No

Notes: Full beneficial use achieved.

Post Card Sent: _____ Complete Partial Dry

2nd Review:

Site appointment scheduled w/patron Date: _____ Informed of \$150 if not complete 3rd visit. Initials: _____ Used Acres: _____ Dry Acres: _____

Notes: _____

3rd Review:

Site appointment scheduled w/patron Date: _____

Initials: _____ Used Acres: _____ Dry Acres: _____

Notes: _____

If not complete invoice \$150 fee: _____

4th Review Date:

Site appointment scheduled w/patron Date: _____

Initials: _____ Used Acres: _____ Dry Acres: _____

Notes: _____

Invoice \$150.00 fee: _____

DESCHUTES COUNTY SEC.03 T14S R13E


E-RECEIVED
08/31/2022
OWRD


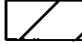

SCALE - 1" = 400'



NE 1/4 OF THE SW 1/4

OWRD: T-13298

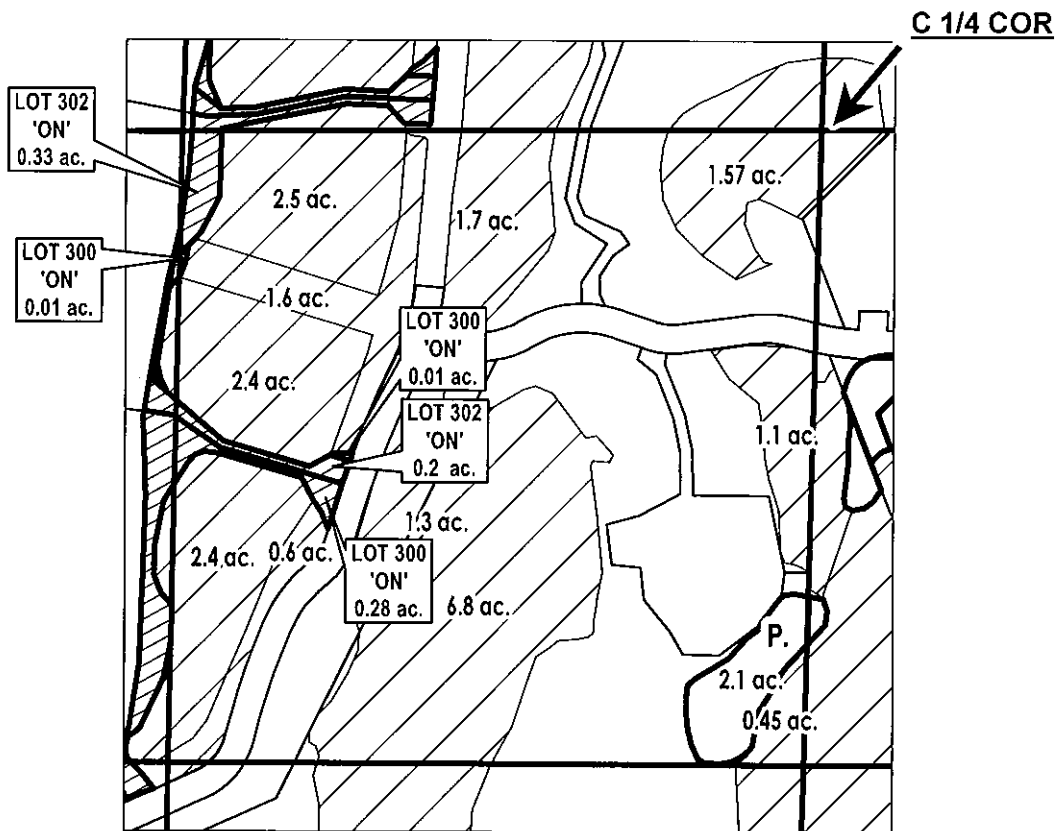

 POND
 EXISTING WATER RIGHTS
 ON LANDS



FINAL PROOF MAP

NAME: Ranch at the Canyons Association Inc

TAXLOT #: 300, 302

0.83 ACRES

DATE: 8/24/2022

PERMANENT TRANSFER – FINAL PROOF

Property Owner: Canyons Land & Cattle Co. Patron #: 1438

Property Address: Canyons Ranch Drive

USE	BEAT	HG	TWP	RNG	SEC	QQ	TAX LOT	ACRES
IRRIG	PB4	H-12-6-2	14	13	3	NESW	302	0.53

TYPE OF CROP: Hay

METHOD OF IRRIGATION: Wheel-Line

1st Review Date: 6-8-21 Initials: BD Used Acres: 0.53 Dry Acres: _____

Photos taken with Collector: Yes No Collector Polygons: Yes No

Notes: Full beneficial use achieved.

Post Card Sent: _____ Complete Partial Dry

2nd Review:

Site appointment scheduled w/patron Date: _____ Informed of \$150 if not complete 3rd visit. Initials: _____ Used Acres: _____ Dry Acres: _____

Notes: _____

3rd Review:

Site appointment scheduled w/patron Date: _____

Initials: _____ Used Acres: _____ Dry Acres: _____

Notes: _____

If not complete invoice \$150 fee: _____

4th Review Date:

Site appointment scheduled w/patron Date: _____

Initials: _____ Used Acres: _____ Dry Acres: _____

Notes: _____

Invoice \$150.00 fee: _____

PERMANENT TRANSFER – FINAL PROOF

Property Owner: Canyons Land & Cattle Co. Patron #: 1438

Property Address: Canyons Ranch Drive

USE	BEAT	HG	TWP	RNG	SEC	QQ	TAX LOT	ACRES
IRRIG	PB4	H-12-6-2	14	13	3	NESW	300	0.30

TYPE OF CROP: Hay

METHOD OF IRRIGATION: Wheel-Line

1st Review Date: 6-8-21 Initials: BD Used Acres: .30 Dry Acres: _____

Photos taken with Collector: Yes No Collector Polygons: Yes No

Notes: Full beneficial use achieved.

Post Card Sent: _____ Complete Partial Dry

2nd Review:

Site appointment scheduled w/patron Date: _____ Informed of \$150 if not complete 3rd visit. Initials: _____ Used Acres: _____ Dry Acres: _____

Notes: _____

3rd Review:

Site appointment scheduled w/patron Date: _____

Initials: _____ Used Acres: _____ Dry Acres: _____

Notes: _____

If not complete invoice \$150 fee: _____

4th Review Date:

Site appointment scheduled w/patron Date: _____

Initials: _____ Used Acres: _____ Dry Acres: _____

Notes: _____

Invoice \$150.00 fee: _____

DESCHUTES COUNTY SEC.03 T14S R13E

E-RECEIVED
08/31/2022
OWRD


SCALE - 1" = 400'





NW 1/4 OF THE SW 1/4

OWRD: T-13298

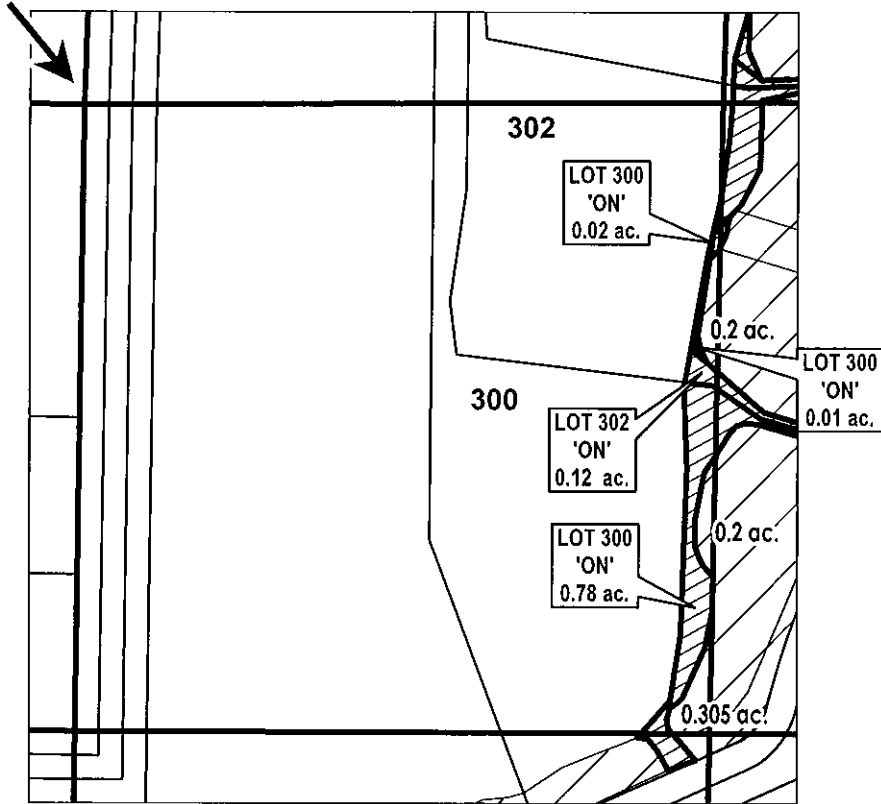W 1/4 COR



 EXISTING WATER RIGHTS
 ON LANDS



FINAL PROOF MAP

NAME: Ranch at the Canyons Association Inc

TAXLOT #: 300, 302

0.93 ACRES

DATE: 8/24/2022

PERMANENT TRANSFER – FINAL PROOF

Property Owner: Canyons Land & Cattle Co. Patron #: 1438
 Property Address: Canyons Ranch Drive

USE	BEAT	HG	TWP	RNG	SEC	QQ	TAX LOT	ACRES
IRRIG	PB4	H-12-6-1	14	13	3	NWSW	300	0.81

TYPE OF CROP: Hay
 METHOD OF IRRIGATION: Wheel-Line

1st Review Date: 6.8.21 Initials: BD Used Acres: _____ Dry Acres: _____

Photos taken with Collector: Yes No Collector Polygons: Yes No

Notes: Need to adjust polygon (see weed polygon in collector).

Post Card Sent: _____ Complete Partial Dry

2nd Review:

Site appointment scheduled w/patron Date: 8-17-21 Informed of \$150 if not complete 3rd visit.
 Initials: AK Used Acres: 0.81 Dry Acres: _____

Notes: Irrigated. Producing orchard grass. Recently mowed. Photos in collector mapped with GPS

3rd Review:

Site appointment scheduled w/patron Date: _____
 Initials: _____ Used Acres: _____ Dry Acres: _____

Notes: _____

If not complete invoice \$150 fee: _____

4th Review Date:

Site appointment scheduled w/patron Date: _____
 Initials: _____ Used Acres: _____ Dry Acres: _____

Notes: _____

Invoice \$150.00 fee: _____

PERMANENT TRANSFER – FINAL PROOF

Property Owner: Canyons Land & Cattle Co. Patron #: 1438
Property Address: Canyons Ranch Drive

USE	BEAT	HG	TWP	RNG	SEC	QQ	TAX LOT	ACRES
IRRIG	PB4	H-12-6-1	14	13	3	NWSW	302	0.12

TYPE OF CROP: Hay
METHOD OF IRRIGATION: wheel-line

1st Review Date: 6-8-21 Initials: BD Used Acres: .12 Dry Acres: _____
Photos taken with Collector: Yes No Collector Polygons: Yes No
Notes: Full beneficial use achieved

Post Card Sent: _____ Complete Partial Dry

2nd Review:

Site appointment scheduled w/patron Date: _____ Informed of \$150 if not complete 3rd visit.
Initials: _____ Used Acres: _____ Dry Acres: _____
Notes: _____

3rd Review:

Site appointment scheduled w/patron Date: _____
Initials: _____ Used Acres: _____ Dry Acres: _____
Notes: _____

If not complete invoice \$150 fee: _____

4th Review Date:

Site appointment scheduled w/patron Date: _____
Initials: _____ Used Acres: _____ Dry Acres: _____
Notes: _____

Invoice \$150.00 fee: _____

DESCHUTES COUNTY SEC.03 T14S R13E


E-RECEIVED
08/31/2022
OWRD

SCALE - 1" = 400'



SW 1/4 OF THE SW 1/4

OWRD: T-13298

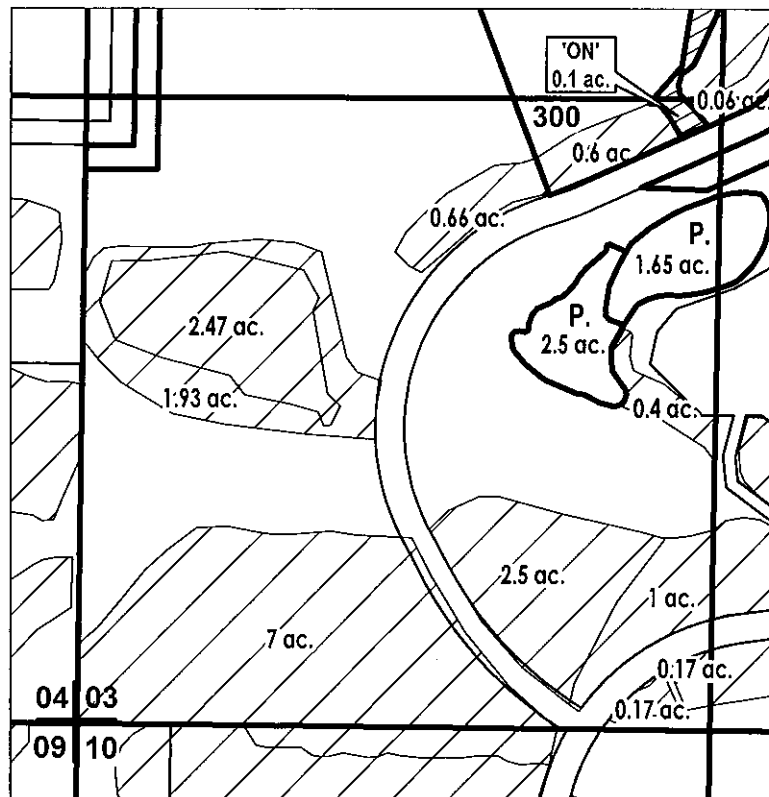

	POND
	EXISTING WATER RIGHTS
	ON LANDS



FINAL PROOF MAP

NAME: Ranch at the Canyons Association Inc

TAXLOT #: 300

0.1 ACRES

DATE: 8/24/2022

PERMANENT TRANSFER – FINAL PROOF

Property Owner: Canyons Land & Cattle Co. Patron #: 1438

Property Address: Canyons Ranch Drive

USE	BEAT	HG	TWP	RNG	SEC	QQ	TAX LOT	ACRES
IRRIG	PB4	H-12-6-1	14	13	3	SWSW	300	0.10

TYPE OF CROP: Hay

METHOD OF IRRIGATION: hand-line

1st Review Date: 6-8-21 Initials: BD Used Acres: _____ Dry Acres: _____

Photos taken with Collector: Yes No Collector Polygons: Yes No

Notes: Slight under irrigated. Rework polygon w/ Dan. Move some WR to OI area (see weed polygon collected in Collector).

Post Card Sent: _____ Complete Partial Dry

2nd Review:

Site appointment scheduled w/patron Date: 8-17-21 Informed of \$150 if not complete 3rd visit. Initials: JD Used Acres: 0.1 Dry Acres: _____

Notes: Irrigated. Recently mowed hay. Photos in collector. Area mapped on GPS

3rd Review:

Site appointment scheduled w/patron Date: _____

Initials: _____ Used Acres: _____ Dry Acres: _____

Notes: _____

If not complete invoice \$150 fee: _____

4th Review Date:

Site appointment scheduled w/patron Date: _____

Initials: _____ Used Acres: _____ Dry Acres: _____

Notes: _____

Invoice \$150.00 fee: _____

DESCHUTES COUNTY SEC.03 T14S R13E


E-RECEIVED
08/31/2022
OWRD

SCALE - 1" = 400'



SE 1/4 OF THE SW 1/4

OWRD: T-13298

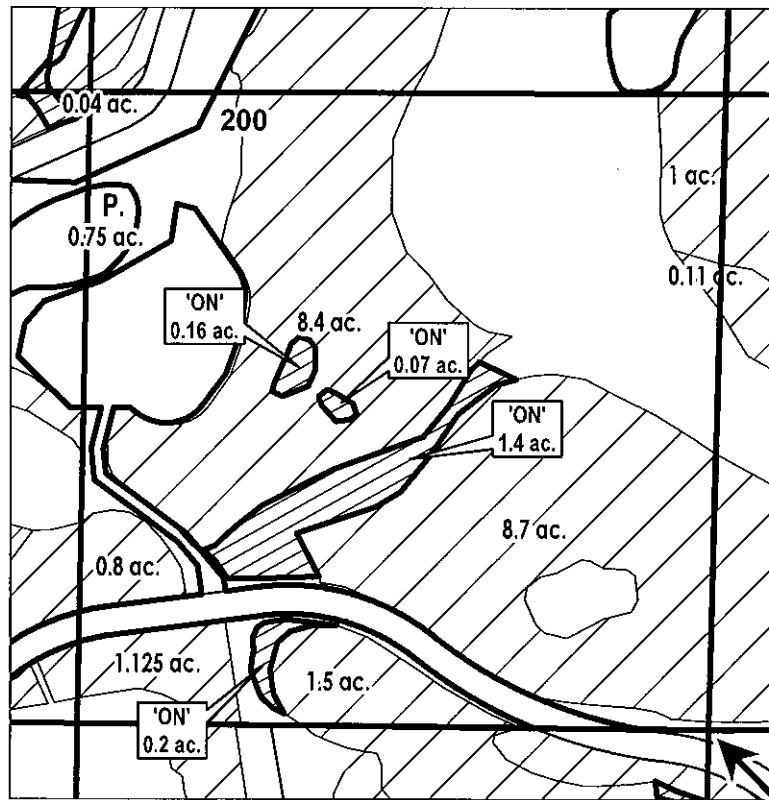

S 1/4 COR

	POND
	EXISTING WATER RIGHTS
	ON LANDS



FINAL PROOF MAP

NAME: Ranch at the Canyons Association Inc
TAXLOT #: 200 1.83 ACRES

DATE: 8/24/2022

PERMANENT TRANSFER – FINAL PROOF

Property Owner: Canyons Land & Cattle Co. Patron #: 1438

Property Address: Canyons Ranch Drive

USE	BEAT	HG	TWP	RNG	SEC	QQ	TAX LOT	ACRES
IRRIG	PB4	H-12-6-1-2	14	13	3	SESW	200	1.83

TYPE OF CROP: Hay / Cow Pasture

METHOD OF IRRIGATION: wheel-line / Hand-line / Flood

1st Review Date: 6-8-21 Initials: BD Used Acres: 1.83 Dry Acres: _____

Photos taken with Collector: Yes No Collector Polygons: Yes No

Notes: Achieved Full Beneficial Use. Well established hay / pasture

Post Card Sent: _____ Complete Partial Dry

2nd Review:

Site appointment scheduled w/patron Date: _____ Informed of \$150 if not complete 3rd visit. Initials: _____ Used Acres: _____ Dry Acres: _____

Notes: _____

3rd Review:

Site appointment scheduled w/patron Date: _____

Initials: _____ Used Acres: _____ Dry Acres: _____

Notes: _____

If not complete invoice \$150 fee: _____

4th Review Date:

Site appointment scheduled w/patron Date: _____

Initials: _____ Used Acres: _____ Dry Acres: _____

Notes: _____

Invoice \$150.00 fee: _____

DESCHUTES COUNTY SEC.03 T14S R13E

E-RECEIVED
08/31/2022
OWRD


SCALE - 1" = 400'


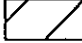



NW 1/4 OF THE SE 1/4; SW 1/4 OF THE SE 1/4

OWRD: T-13298

C 1/4 COR

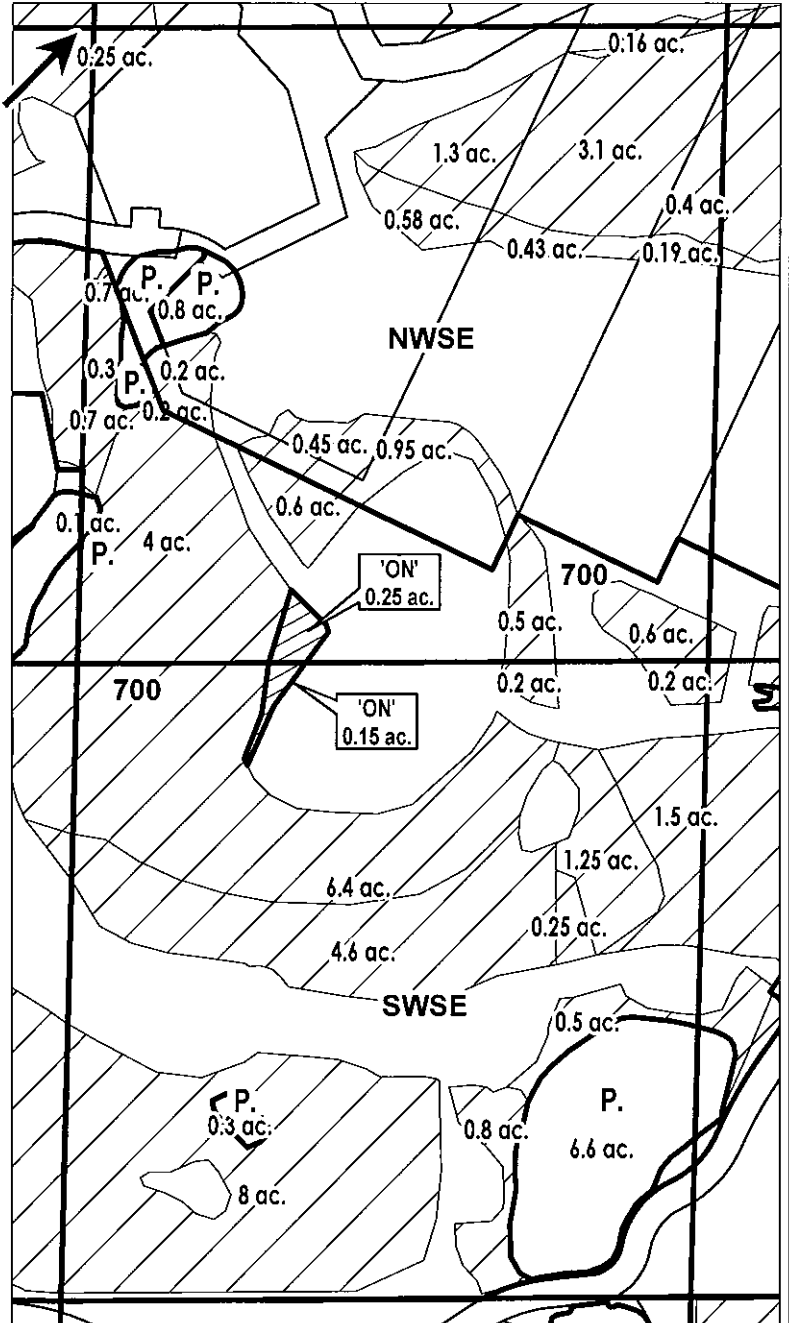

-  POND
-  EXISTING WATER RIGHTS
-  ON LANDS



FINAL PROOF MAP

NAME: Ranch at the Canyons Association Inc

TAXLOT #: 700

0.4 ACRES

FINAL PROOF SITE REPORT

Claim of Beneficial Use

Property Owner (Applicant): Ranch at the Canyons

Petition #: P-2019-004

Current Owner:

OWRD#: T-13298

Property Address: Terrebonne

Notice #:

Remap complete in ARC

POD	USE	HG	TWP	RNG	SEC	QQ	TAX LOT	ACRES
11	IRRIG		14	13	03	NWSE	700	0.25

Person interviewed (if any): Brennan-Irrigator

Method of irrigation (pump, flood, etc): wheel line

Use (crops produced): Hay

Method used to calculate area irrigated: field maps

Is beneficial use achieved: yes

Dated photos of beneficial use: 4/8/22

Are there any mapping changes: Yes (Previous 141303SESE 701)

o Submit map changes to mapping for updates to ARC. Date submitted: 4/8/22

o Update QQ/TL changes in WWIN: needed

Enter use into WWIN: Pending

IF INCOMPLETE:

Failure to Prove up _____ acres of transferred water right

Extension Filed: _____

NOTES:

1st Review:

Established hay crop. Irrigated w/ wheel line. knee high

2nd Review:

3rd Review (if not complete assess \$150 fee)

Final Inspection by: [Signature]

Date: 4/8/22

FINAL PROOF SITE REPORT

Claim of Beneficial Use

Property Owner (Applicant): Ranch at the Canyons

Petition #: P-2019-004

Current Owner:

OWRD#: T-13298

Property Address: Terrebonne

Notice #:

Remap complete in ARC

POD	USE	HG	TWP	RNG	SEC	QQ	TAX LOT	ACRES
11	IRRIG		14	13	03	SWSE	700	0.15

- Person interviewed (if any): Brennan - Irrigator
- Method of irrigation (pump, flood, etc): wheel line
- Use (crops produced): Hay field
- Method used to calculate area irrigated: field maps

- Is beneficial use achieved: yes
- Dated photos of beneficial use: 4/8/22
- Are there any mapping changes: yes (Previous 141303SESE 701)
 - o Submit map changes to mapping for updates to ARC. Date submitted: 4/8/22
 - o Update QQ/TL changes in WWIN: needed
- Enter use into WWIN: Pending

IF INCOMPLETE:

- Failure to Prove up _____ acres of transferred water right
- Extension Filed: _____

NOTES:

1st Review:

Established hay crop. Irrigated w/ wheel line. knee high.

2nd Review:

3rd Review (if not complete assess \$150 fee)

Final Inspection by:

[Signature]

Date:

4/8/22

DESCHUTES COUNTY SEC.03 T14S R13E


E-RECEIVED
08/31/2022
OWRD

SCALE - 1" = 400'



SE 1/4 OF THE SE 1/4

OWRD: T-13298

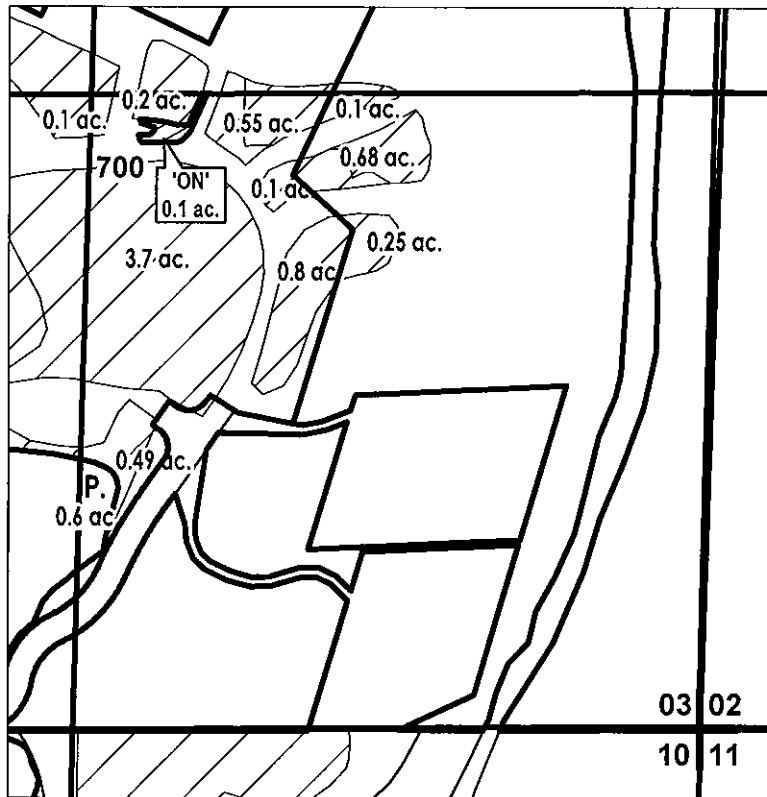

	POND
	EXISTING WATER RIGHTS
	ON LANDS



FINAL PROOF MAP

NAME: Ranch at the Canyons Association Inc

TAXLOT #: 700

0.1 ACRES

DATE: 8/24/2022

FINAL PROOF SITE REPORT

Claim of Beneficial Use

Property Owner (Applicant): Ranch at the Canyons

Petition #: P-2019-004

Current Owner:

OWRD#: T-13298

Property Address: Terrebonne

Notice #:

POD	USE	HG	TWP	RNG	SEC	QQ	TAX LOT	ACRES
11	IRRIG		14	13	03	SESE	700	0.1

- Person interviewed (if any): Brennan - Irrigator
- Method of irrigation (pump, flood, etc): Hand line
- Use (crops produced): Grass seed blend
- Method used to calculate area irrigated: Field maps
- Is beneficial use achieved: Yes

Dated photos of beneficial use: 4/8/22

- Are there any mapping changes: Slight polygon adjustment to otherside
 - o Submit map changes to mapping for updates to ARC. Date submitted: of 9/2/22
 - o Update QQ/TL changes in WWIN: N/A Done

Enter use into WWIN: WWIN needs updated no change in
at at

IF INCOMPLETE:

- Failure to Prove up _____ acres of transferred water right
- Extension Filed: _____

NOTES:

1st Review:

Full use. Hand line out and area is being irrigated. 4" growth that has been greened up

2nd Review:

3rd Review (if not complete assess \$150 fee)

Final Inspection by: [Signature]

Date: 4/8/22 12

DESCHUTES COUNTY SEC.09 T14S R13E

E-RECEIVED
08/31/2022
OWRD


SCALE - 1" = 400'



NE 1/4 OF THE NE 1/4

OWRD: T-13298

MAP 1.

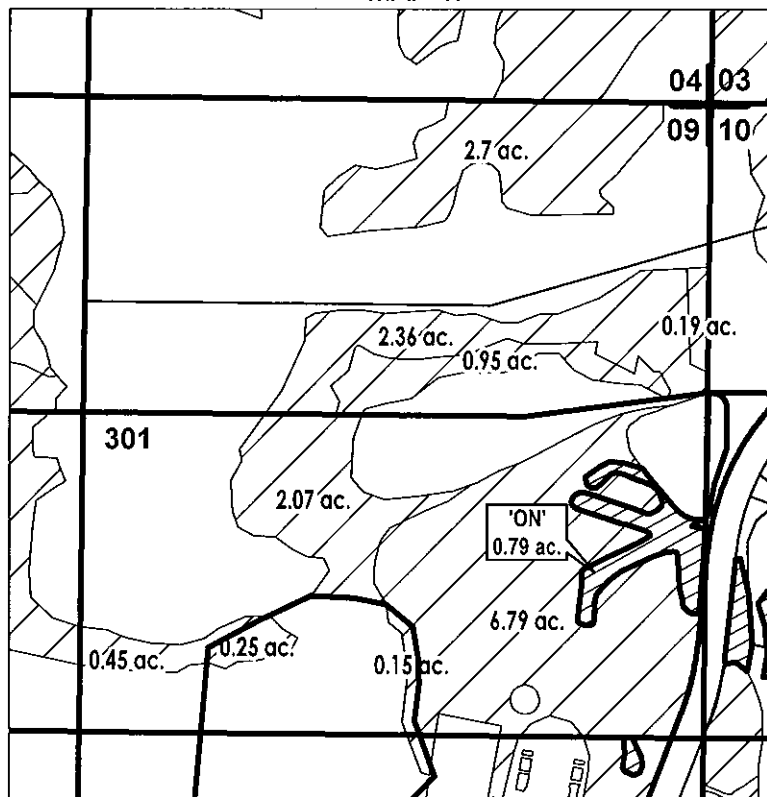

	POND
	EXISTING WATER RIGHTS
	ON LANDS



FINAL PROOF MAP

NAME: Ranch at the Canyons Association Inc

TAXLOT #: 301

0.79 ACRES

DATE: 8/24/2022

PERMANENT TRANSFER – FINAL PROOF

Property Owner: Canyons Land & Cattle Co. Patron #: 1438

Property Address: Canyons Ranch Drive

USE	BEAT	HG	TWP	RNG	SEC	QQ	TAX LOT	ACRES
IRRIG	PB4	H-12-5	14	13	9	NENE	301	0.79

TYPE OF CROP: Horse Pasture

METHOD OF IRRIGATION: Pump / Handline

1st Review Date: 6/8/21 Initials: BD Used Acres: 0.79 Dry Acres: _____

Photos taken with Collector: Yes No Collector Polygons: Yes No

Notes: Achieved full beneficial use. 2 photos taken

Post Card Sent: _____ Complete Partial Dry

2nd Review:

Site appointment scheduled w/patron Date: _____ Informed of \$150 if not complete 3rd visit. Initials: _____ Used Acres: _____ Dry Acres: _____

Notes: _____

3rd Review:

Site appointment scheduled w/patron Date: _____

Initials: _____ Used Acres: _____ Dry Acres: _____

Notes: _____

If not complete invoice \$150 fee: _____

4th Review Date:

Site appointment scheduled w/patron Date: _____

Initials: _____ Used Acres: _____ Dry Acres: _____

Notes: _____

Invoice \$150.00 fee: _____

DESCHUTES COUNTY SEC.09 T14S R13E


E-RECEIVED
08/31/2022
OWRD

SCALE - 1" = 400'



SE 1/4 OF THE NE 1/4

OWRD: T-13298

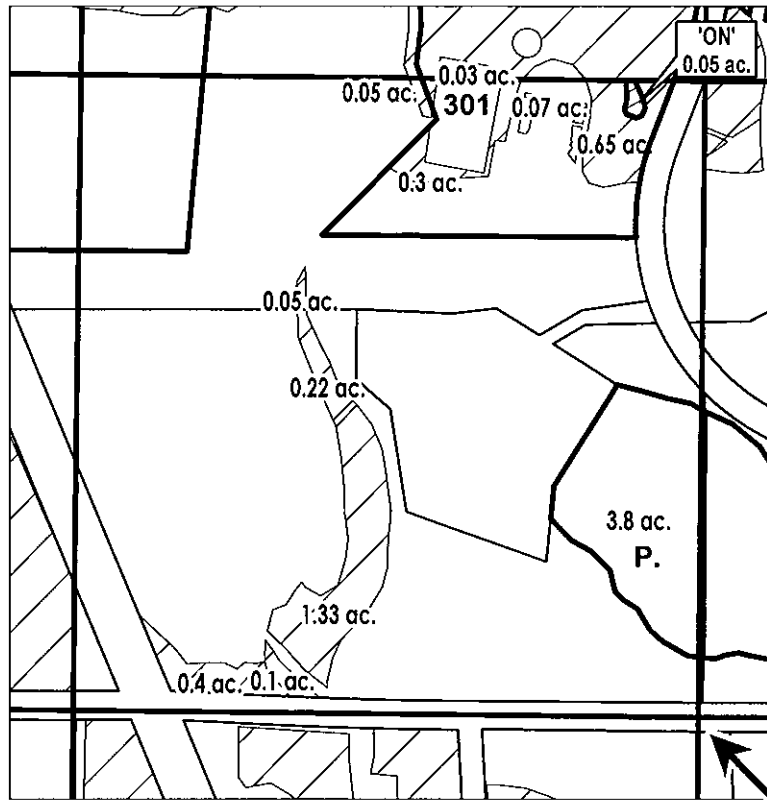

E 1/4 COR

	POND
	EXISTING WATER RIGHTS
	ON LANDS



FINAL PROOF MAP

NAME: Ranch at the Canyons Association Inc

TAXLOT #: 301

0.05 ACRES

DATE: 8/31/2022

PERMANENT TRANSFER – FINAL PROOF

Property Owner: Canyons Land & Cattle Co. Patron #: 1438

Property Address: Canyons Ranch Drive

USE	BEAT	HG	TWP	RNG	SEC	QQ	TAX LOT	ACRES
IRRIG	PB4	H-12-5	14	13	9	SENE	301	0.05

TYPE OF CROP: Horse Pasture

METHOD OF IRRIGATION: Pump

1st Review Date: 6/8/21 Initials: SD Used Acres: .05 Dry Acres: _____

Photos taken with Collector: Yes No Collector Polygons: Yes No

Notes: Achieved full beneficial use. See photo in collector

Post Card Sent: _____ Complete Partial Dry

2nd Review:

Site appointment scheduled w/patron Date: _____ Informed of \$150 if not complete 3rd visit. Initials: _____ Used Acres: _____ Dry Acres: _____

Notes: _____

3rd Review:

Site appointment scheduled w/patron Date: _____

Initials: _____ Used Acres: _____ Dry Acres: _____

Notes: _____

If not complete invoice \$150 fee: _____

4th Review Date:

Site appointment scheduled w/patron Date: _____

Initials: _____ Used Acres: _____ Dry Acres: _____

Notes: _____

Invoice \$150.00 fee: _____

DESCHUTES COUNTY SEC.10 T14S R13E


E-RECEIVED
08/31/2022
OWRD



SCALE - 1" = 400'



NE 1/4 OF THE NE 1/4

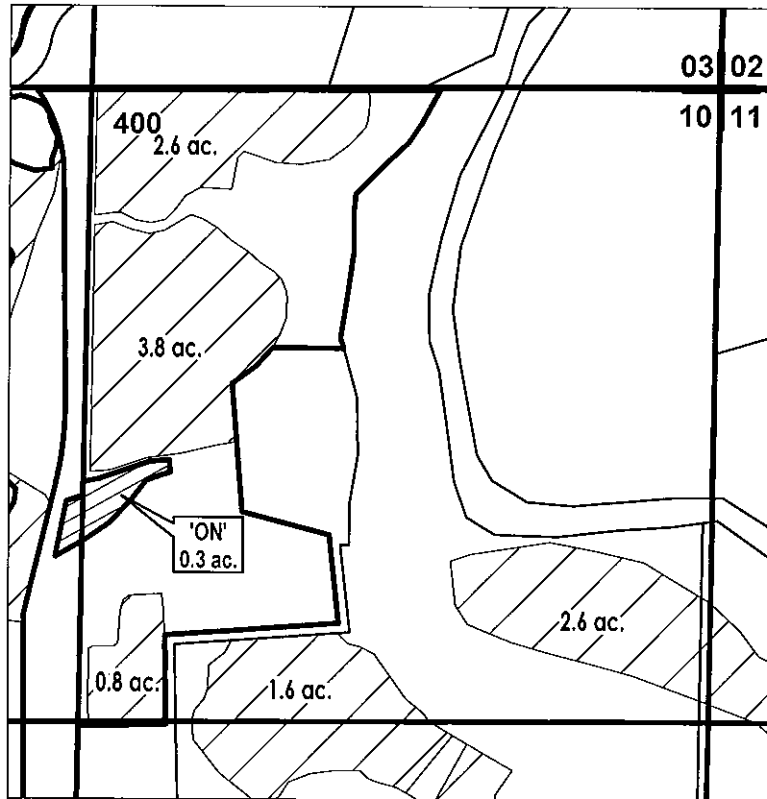OWRD: T-13298



	EXISTING WATER RIGHTS
	ON LANDS



FINAL PROOF MAP

NAME: Ranch at the Canyons Association Inc

TAXLOT #: 400

0.3 ACRES

DATE: 8/24/2022

PERMANENT TRANSFER – FINAL PROOF

Property Owner: Canyons Land & Cattle Co. Patron #: 1438

Property Address: Canyons Ranch Drive

USE	BEAT	HG	TWP	RNG	SEC	QQ	TAX LOT	ACRES
IRRIG	PB4	H-12-3-2	14	13	10	NENE	400	0.30

TYPE OF CROP: _____

METHOD OF IRRIGATION: Handline

1st Review Date: 6-8-21 Initials: BD Used Acres: _____ Dry Acres: 0.30

Photos taken with Collector: Yes No Collector Polygons: Yes No

Notes: Need to mow down weeds, add a 2nd handline, & possibly replant. Flags placed @ edge of WR. Need to contact irrigator

Post Card Sent: _____ Complete Partial Dry

2nd Review:

Site appointment scheduled w/patron Date: 8-17-21 Informed of \$150 if not complete 3rd visit. Initials: RL Used Acres: 0.3 Dry Acres: _____

Notes: Irrigated, producing pasture mix. Weeds removed. Photos in collector

3rd Review:

Site appointment scheduled w/patron Date: _____

Initials: _____ Used Acres: _____ Dry Acres: _____

Notes: _____

If not complete invoice \$150 fee: _____

4th Review Date:

Site appointment scheduled w/patron Date: _____

Initials: _____ Used Acres: _____ Dry Acres: _____

Notes: _____

Invoice \$150.00 fee: _____

DESCHUTES COUNTY SEC.10 T14S R13E


E-RECEIVED
08/31/2022
OWRD

SCALE - 1" = 400'



NW 1/4 OF THE NE 1/4

OWRD: T-13298

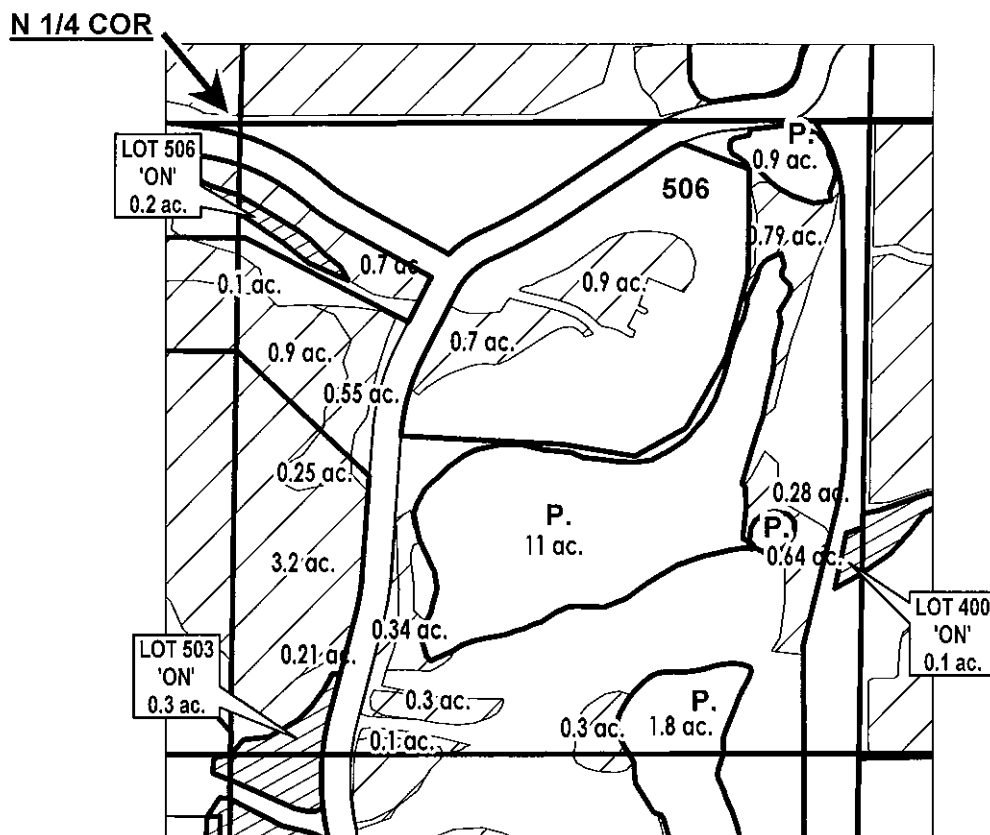

	POND
	EXISTING WATER RIGHTS
	ON LANDS



FINAL PROOF MAP

NAME: Ranch at the Canyons Association Inc

TAXLOT #: 400, 503, 506

0.6 ACRES

DATE: 8/24/2022

PERMANENT TRANSFER – FINAL PROOF

Property Owner: Canyons Land & Cattle Co. Patron #: 1438

Property Address: Canyons Ranch Drive

USE	BEAT	HG	TWP	RNG	SEC	QQ	TAX LOT	ACRES
IRRIG	PB4	H-12-3-3	14	13	10	NWNE	503	0.30

TYPE OF CROP: Alfalfa / Bunchgrass
METHOD OF IRRIGATION: Handline

1st Review Date: 6.8.21 Initials: BD Used Acres: 0.30 Dry Acres: _____

Photos taken with Collector: Yes No Collector Polygons: Yes No

Notes: Full beneficial use achieved.

Post Card Sent: _____ Complete Partial Dry

2nd Review:

Site appointment scheduled w/patron Date: _____ Informed of \$150 if not complete 3rd visit.
Initials: _____ Used Acres: _____ Dry Acres: _____

Notes: _____

3rd Review:

Site appointment scheduled w/patron Date: _____
Initials: _____ Used Acres: _____ Dry Acres: _____

Notes: _____

If not complete invoice \$150 fee: _____

4th Review Date:

Site appointment scheduled w/patron Date: _____
Initials: _____ Used Acres: _____ Dry Acres: _____

Notes: _____

Invoice \$150.00 fee: _____

PERMANENT TRANSFER – FINAL PROOF

Property Owner: Canyons Land & Cattle Co. Patron #: 1438

Property Address: Canyons Ranch Drive

USE	BEAT	HG	TWP	RNG	SEC	QQ	TAX LOT	ACRES
IRRIG	PB4	H-12-3-3	14	13	10	NWNE	506	0.20

TYPE OF CROP: Hay

METHOD OF IRRIGATION: Hand-Line

1st Review Date: 6-8-21 Initials: BD Used Acres: 0.20 Dry Acres: _____

Photos taken with Collector: Yes No Collector Polygons: Yes No

Notes: Established hay field. Full beneficial use achieved.

Post Card Sent: _____ Complete Partial Dry

2nd Review:

Site appointment scheduled w/patron Date: _____ Informed of \$150 if not complete 3rd visit. Initials: _____ Used Acres: _____ Dry Acres: _____

Notes: _____

3rd Review:

Site appointment scheduled w/patron Date: _____

Initials: _____ Used Acres: _____ Dry Acres: _____

Notes: _____

If not complete invoice \$150 fee: _____

4th Review Date:

Site appointment scheduled w/patron Date: _____

Initials: _____ Used Acres: _____ Dry Acres: _____

Notes: _____

Invoice \$150.00 fee: _____

PERMANENT TRANSFER – FINAL PROOF

Property Owner: Canyons Land & Cattle Co. Patron #: 1438

Property Address: Canyons Ranch Drive

USE	BEAT	HG	TWP	RNG	SEC	QQ	TAX LOT	ACRES
IRRIG	PB4	H-12-3-2	14	13	10	NWNE	400	0.10

TYPE OF CROP: _____

METHOD OF IRRIGATION: Handline

1st Review Date: 6-8-21 Initials: BD Used Acres: _____ Dry Acres: 0.10

Photos taken with Collector: Yes No Collector Polygons: Yes No

Notes: Need to mow down weeds, add 2nd handline, & possibly replant, Flags placed @ edge of WR. Need to contact irrigator.

Post Card Sent: _____ Complete Partial Dry

2nd Review:

Site appointment scheduled w/patron Date: 8-17-21 Informed of \$150 if not complete 3rd visit. Initials: JK Used Acres: 0.1 Dry Acres: _____

Notes: Irrigated. Growing pasture grass. Photos in collector.

3rd Review:

Site appointment scheduled w/patron Date: _____

Initials: _____ Used Acres: _____ Dry Acres: _____

Notes: _____

If not complete invoice \$150 fee: _____

4th Review Date:

Site appointment scheduled w/patron Date: _____

Initials: _____ Used Acres: _____ Dry Acres: _____

Notes: _____

Invoice \$150.00 fee: _____

DESCHUTES COUNTY SEC.10 T14S R13E


E-RECEIVED
08/31/2022
OWRD

SCALE - 1" = 400'



SW 1/4 OF THE NE 1/4

OWRD: T-13298

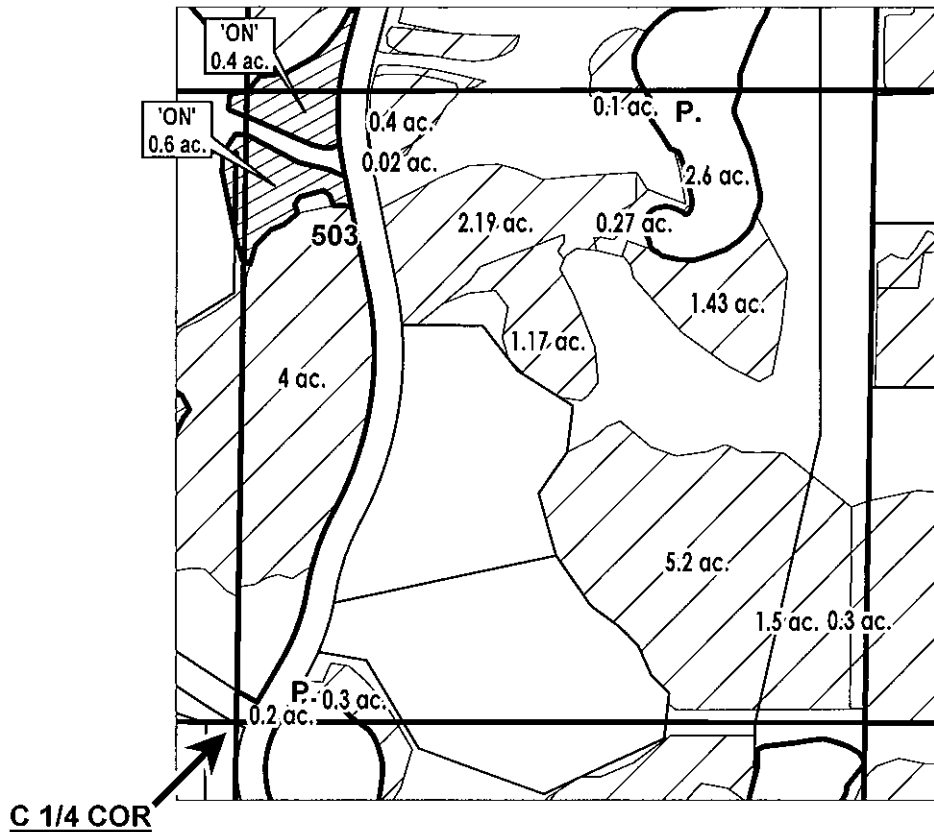

	POND
	EXISTING WATER RIGHTS
	ON LANDS



FINAL PROOF MAP

NAME: Ranch at the Canyons Association Inc

TAXLOT #: 503

1.0 ACRES

DATE: 8/24/2022

PERMANENT TRANSFER – FINAL PROOF

Property Owner: Canyons Land & Cattle Co. Patron #: 1438

Property Address: Canyons Ranch Drive

USE	BEAT	HG	TWP	RNG	SEC	QQ	TAX LOT	ACRES
IRRIG	PB4	H-12-3-2	14	13	10	SWNE	503	1.00

TYPE OF CROP: Alfalfa / Bunchgrass
METHOD OF IRRIGATION: handline

1st Review Date: 6-8-21 Initials: BD Used Acres: .4 Dry Acres: .6

Photos taken with Collector: Yes No Collector Polygons: Yes No

Notes: Need to irrigate south of driveway. Need to contact patron / irrigator.

Post Card Sent: Complete Partial Dry

2nd Review:

Site appointment scheduled w/patron Date: 8-17-21 Informed of \$150 if not complete 3rd visit. Initials: JA Used Acres: 1.00 Dry Acres: _____

Notes: Irrigated and producing bunchgrass. Photos in Collector

3rd Review:

Site appointment scheduled w/patron Date: _____

Initials: _____ Used Acres: _____ Dry Acres: _____

Notes: _____

If not complete invoice \$150 fee: _____

4th Review Date:

Site appointment scheduled w/patron Date: _____

Initials: _____ Used Acres: _____ Dry Acres: _____

Notes: _____

Invoice \$150.00 fee: _____

DESCHUTES COUNTY SEC.10 T14S R13E


E-RECEIVED
08/31/2022
OWRD




SCALE - 1" = 400'



SE 1/4 OF THE NE 1/4

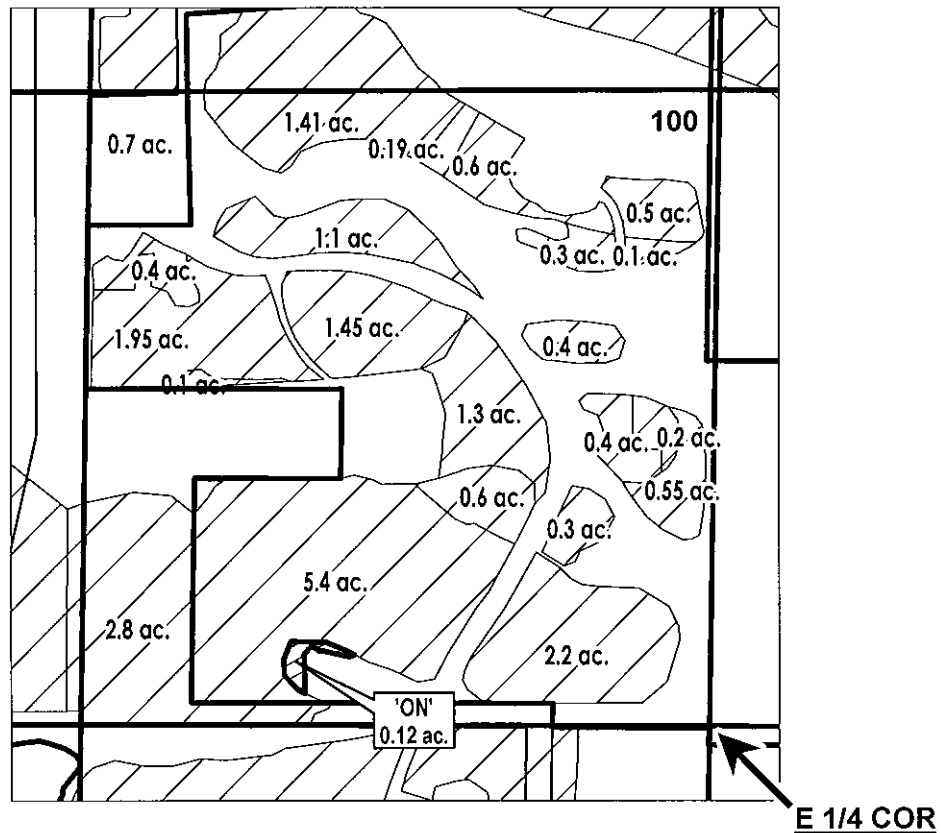OWRD: T-13298

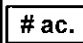

-  EXISTING WATER RIGHTS
-  ON LANDS
-  PARCELS W/ WATER RIGHTS



FINAL PROOF MAP

NAME: Ranch at the Canyons Association Inc

TAXLOT #: 100

0.12 ACRES

DATE: 8/24/2022

PERMANENT TRANSFER – FINAL PROOF

Property Owner: Canyons Land & Cattle Co. Patron #: 1438

Property Address: Canyons Ranch Drive

USE	BEAT	HG	TWP	RNG	SEC	QQ	TAX LOT	ACRES
IRRIG	PB4	H-12-3-2	14	13	10	SENE	100	0.12

TYPE OF CROP: Hay

METHOD OF IRRIGATION: Hand-Line

1st Review Date: 6.8.21 Initials: BD Used Acres: 0.12 Dry Acres: _____

Photos taken with Collector: Yes No Collector Polygons: Yes No

Notes: Achieved full beneficial use (see collector pic). Some weeds present, but mainly hay. Should look better after 1st cutting.

Post Card Sent: _____ Complete Partial Dry

2nd Review:

Site appointment scheduled w/patron Date: _____ Informed of \$150 if not complete 3rd visit. Initials: _____ Used Acres: _____ Dry Acres: _____

Notes: _____

3rd Review:

Site appointment scheduled w/patron Date: _____

Initials: _____ Used Acres: _____ Dry Acres: _____

Notes: _____

If not complete invoice \$150 fee: _____

4th Review Date:

Site appointment scheduled w/patron Date: _____

Initials: _____ Used Acres: _____ Dry Acres: _____

Notes: _____

Invoice \$150.00 fee: _____

DESCHUTES COUNTY SEC.10 T14S R13E


E-RECEIVED
08/31/2022
OWRD

SCALE - 1" = 400'



NE 1/4 OF THE NW 1/4

OWRD: T-13298

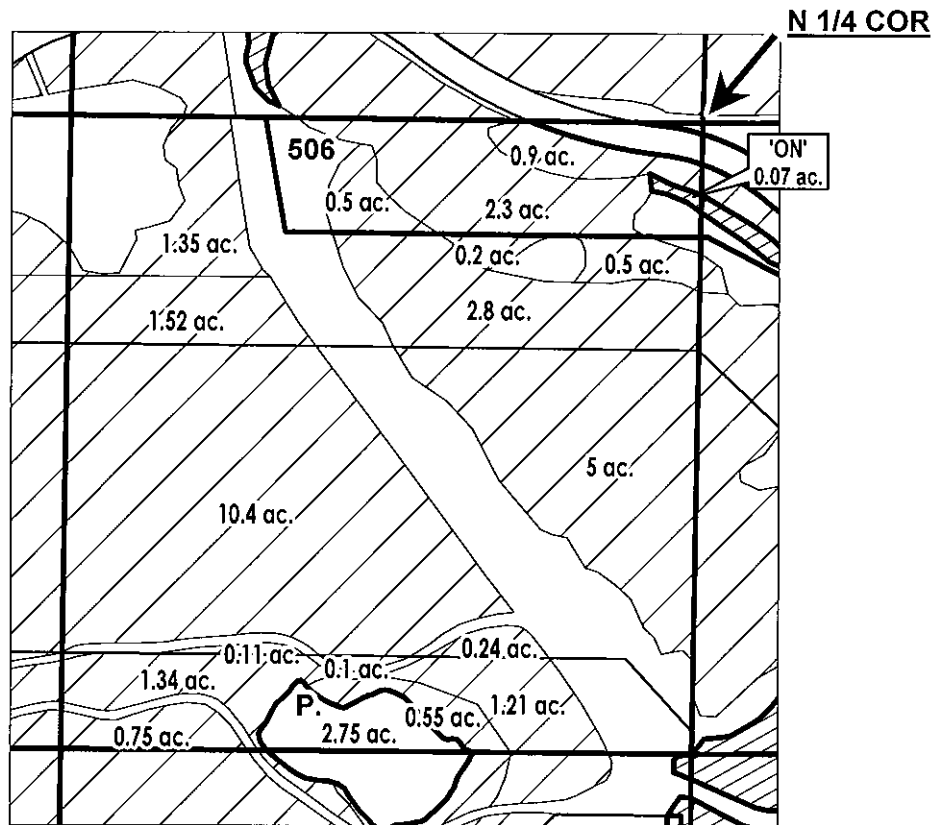

	POND
	EXISTING WATER RIGHTS
	ON LANDS



FINAL PROOF MAP

NAME: Ranch at the Canyons Association Inc

TAXLOT #: 506

0.07 ACRES

DATE: 8/24/2022

PERMANENT TRANSFER – FINAL PROOF

Property Owner: Canyons Land & Cattle Co. Patron #: 1438

Property Address: Canyons Ranch Drive

USE	BEAT	HG	TWP	RNG	SEC	QQ	TAX LOT	ACRES
IRRIG	PB4	H-12-3-3	14	13	10	NENW	506	0.07

TYPE OF CROP: Hay

METHOD OF IRRIGATION: Hand-Line

1st Review Date: 6-8-21 Initials: BD Used Acres: 0.07 Dry Acres: _____

Photos taken with Collector: Yes No Collector Polygons: Yes No

Notes: Established hay field. Full beneficial use achieved.

Post Card Sent: _____ Complete Partial Dry

2nd Review:

Site appointment scheduled w/patron Date: _____ Informed of \$150 if not complete 3rd visit. Initials: _____ Used Acres: _____ Dry Acres: _____

Notes: _____

3rd Review:

Site appointment scheduled w/patron Date: _____

Initials: _____ Used Acres: _____ Dry Acres: _____

Notes: _____

If not complete invoice \$150 fee: _____

4th Review Date:

Site appointment scheduled w/patron Date: _____

Initials: _____ Used Acres: _____ Dry Acres: _____

Notes: _____

Invoice \$150.00 fee: _____

DESCHUTES COUNTY SEC.10 T14S R13E


E-RECEIVED
08/31/2022
OWRD

SCALE - 1" = 400'



NW 1/4 OF THE NW 1/4

OWRD: T-13298

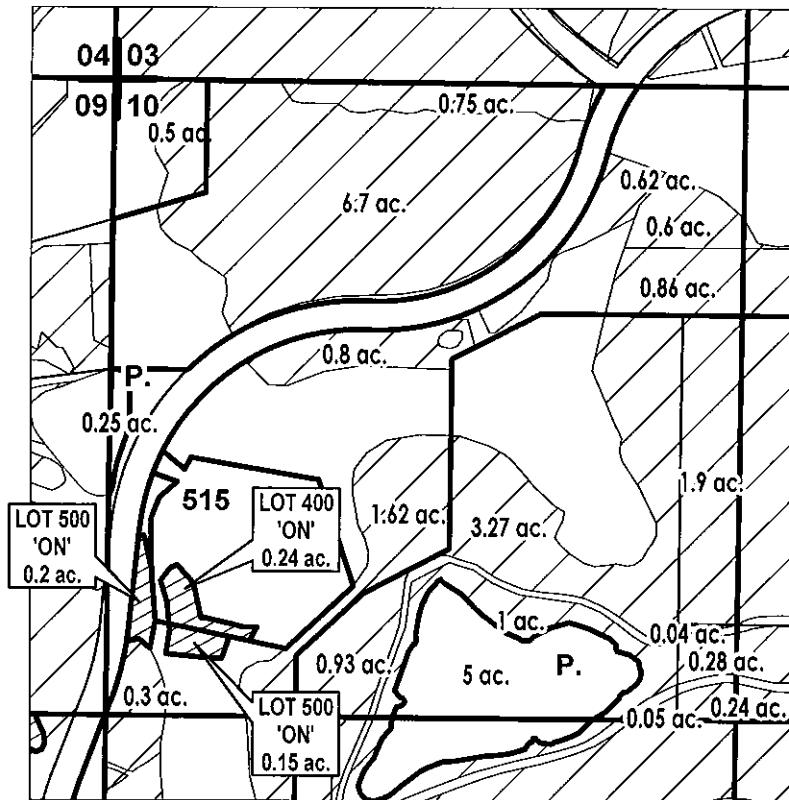

	POND
	EXISTING WATER RIGHTS
	ON LANDS



FINAL PROOF MAP

NAME: Ranch at the Canyons Association Inc

TAXLOT #: 500, 515

0.59 ACRES

DATE: 8/31/2022

PERMANENT TRANSFER – FINAL PROOF

Property Owner: Canyons Land & Cattle Co. Patron #: 1438

Property Address: Canyons Ranch Drive

USE	BEAT	HG	TWP	RNG	SEC	QQ	TAX LOT	ACRES
IRRIG	PB4	H-12-6-1-2	14	13	10	NWNW	500	0.35

TYPE OF CROP: Landscape / Grass

METHOD OF IRRIGATION: Pump / Handline

1st Review Date: 6-8-21 Initials: BD Used Acres: 0.35 Dry Acres: _____

Photos taken with Collector: Yes No Collector Polygons: Yes No

Notes: Achieved full beneficial use.

Post Card Sent: _____ Complete Partial Dry

2nd Review:

Site appointment scheduled w/patron Date: _____ Informed of \$150 if not complete 3rd visit. Initials: _____ Used Acres: _____ Dry Acres: _____

Notes: _____

3rd Review:

Site appointment scheduled w/patron Date: _____

Initials: _____ Used Acres: _____ Dry Acres: _____

Notes: _____

If not complete invoice \$150 fee: _____

4th Review Date:

Site appointment scheduled w/patron Date: _____

Initials: _____ Used Acres: _____ Dry Acres: _____

Notes: _____

Invoice \$150.00 fee: _____

PERMANENT TRANSFER – FINAL PROOF

Property Owner: Canyons Land & Cattle Co. Patron #: 1438
Property Address: Canyons Ranch Drive

USE	BEAT	HG	TWP	RNG	SEC	QQ	TAX LOT	ACRES
IRRIG	PB4	H-12-6-1-2	14	13	10	NWNW	515	0.24

TYPE OF CROP: Landscape Grass
METHOD OF IRRIGATION: Handline / Pump

1st Review Date: 6/8/21 Initials: BD Used Acres: .24 Dry Acres: _____
Photos taken with Collector: Yes No Collector Polygons: Yes No

Notes: Need to contact. If patron wants to keep final proof polygon then they need to put out 1 more line of handline. Landscape grass is established within polygon, just currently irrigated (see collector pic). If patron wants to adjust polygon to what is currently irrigated, see collector polygon, then they have achieved full-beneficial use
Sight alignment within tax lot and qt-qt.

Post Card Sent: _____ Complete Partial Dry

2nd Review:

Site appointment scheduled w/patron Date: _____ Informed of \$150 if not complete 3rd visit. Initials: _____ Used Acres: _____ Dry Acres: _____

Notes: _____

3rd Review:

Site appointment scheduled w/patron Date: _____
Initials: _____ Used Acres: _____ Dry Acres: _____

Notes: _____

If not complete invoice \$150 fee: _____

4th Review Date:

Site appointment scheduled w/patron Date: _____
Initials: _____ Used Acres: _____ Dry Acres: _____

Notes: _____

Invoice \$150.00 fee: _____

DESCHUTES COUNTY SEC.10 T14S R13E


E-RECEIVED
08/31/2022
OWRD

SCALE - 1" = 400'



SW 1/4 OF THE NW 1/4

OWRD: T-13298

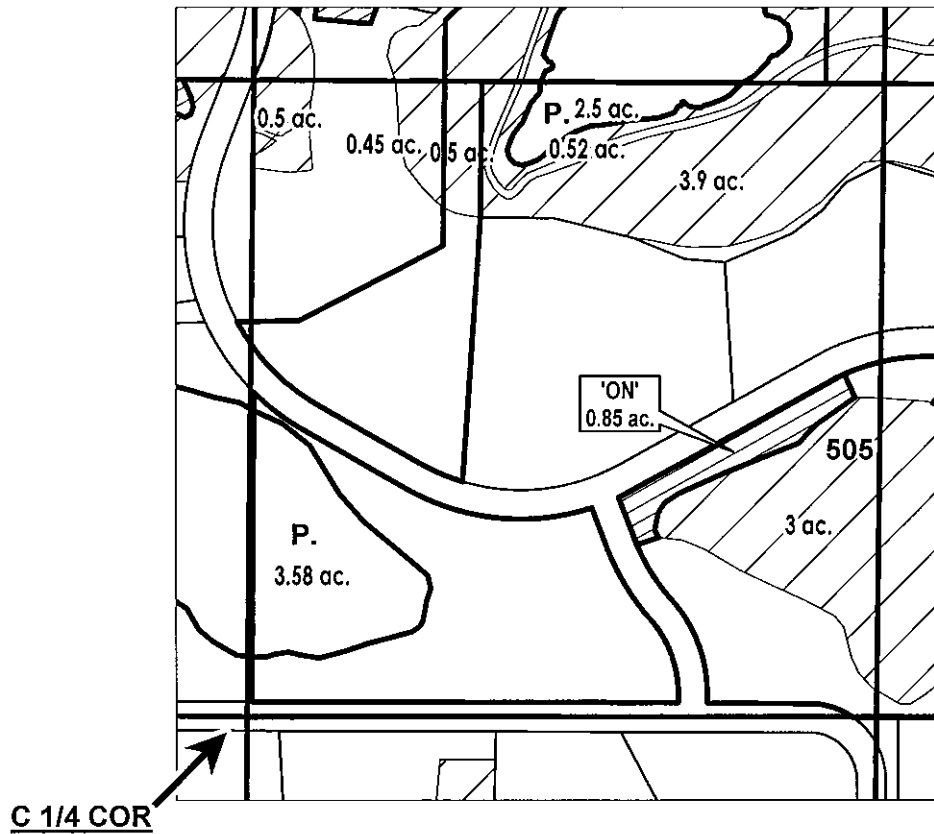

	POND
	EXISTING WATER RIGHTS
	ON LANDS



FINAL PROOF MAP

NAME: Ranch at the Canyons Association Inc

TAXLOT #: 505

0.85 ACRES

DATE: 8/24/2022

PERMANENT TRANSFER – FINAL PROOF

Property Owner: Canyons Land & Cattle Co. Patron #: 1438
 Property Address: Canyons Ranch Drive

USE	BEAT	HG	TWP	RNG	SEC	QQ	TAX LOT	ACRES
IRRIG	PB4	H-12-5	14	13	10	SWNW	505	0.85

TYPE OF CROP: Hay
 METHOD OF IRRIGATION: Hand-Line

1st Review Date: 6-8-21 Initials: BD Used Acres: 0.85 Dry Acres: _____
 Photos taken with Collector: Yes No Collector Polygons: Yes No
 Notes: Full beneficial use achieved.

Post Card Sent: _____ Complete Partial Dry

2nd Review:
 Site appointment scheduled w/patron Date: _____ Informed of \$150 if not complete 3rd visit.
 Initials: _____ Used Acres: _____ Dry Acres: _____
 Notes: _____

3rd Review:
 Site appointment scheduled w/patron Date: _____
 Initials: _____ Used Acres: _____ Dry Acres: _____
 Notes: _____

If not complete invoice \$150 fee: _____

4th Review Date:
 Site appointment scheduled w/patron Date: _____
 Initials: _____ Used Acres: _____ Dry Acres: _____
 Notes: _____

Invoice \$150.00 fee: _____

DESCHUTES COUNTY SEC.10 T14S R13E


E-RECEIVED
08/31/2022
OWRD

SCALE - 1" = 400'



SE 1/4 OF THE NW 1/4

OWRD: T-13298

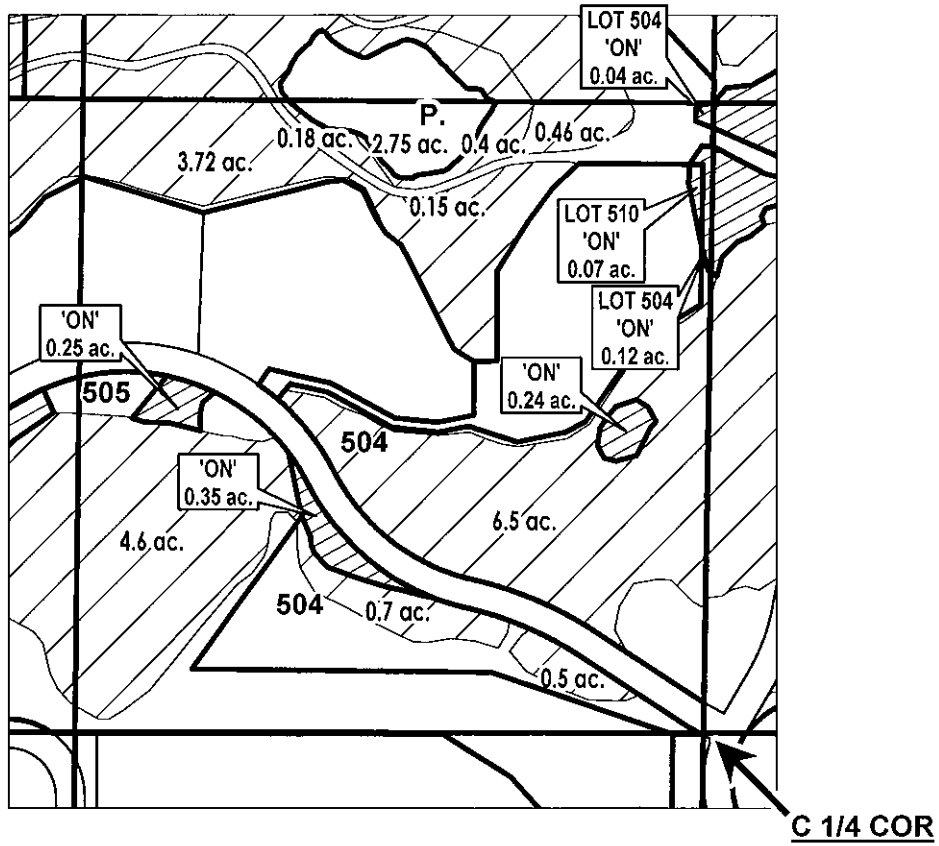

	POND
	EXISTING WATER RIGHTS
	ON LANDS



FINAL PROOF MAP

NAME: Ranch at the Canyons Association Inc

TAXLOT #: 504, 505, 510

1.07 ACRES

DATE: 8/24/2022

PERMANENT TRANSFER – FINAL PROOF

Property Owner: Canyons Land & Cattle Co. Patron #: 1438

Property Address: Canyons Ranch Drive

USE	BEAT	HG	TWP	RNG	SEC	QQ	TAX LOT	ACRES
IRRIG	PB4	H-12-3-3	14	13	10	SENW	504	0.75

TYPE OF CROP: Landscape / Hay

METHOD OF IRRIGATION: Hand line / Wheel-Line

1st Review Date: 6-8-21 Initials: BD Used Acres: .63 Dry Acres: .12

Photos taken with Collector: Yes No Collector Polygons: Yes No

Notes: Need to irrigate 0.12 polygon south of driveway. Needs a return visit & contact patron / irrigator.

Post Card Sent: Complete Partial Dry

2nd Review:

Site appointment scheduled w/patron Date: 8-17-21 Informed of \$150 if not complete 3rd visit. Initials: AK Used Acres: 0.12 Dry Acres: 0

Notes: Filled in dry spot south of Driveway. Producing bunchgrass. Photo in collector
(0.75 total)

3rd Review:

Site appointment scheduled w/patron Date: _____

Initials: _____ Used Acres: _____ Dry Acres: _____

Notes: _____

If not complete invoice \$150 fee: _____

4th Review Date:

Site appointment scheduled w/patron Date: _____

Initials: _____ Used Acres: _____ Dry Acres: _____

Notes: _____

Invoice \$150.00 fee: _____

PERMANENT TRANSFER – FINAL PROOF

Property Owner: Canyons Land & Cattle Co. Patron #: 1438

Property Address: Canyons Ranch Drive

USE	BEAT	HG	TWP	RNG	SEC	QQ	TAX LOT	ACRES
IRRIG	PB4	H-12-3-3	14	13	10	SENW	505	0.25

TYPE OF CROP: Grass / Landscaping
METHOD OF IRRIGATION: Hand-Line

1st Review Date: 6-8-21 Initials: BD Used Acres: _____ Dry Acres: 0.25

Photos taken with Collector: Yes No Collector Polygons: Yes No

Notes: Need to irrigate. Grass present, but handlines have not run all year.

Post Card Sent: _____ Complete Partial Dry

2nd Review:

Site appointment scheduled w/patron Date: 8-17-21 Informed of \$150 if not complete 3rd visit. Initials: RL Used Acres: 0.25 Dry Acres: _____

Notes: Irrigating with handline. mix crop, grass + some weeds
Photos in collector

3rd Review:

Site appointment scheduled w/patron Date: _____

Initials: _____ Used Acres: _____ Dry Acres: _____

Notes: _____

If not complete invoice \$150 fee: _____

4th Review Date:

Site appointment scheduled w/patron Date: _____

Initials: _____ Used Acres: _____ Dry Acres: _____

Notes: _____

Invoice \$150.00 fee: _____

PERMANENT TRANSFER – FINAL PROOF

Property Owner: Canyons Land & Cattle Co. Patron #: 1438
 Property Address: Canyons Ranch Drive

USE	BEAT	HG	TWP	RNG	SEC	QQ	TAX LOT	ACRES
IRRIG	PB4	H-12-3-3	14	13	10	SENW	510	0.07

TYPE OF CROP: Bunch-grass landscape
 METHOD OF IRRIGATION: Handline

1st Review Date: 6-8-21 Initials: BD Used Acres: _____ Dry Acres: 0.07

Photos taken with Collector: Yes No Collector Polygons: Yes No

Notes: Need to irrigate entire polygon. Need to contact irrigator / patron.

Post Card Sent: _____ Complete Partial Dry

2nd Review:

Site appointment scheduled w/patron Date: 8-17-21 Informed of \$150 if not complete 3rd visit.
 Initials: SK Used Acres: 0.07 Dry Acres: _____

Notes: Irrigated. Producing grass. photos in collector

3rd Review:

Site appointment scheduled w/patron Date: _____
 Initials: _____ Used Acres: _____ Dry Acres: _____

Notes: _____

If not complete invoice \$150 fee: _____

4th Review Date:

Site appointment scheduled w/patron Date: _____
 Initials: _____ Used Acres: _____ Dry Acres: _____

Notes: _____

Invoice \$150.00 fee: _____

DESCHUTES COUNTY SEC.10 T14S R13E


E-RECEIVED
08/31/2022
OWRD

SCALE - 1" = 400'



NW 1/4 OF THE SE 1/4

OWRD: T-13298

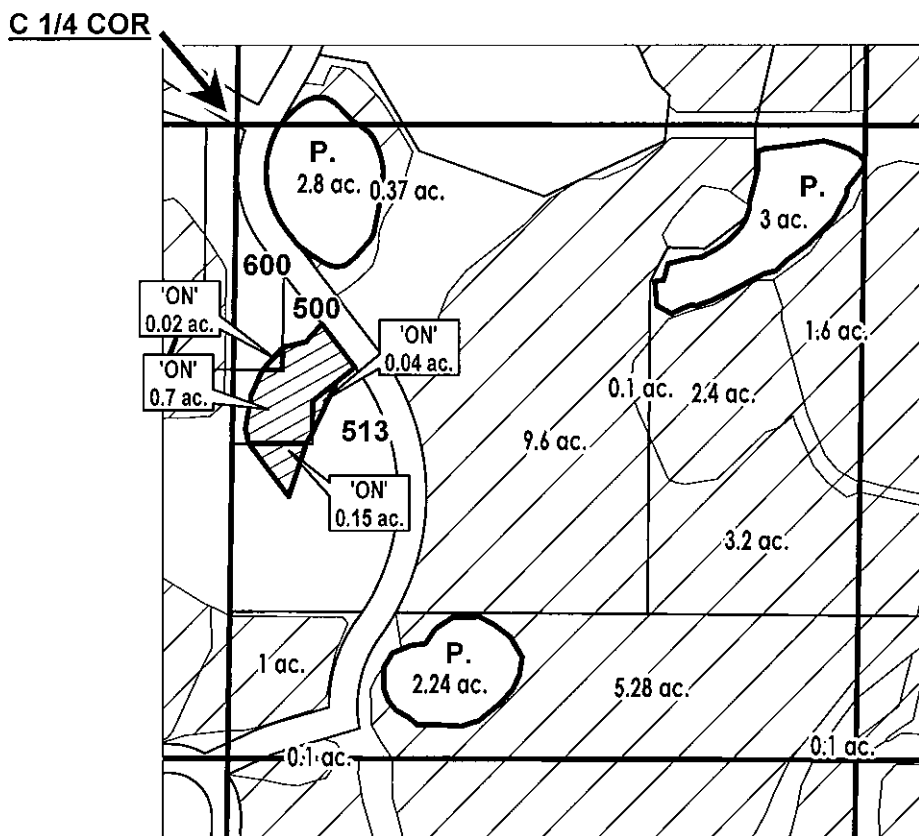

	POND
	EXISTING WATER RIGHTS
	ON LANDS



FINAL PROOF MAP

NAME: Ranch at the Canyons Association Inc

TAXLOT #: 500, 513, 600

0.91 ACRES

DATE: 8/24/2022

PERMANENT TRANSFER – FINAL PROOF

Property Owner: Canyons Land & Cattle Co. Patron #: 1438

Property Address: Canyons Ranch Drive

USE	BEAT	HG	TWP	RNG	SEC	QQ	TAX LOT	ACRES
IRRIG	PB3	J-24	14	13	10	NWSE	500	0.70

TYPE OF CROP: lawn

METHOD OF IRRIGATION: Sprinkler

1st Review Date: 6.8.21 Initials: BD Used Acres: 0.70 Dry Acres: _____

Photos taken with Collector: Yes No Collector Polygons: Yes No

Notes: Full beneficial use achieved. Established lawn.

Post Card Sent: _____ Complete Partial Dry

2nd Review:

Site appointment scheduled w/patron Date: _____ Informed of \$150 if not complete 3rd visit. Initials: _____ Used Acres: _____ Dry Acres: _____

Notes: _____

3rd Review:

Site appointment scheduled w/patron Date: _____

Initials: _____ Used Acres: _____ Dry Acres: _____

Notes: _____

If not complete invoice \$150 fee: _____

4th Review Date:

Site appointment scheduled w/patron Date: _____

Initials: _____ Used Acres: _____ Dry Acres: _____

Notes: _____

Invoice \$150.00 fee: _____

PERMANENT TRANSFER – FINAL PROOF

Property Owner: Canyons Land & Cattle Co. Patron #: 1438

Property Address: Canyons Ranch Drive

USE	BEAT	HG	TWP	RNG	SEC	QQ	TAX LOT	ACRES
IRRIG	PB3	J-24	14	13	10	NWSE	513	0.19

TYPE OF CROP: Lawn

METHOD OF IRRIGATION: Spinkler

1st Review Date: 6-8-21 Initials: BD Used Acres: 0.19 Dry Acres: _____

Photos taken with Collector: Yes No Collector Polygons: Yes No

Notes: Achieved full beneficial use.

Post Card Sent: _____ Complete Partial Dry

2nd Review:

Site appointment scheduled w/patron Date: _____ Informed of \$150 if not complete 3rd visit. Initials: _____ Used Acres: _____ Dry Acres: _____

Notes: _____

3rd Review:

Site appointment scheduled w/patron Date: _____

Initials: _____ Used Acres: _____ Dry Acres: _____

Notes: _____

If not complete invoice \$150 fee: _____

4th Review Date:

Site appointment scheduled w/patron Date: _____

Initials: _____ Used Acres: _____ Dry Acres: _____

Notes: _____

Invoice \$150.00 fee: _____

PERMANENT TRANSFER – FINAL PROOF

Property Owner: Canyons Land & Cattle Co. Patron #: 1438

Property Address: Canyons Ranch Drive

USE	BEAT	HG	TWP	RNG	SEC	QQ	TAX LOT	ACRES
IRRIG	PB3	J-24	14	13	10	NWSE	600	0.02

TYPE OF CROP: Lawn

METHOD OF IRRIGATION: Sprinkler

1st Review Date: 6-8-21 Initials: BD Used Acres: 0.02 Dry Acres: _____

Photos taken with Collector: Yes No Collector Polygons: Yes No

Notes: Full beneficial use achieved. Established lawn

Post Card Sent: _____ Complete Partial Dry

2nd Review:

Site appointment scheduled w/patron Date: _____ Informed of \$150 if not complete 3rd visit. Initials: _____ Used Acres: _____ Dry Acres: _____

Notes: _____

3rd Review:

Site appointment scheduled w/patron Date: _____

Initials: _____ Used Acres: _____ Dry Acres: _____

Notes: _____

If not complete invoice \$150 fee: _____

4th Review Date:

Site appointment scheduled w/patron Date: _____

Initials: _____ Used Acres: _____ Dry Acres: _____

Notes: _____

Invoice \$150.00 fee: _____