



October 13, 2022

Ann Reece
District Transfer Advisor
Oregon Water Resources Department
725 Summer St NE Ste A
Salem, OR 97301-1266

RE: FINAL PROOFS – Claim of Beneficial Use for T-13341

Dear Ann,

Central Oregon Irrigation District is submitting our claim of beneficial use for a permanent District transfer ("385").

Enclosed is a list of the authorized lands. Site reports are attached to each map and any specific details about the properties are contained in each site report.

Please Note: The below noted properties have had the following changes:

1. 14-13-15 NWNE 300: Partial use of 0.80 acres. Cancellation of 1.1 acres due to nonuse
2. 14-13-15 SWNE 300: Partial use of 1.6 acres. Cancellation of 2.4 acres due to nonuse

The District certifies that it has inspected the place of use and confirms the change in place of use has been completed consistent with the terms and conditions of the final order approving the transfer.



Craig Horrell
Managing Director, Central Oregon Irrigation District

Date: 10.13.22



Oregon Water Resources Department
725 Summer Street NE, Suite A
Salem, Oregon 97301-1266
(503) 986-0900
www.wrd.state.or.us

District Permanent Water Right Transfer Claim of Beneficial Use

1. APPLICANT INFORMATION

District: CENTRAL OREGON IRRIGATION DISTRICT

Contact Person: LESLIE CLARK

Phone: 541-548-6047

Mailing Address: 1055 SW LAKE COURT

City: REDMOND

State: OR

Zip: 97756

E-Mail address: lesliec@coid.org

Transfer Number: T - 13341

2. WATER RIGHT(S)

Pursuant to OAR Chapter 690, Division 385, the district is submitting to the Water Resources Department this claim of beneficial use, with the appropriate fee, for the following water right(s):

NOTE: Fees do not apply if the priority date is prior to July 9, 1987.

PERMIT NUMBER	CERTIFICATE NUMBER	DECREE (name, volume, and page)	PRIMARY (P) OR SUPP (S)
-	94956		<input checked="" type="checkbox"/> P <input type="checkbox"/> S
-	76714		<input type="checkbox"/> P <input checked="" type="checkbox"/> S
-			<input type="checkbox"/> P <input type="checkbox"/> S
-			<input type="checkbox"/> P <input type="checkbox"/> S

3. AUTHORIZED POINT(S) OF DIVERSION (POD) / APPROPRIATION (POA)

The authorized point(s) of diversion / appropriation for the water right modified by the transfer are as follows:

PERMIT NUMBER	DECREE or CERTIFICATE	POD / POA #	SOURCE	LOCATION – MEASURED DISTANCES
-	94956	1	DESCH	SW ¼ NE ¼ SEC. 13, T. 18 S., R. 11 E., W.M.; 1520' S. & 1535' W. FROM THE NE CORNER OF SEC. 13
-	94956	11	DESCH	SE ¼ NE ¼ SEC. 29, T. 17 S., R. 12 E., W.M.; 850' N. AND 630' W. FROM THE E ¼ CORNER OF SEC. 29
-	76714		C.P.	NE ¼ NE ¼ SECTION 17, T 21 S, R 8 E, W.M.

6. SIGNATURES

The district certifies that it has inspected the place of use listed in Table I, and confirms the change in place of use has been completed consistent with the terms and conditions of the final order approving the transfer.



Craig Horrell
Managing Director, Central Oregon Irrigation District

10.13.22

Date

DESCHUTES COUNTY SEC.08 T14S R13E


E-RECEIVED
10/13/2022
OWRD

SCALE - 1" = 400'




SW 1/4 OF THE NW 1/4

OWRD: T-13341

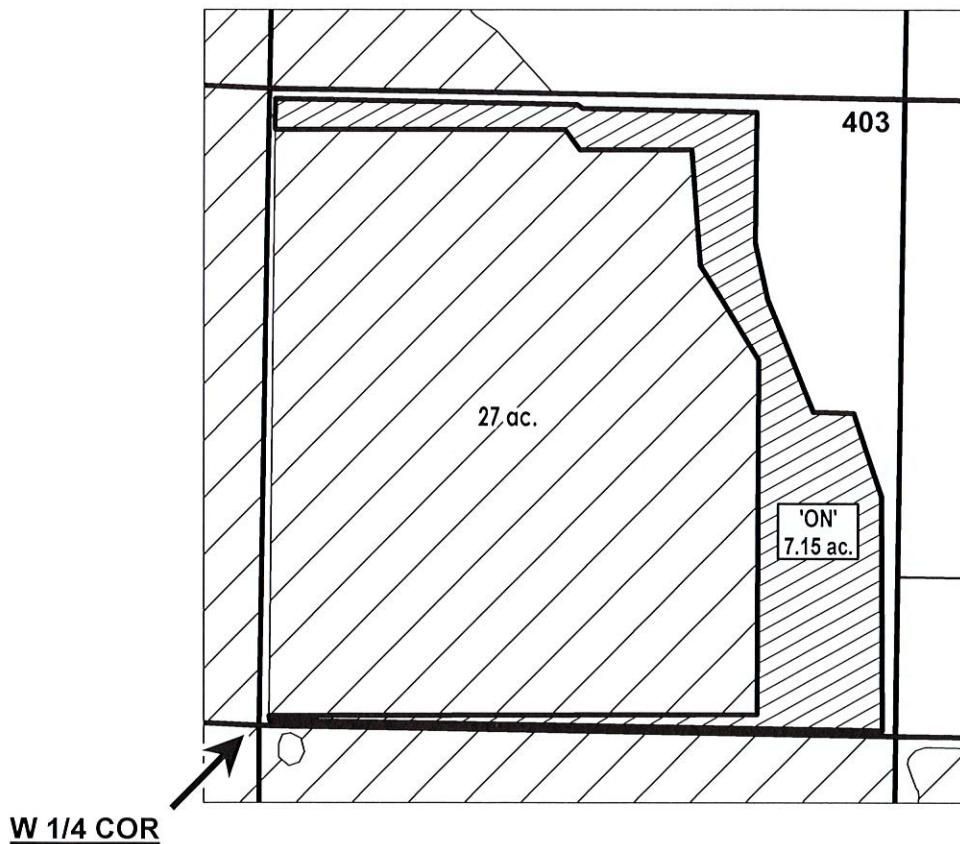

	EXISTING WATER RIGHTS
	ON LANDS

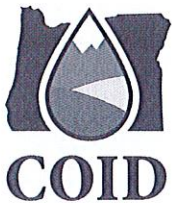

FINAL PROOF MAP

NAME: Butterfield, Patrick/Patricia

TAXLOT #: 403

7.15 ACRES

DATE: 9/7/2022

PERMANENT TRANSFER – FINAL PROOF

OWRD #: T-13341
Petition #: P-2019-005

Property Owner: Butterfield, Patrick/Patricia Patron #: 88825

Property Address: 10803 NW 27th St, Terrebonne

USE	BEAT	HG	TWP	RNG	SEC	QQ	TAX LOT	ACRES
IRRIG	PB4	H-14-1-8	14	13	8	SWNW	403	7.150
IRRIG								

TYPE OF CROP: Hay/Pasture

METHOD OF IRRIGATION: wheel-line

1st Review Date: 6/9/20 Initials: AC Used Acres: 7.15 Dry Acres: 0

Photos taken with Collector: Yes No Collector Polygons: Yes No

Notes: CAP Sed. Full use, healthy grass knee high

Post Card Sent: 6/9/20 Complete Partial Dry

2nd Review:

Site appointment scheduled w/patron Date: _____ Informed of \$150 if not complete 3rd visit.

Initials: _____ Used Acres: _____ Dry Acres: _____

Notes: _____

3rd Review:

Site appointment scheduled w/patron Date: _____

Initials: _____ Used Acres: _____ Dry Acres: _____

Notes: _____

If not complete invoice \$150 fee: _____

4th Review Date:

Site appointment scheduled w/patron Date: _____

Initials: _____ Used Acres: _____ Dry Acres: _____

Notes: _____

Invoice \$150.00 fee: _____

DESCHUTES COUNTY SEC.15 T14S R13E

E-RECEIVED
10/13/2022
OWRD


SCALE - 1" = 400'



NW 1/4 OF THE NE 1/4; SW 1/4 OF THE NE 1/4

OWRD: T-13341

N 1/4 COR

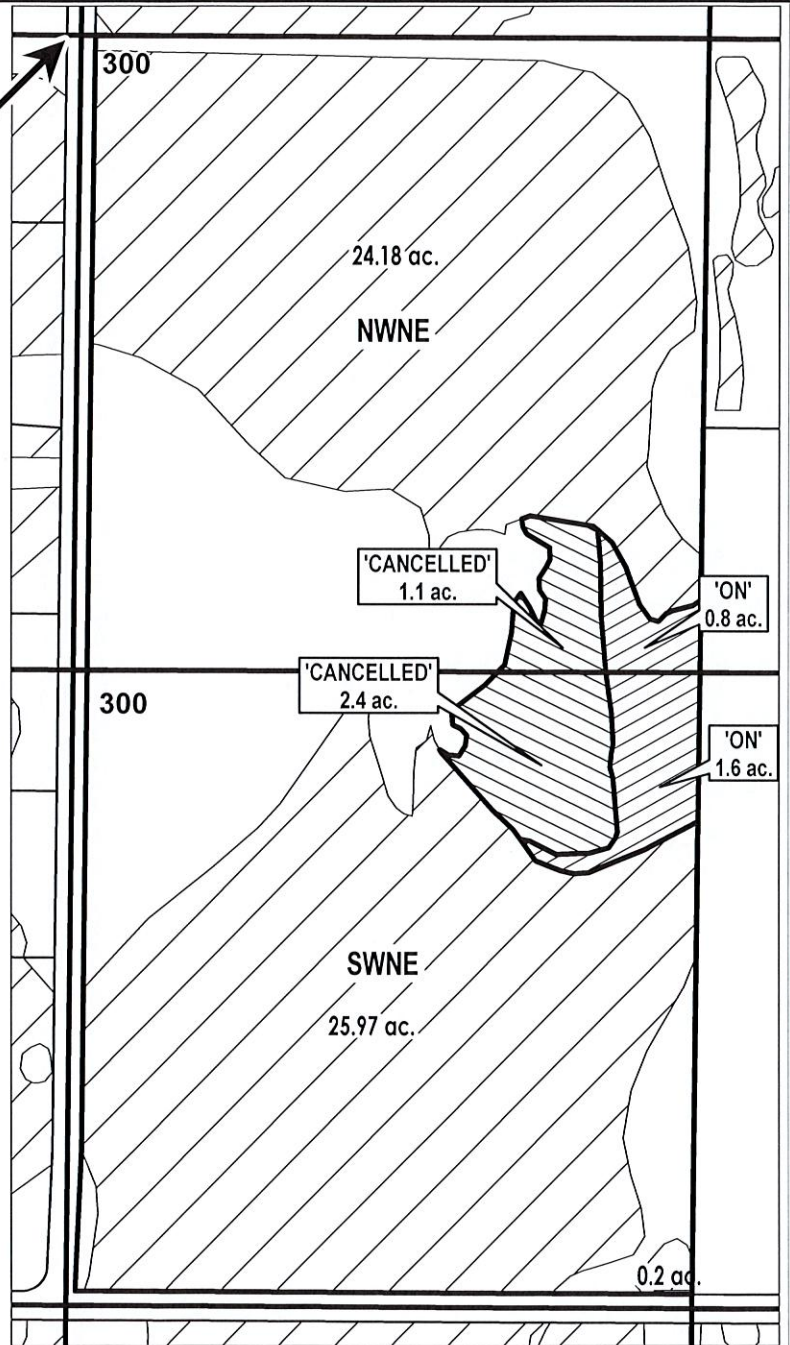

ON LANDS



CANCELLED LANDS



EXISTING WATER RIGHTS



FINAL PROOF MAP

NAME: Dunn, James/Betty

TAXLOT #: 300

2.4 ACRES 'ON'

3.5 ACRES 'CANCELLED'

DATE: 9/7/2022

PERMANENT TRANSFER – FINAL PROOF

OWRD #: T-13341
Petition #: P-2019-005

Property Owner: Dunn, James/Betty Patron #: 4838

Property Address: 9190 NE 9th St, Terrebonne

USE	BEAT	HG	TWP	RNG	SEC	QQ	TAX LOT	ACRES
IRRIG	PB3	J-23	14	13	15	NWNE	300	1.900
IRRIG	PB3	J-20	14	13	15	SWNE	300	4.000

TYPE OF CROP: Grass-Pasture mix
METHOD OF IRRIGATION: sprinkle

NWNE = 0.75
SWNE = 1.42
NWNE = 1.15
SWNE = 2.58

1st Review Date: 6/24/21 Initials: JT Used Acres: 7 Dry Acres: 3.73

Photos taken with Collector: Yes No Collector Polygons: Yes No GPS Download
Notes: New crop, thick and about 6 inches of growth.
Being sprinkled with handline.
Does not extend to pond. Needs to increase area by 3.73ac.

Post Card Sent: Complete Partial Dry

2nd Review:

Site appointment scheduled w/patron Date: 5/24/22 Informed of \$150 if not complete 3rd visit.
Initials: JT Used Acres: 0 Dry Acres: 5.9

Notes: Full area dry
retain what is currently showing Bill

3rd Review:

Site appointment scheduled w/patron Date: 9/16/22
Initials: JT Used Acres: 2.4 Dry Acres: 3.5 → used NWNE: 0.8 NWNE: 1.1
SWNE: 1.0 SWNE: 2.4

Notes: Irrigated area increased → New seed extended to hillside.
Road established over portion of transfer water.
Crop does not extend to pond.

If not complete invoice \$150 fee: _____

SR completed by Jessi T and Cary P. on 9/16/22

4th Review Date:

Site appointment scheduled w/patron Date: _____
Initials: _____ Used Acres: _____ Dry Acres: _____

Notes: _____

Invoice \$150.00 fee: _____

DESCHUTES COUNTY SEC.20 T14S R13E



E-RECEIVED
10/13/2022
OWRD

SCALE - 1" = 400'



NW 1/4 OF THE NW 1/4

OWRD: T-13341

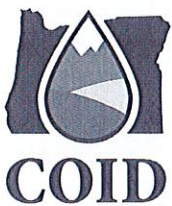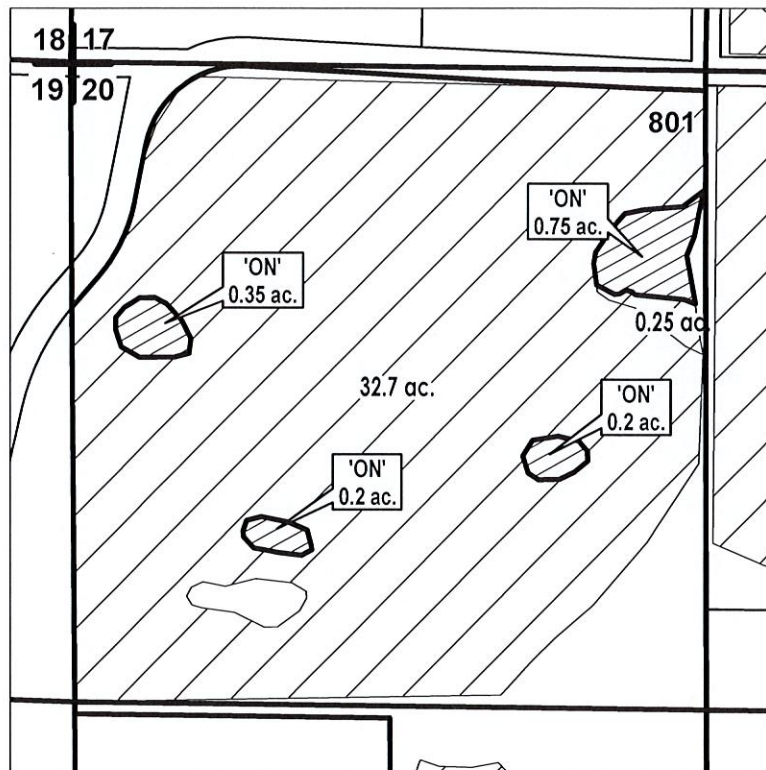

FINAL PROOF MAP

NAME: Aaby, Darrell/Sherry

TAXLOT #: 801

1.5 ACRES

DATE: 9/7/2022

PERMANENT TRANSFER – FINAL PROOF

OWRD #: T-13341
Petition #: P-2019-005

Property Owner: Aaby, Darrell/Sherry Patron #: 4316

Property Address: 7575 NW Almeter Way, Terrebonne

USE	BEAT	HG	TWP	RNG	SEC	QQ	TAX LOT	ACRES
IRRIG	PB4	F-6-2	14	13	20	NWNW	801	1.500
IRRIG								

TYPE OF CROP: Hay
METHOD OF IRRIGATION: Pivot

1st Review Date: 6/9/20 Initials: AC Used Acres: 1.5 Dry Acres: 0
Photos taken with Collector: Yes No Collector Polygons: Yes No
Notes: Full use. Hay waist high. Very healthy. Ready to cut

Post Card Sent: 6/9/20 Complete Partial Dry

2nd Review:

Site appointment scheduled w/patron Date: _____ Informed of \$150 if not complete 3rd visit.
Initials: _____ Used Acres: _____ Dry Acres: _____
Notes: _____

3rd Review:

Site appointment scheduled w/patron Date: _____
Initials: _____ Used Acres: _____ Dry Acres: _____
Notes: _____

If not complete invoice \$150 fee: _____

4th Review Date:

Site appointment scheduled w/patron Date: _____
Initials: _____ Used Acres: _____ Dry Acres: _____
Notes: _____

Invoice \$150.00 fee: _____

DESCHUTES COUNTY SEC.24 T14S R13E


E-RECEIVED
10/13/2022
OWRD

SCALE - 1" = 400'




NW 1/4 OF THE SE 1/4

OWRD: T-13341

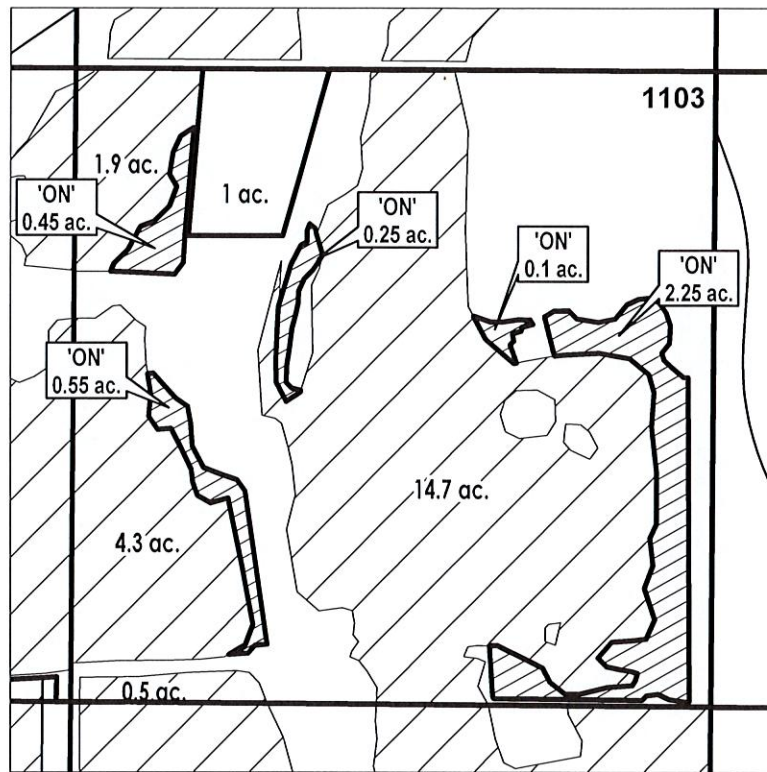

	EXISTING WATER RIGHTS
	ON LANDS
	PARCELS W/ WATER RIGHTS

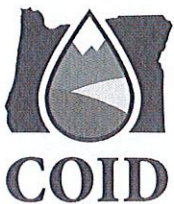

FINAL PROOF MAP

NAME: Campbell, Cherie Carr

TAXLOT #: 1103

3.6 ACRES

DATE: 9/27/2022

PERMANENT TRANSFER – FINAL PROOF

OWRD #: T-13341
Petition #: P-2019-005

Property Owner: Campbell, Cherie Carr Patron #: 5343

Property Address: 6829 NE 41st St, Redmond

USE	BEAT	HG	TWP	RNG	SEC	QQ	TAX LOT	ACRES
IRRIG	PB3	PBC-53	14	13	24	NWSE	1103	3.600
IRRIG								

TYPE OF CROP: pasture/landscaping near house
METHOD OF IRRIGATION: sprinkle/flood

1st Review Date: 6/12/20 Initials: AC Used Acres: 3.6 Dry Acres:

Photos taken with Collector: Yes No Collector Polygons: Yes No

Notes: GPSed Nice landscaping around house
- East pasture -> well established
- West pasture -> cows on it. Areas knee high

Post Card Sent: 6/15/20 Complete Partial Dry

2nd Review:

Site appointment scheduled w/patron Date: _____ Informed of \$150 if not complete 3rd visit.
Initials: _____ Used Acres: _____ Dry Acres: _____

Notes: _____

3rd Review:

Site appointment scheduled w/patron Date: _____
Initials: _____ Used Acres: _____ Dry Acres: _____

Notes: _____

If not complete invoice \$150 fee: _____

4th Review Date:

Site appointment scheduled w/patron Date: _____
Initials: _____ Used Acres: _____ Dry Acres: _____

Notes: _____

Invoice \$150.00 fee: _____


DESCHUTES COUNTY SEC.25 T14S R13E

SCALE - 1" = 400'



SE 1/4 OF THE NW 1/4

OWRD: T-13341

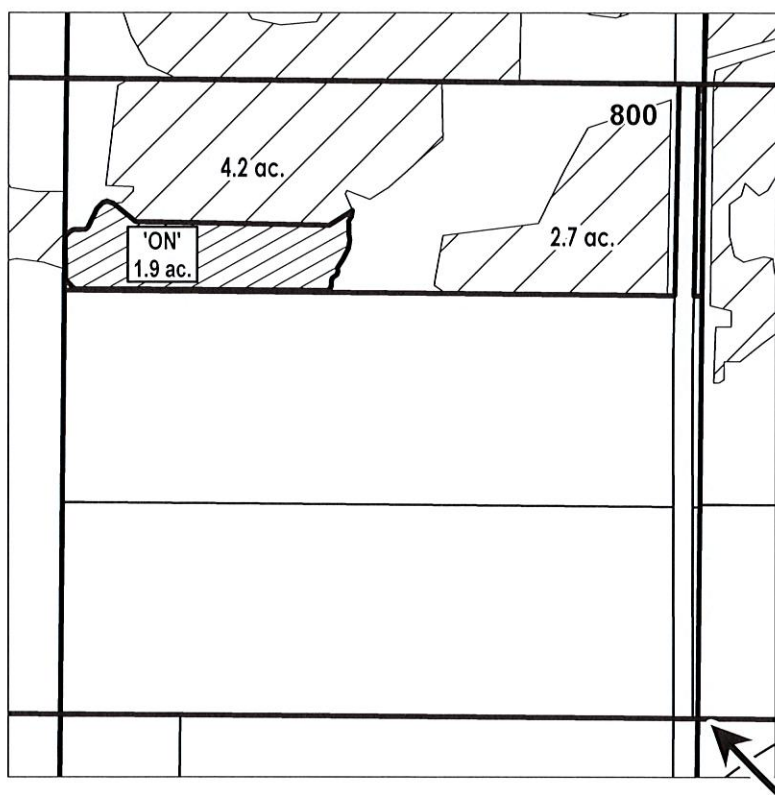

C 1/4 COR

	EXISTING WATER RIGHTS
	ON LANDS



FINAL PROOF MAP

NAME: Farnsworth, Lenard/Christine

TAXLOT #: 800

1.9 ACRES

DATE: 9/7/2022

PERMANENT TRANSFER – FINAL PROOF

OWRD #: T-13341
Petition #: P-2019-005

Property Owner: Farnsworth, Lenard/Christine Patron #: 347

Property Address: 5975 NE 41st, Redmond

USE	BEAT	HG	TWP	RNG	SEC	QQ	TAX LOT	ACRES
IRRIG	PB3	PBC-48-0	14	13	25	SENW	800	1.900
IRRIG								

TYPE OF CROP: pasture
METHOD OF IRRIGATION: sprinkler

1st Review Date: 6/12/20 Initials: AC Used Acres: 1.9 Dry Acres: EQ
Photos taken with Collector: Yes No Collector Polygons: Yes No
Notes: GPS set - grass growing in full, well established
slight adjustment

Post Card Sent: 6/15/20 Complete Partial Dry

2nd Review:
Site appointment scheduled w/patron Date: _____ Informed of \$150 if not complete 3rd visit.
Initials: _____ Used Acres: _____ Dry Acres: _____
Notes: _____

3rd Review:
Site appointment scheduled w/patron Date: _____
Initials: _____ Used Acres: _____ Dry Acres: _____
Notes: _____

If not complete invoice \$150 fee: _____

4th Review Date:
Site appointment scheduled w/patron Date: _____
Initials: _____ Used Acres: _____ Dry Acres: _____
Notes: _____

Invoice \$150.00 fee: _____

DESCHUTES COUNTY SEC.34 T14S R13E


E-RECEIVED
10/13/2022
OWRD

SCALE - 1" = 400'




SW 1/4 OF THE NE 1/4

OWRD: T-13341

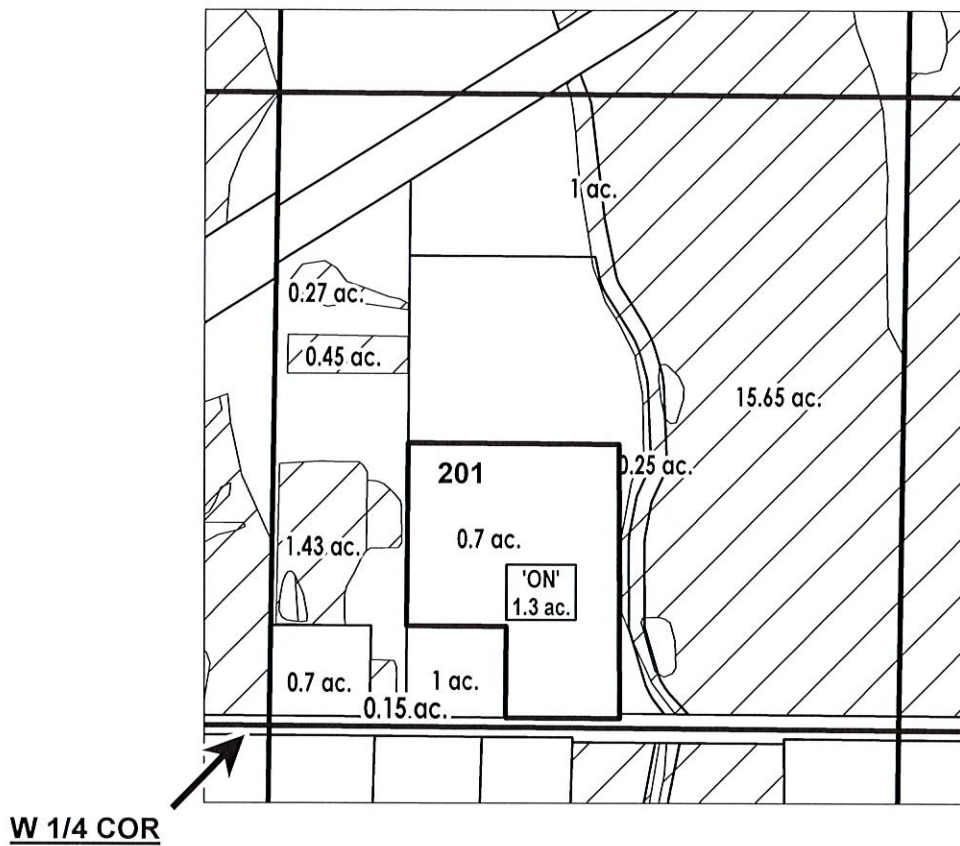

- EXISTING WATER RIGHTS
- ON LANDS
- PARCELS W/ WATER RIGHTS

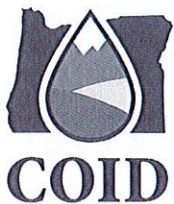

FINAL PROOF MAP

NAME: Batty, James/Pamela

TAXLOT #: 201

1.3 ACRES

DATE: 9/7/2022

PERMANENT TRANSFER – FINAL PROOF

OWRD #: T-13341
Petition #: P-2019-005

Property Owner: Batty, James/Pamela Patron #: 4175
Property Address: 1023 NE Yucca Ave, Redmond

USE	BEAT	HG	TWP	RNG	SEC	QQ	TAX LOT	ACRES
IRRIG	PB3	G-6	14	13	34	SWNE	201	1.300
IRRIG								

TYPE OF CROP: pasture/lawn
METHOD OF IRRIGATION: sprinklers

1st Review Date: 7/23/20 Initials: AE Used Acres: 1.07 Dry Acres: 0.83
Photos taken with Collector: Yes No Collector Polygons: Yes No
Notes: GPScd - what is currently being irrigated is good.
Still short 0.83

Post Card Sent: 7/23/20 Complete Partial Dry

2nd Review:
Site appointment scheduled w/patron Date: 6/1/21 Informed of \$150 if not complete 3rd visit.
Initials: JT Used Acres: .64 Dry Acres: .66
Notes: Western pasture reseeded + being sprinkled.
Still short 0.66 ac.

3rd Review:
Site appointment scheduled w/patron Date: 5/23/22
Initials: JP Used Acres: 1.87 Dry Acres: .13
Notes: 5/23/22 Planted NE of barn. meet's 1.3ac transfer, but short 0.13 ac of total 2ac w/

If not complete invoice \$150 fee: JP Did not charge \$150 fee due to paying \$1750 ext. fee

4th Review Date:
Site appointment scheduled w/patron Date: 7/12/22
Initials: JT Used Acres: 1.3 Dry Acres: 0 2.0 ac irrigated
Notes: 0.13 proved up Full use. photos in field maps.



Invoice \$150.00 fee: _____

CROOK COUNTY SEC.16 T16S R14E

E-RECEIVED
10/13/2022
OWRD

OWRD: T-13341

SCALE - 1" = 400'


-  EXISTING WATER RIGHTS
-  ON LANDS



NW 1/4

08 | 09

17 | 16

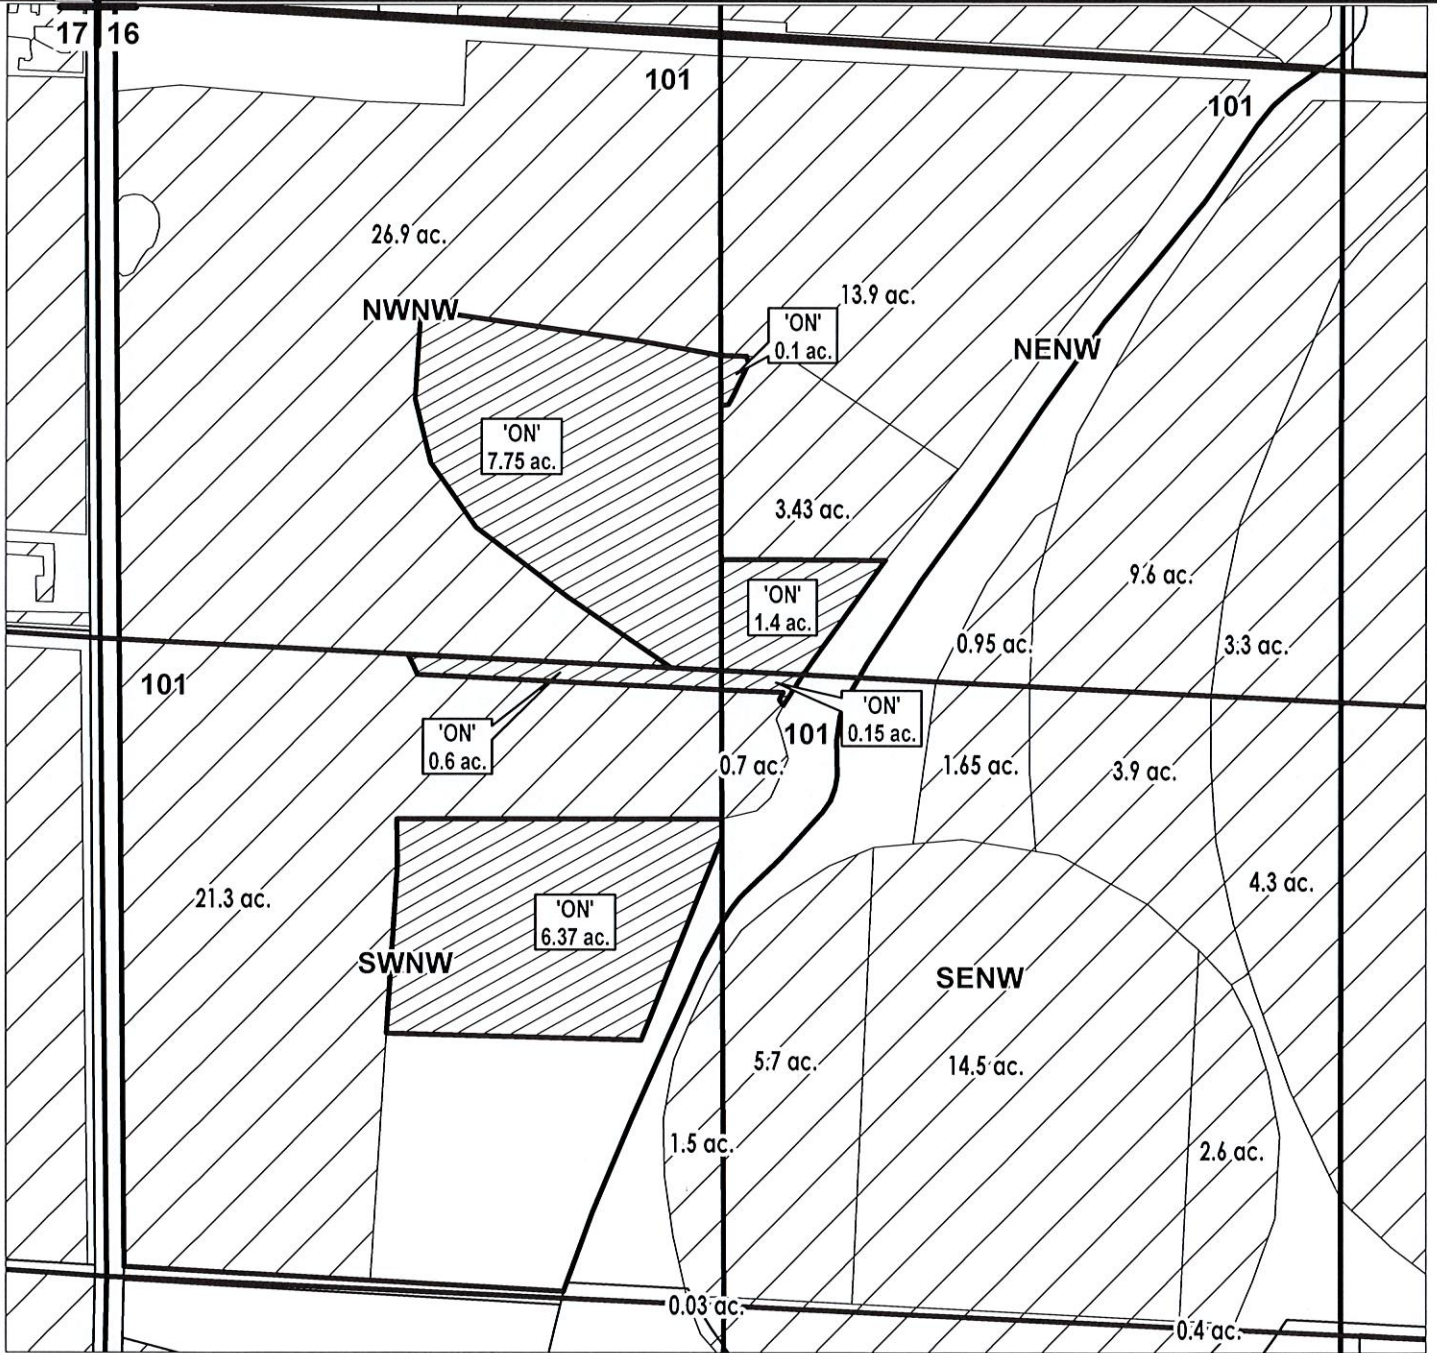

FINAL PROOF MAP

NAME: England, Jim/Jill

TAXLOT #: 101

16.37 ACRES

DATE: 9/7/2022

PERMANENT TRANSFER – FINAL PROOF

OWRD #: T-13341
Petition #: P-2019-005

Property Owner: England, Jim/Jill Patron #: 3891
Property Address: 12518 SW Powell Butte Hwy, Powell Butte

USE	BEAT	HG	TWP	RNG	SEC	QQ	TAX LOT	ACRES
IRRIG	CO3	K-5-4*	16	14	16	NENW	101	1.05 ^{1.15}
IRRIG	CO3	K-5-4*	16	14	16	NWNW	101	7.75
IRRIG	CO3	K-5-2*	16	14	16	SWNW	101	6.97
IRRIG	CO3	K-5-4*	16	14	16	SEnw	101	0.15

TYPE OF CROP: pasture
METHOD OF IRRIGATION: Flood

1st Review Date: 7/7/20 Initials: AC Used Acres: 15.92 Dry Acres: 0

Photos taken with Collector: Yes No Collector Polygons: Yes No

Notes: GPSed - Irrigated to the edge. Looks great!

Post Card Sent: 7/7/20 Complete Partial Dry

2nd Review:
Site appointment scheduled w/patron Date: _____ Informed of \$150 if not complete 3rd visit.
Initials: _____ Used Acres: _____ Dry Acres: _____
Notes: _____

3rd Review:
Site appointment scheduled w/patron Date: _____
Initials: _____ Used Acres: _____ Dry Acres: _____
Notes: _____

If not complete invoice \$150 fee: _____

4th Review Date:
Site appointment scheduled w/patron Date: _____
Initials: _____ Used Acres: _____ Dry Acres: _____