


# T. 2N., R. 4W., W.M.

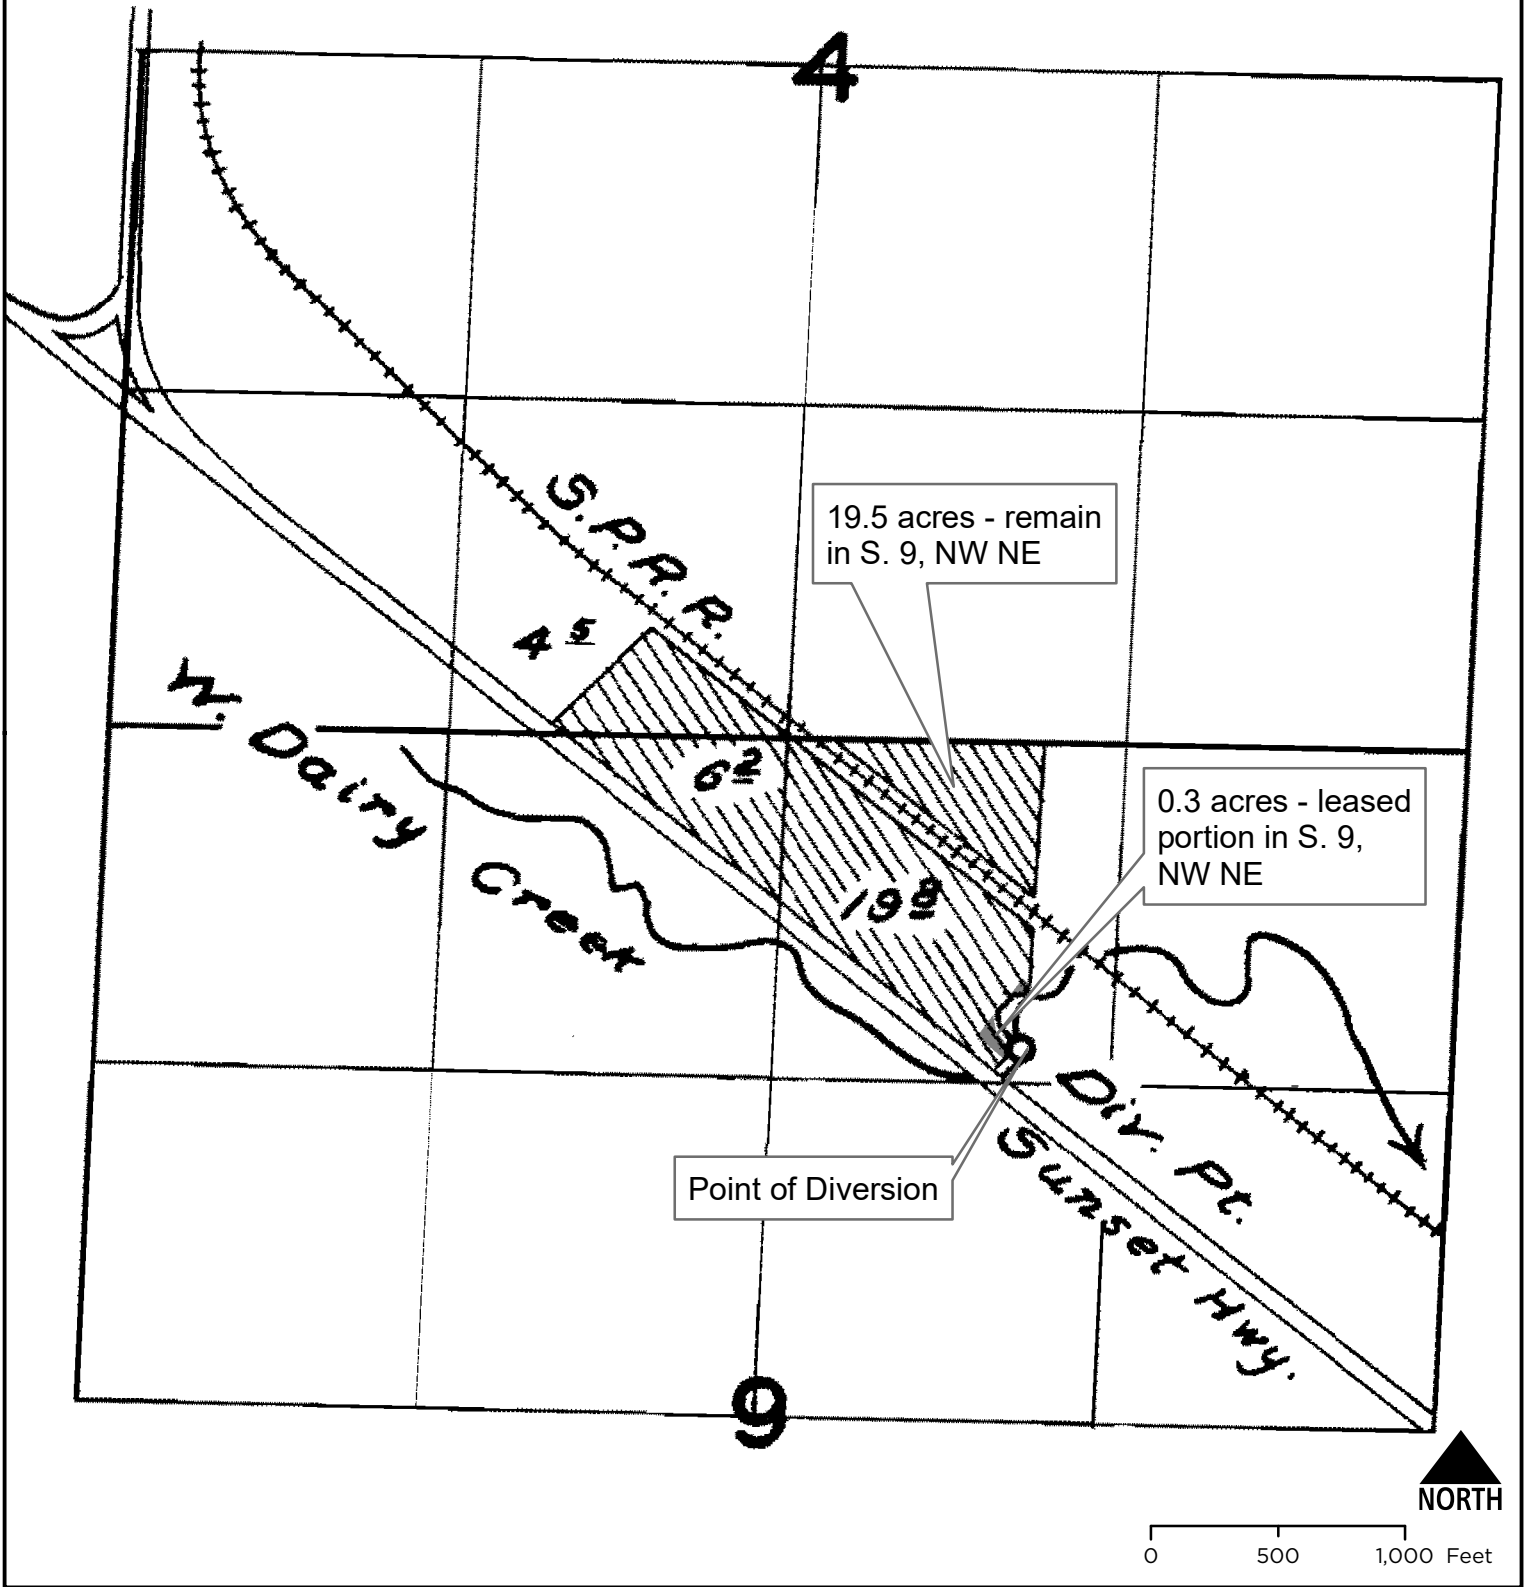

## Location of Irrigated Area - 26161

■ Area to be leased Instream