
## TOWNSHIP 37 SOUTH, RANGE 4 WEST, W.M. SECTION 32 JACKSON COUNTY, OREGON

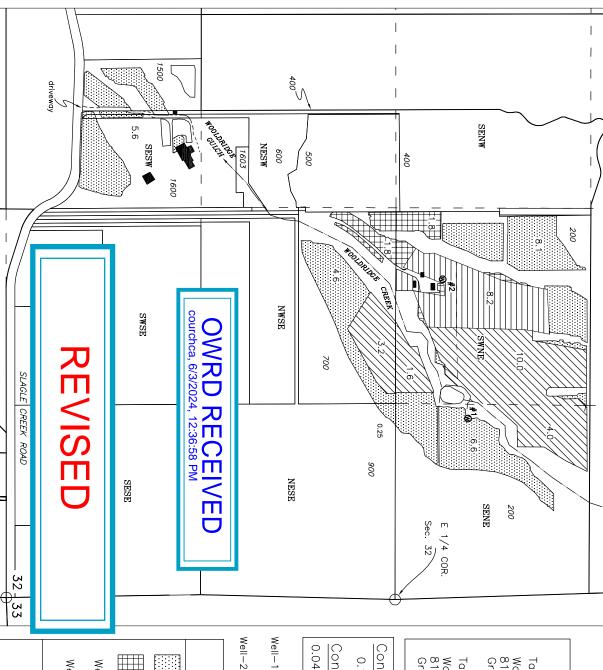

## ALLOCATION OF CONSERVED CERTIFICATE 52048 WATER

(Revision CW-141)

Wooldridge Creek Vineyard, 818 Slagle Creek Road Grants Pass, OR Tax Lots 200,700 & 900 PROPERTY OWNERS Road 97527 

Warrick Vineyard, LLC 818 Slagle Creek Roa Grants Pass, OR 97! Tax Lots 1500, 1600 Road 97527

1/28/2024 n.e.d. Scale660

Conserved Water 1 Applicant 75% Rev.6/3/2024 n.e.d.

0.143 CFS Conserved Water 28.35 AF

0.047 CFS Conserved Water 9.45 AF Conserved Water State 25%

Certificate 52048

18.8 Ac. 0.24 CFS

Reduced

Ac. 0.10 CFS Reduced to 0.045 CFS Reduced to 9.02 AF Reduced to 0.105CFS Reduced to 20.68 AF

8.2

Place of Use Irrigation of Conserved Water

0.018 CFS, 3.5 AF Well-2, 3.6 Acres Conserved Water 0.125 CFS, Well-1, 25.15 Acres Conserved Water 24.85 AF

We∥ Well #1 not to exceed 0.23 CFS & 45.53 AF under C-52048 & conserved water #2 not to exceed 0.063 CFS & 12.52 AF under C-52048 & conserved water

This map is not intended to provide legal dimensions or locations of property ownership lines

8 SE/NE 500 feet North & 1,225 feet West from the Ш 1/4 Corner Section 32

 $\otimes$ #2 SW/NE 350 feet North & 2,185 feet West from the E 1/4 Corner Section 32 Location of wells from Certificate 52048

SUPERIOR WATER RIGHT CONSULTING LLC. normthewaterguy@charter.net GRANTS PASS, OR 97526 PHONE (541) 761-1057 245 GLENOAK LANE