
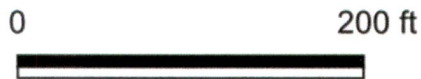


RECEIVED
JUN 12 2023
OWRD

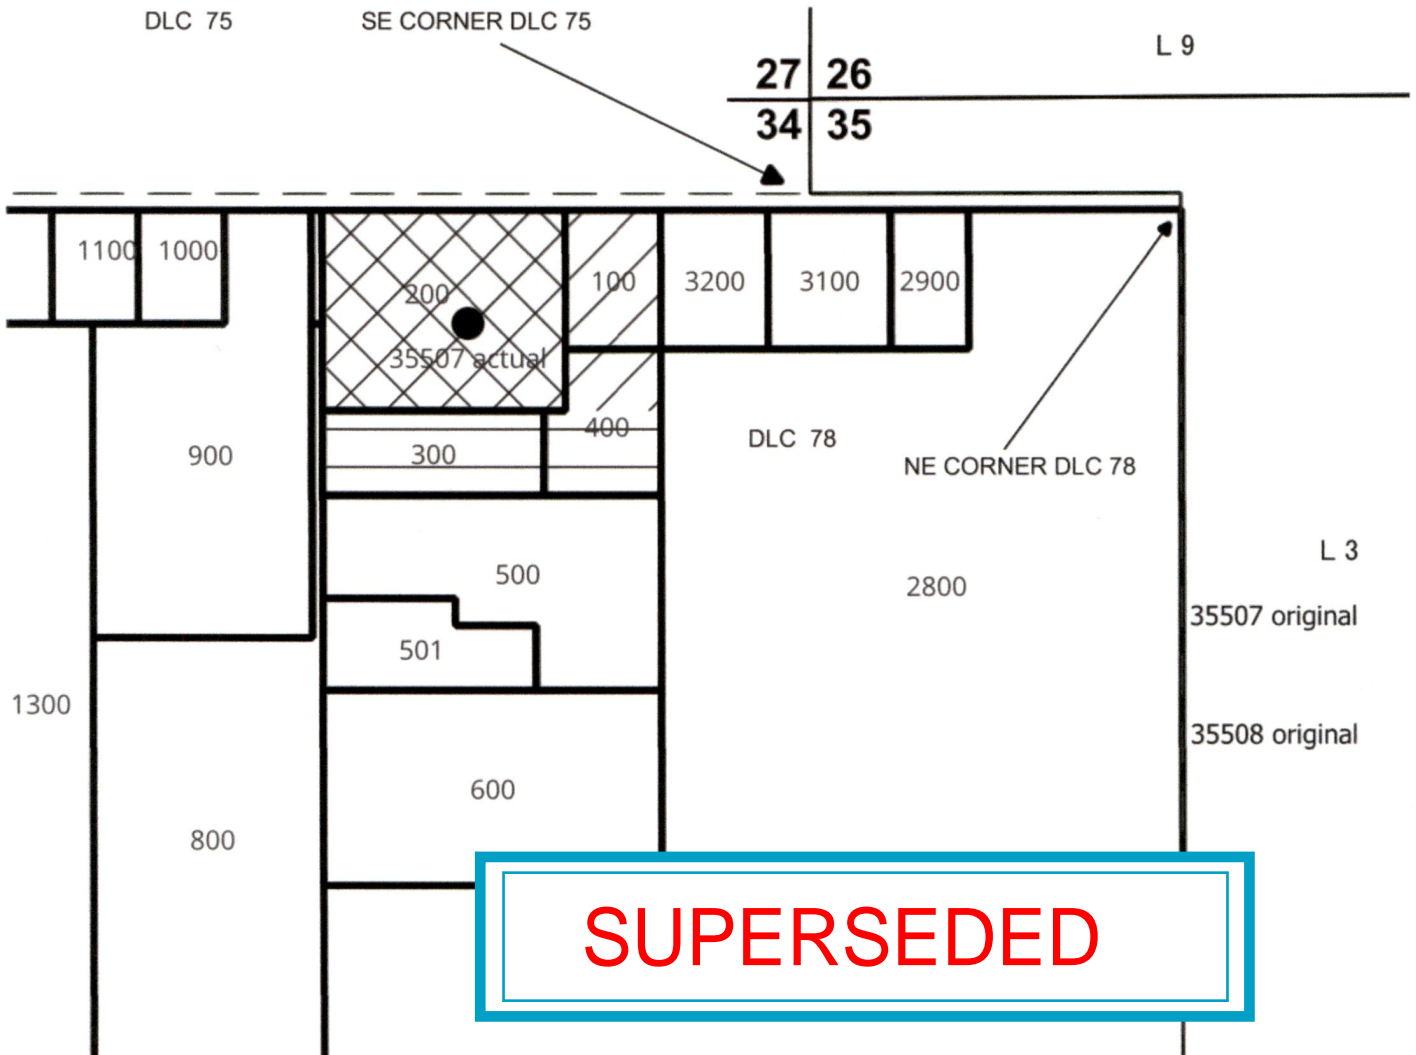

This map is not intended to provide legal dimensions or locations of property ownership lines

Pars
rick.p
541.4

14269 -