



EAST FORK IRRIGATION
— DISTRICT —
ODELL OREGON

3500 GRAVES RD – HOOD RIVER, OR 97031 | PH: (541) 354 – 1185 | P.O. BOX 162 – ODELL, OR 97044

July 23, 2024

RE: Final Proofs – Claim of Beneficial Use for T-~~13957~~ 14132

Ann Reece
Oregon Water Resources Department
725 Summer St NE, Suite A
Salem, OR 97031

Ann,

East Fork Irrigation District is submitting our claim of beneficial use for a permanent District transfer, T-14132, DINN 2022-1.

The District has inspected all included parcels to confirm that the changes have been made as mapped and contained in the final proof report.

Thank you in advance for your assistance with this.

Best regards,

Jaylene Hattig
Water Rights/GIS Specialist
East Fork Irrigation District

Received
JUL 29 2024
OWRD



Oregon Water Resources Department
725 Summer Street NE, Suite A
Salem, Oregon 97301-1266
(503) 986-0900
www.wrd.state.or.us

District Permanent Water Right Transfer Claim of Beneficial Use

1. APPLICANT INFORMATION

District: East Fork Irrigation District

Contact Person: Jaylene Hattig Phone: 541-354-1185

Mailing Address: P.O. Box 162

City: Odell State: OR Zip: 97044

E-Mail address: Jaylene@efidhr.org

Transfer Number: T - 14132

2. WATER RIGHT(S)

Pursuant to OAR Chapter 690, Division 385, the district is submitting to the Water Resources Department this claim of beneficial use, with the appropriate fee, for the following water right(s):

NOTE: Fees do not apply if the priority date is prior to July 9, 1987.

PERMIT NUMBER	CERTIFICATE NUMBER	DECREE (name, volume, and page)	PRIMARY (P) OR SUPP (S)
-	92000	Hood River Volume 17, Page 333	☒ P ☐ S
-	80929	Hood River Volume 17, Page 333	☒ P ☐ S
-	84803	Hood River Volume 17, Page 333	☒ P ☐ S
-			☐ P ☐ S

3. AUTHORIZED POINT(S) OF DIVERSION (POD) / APPROPRIATION (POA)

The authorized point(s) of diversion / appropriation for the water right modified by the transfer are as follows:

PERMIT NUMBER	DECREE or CERTIFICATE	POD / POA #	SOURCE	LOCATION – MEASURED DISTANCES
-	92000, 80929, 84803	1	East Fork Hood River	Being 3750 ft South and 430 ft East from the NW corner of Section 4
-				
-				
-				

92000

TABLE II. - PROPOSED PLACE OF USE

POD # or POA #	PRIORITY DATE	USE	LEGAL DESCRIPTION						ACRES	USER NAME	DINN
			TWP (N or S)	RNG (E or W)	SEC	QQ	DLC	GOV'T LOT			
1	11/25/1895	IR	1N	10E	15	SENW			0.20	Donald & Janohn Benefield	
1	11/25/1895	IR	1N	10E	15	NENW			0.20	Matt & Tricia Leininger	
1	11/25/1895	IR	1N	10E	15	SENW			0.50	Charles & Karrie Cantrell	
1	11/25/1895	IR	2N	10E	27A	NWNE			2.85	Norman Trejo Ramirez	
1	11/25/1895	IR	2N	10E	28	NENW			4.35	Jared & Kathryn Gidley	
									8.10		

6. SIGNATURES

The district certifies that it has inspected the place of use listed in Table I, and confirms the change in place of use has been completed consistent with the terms and conditions of the final order approving the transfer.



Signature of District Manager
or District Board Chairperson



Date

Steve Pappas

Type or Print Name of District Manager
or District Board Chairperson

Received
JUL 29 2024
OWRD

FINAL PROOF MAPS

T-14132

Received
JUL 29 2024
OWRD




HOOD RIVER COUNTY SEC 15 T01N R10E SCALE - 1" = 400'



SE 1/4 OF THE NW 1/4

OWRD T-14132

DIN-2021-01

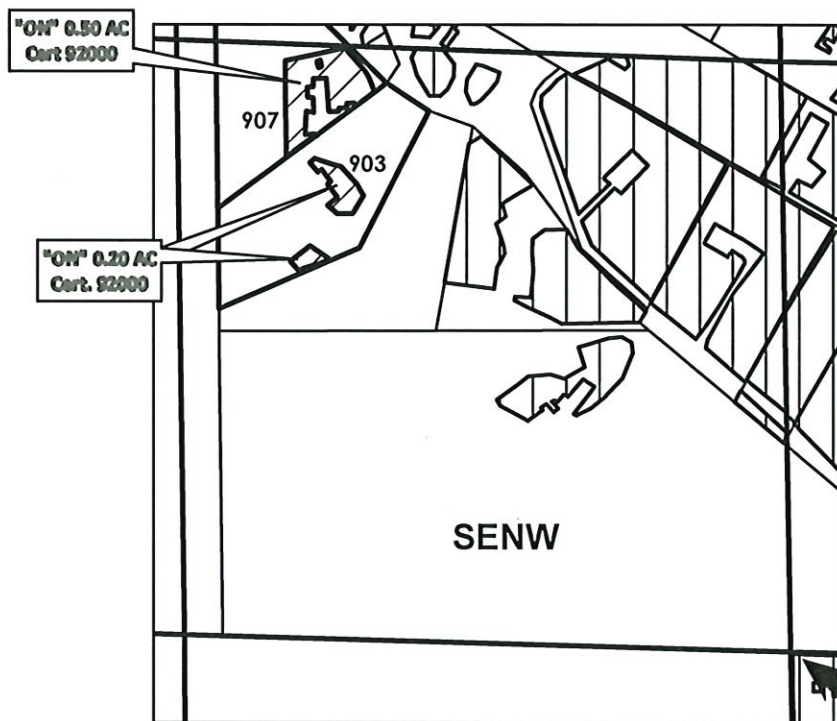

Received
JUL 29 2024
OWRD

C 1/4 COR

ON LAND CERT:
92000: 0.70 Ac

 ON LANDS
 EXISTING WATER RIGHTS

CLAIM OF BENEFICIAL USE MAP

DONALD & JANOHN BENEFIELD TAX LOT: 903 0.20 AC
CHARLES & TRICIA CANTRELL TAX LOT: 907 0.50 Ac




HOOD RIVER COUNTY
SEC. 15 T01N R10E
SCALE - 1" = 400'



NE 1/4 OF THE NW 1/4

T-14132

DIN-2022-1

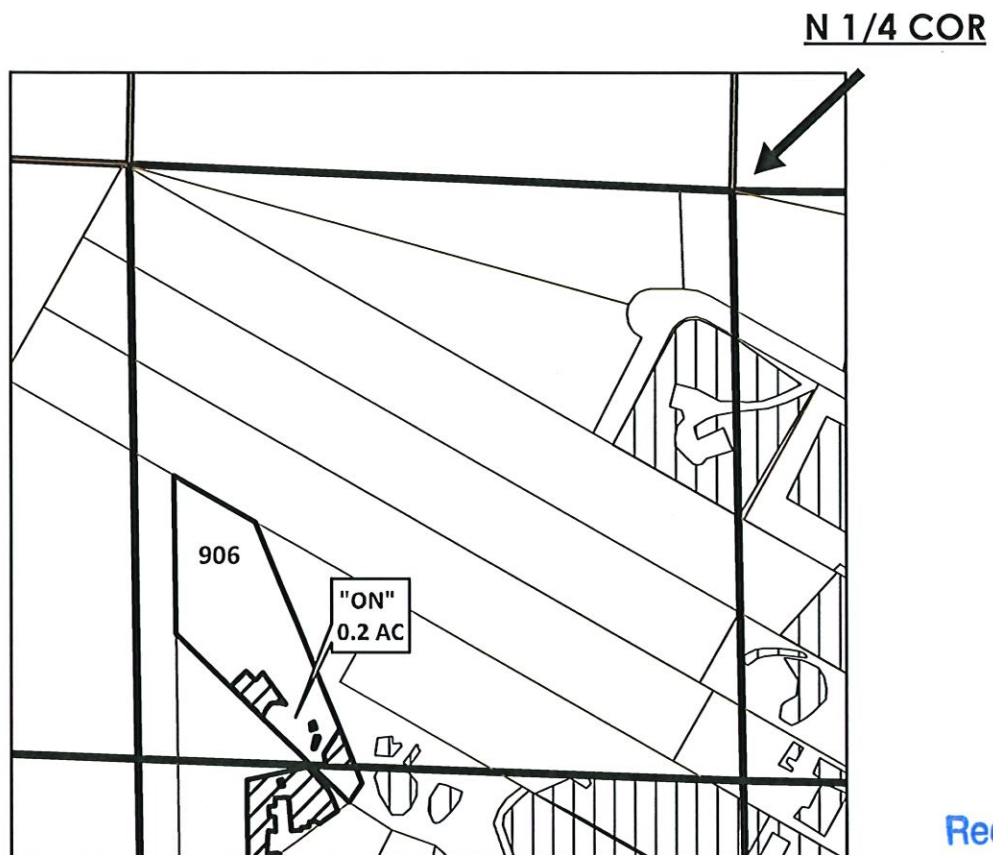

Received
JUL 29 2024
OWRD

	ON LANDS
	EXISTING WATER RIGHTS

CLAIM OF BENEFICIAL USE MAP
NAME: MATT & TRICIA LEININGER
TAX LOT: 906 0.2 ACRE

ON LANDS
CERT:
92000



HOOD RIVER COUNTY
SEC. 27 T02N R10E
SCALE - 1" = 400'




NW 1/4 OF THE NE 1/4

T-14132

DIN-2022-1

N 1/4 COR

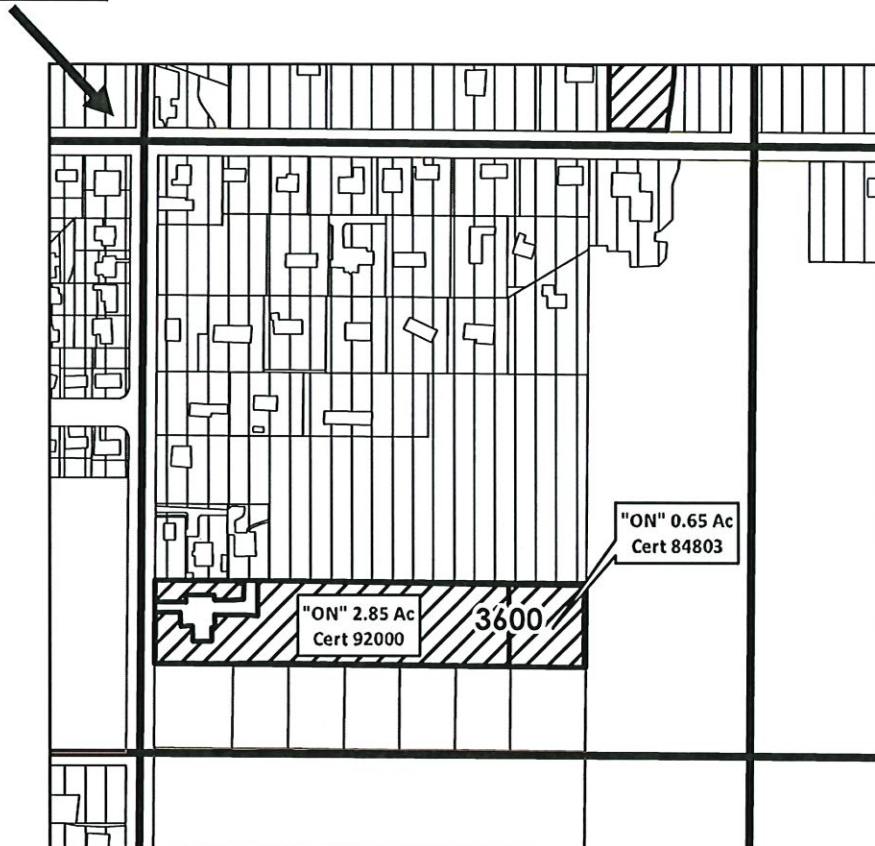

Received
JUL 29 2024
OWRD

	ON LANDS
	EXISTING WATER RIGHTS

CLAIM OF BENEFICIAL USE MAP
NAME: NORMAN TREJO RAMIREZ
TAX LOT: 3600 3.5 ACRE

ON LANDS
CERT:
92000: 2.85 AC
84803: 0.65 AC




HOOD RIVER COUNTY
SEC. 28 T02N R10E
SCALE - 1" = 400'



NE 1/4 OF THE NW 1/4

T-14132

DIN-2022-1

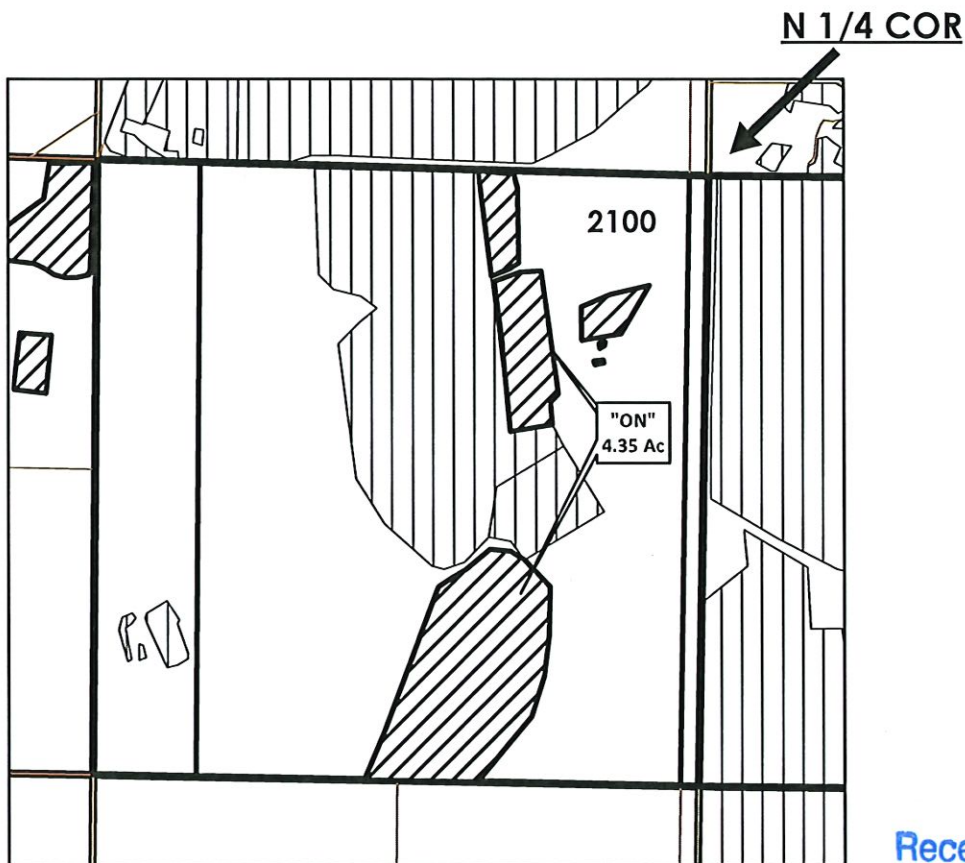

Received
JUL 29 2024
OWRD

	ON LANDS
	EXISTING WATER RIGHTS

CLAIM OF BENEFICIAL USE MAP
NAME: JARED R. & KATHRYN D. GIDLEY
TAX LOT: 2100 4.35 ACRE

ON LANDS
CERT:
92000:




HOOD RIVER COUNTY
SEC. 11 T01N R10E
SCALE - 1" = 400'



SE 1/4 OF THE NW 1/4

T-14132

DIN-2022-1

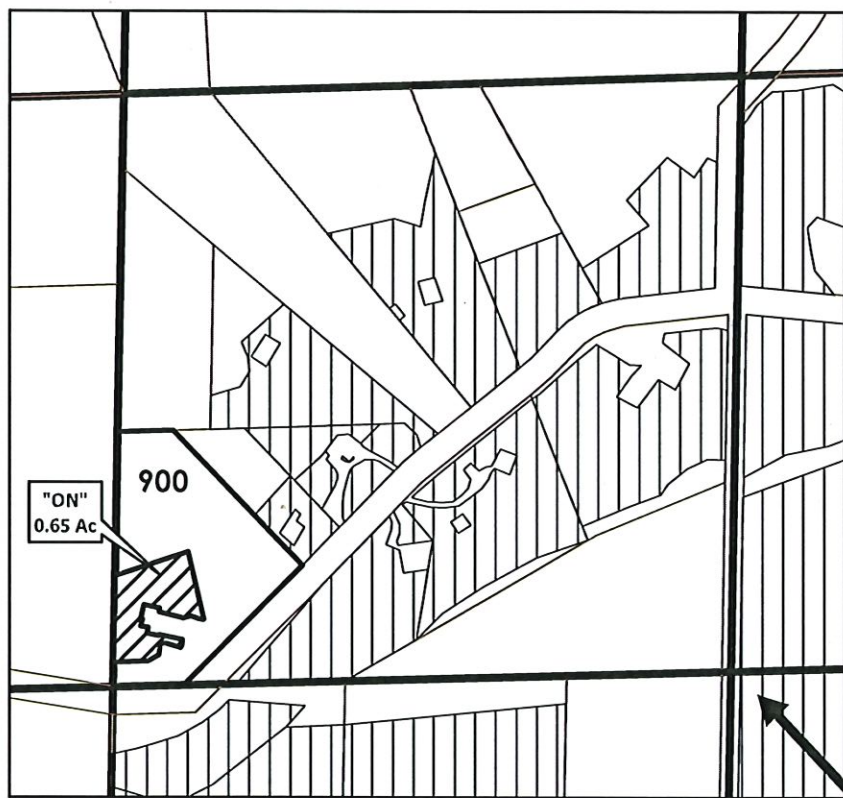

Received
JUL 29 2024
OWRD

C 1/4 COR

	ON LANDS
	EXISTING WATER RIGHTS

CLAIM OF BENEFICIAL USE MAP
NAME: SIMON & ESTELLA MUNOZ
TAX LOT: 900 0.65 ACRE

ON LANDS
CERT:
80929

**CLAIM OF BENEFICIAL USE
SITE REPORTS**

T-14132

Received
JUL 29 2024
OWRD



CLAIM OF BENEFICIAL USE Site Report

Transfer Number: T - 14132 District Internal Notice #: 2022-1

User Name: Donald & Janohn Benefield

Place of Use: 4355 KIM Dr.

USE	POD #	TWP	RNG	SEC	QQ	DLC	GOV'T LOT	TAX LOT	ACRES
IR	1	01N	10E	15	SEnw			903	0.20

District Conveyance System:

Description of Delivery System: pumping from EFID hookup

Headgate: EFID Headworks Canal: Bowcut Pipeline

Beneficial Use:

Description of Beneficial Use: garden, Landscape, various plants
Method Used to Apply Water: riser to hose & sprinkler

Method Used to Calculate Beneficial Use: Site Visit, GPS/GLS

User Interviewed: () Yes (X) No not home

Beneficial Use Made as Authorized: (X) Yes () No

Description of Beneficial Use if Less than Authorized:

Inspected By: [Signature] Date: 7/22/24

Instructions: Attach and label the corresponding final proof map.

Received

JUL 29 2024

OWRD



CLAIM OF BENEFICIAL USE Site Report

Transfer Number: T - 14132 District Internal Notice #: 2022-1

User Name: Charles and Karrie Cantrell

Place of Use: 4375 KIM DR.

USE	POD #	TWP	RNG	SEC	QQ	DLC	GOV'T LOT	TAX LOT	ACRES
IR	1	01N	10E	15	SE	W		907	0.50

District Conveyance System:

Description of Delivery System: pumping from EFID hookup to property

Headgate: EFID Headworks Canal: Bowcut Pipeline

Beneficial Use:

Description of Beneficial Use: Landscape : lawn, garden
Method Used to Apply Water: riser, hose : sprinkler.

Method Used to Calculate Beneficial Use: site visit, GPS/GIS

User Interviewed: ☒ Yes ☒ No

Beneficial Use Made as Authorized: ☒ Yes () No

Description of Beneficial Use if Less than Authorized:

Inspected By: Jylene Hattley Date: 7/22/24

Instructions: Attach and label the corresponding final proof map.

Received

JUL 29 2024

OWRD



CLAIM OF BENEFICIAL USE Site Report

Transfer Number: T - 14132 District Internal Notice #: 2022-1

User Name: Matt & Tricia Leininger

Place of Use: 4360 KIM DR.

USE	POD #	TWP	RNG	SEC	QQ	DLC	GOV'T LOT	TAX LOT	ACRES
IR	1	01N	10E	15	NENW			906	0.20

District Conveyance System:

Description of Delivery System: pumping from EFID takeout to property

Headgate: EFID Headworks Canal: Bowcut Pipeline

Beneficial Use:

Description of Beneficial Use: landscape, lawn, garden, tree
Method Used to Apply Water: riser to hose & sprinkler

Method Used to Calculate Beneficial Use: site visit GPS/GIS

User Interviewed: ☒ Yes () No

Beneficial Use Made as Authorized: ☒ Yes () No

Description of Beneficial Use if Less than Authorized:

Inspected By: [Signature]

Date: 7/22/24

Instructions: Attach and label the corresponding final proof map.

Received

JUL 29 2024

OWRD



CLAIM OF BENEFICIAL USE Site Report

Transfer Number: T - 14132 District Internal Notice #: 2022-1

User Name: Norman Trejo Ramirez

Place of Use: 3159 Wy'east Rd.

USE	POD #	TWP	RNG	SEC	QQ	DLC	GOV'T LOT	TAX LOT	ACRES
IR	1	02N	10E	27A	NWNE			3600	3.50

District Conveyance System:

Description of Delivery System: EFID hook up on property

Headgate: EFID Headworks Canal: Wy'east Rd. Line

Beneficial Use:

Description of Beneficial Use: pasture, hay

Method Used to Apply Water: hose and sprinklers on hand set.

Method Used to Calculate Beneficial Use: site visit

User Interviewed: () Yes (X) No

Beneficial Use Made as Authorized: (X) Yes () No

Description of Beneficial Use if Less than Authorized:

Inspected By: [Signature] Date: 7/22/27

Instructions: Attach and label the corresponding final proof map.

Received

JUL 29 2024

OWRD



CLAIM OF BENEFICIAL USE Site Report

Transfer Number: T - 14132 District Internal Notice #: 2022-1

User Name: Jared R. & Kathryn D. Gidley

Place of Use: 3050 Gilhouley Rd.

USE	POD #	TWP	RNG	SEC	QQ	DLC	GOV'T LOT	TAX LOT	ACRES
IR	1	02N	10E	28	NENW			2100	4.35

District Conveyance System:
Description of Delivery System: EFID hook up on property

Headgate: EFID Headworks Canal: Dukes Valley Canal

Beneficial Use:

Description of Beneficial Use: currently planted w/hay awaiting trees. Hand lines w/micro sprinklers.
Method Used to Apply Water:
Method Used to Calculate Beneficial Use: site visit, GPS/GIS

User Interviewed: ☒ Yes () No

Beneficial Use Made as Authorized: ☒ Yes () No

Description of Beneficial Use if Less than Authorized:

Inspected By: Jaylene Hattery

Date: 7/23/24

Received
JUL 29 2024

Instructions: Attach and label the corresponding final proof map.

OWRD



CLAIM OF BENEFICIAL USE Site Report

Transfer Number: T - 14132 District Internal Notice #: 2022-1

User Name: Simon & Estella Munoz

Place of Use: 5580 Neal Creek Rd

USE	POD #	TWP	RNG	SEC	QQ	DLC	GOV'T LOT	TAX LOT	ACRES
IR	1	01N	10E	11BD	SENW			900	0.65

District Conveyance System:
Description of Delivery System: 1" PVC line from EFID hookup

Headgate: EFID Headworks Canal: Christopher Pipeline

Beneficial Use:

Description of Beneficial Use: Shrubs, lawn, garden, trees
Method Used to Apply Water: rise w/hose & low impact sprinklers.

Method Used to Calculate Beneficial Use: site visit, GIS/GPS

User Interviewed: ☒ Yes () No

Beneficial Use Made as Authorized: ☒ Yes () No

Description of Beneficial Use if Less than Authorized:

Inspected By: 

Date: 7/22/24

Instructions: Attach and label the corresponding final proof map.

Received
JUL 29 2024

OWRD

SUPERSEDED

4. AUTHORIZED PLACE OF USE

The summary of the perfected change in place of use authorized by the final order approving the water right transfer is listed in Table 1.

[illegible]

MAP AND SITE REPORT

☒ Attached is a map and site report for each water right listed in Table 1 that satisfies the requirements of OAR 690-385-7400.

Received
JUL 29 2024
OWRD