

TALENT IRRIGATION DISTRICT

P.O. Box 467
104 W. Valley View Rd.
Talent OR 97540-0467



Phone: 541-535-1529
Fax: 541-535-4108
Email: tld@talentid.org
Web: www.talentid.org

CLAIM OF BENEFICIAL USE

Priority Mail

January 20, 2025

Ann Reece
Oregon Water Resources Department
725 Summer Street NE Suite A
Salem, OR 97301-1271

RE: Claim of Beneficial Use for T-13083

District Transfer Year: 2018

Dear Ann:

Enclosed is Talent Irrigation District's form entitled "District Permanent Water Right Transfer Claim of Beneficial Use" for your Transfer Number T-13083. Also enclosed are the "Claim of Beneficial Use Site Reports" and copies of the "To" land maps showing the new location of the water rights on each property. The following is a summary of the transfers listed with our internal file number and landowner name:

<u>TID FILE NO.</u>	<u>NAME</u>
12-4	Tim / Emily Johnson (Tischhauser)
15-1	Naumes, Inc.
15-2	Jeffrey / Stevana Anderson
15-3	Ellen Tuohey
15-4	Dunn Ranch, LLC (Manta Investments, LLC)
16-1	Soda Springs (Seven Generations)
17-2	John Giorgi Living Trust (Nicoya / James Grey Hecht)
17-3	Rsles-1 (Olson Holdings)
17-4	Jacob Parker (Alta Capital Group)
18-1	Rocky Robeson / Megan Kurz (Bast Tract 89, LLC)
18-2	Stiritz-Brellocks Revocable Living Trust (Kyrill / Ehlan Stiritz)
18-3	DRR Properties
18-3	Duane / Kelly Roberts Community Property Trust
18-4	Mel / Shiela Canal

Ann Reece


Page 2

The Site Reports are attached to each map and are signed by the District representative inspecting each property. Specific details about the properties are contained in each site report.

The District has inspected all of the above parcels to confirm that the changes have been made as mapped and contained in the final proof report.

I hereby certify the changes are completed as authorized and that each property has met their Claim of Beneficial Use as mapped.

I am authorized to sign on behalf of Talent Irrigation District.

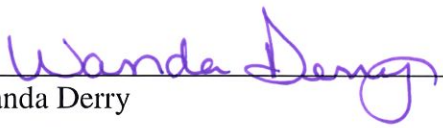

Wanda Derry
Manager
Talent Irrigation District

Date: 1-20-2025

Enclosures



Oregon Water Resources Department
725 Summer Street NE, Suite A
Salem, Oregon 97301-1266
(503) 986-0900
www.wrd.state.or.us

District Permanent Water Right Transfer Claim of Beneficial Use

1. APPLICANT INFORMATION

District: Talent Irrigation District District Transfer Year: 2018
Contact Person: Wanda Derry, Manager Phone: 541-535-1529
Mailing Address: PO Box 467
City: Talent State: OR Zip: 97540
E-Mail address: tid@talentid.org
Transfer Number: T - 13083

2. WATER RIGHT(S)

Pursuant to OAR Chapter 690, Division 385, the district is submitting to the Water Resources Department this claim of beneficial use, with the appropriate fee, for the following water right(s):
NOTE: Fees do not apply if the priority date is prior to July 9, 1987.

PERMIT NUMBER	CERTIFICATE NUMBER	DECREE (name, volume, and page)	PRIMARY (P) OR SUPP (S)
-	83727		☒ P ☒ S
-	79212		☒ P ☒ S
-			☐ P ☐ S
-			☐ P ☐ S

3. AUTHORIZED POINT(S) OF DIVERSION (POD) / APPROPRIATION (POA)

The authorized point(s) of diversion / appropriation for the water right modified by the transfer are as follows:

PERMIT NUMBER	DECREE or CERTIFICATE	POD / POA #	SOURCE	LOCATION – MEASURED DISTANCES
-	79212			SEE ATTACHED POD CERTIFICATE TABLE
-	83727			SEE ATTACHED POD CERTIFICATE TABLE
-				
-				

E-RECEIVED
1/21/2025
WRD

4. AUTHORIZED PLACE OF USE

The summary of the perfected change in place of use authorized by the final order approving the water right transfer is listed in Table 6WRD

*Wherever primary irrigation (IR) is being perfected under C 79212, supplemental irrigation is also being perfected under C 83727 (IS)

TABLE 1 - AUTHORIZED PLACE OF USE (POU)													
CERTIFICATE DECREE or PERMIT	DIN #	POD / POA #	PRIORITY DATE	USE	LEGAL DESCRIPTION						TAX LOT	ACRES	USER NAME
					TWP	RNG	SEC	QQ	DLC	GOV'T LOT			
79212	12-4	ALL	5/23/1912	IR	40S	2E	5	NE SE			102	2.00	Tim/Emily Johnson (Mary Tischhauser)
83727	12-4	ALL	9/16/1915	IS	40S	2E	5	NE SE			102	2.00	Tim/Emily Johnson (Mary Tischhauser)
83727	15-1	ALL	9/16/1915	IR	38S	1W	24	NE SW		5	100	3.34	Naumes, Inc.
83727	15-1	ALL	9/16/1915	IR	38S	1W	24	NW SE		6	100	4.82	Naumes, Inc.
83727	15-1	ALL	9/16/1915	IR	38S	1E	19	NE SW		9	200	1.20	Naumes, Inc.
83727	15-1	ALL	9/16/1915	IR	38S	1E	19	NW SW		10	200	9.37	Naumes, Inc.
79212	15-2	ALL	5/23/1912	IR	38S	1W	18	NW NW		4	1001	1.67	Jeffrey A./Stevana L. Anderson
83727	15-2	ALL	9/16/1915	IS	38S	1W	18	NW NW		4	1001	1.67	Jeffrey A./Stevana L. Anderson
79212	15-3	ALL	5/23/1912	IR	38S	1W	14	SW NE			1501	1.06	Ellen Tuohey
83727	15-3	ALL	9/16/1915	IS	38S	1W	14	SW NE			1501	1.06	Ellen Tuohey
79212	15-3	ALL	5/23/1912	IR	38S	1W	14	SE NE			1507	3.44	Ellen Tuohey
83727	15-3	ALL	9/16/1915	IS	38S	1W	14	SE NE			1507	3.44	Ellen Tuohey
79212	15-4	ALL	5/23/1912	IR	39S	2E	19	NW NW	40		300	2.60	Dunn Ranch LLC (Manta Investments)
83727	15-4	ALL	9/16/1915	IS	39S	2E	19	NW NW	40		300	2.60	Dunn Ranch LLC (Manta Investments)
79212	15-4	ALL	5/23/1912	IR	39S	2E	19	SW NW	40		300	2.30	Dunn Ranch LLC (Manta Investments)
83727	15-4	ALL	9/16/1915	IS	39S	2E	19	SW NW	40		300	2.30	Dunn Ranch LLC (Manta Investments)
79212	16-1	ALL	5/23/1912	IR	39S	2E	35	SW SW			300	1.90	Soda Springs (Seven Generations)
83727	16-1	ALL	9/16/1915	IS	39S	2E	35	SW SW			300	1.90	Soda Springs (Seven Generations)
83727	16-1	ALL	9/16/1915	IR	39S	2E	35	SW SW			300	1.10	Soda Springs (Seven Generations)
83727	16-1	ALL	9/16/1915	IR	39S	2E	35	SE SW			300	.70	Soda Springs (Seven Generations)
83727	16-1	ALL	9/16/1915	IR	40S	2E	02	NE NW		3	500	.85	Soda Springs (Seven Generations)
83727	16-1	ALL	9/16/1915	IR	40S	2E	02	NE NW		3	102	3.28	Soda Springs (Seven Generations)
83727	16-1	ALL	9/16/1915	IR	40S	2E	02	SE NW			102	2.17	Soda Springs (Seven Generations)
79212	17-2	ALL	5/23/1912	IR	38S	1W	28	SW SE			2400	1.20	John Giorgi Liv Tr (N/J G Hecht)
83727	17-2	ALL	9/16/1915	IS	38S	1W	28	SW SE			2400	1.20	John Giorgi Liv Tr (N/J G Hecht)
79212	17-3	ALL	5/23/1912	IR	38S	1E	32	SW NW	48		501	12.20	Rsles-1 (Olson Holdings)
83727	17-3	ALL	9/16/1915	IS	38S	1E	32	SW NW	48		501	12.20	Rsles-1 (Olson Holdings)
83727	17-3	ALL	9/16/1915	IR	38S	1E	32	SW NW	48		501	3.40	Rsles-1 (Olson Holdings)
79212	17-4	ALL	5/23/1912	IR	38S	1W	20	NE SE			1800	2.07	Jacob Parker (Alta Capital Group)
83727	17-4	ALL	9/16/1915	IS	38S	1W	20	NE SE			1800	2.07	Jacob Parker (Alta Capital Group)
79212	17-4	ALL	5/23/1912	IR	38S	1W	20	NW SE			1800	5.01	Jacob Parker (Alta Capital Group)
83727	17-4	ALL	9/16/1915	IS	38S	1W	20	NW SE			1800	5.01	Jacob Parker (Alta Capital Group)

83727	18-1	ALL	9/16/1915	IR	38S	2W	10	SE SE	48		2800	3.00	Rocky Robeson/Megan Kurz (Bast Tract 89 LLC)
79212	18-2	ALL	5/23/1912	IR	39S	2E	34	SW NW			400	.50	Stirtz-Brellochs Rev Liv Tr (Kyrill B/Ehlan R Stirtz)
83727	18-2	ALL	9/16/1915	IS	39S	2E	34	SW NW			400	.50	Stirtz-Brellochs Rev Liv Tr (Kyrill B/Ehlan R Stirtz)
83727	18-3	ALL	9/16/1915	IR	39S	2E	18	NW NW			300	7.83	DRR Properties
83727	18-3	ALL	9/16/1915	IR	39S	2E	18	NW SE			300	8.78	DRR Properties
83727	18-3	ALL	9/16/1915	IR	39S	2E	18	SE NW			303	.20	DRR Properties
83727	18-3	ALL	9/16/1915	IR	39S	2E	18	NW SE			302	1.60	Duane/Kelly Roberts Community Prop Tr
79212	18-4	ALL	5/23/1912	IR	38S	1E	29	SW SW	45		6400	.20	Mel/Shiela Canal
83727	18-4	ALL	9/16/1915	IS	38S	1E	29	SW SW	45		6400	.20	Mel/Shiela Canal
TOTAL											123.94		



5. MAP AND SITE REPORT

☒ Attached is a map and site report for each water right listed in Table 1 that satisfies the requirements of OAR 690-385-7400.

6. SIGNATURES

The district certifies that it has inspected the place of use listed in Table I, and confirms the change in place of use has been completed consistent with the terms and conditions of the final order approving the transfer.

Wanda Derry
Signature of District Manager
or District Board Chairperson

1-20-2025
Date

Wanda Derry
Type or Print Name of District Manager
or District Board Chairperson

Certificate 79212: Authorized Sources, Tributaries (Trib.), Priority Dates and description of Points of Diversion:

Source	Trib.	Priority Date	Twp	Rng	Mer	Sec	Q-Q	Measured Distances/Description
Emigrant Creek	Bear Creek	05/23/1912	39 S	2 E	WM	20	SE SE	POINT OF DIVERSION IS LOCATED AT THE TOE OF EMIGRANT DAM
McDonald Creek	Little Applegate River	08/20/1915	40 S	1 W	WM	10	SE SE	INTO MCDONALD CREEK CANAL; 700 FEET NORTH AND 300 FEET WEST FROM THE SE CORNER OF SECTION 10
Greeley Creek	Little Applegate River	08/20/1915	40 S	1 W	WM	3	NW SE	INTO MCDONALD CREEK CANAL; 2400 FEET NORTH AND 2300 FEET WEST FROM THE SE CORNER OF SECTION 3
Bear Creek	Rogue River	07/31/1915	38 S	1 E	WM	33	SE SW	OAK STREET DAM; 150 FEET NORTH AND 2020 FEET EAST FROM THE SW CORNER OF SECTION 33
Neil Creek	Bear Creek	07/31/1915	39 S	2 E	WM	30	SE SW	ASHLAND LATERAL; 600 FEET NORTH AND 1350 FEET EAST FROM THE SW CORNER OF SECTION 30
Ashland Creek	Bear Creek	07/31/1915	39 S	1 E	WM	4	NE NW	710 FEET SOUTH AND 2000 FEET EAST FROM THE NW CORNER OF SECTION 4
Emigrant Creek	Bear Creek	07/31/1915	40 S	2 E	WM	2	SW NE	ASHLAND LATERAL; 520 FEET NORTH AND 1900 FEET WEST FROM THE E1/4 CORNER OF SECTION 2
Wagner Creek	Bear Creek	07/31/1915	39 S	1 W	WM	2	SW SE	UPPER WEST LATERAL; 100 FEET NORTH AND 1800 FEET WEST FROM THE SE CORNER OF SECTION 2
Wagner Creek	Bear Creek	07/31/1915	38 S	1 W	WM	35	SE SW	WEST LATERAL; 600 FEET NORTH AND 3600 FEET WEST FROM THE SE CORNER OF SECTION 35
Anderson Creek	Bear Creek	07/31/1915	38 S	1 W	WM	33	NE SE	2100 FEET NORTH AND 600 FEET WEST FROM THE SE CORNER OF SECTION 33
Anderson Creek	Bear Creek	07/31/1915	38 S	1 W	WM	34	NE NW	WEST LATERAL; 800 FEET SOUTH AND 2400 FEET EAST FROM THE NW CORNER OF SECTION 34
Anderson Creek	Bear Creek	07/31/1915	38 S	1 W	WM	27	NE NW	TALENT MIDDLE CANAL; 4000 FEET NORTH AND 2500 FEET EAST FROM THE SW CORNER OF SECTION 27
Coleman Creek	Bear Creek	09/06/1915	38 S	1W	WM	20	SE NW	2100 FEET SOUTH AND 1500 FEET EAST FROM THE NW CORNER OF SECTION 20
Coleman Creek	Bear Creek	09/06/1915	38 S	1 W	WM	17	SE SE	TALENT MIDDLE CANAL; 900 FEET NORTH AND 1100 FEET WEST FROM THE SE CORNER OF SECTION 17
Kenutchen Creek (Knudsen Creek)	Bear Creek	09/06/1915	38 S	1 E	WM	18	SW NW	1450 FEET SOUTH AND 700 FEET EAST FROM THE NW CORNER OF SECTION 18

Source	Trib.	Priority Date	Twp	Rng	Mer	Sec	Q-Q	Measured Distances/Description
Meyers Creek (Myers Creek)	Bear Creek	09/06/1915	38 S	1 E	WM	20	SE SE	700 FEET NORTH AND 20 FEET WEST FROM THE SE CORNER OF SECTION 20
Butler Creek	Bear Creek	09/06/1915	38 S	1 E	WM	28	SE NW	2500 FEET SOUTH AND 2000 FEET EAST FROM THE NW CORNER OF SECTION 28
Keene Creek and Keene Creek Reservoir (Hyatt Reservoir)	Jenny Creek	05/23/1912	--	--	--	--	--	SOURCES ARE TRIBUTARIES OF JENNY CREEK IN THE KLAMATH RIVER BASIN. LIMITED TO 100 CFS
Keene Creek	Jenny Creek	09/06/1915	39 S	3 E	WM	16	SE SE	HYATT RESERVOIR; 15 FEET NORTH AND 1200 FEET WEST FROM THE SE CORNER OF SECTION 16
Keene Creek	Jenny Creek	09/06/1915	39 S	3 E	WM	20	SE SE	REDIVERSION-LITTLE HYATT POOL DIVERSION; 800 FEET NORTH AND 750 FEET WEST FROM THE SE CORNER OF SECTION 20
Keene Creek	Jenny Creek	09/06/1915	39 S	3 E	WM	33	SW SW	REDIVERSION AT KEENE CREEK DIVERSION DAM (beginning point of Green Springs Tunnel); 1200 FEET NORTH AND 1200 FEET EAST FROM THE SW CORNER OF SECTION 33
Emigrant Reservoir	Emigrant Creek	01/27/1920	39 S	2 E	WM	20	SE SE	POINT OF DIVERSION IS LOCATED AT THE TOE OF EMIGRANT DAM

Certificate 83727: Authorized Sources, Tributaries (Trib.), and description of Points of Diversion:

Source	Tributary	Twp	Rng	Mer	Sec	Q-Q	Measured Distances
Emigrant Creek and Emigrant Reservoir	Bear Creek	39 S	2 E	WM	20	SE SE	The point of diversion is located at the outlet of Emigrant Reservoir.
South Fork Little Butte Creek	Little Butte Creek	37 S	4 E	WM	16	SE SE	1240 FEET NORTH AND 1100 FEET WEST FROM THE SE1/4 CORNER OF SECTION 16
Conde Creek	South Fork Little Butte Creek	38 S	3 E	WM	9	SW SW	1320 FEET NORTH AND 600 FEET EAST FROM THE SW CORNER OF SECTION 9
Dead Indian Creek	South Fork Little Butte Creek	38 S	3 E	WM	15	SE SW	1310 FEET NORTH AND 1100 FEET WEST FROM THE SOUTH ¼ CORNER OF SECTION 15
Daley Creek	South Fork Little Butte Creek	37 S	4 E	WM	34	SW SE	750 FEET NORTH AND 480 FEET EAST FROM THE SOUTH ¼ CORNER OF SECTION 34
Beaver Dam Creek	South Fork Little Butte Creek	38 S	4 E	WM	4	NE SW	2000 FEET NORTH AND 1800 FEET EAST FROM THE SW CORNER OF SECTION 4
Pole Bridge Creek	South Fork Little Butte Creek	37 S	4 E	WM	28	SE NW	1380 FEET SOUTH AND 2000 FEET EAST FROM THE NW CORNER OF SECTION 28
Deadwood Creek	South Fork Little Butte Creek S	38 S	4 E	WM	6	NE SE	Not specified on certificate.
Keene Creek and Keene Creek Reservoir	Jenny Creek	39 S	3 E	WM	16	SE SE	HYATT RESERVOIR; 15 FEET NORTH AND 1200 FEET WEST FROM THE SE CORNER OF SECTION 16
Keene Creek and Keene Creek Reservoir	Jenny Creek	39 S	3 E	WM	20	SE SE	REDIVERSION AT LITTLE HYATT POOL DIVERSION; 800 FEET NORTH AND 750 FEET WEST FROM THE SE CORNER OF SECTION 20
Keene Creek and Keene Creek Reservoir	Jenny Creek	39 S	3 E	WM	33	SW SW	KEENE CREEK DIVERSION DAM (beginning of Green Springs Tunnel); 1200 FEET NORTH AND 1200 FEET EAST FROM THE SW CORNER OF SECTION 33
Grizzly Creek and Howard Prairie Reservoir	Jenny Creek	38 S	4 E	WM	32	E1/2 of SW1/4	Not specified on certificate
Soda Creek	Grizzly Creek	39 S	4 E	WM	8	SW NW	2200 FEET SOUTH AND 60 FEET EAST FROM THE NW CORNER OF SECTION 8
Little Beaver Creek	Jenny Creek	39 S	4 E	WM	19	SE SW	600 FEET NORTH AND 1930 FEET EAST FROM THE SW CORNER OF SECTION 19

CLAIM OF BENEFICIAL USE Site Report

Transfer Number: **T-13083**

District Internal Notice #: **12-4**

User Name: Tim / Emily Johnson
(Mary Tischhauser)

Phone: 541-499-2244

Property: 1688 Old Hwy 99 S, Ashland, OR 97520

Place of Use:

USE	POD #	TWP	RNG	SEC	QQ	DLC	GOV'T LOT	TAX LOT	ACRES
IR	ALL	40S	2E	05	NE SE			102	2.00

TOTAL ACRES = 2.00

District Conveyance System:

Description of Delivery System: Private pump station and private pipeline

Headgate: None Canal: Ashland Canal

Beneficial Use:

Description of Beneficial Use: Lawn & Landscaping

Method Used to Apply Water: Sprinkler irrigated. The water use is metered.

Method Used to Calculate Beneficial Use: Ariel Map Verification 7/5/24 HH

User Interviewed: () Yes (x) No

Beneficial Use Made as Authorized: (x) Yes () No

Description of Beneficial Use if Less than Authorized:

None

Inspected By: Shane D. Brown Date: 1/16/2025

Instructions: Attach and label the corresponding final proof map.

JACKSON COUNTY
SEC. 05 T40S R2E

SCALE - 1" = 400'



E-RECEIVED



1/21/2025

OWRD

T-13083

NE 1/4 OF THE SE 1/4

DIN 12-04

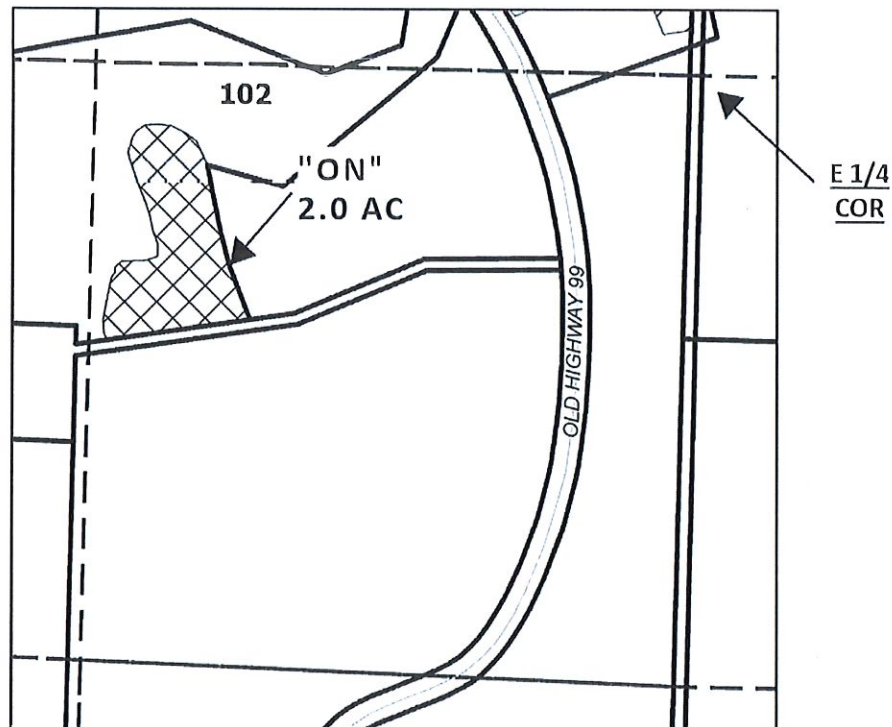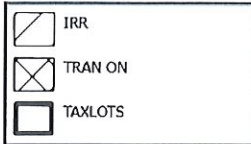

EXISTING RIGHTS
CERTIFICATE #:
79212 (IR): 0.0 AC
83727 (IS): 0.0 AC



DATE: 12/20/24

CLAIM OF BENEFICIAL USE MAP

NAME: TIM AND EMILY JOHNSON
TAXLOT# 102
NESE 2.0 AC

ON LANDS
CERTIFICATE #:
79212 (IR) 2.0 AC
83727 (IS) 2.0 AC

This map is not intended to provide legal dimensions
or locations of property ownership lines

CLAIM OF BENEFICIAL USE Site Report

Transfer Number: T-13083 District Internal Notice #: 15-1
 User Name: Naumes Phone: 541-941-2252
 Property: 1912/1950 Suncrest Rd., Talent, OR 97540

Place of Use:

USE	POD #	TWP	RNG	SEC	QQ	DLC	GOV'T LOT	TAX LOT	ACRES
IR	ALL	38S	1W	24	NE SW		5	100	3.34
IR	ALL	38S	1W	24	NW SE		6	100	4.82
IR	ALL	38S	1E	19	NE SW		9	200	1.20
IR	ALL	38S	1E	19	NW SW		10	200	9.37

TOTAL ACRES = 18.73

District Conveyance System:

Description of Delivery System: E-5 Butler Creek Private Pump Station on Upper East Canal

Headgate: None Canal: Upper East Main Canal

Beneficial Use:

Description of Beneficial Use: Vineyard
 Method Used to Apply Water: Drip irrigated. The water use is metered.
 Method Used to Calculate Beneficial Use: Ariel Map Verification 6/14/24 HH
 User Interviewed: () Yes (x) No
 Beneficial Use Made as Authorized: (x) Yes () No

Description of Beneficial Use if Less than Authorized:

None

Inspected By: Shane D. Burns Date: 7/8/2024

Instructions: Attach and label the corresponding final proof map.

**JACKSON COUNTY
SEC. 24 T38S R1W**

OWRD E-RECEIVED
02/19/2025
AMENDED



SCALE - 1" = 400'



NE 1/4 OF THE SW 1/4; NW 1/4 OF THE SE 1/4

T-13083

DIN-15-01

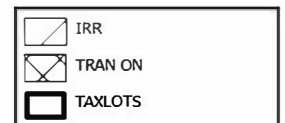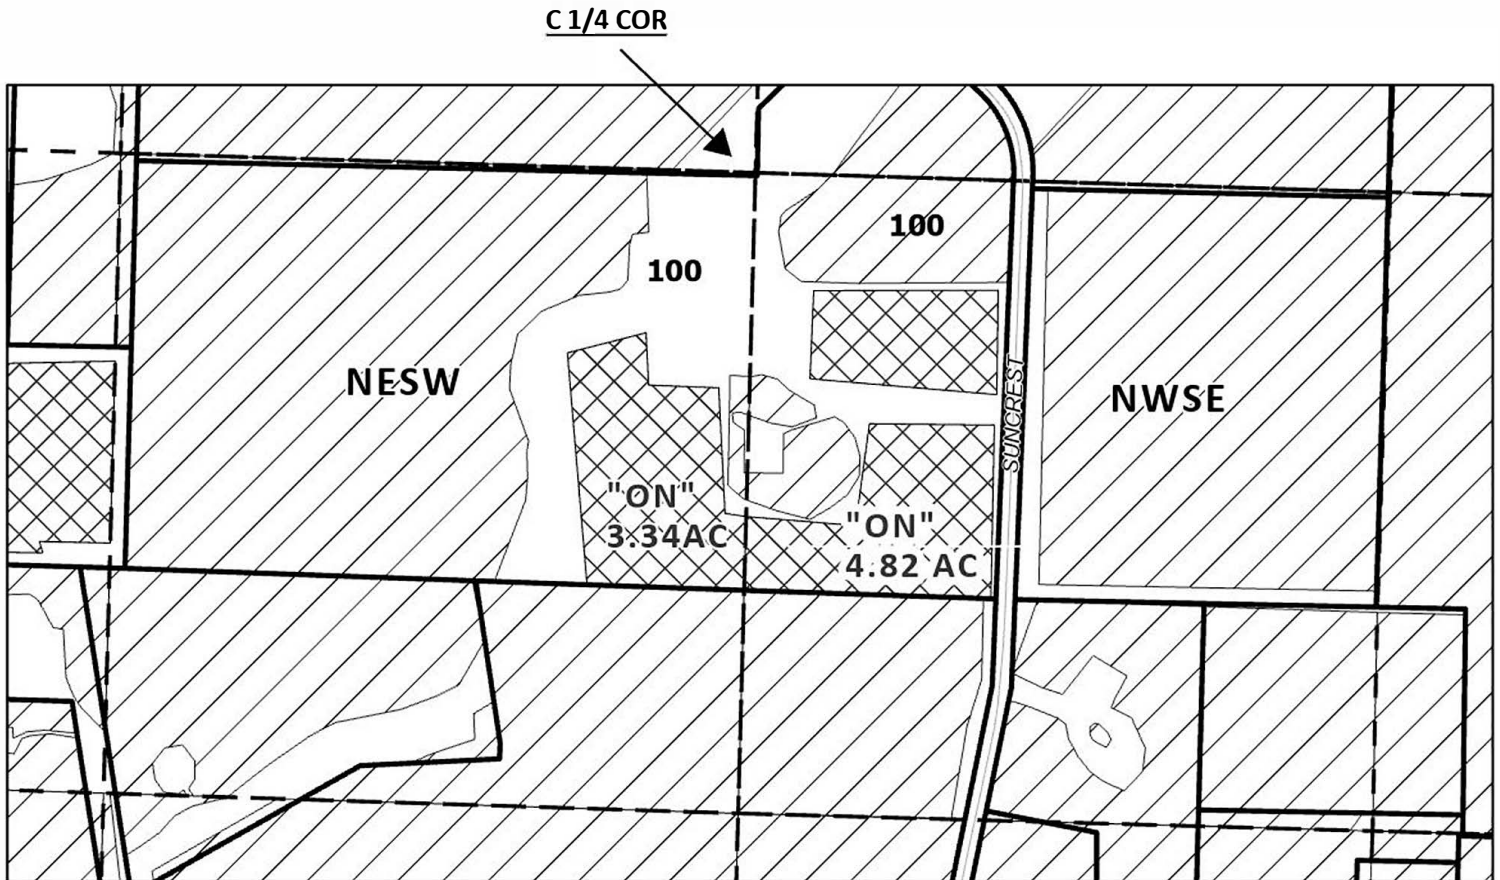

CLAIM OF BENEFICIAL USE MAP

NAME: NAUMES
TAXLOT #: 100 8.16 AC
NESW 3.34 AC
NWSE 4.82 AC

CERTIFICATE
#: 83727 (IR)

**JACKSON COUNTY
SEC. 19 T38S R1E**

SCALE - 1" = 400'





OWRD E-RECEIVED
02/19/2025
AMENDED

NW 1/4 OF THE SW 1/4; NE 1/4 OF THE SW 1/4

T-13083

DIN-15-01

W 1/4 COR

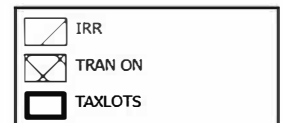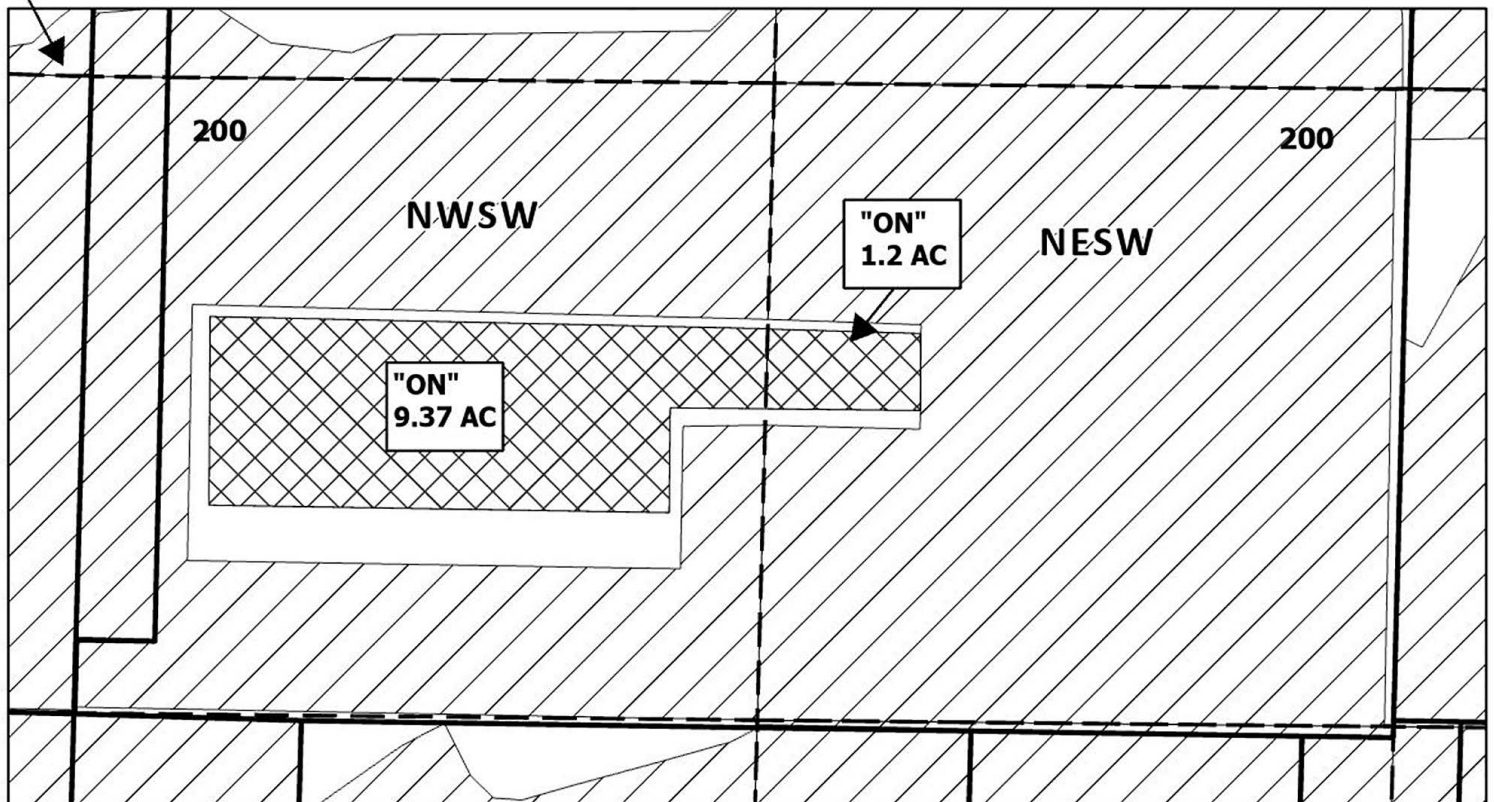

CLAIM OF BENEFICIAL USE MAP

NAME: NAUMES, INC
TAXLOT #: 200 10.57 AC
NESW 1.2 AC
NWSW 9.37 AC

CERTIFICATE #:
83727 (IR)

REV: 02/18/25

CLAIM OF BENEFICIAL USE Site Report

Transfer Number: T-13083 District Internal Notice #: 15-2
 User Name: Jeffrey A. / Stevana L. Anderson Phone: 541-944-6928
 Property: 4868 Pioneer Rd., Medford, OR 97501

Place of Use:

USE	POD #	TWP	RNG	SEC	QQ	DLC	GOV'T LOT	TAX LOT	ACRES
IR	ALL	38S	1W	18	NW NW		4	1001	1.67

TOTAL ACRES = 1.67

District Conveyance System:

Description of Delivery System: Private pump station on the West Canal
 Headgate: None Canal: West Canal

Beneficial Use:

Description of Beneficial Use: Lawn & Landscape
 Method Used to Apply Water: Sprinkler irrigated. The water use is metered.
 Method Used to Calculate Beneficial Use: Ariel Map Verification 7/5/24 HH
 User Interviewed: () Yes (x) No
 Beneficial Use Made as Authorized: (x) Yes () No

Description of Beneficial Use if Less than Authorized:

None

Inspected By: Shane D. Burns Date: 2/8/2024

Instructions: Attach and label the corresponding final proof map.

**JACKSON COUNTY
SEC. 18 T38S R1W**

E-RECEIVED
1/21/2025
OWRD


SCALE - 1" = 400'




NW 1/4 OF THE NW 1/4

T-13083

DIN-15-02

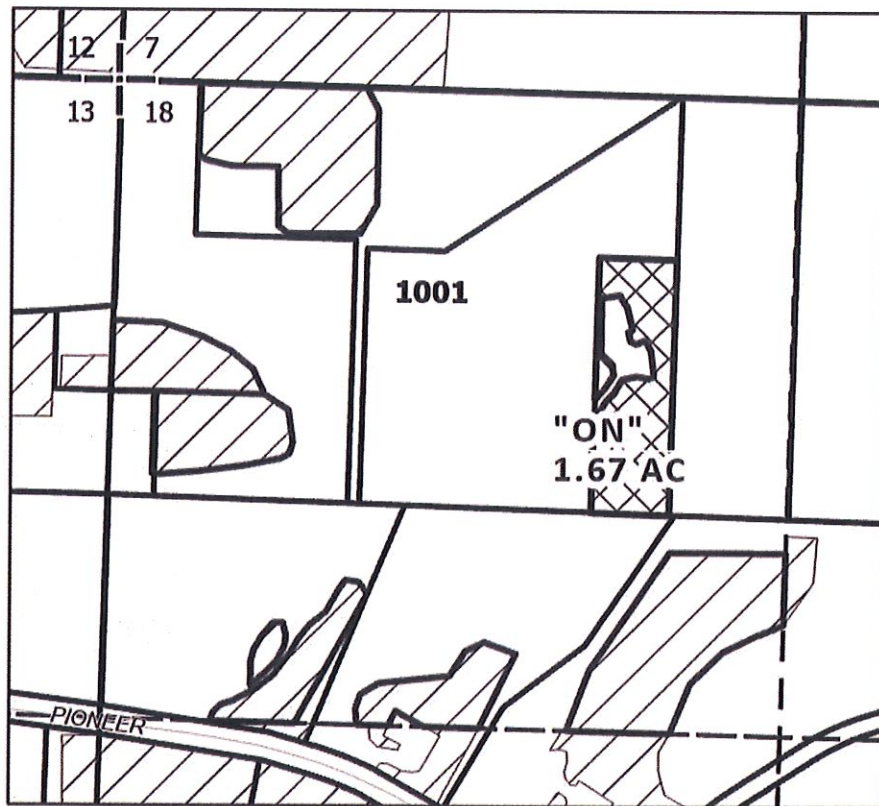

EXISTING RIGHTS
CERTIFICATE #:
79212 (IR): 4.7 AC
83727 (IS): 4.7 AC
83727 (IR): 2.83 AC

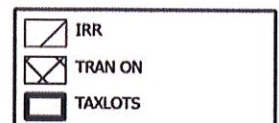

CLAIM OF BENEFICIAL USE MAP

NAME: JEFFREY A. / STEVANA L. ANDERSON
TAXLOT #: 1001 1.67 AC

ON LANDS
CERTIFICATE #:
79212 (IR)
83727 (IS)

CLAIM OF BENEFICIAL USE Site Report

Transfer Number: T-13083 District Internal Notice #: 15-3

User Name: Ellen Tuohey Phone: 541-261-9615

Property: 4234 Payne Rd. Medford, OR 97504

Place of Use:

	POD						GOV'T		
USE	#	TW P	RNG	SEC	QQ	DLC	LOT	TAX LOT	ACRES
IR	ALL	38S	1W	14	SW NE			1501	1.06
IR	ALL	38S	1W	14	SE NE			1507	3.44

TOTAL ACRES = 4.5

District Conveyance System:

Description of Delivery System: E-14 Private Pump station on the Lower East Canal

Headgate: None Canal: Lower East Main Canal

Beneficial Use:

Description of Beneficial Use: Pasture

Method Used to Apply Water: Sprinkler irrigated. The water use is metered.

Method Used to Calculate Beneficial Use: Ariel Map Verification 6/14/24 HH

User Interviewed: () Yes (x) No

Beneficial Use Made as Authorized: (x) Yes () No

Description of Beneficial Use if Less than Authorized:

None

Inspected By: Sharon L. Burns Date: 7/8/2024

Instructions: Attach and label the corresponding final proof map.

**JACKSON COUNTY
SEC. 14 T38S R1W**

OWRD E-RECEIVED

02/19/2025

AMENDED


SCALE - 1" = 400'



SW 1/4 OF THE NE 1/4; SE 1/4 OF THE NE 1/4

T-13083

DIN-15-03

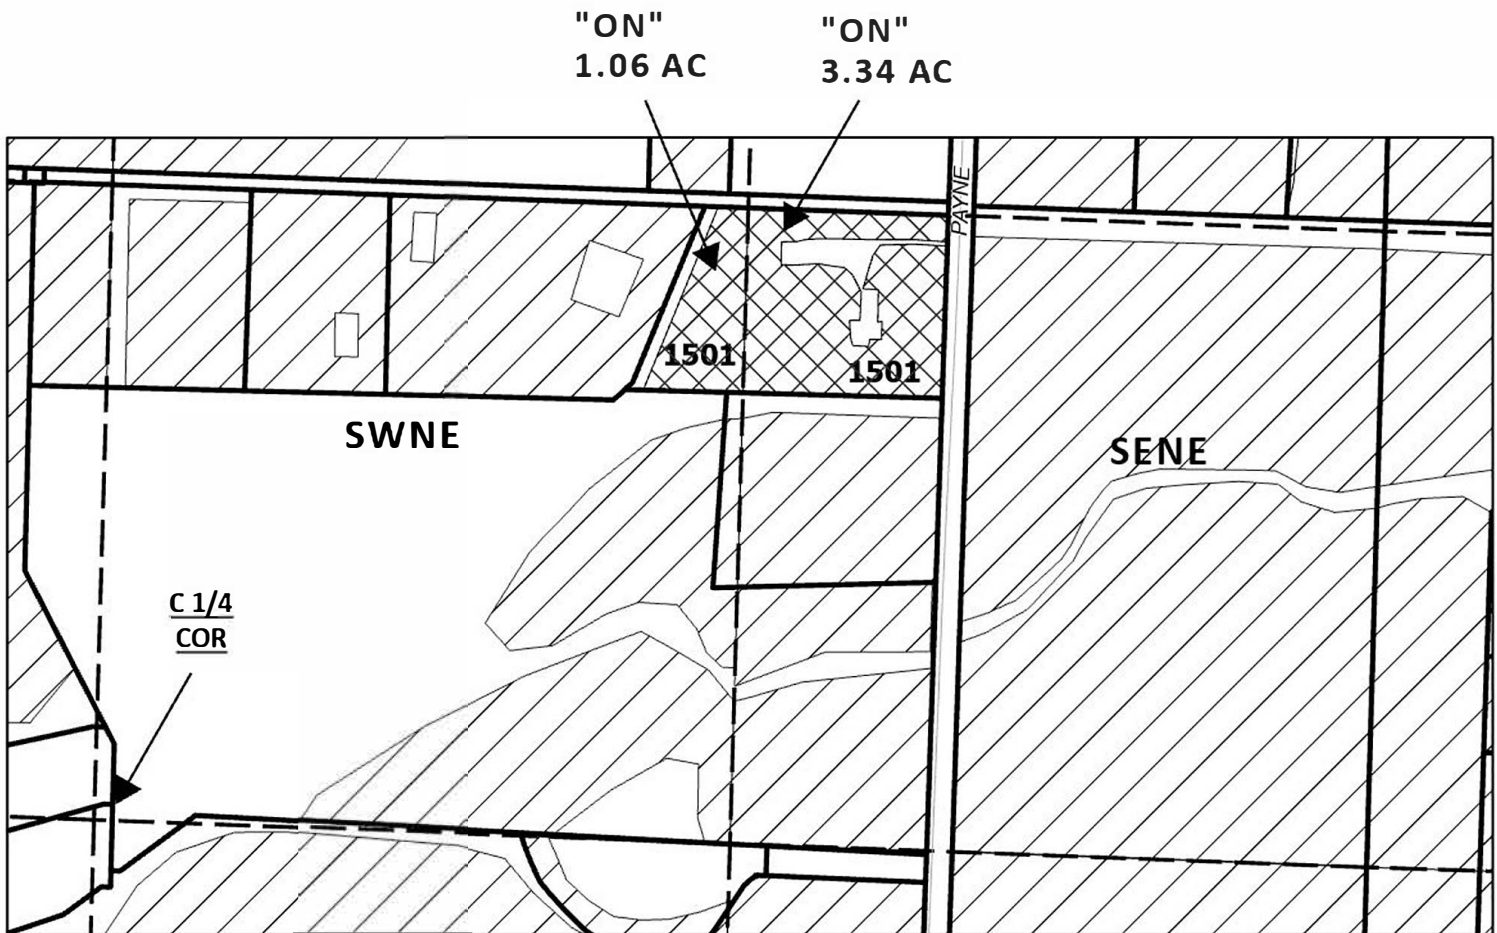

	IRR
	TRAN ON
	TAXLOTS



CLAIM OF BENEFICIAL USE MAP

NAME: ELLEN TUOHEY
TAXLOT #: 1501 4.5 AC
SWNE 1.06 AC
SENE 3.44 AC

CERTIFICATE #:
83727 (IR)

REV: 02/18/25

CLAIM OF BENEFICIAL USE Site Report

Transfer Number: **T-13083**

District Internal Notice #: **15-4**

User Name: Dunn Ranch LLC
(Manta Investments, LLC)

Phone: 541-821-8659

Property: 4201 Hwy 66, Ashland

Place of Use:

	POD						GOV'T		
USE	#	TWP	RNG	SEC	QQ	DLC	LOT	TAX LOT	ACRES
IR	ALL	39S	2E	19	SW NW	40		300	2.30
IR	ALL	39S	2E	19	NW NW	40		300	2.60

TOTAL ACRES = 4.90

District Conveyance System:

Description of Delivery System: Pump from Neil Creek via private pipeline

Headgate: None Canal: Ashland Canal

Beneficial Use:

Description of Beneficial Use: Pasture

Method Used to Apply Water: Sprinkler irrigated. The water use is metered.

Method Used to Calculate Beneficial Use: Ariel Map Verification 7/5/24 HH

User Interviewed: () Yes (x) No

Beneficial Use Made as Authorized: (x) Yes () No

Description of Beneficial Use if Less than Authorized:

None

Inspected By: Shawn D. Bruce Date: 4/22/2024

Instructions: Attach and label the corresponding final proof map.

**JACKSON COUNTY

SCALE - 1" = 400'

E-RECEIVED

1/21/2025


OWRD



T-13083

NW 1/4 OF THE NW 1/4; SW 1/4 OF THE NW 1/4


DIN 15-04

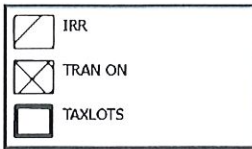

EXISTING RIGHTS
CERTIFICATE #:

NWNW
79212 (IR): 10.0 AC
83727 (IS): 10.0 AC

SWNW
79212 (IR): 1.5 AC
83727 (IS): 1.5 AC

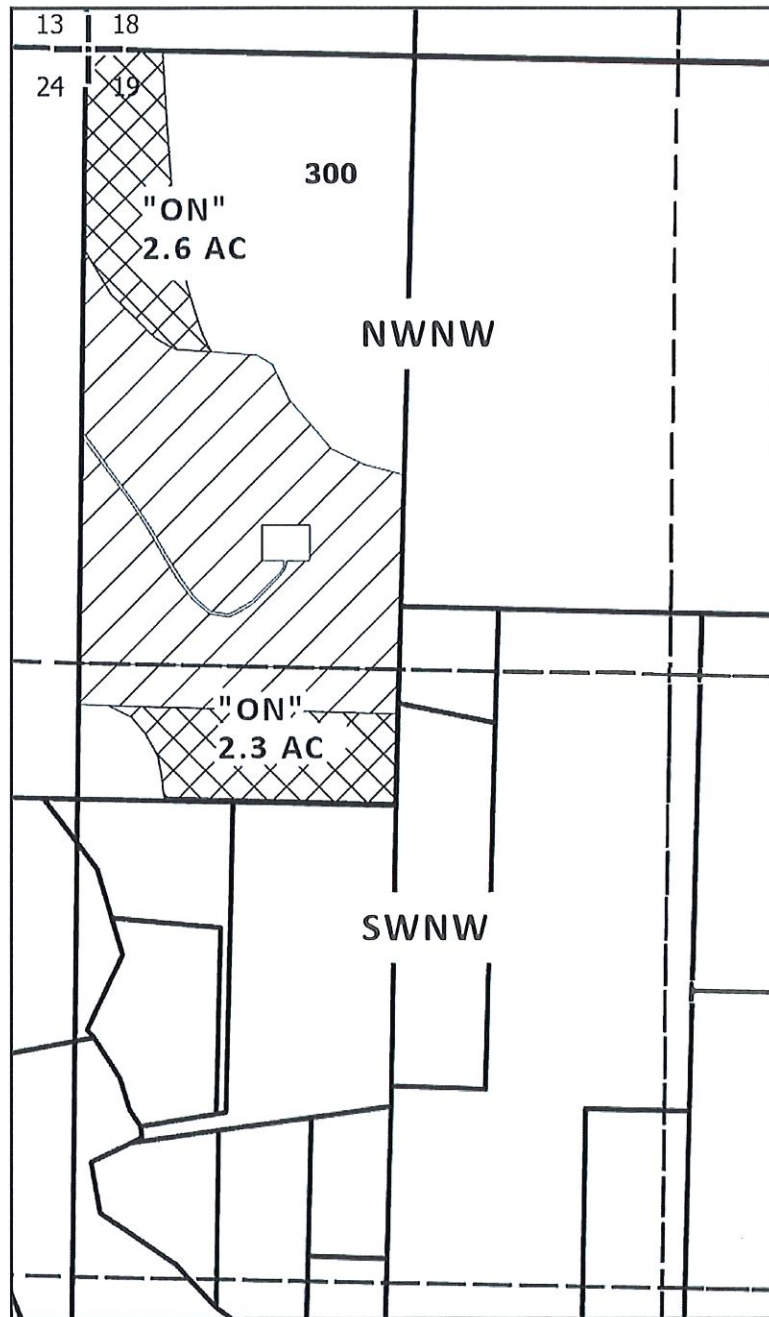

DATE: 12/20/24

CLAIM OF BENEFICIAL USE MAP

NAME: DUNN RANCH, LLC
(MANTA INVESTMENTS, LLC)

TAXLOT# 300

NWNW 2.6 AC

SWNW 2.3 AC

ON LANDS
CERTIFICATE #:
79212 (IR) 4.9 AC
83727 (IS) 4.9 AC

This map is not intended to provide legal dimensions
or locations of property ownership lines

CLAIM OF BENEFICIAL USE Site Report

Transfer Number: **T-13083**

District Internal Notice #: **16-1**

User Name: Soda Springs (Seven Generations)

Phone: 541-821-2522

Property: Buckhorn Springs Rd. Ashland, OR 97520

Place of Use:

	POD						GOV'T		
USE	#	TWP	RNG	SEC	QQ	DLC	LOT	TAX LOT	ACRES
IR	ALL	39S	2E	35	SW SW			300	1.90
IR	ALL	39S	2E	35	SW SW			300	1.10
IR	ALL	39S	2E	35	SE SW			300	.70
IR	ALL	40S	2E	02	NE NW		3	500	.85
IR	ALL	40S	2E	02	NE NW		3	102	3.28
IR	ALL	40S	2E	02	SE NW			102	2.17

TOTAL ACRES = 10.00

District Conveyance System:

Description of Delivery System: Private pump station on the Ashland Canal

Headgate: AC Headgate 1

Canal: Ashland Main Canal

Beneficial Use:

Description of Beneficial Use: Pasture

Method Used to Apply Water: Sprinkler Irrigated. The water use is metered.

Method Used to Calculate Beneficial Use: Ariel Map Verification 6/14/24 HH

User Interviewed: () Yes (X) No

Beneficial Use Made as Authorized: (X) Yes () No

Description of Beneficial Use if Less than Authorized:

None

Inspected By: *Shane J. Burns*

Date: *7/8/2024*

Instructions: Attach and label the corresponding final proof map.

JACKSON COUNTY
SEC. 35 T39S R2E & SEC. 02 T40S R2E

OWRD E-RECEIVED
02/19/2025
AMENDED


SCALE - 1" = 400'



T-13083

S 1/2 OF THE SW 1/4 (SEC 35); N 1/2 OF THE NW 1/4 (SEC 02)

DIN-16-01
MAP 1 OF 2

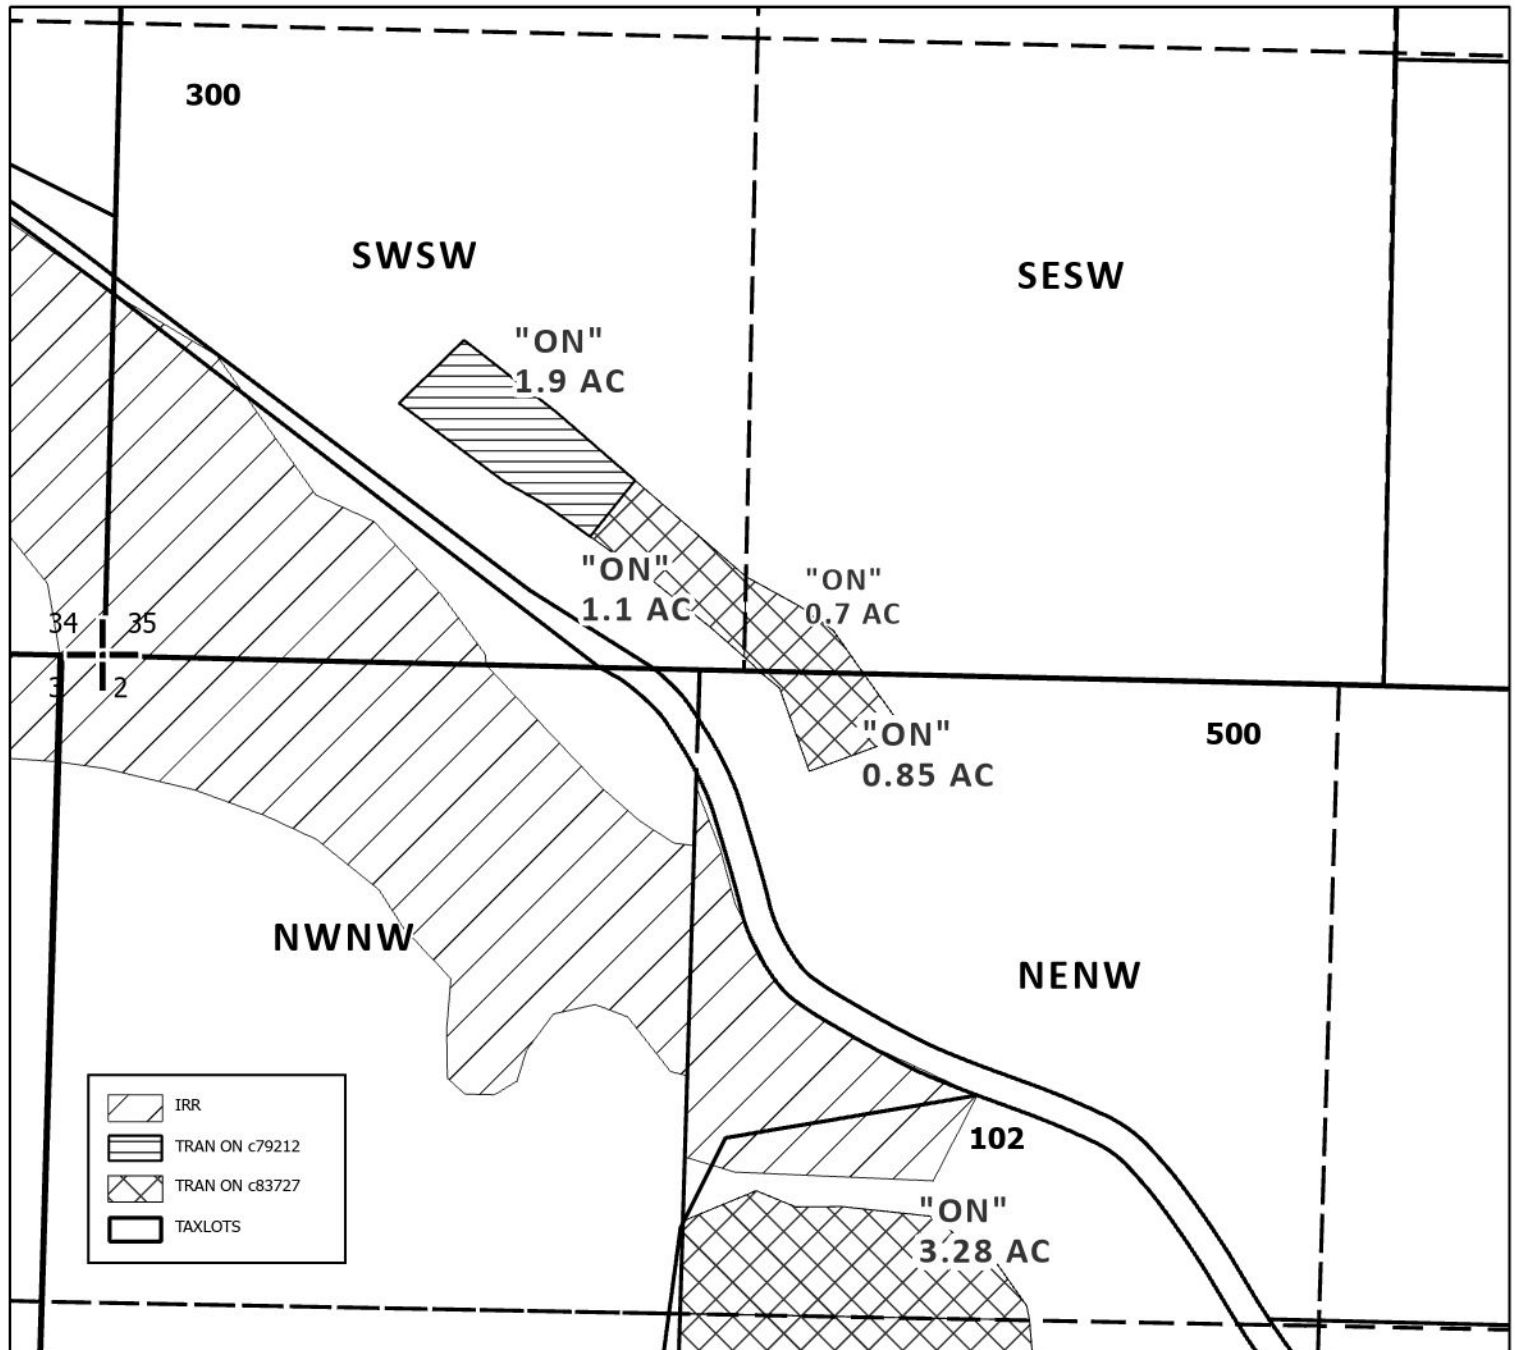

CLAIM OF BENEFICIAL USE MAP

NAME: SODA SPRINGS (SEVEN GENERATIONS)
TAXLOT #: 300 3.7 AC
SWSW: 3.0 AC
SESW: 0.7 AC
TAXLOT #500
NENW 0.85 AC
TAXLOT #: 102
NENW 3.28 AC

ON LANDS
CERTIFICATE #:
79212 (IR) 1.9 AC
83727 (IS): 1.9 AC
83727 (IR): 5.93 AC

**JACKSON COUNTY
SEC. 02 T40S R2E**

SCALE - 1" = 400'



E-RECEIVED



1/21/2025

OWRD

T-13083

SE 1/4 OF THE NW 1/4

DIN-16-01
MAP 2 OF 2

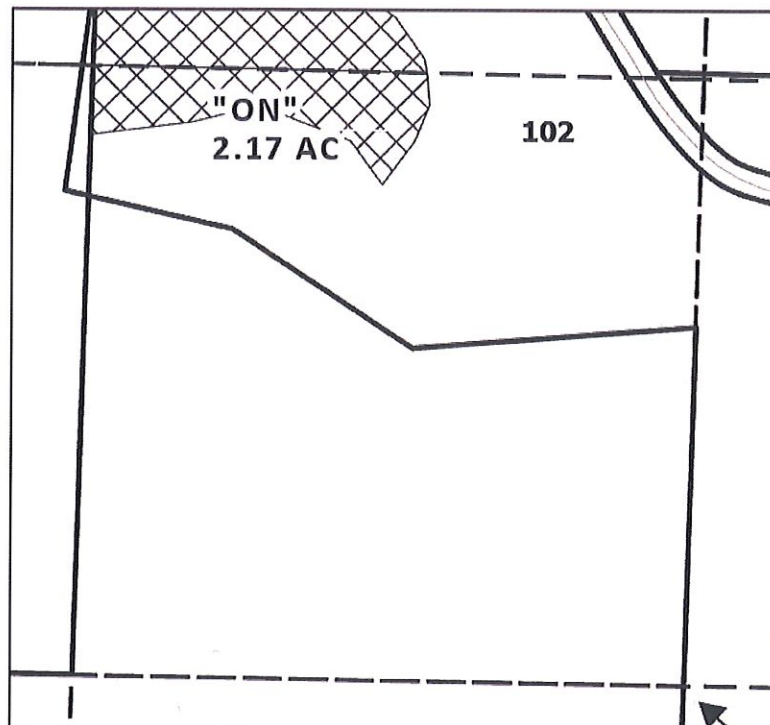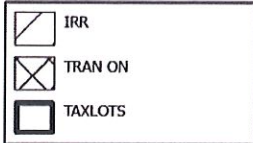


C 1/4
COR

CLAIM OF BENEFICIAL USE MAP

NAME: SODA SPRINGS (SEVEN GENERATIONS)
TAXLOT# 102
SE 1/4 2.17 AC

ON LANDS
CERTIFICATE #:
83724 (IR) 2.17 AC

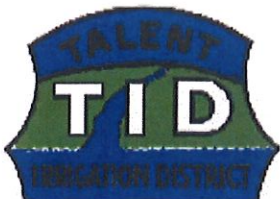

CLAIM OF BENEFICIAL USE Site Report

Transfer Number: **T-13083**

District Internal Notice #: **17-2**

User Name: John Giorgi Living Trust
(Nicoya / James Grey Hecht)

Phone: 541-890-3575

Property: 1785 Zemke Rd, Talent, OR 97540

Place of Use:

USE	POD #	TWP	RNG	SEC	QQ	DLC	GOV'T LOT	TAX LOT	ACRES
IR	ALL	38S	1W	28	SW SE			2400	1.20
TOTAL ACRES =									1.20

District Conveyance System:

Description of Delivery System: Pump from West Canal via private pipeline

Headgate: None

Canal: West Canal

Beneficial Use:

Description of Beneficial Use: Lawn and Landscaping

Method Used to Apply Water: Sprinkler irrigated. The water use is metered

Method Used to Calculate Beneficial Use: Ariel Map Verification 7/5/24 HH

User Interviewed: () Yes (x) No

Beneficial Use Made as Authorized: (x) Yes () No

Description of Beneficial Use if Less than Authorized:

None

Inspected By: Shawn D. Burns

Date: 11/22/2024

Instructions: Attach and label the corresponding final proof map.

JACKSON COUNTY
SEC. 28 T38S R1W

SCALE - 1" = 400'



E-RECEIVED



1/21/2025

OWRD

T-13083

SW 1/4 OF THE SE 1/4

DIN 17-02

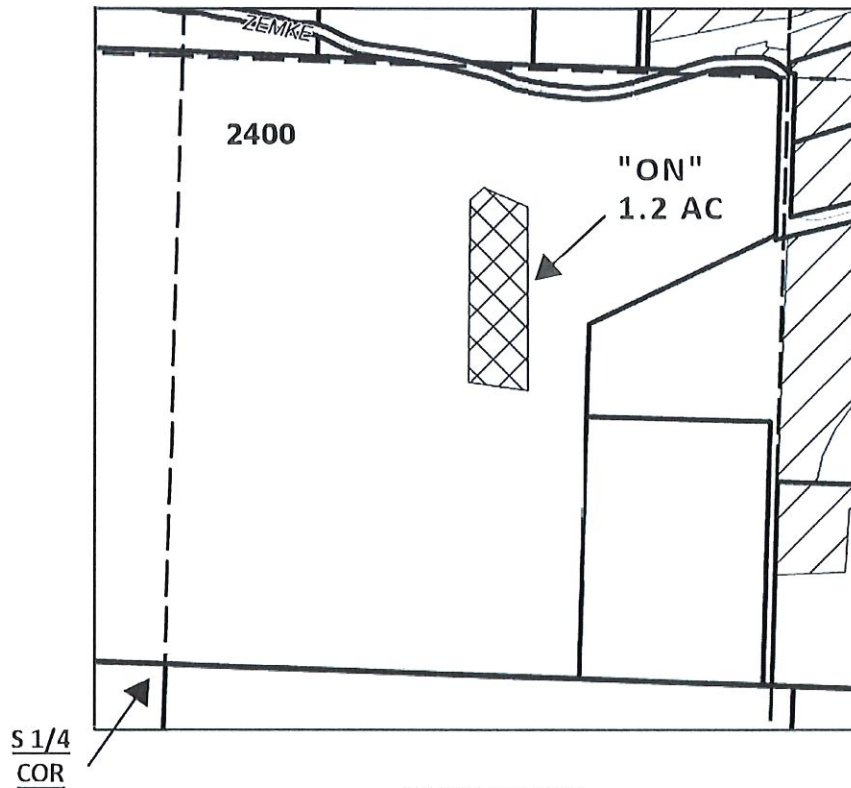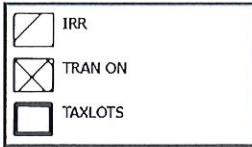

EXISTING RIGHTS
CERTIFICATE #:
79212 (IR): 0.0 AC
83727 (IS): 0.0 AC



DATE: 12/20/24

CLAIM OF BENEFICIAL USE MAP

NAME: JOHN GIORGI LIVING TRUST
(NICOYA / JAMES GREY HECHT)
TAXLOT# 2400
SWSE 1.2 AC

ON LANDS
CERTIFICATE #:
79212 (IR) 1.2 AC
83727 (IS) 1.2 AC

This map is not intended to provide legal dimensions
or locations of property ownership lines

CLAIM OF BENEFICIAL USE Site Report

Transfer Number: T-13083

District Internal Notice #: 17-3

User Name: Rsles-1, LLC (Olson Holdings, LCC)

Phone: 541-890-3575

Property: 307 Eagle Mill Rd. Ashland, OR. 97520

Place of Use:

USE	POD #	TWP	RNG	SEC	QQ	DLC	GOV'T LOT	TAX LOT	ACRES
IR	ALL	38S	1E	32	SW NW	48		501	12.20
IR	ALL	38S	1E	32	SW NW	48		501	3.40

TOTAL ACRES = 15.60

District Conveyance System:

Description of Delivery System: Private pump station on the Talent Canal

Headgate: None

Canal: Talent Canal

Beneficial Use:

Description of Beneficial Use: Agriculture

Method Used to Apply Water: Sprinkler irrigated. The water use is metered

Method Used to Calculate Beneficial Use: Ariel Map Verification 6/14/24 HH

User Interviewed: () Yes (x) No

Beneficial Use Made as Authorized: (x) Yes () No

Description of Beneficial Use if Less than Authorized:

None

Inspected By: Shane D. Burns

Date: 7/8/2024

Instructions: Attach and label the corresponding final proof map.

**JACKSON COUNTY
SEC. 32 T38S R1E**

SCALE - 1" = 400'



E-RECEIVED



1/21/2025

OWRD

T-13083

SW 1/4 OF THE NW 1/4

DIN-17-03

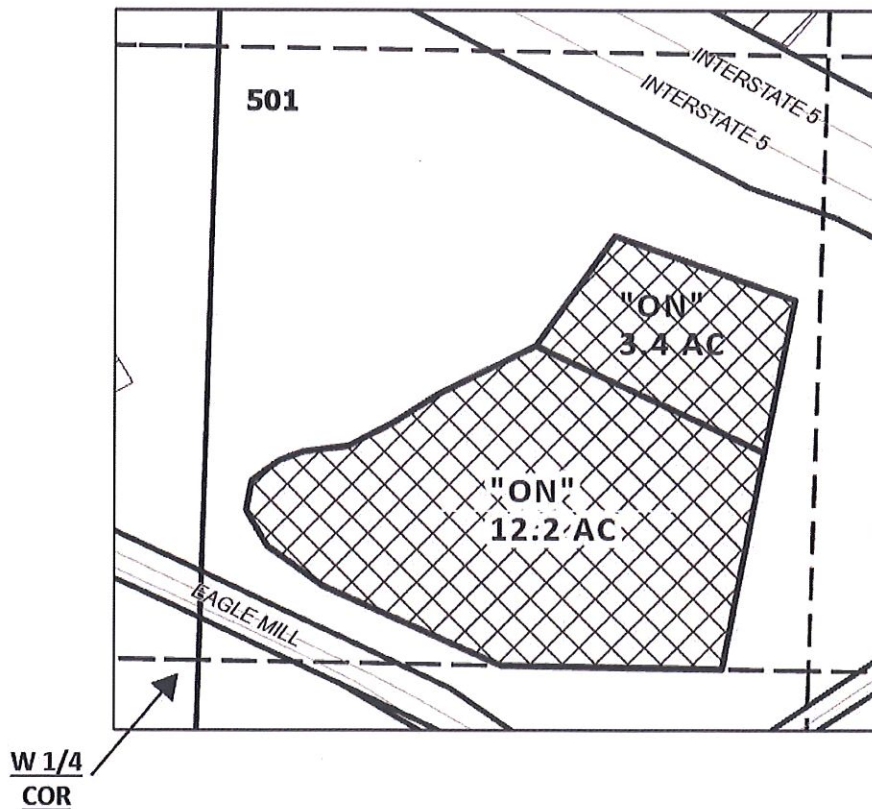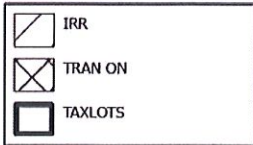

CLAIM OF BENEFICIAL USE MAP

NAME: RS;ES-1, LLC (OLSON HOLDINGS, LLC)
TAXLOT #: 501 15.6 AC

ON LANDS
CERTIFICATE #:
79212 (P) 12.2 AC
83724 (IS) 12.2 AC
83724 (IR) 3.4 AC

CLAIM OF BENEFICIAL USE Site Report

Transfer Number: **T-13083**

District Internal Notice #: **17-4**

User Name: Jacob Parker
(Alta Capital Group)

Phone: 541-890-3575

Property: 3053 Deer Trail Ln, Medford, OR 97501

Place of Use:

USE	POD #	TWP	RNG	SEC	QQ	DLC	GOV'T LOT	TAX LOT	ACRES
IR	ALL	38S	1W	20	NE SE			1800	2.07
IR	ALL	38S	1W	20	NW SE			1800	5.01

TOTAL ACRES = 7.08

District Conveyance System:

Description of Delivery System: Private turnout on the West Canal

Headgate: None

Canal: West Canal

Beneficial Use:

Description of Beneficial Use: Agriculture

Method Used to Apply Water: Sprinkler irrigated. The water use is metered

Method Used to Calculate Beneficial Use: Ariel Map Verification 7/5/24 HH

User Interviewed: () Yes (x) No

Beneficial Use Made as Authorized: (x) Yes () No

Description of Beneficial Use if Less than Authorized:

None

Inspected By: Shawn J. Harris Date: 11/22/2024

Instructions: Attach and label the corresponding final proof map.

JACKSON COUNTY
SEC. 20 T38S R1W

SCALE - 1" = 400'



E-RECEIVED
1/21/2025
OWRD



T-13083

NE 1/4 OF THE SE 1/4; NW 1/4 OF THE SE 1/4

DIN 17-04

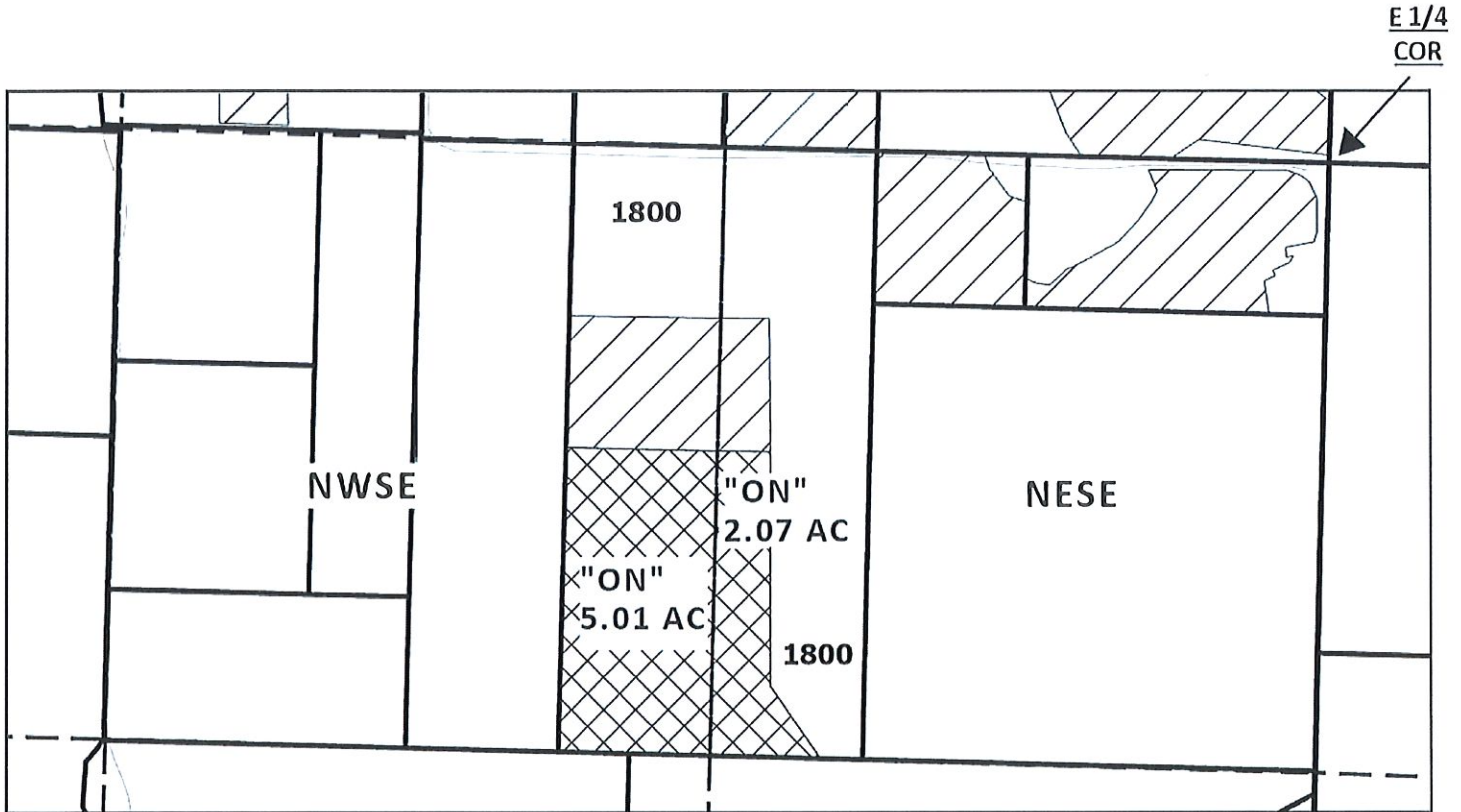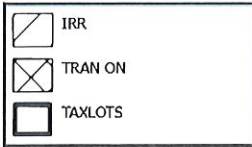

EXISTING RIGHTS
CERTIFICATE #:
NESE:
79212 (IR): 5.4 AC
83727 (IS): 5.4 AC
NWSE:
79212 (IR): 2.18 AC
83727 (IS): 2.18 AC



CLAIM OF BENEFICIAL USE MAP

NAME: JACOB PARKER
TAXLOT# 1800
NESE 2.07 AC
NWSE 5.01 AC

ON LANDS
CERTIFICATE #:
79212 (IR) 7.08 AC
83727 (IS) 7.08 AC

DATE: 12/20/24

This map is not intended to provide legal dimensions
or locations of property ownership lines

CLAIM OF BENEFICIAL USE Site Report

Transfer Number: **T-13083**

District Internal Notice #: **18-1**

User Name: Rocky Robeson / Megan Kurz
(Bast Tract 89, LLC)

Phone: 541-601-6838

Property: 3978 Griffin Creek Rd., Medford, OR 97501

Place of Use:

USE	POD #	TWP	RNG	SEC	QQ	DLC	GOV'T LOT	TAX LOT	ACRES
IR	ALL	38S	2W	10	SE SE	48		2800	3.00

TOTAL ACRES = 3.00

District Conveyance System:

Description of Delivery System: Private turnout on the West Canal
Headgate: None Canal: West Canal

Beneficial Use:

Description of Beneficial Use: Lawn and Landscape

Method Used to Apply Water: Sprinkler irrigated. The water use is metered

Method Used to Calculate Beneficial Use: Ariel Map Verification 7/5/24 HH

User Interviewed: () Yes (X) No

Beneficial Use Made as Authorized: (X) Yes () No

Description of Beneficial Use if Less than Authorized:

None

Inspected By: Shane D. Kurus Date: 11/22/2024

Instructions: Attach and label the corresponding final proof map.

**JACKSON COUNTY
SEC. 10 T38S R2W**

SCALE - 1" = 400'



E-RECEIVED


1/21/2025

OWRD

T-13083

SE 1/4 OF THE SE 1/4

DIN 18-01

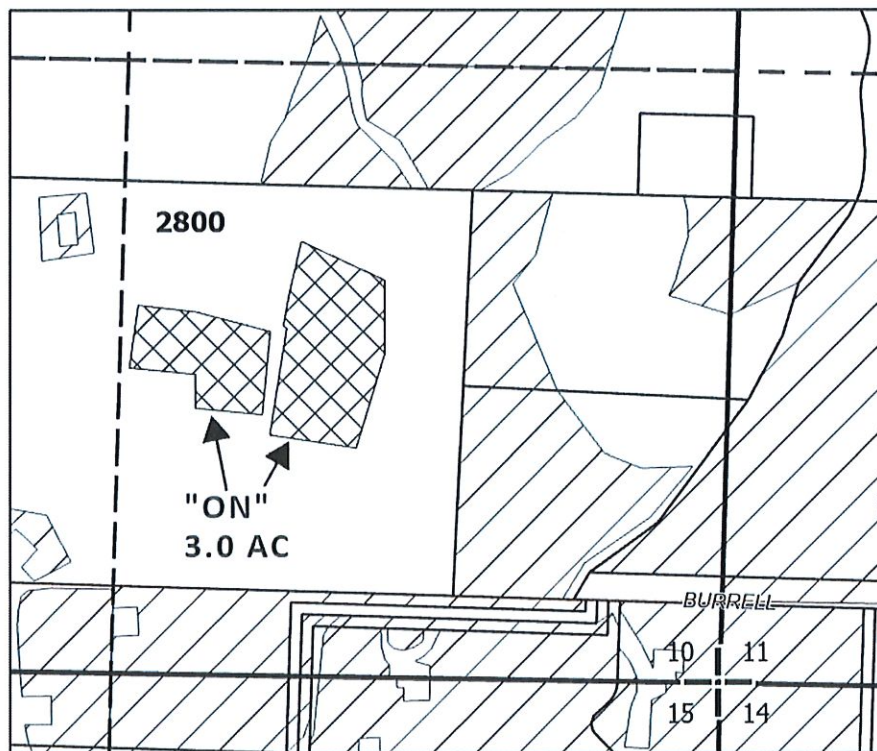

EXISTING RIGHTS
CERTIFICATE #:
79212 (IR): 14.3AC
83727 (IS): 14.3AC
83727 (IR): 0.0 AC



DATE: 12/20/24

CLAIM OF BENEFICIAL USE MAP

NAME: ROCKY ROBESON / MEGAN KURZ
(BASE TRACT 89, LLC)
TAXLOT# 2800
SESE 3.0 AC

ON LANDS
CERTIFICATE #:
83727 (IR) 3.0 AC

This map is not intended to provide legal dimensions
or locations of property ownership lines

CLAIM OF BENEFICIAL USE Site Report

Transfer Number: **T-13083**

District Internal Notice #: **18-2**

User Name: Stiritz-Brellochs Rev Liv Tr (c/o James Stiritz / Brigitte Brellochs TTEE)
(Kyrill B. / Ehlan R. Stiritz) Phone: 541-890-5220

Property: 7793 Hwy 66, Ashland, OR 97520

Place of Use:

USE	POD #	TWP	RNG	SEC	QQ	DLC	GOV'T LOT	TAX LOT	ACRES
IR	ALL	39S	2E	34	SW NW			400	.50

TOTAL ACRES = .50

District Conveyance System:

Description of Delivery System: Private pump station on the Ashland Canal

Headgate: None Canal: Ashland Canal

Beneficial Use:

Description of Beneficial Use: Lawn and Landscape

Method Used to Apply Water: Sprinkler irrigated. The water use is metered

Method Used to Calculate Beneficial Use: Ariel Map Verification 7/5/24 HH

User Interviewed: () Yes (X) No

Beneficial Use Made as Authorized: (X) Yes () No

Description of Beneficial Use if Less than Authorized:

None

Inspected By: Sharon J. Davis Date: 11/22/2024

Instructions: Attach and label the corresponding final proof map.

**JACKSON COUNTY
SEC. 34 T39S R2E**

SCALE - 1" = 400'



E-RECEIVED



1/21/2025

OWRD

T-13083

SW 1/4 OF THE NW 1/4

DIN 18-02

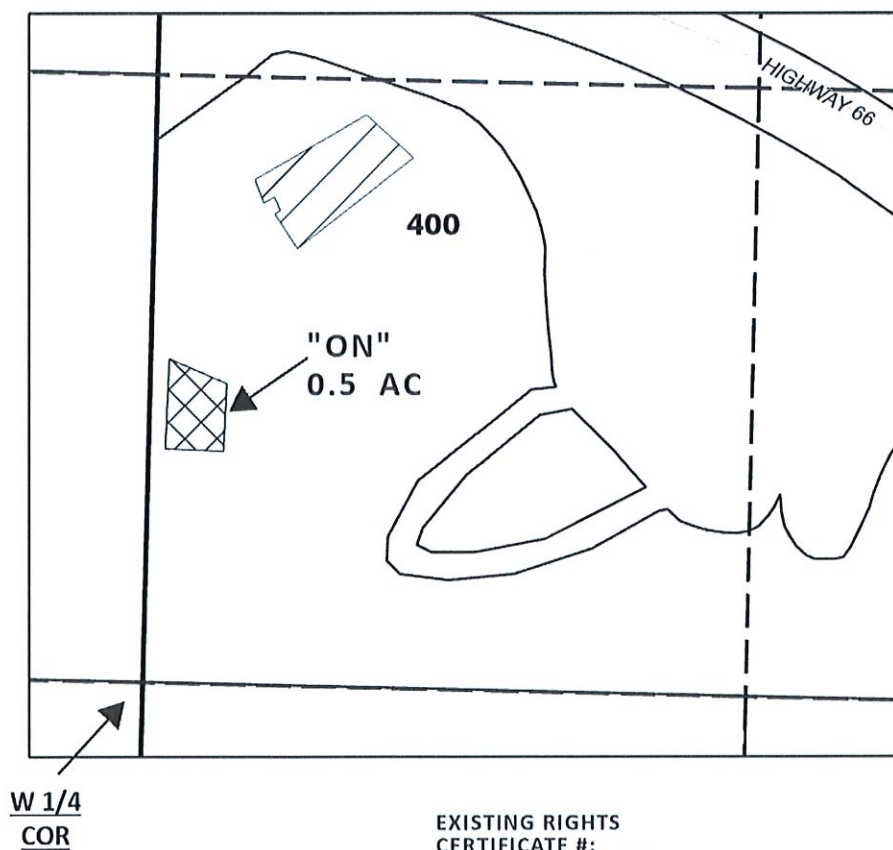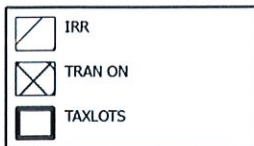

EXISTING RIGHTS
CERTIFICATE #:
83727 (IR): 1.1 AC



DATE: 12/20/24

CLAIM OF BENEFICIAL USE MAP

NAME: STIRITZ-BRELLOCHS REV LIV TR
(C/O JAMES STIRITZ/BRIGITTE BRELLOCHS TTEE)
(KYRILL B./ EHLAN R. STIRITZ)

TAXLOT# 400
SWNW 0.5 AC

ON LANDS
CERTIFICATE #:
79212 (IR) 0.5 AC
83727 (IS) 0.5 AC

This map is not intended to provide legal dimensions
or locations of property ownership lines

CLAIM OF BENEFICIAL USE Site Report

Transfer Number: T-13083

District Internal Notice #: 18-3

User Name: DRR Properties

Phone: 949-809-3900

Property: Emigrant Creek Road,

Place of Use:

USE	POD #	TWP	RNG	SEC	QQ	DLC	GOV'T LOT	TAX LOT	ACRES
IR	ALL	39S	2E	18	NW NW			300	7.83
IR	ALL	39S	2E	18	SE NW			303	.20
IR	ALL	39S	2E	18	NW SE			500	8.78

TOTAL ACRES = 16.81

District Conveyance System:

Description of Delivery System:

Headgate: None

Canal: Ashland Canal

Beneficial Use:

Description of Beneficial Use: Lawn and Landscape

Method Used to Apply Water: Sprinkler irrigated. The water use is metered

Method Used to Calculate Beneficial Use: Ariel Map Verification 7/5/24 HH

User Interviewed: () Yes (X) No

Beneficial Use Made as Authorized: (X) Yes () No

Description of Beneficial Use if Less than Authorized:

None

Inspected By: Shawn D. Burns Date: 7/9/2024

Instructions: Attach and label the corresponding final proof map.

**JACKSON COUNTY
SEC. 18 T39S R2E**

E-RECEIVED
1/21/2025
OWRD


SCALE - 1" = 400'



T-13083

NW 1/4

DIN-18-03
MAP 1 OF 2

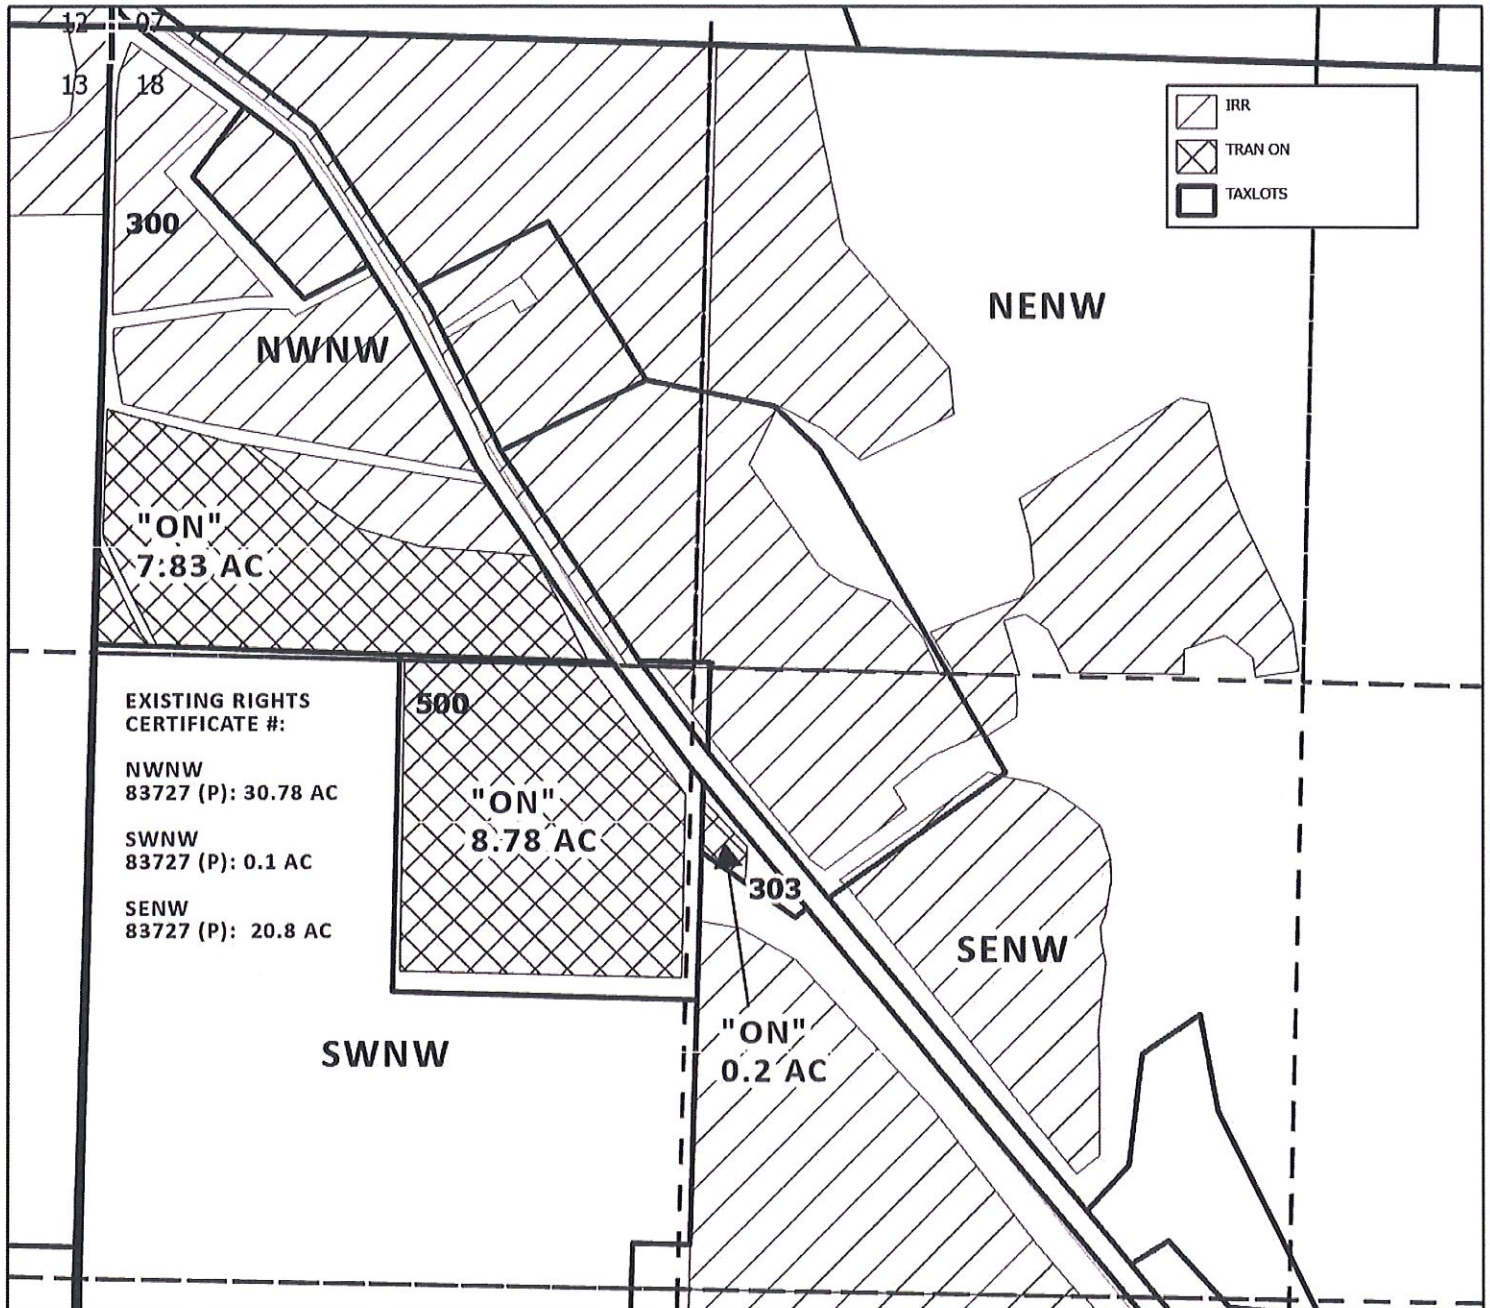

CLAIM OF BENEFICIAL USE MAP



NAME: DRR PROPERTIES, INC (ROBERTS COMMUNITY)
TAXLOT #: 300
NWNW 7.83 AC
TAXLOT# 303
SENW 0.2 AC
TAXLOT # 500
SWNW 8.78 AC

ON LANDS
CERTIFICATE #:
83724 (IR)

CLAIM OF BENEFICIAL USE Site Report

Transfer Number: **T-13083**

District Internal Notice #: **18-3**

User Name: Duane / Kelly Roberts Comm Prop Tr

Phone: 541-301-8825

Property: 2113 Emigrant Creek Road,

Place of Use:

USE	POD #	TWP	RNG	SEC	QQ	DLC	GOV'T LOT	TAX LOT	ACRES
IR	ALL	39S	2E	18	NW SE			302	1.60

TOTAL ACRES = 1.60

District Conveyance System:

Description of Delivery System: Private pump station from Emigrant Creek to pipeline

Headgate: None

Canal: Ashland Canal

Beneficial Use:

Description of Beneficial Use: Lawn and Landscape

Method Used to Apply Water: Sprinkler irrigated. The water use is metered

Method Used to Calculate Beneficial Use: Ariel Map Verification 7/5/24 HH

User Interviewed: () Yes (X) No

Beneficial Use Made as Authorized: (X) Yes () No

Description of Beneficial Use if Less than Authorized:

None

Inspected By: *Sharon D. Burns* Date: *2/8/2024*

Instructions: Attach and label the corresponding final proof map.

**JACKSON COUNTY
SEC. 18 T39S R2E**

SCALE - 1" = 400'




T-13083

NW 1/4 OF THE SE 1/4

E-RECEIVED
1/21/2025
OWRD


**DIN-18-03
MAP 2 OF 2**

C 1/4
COR

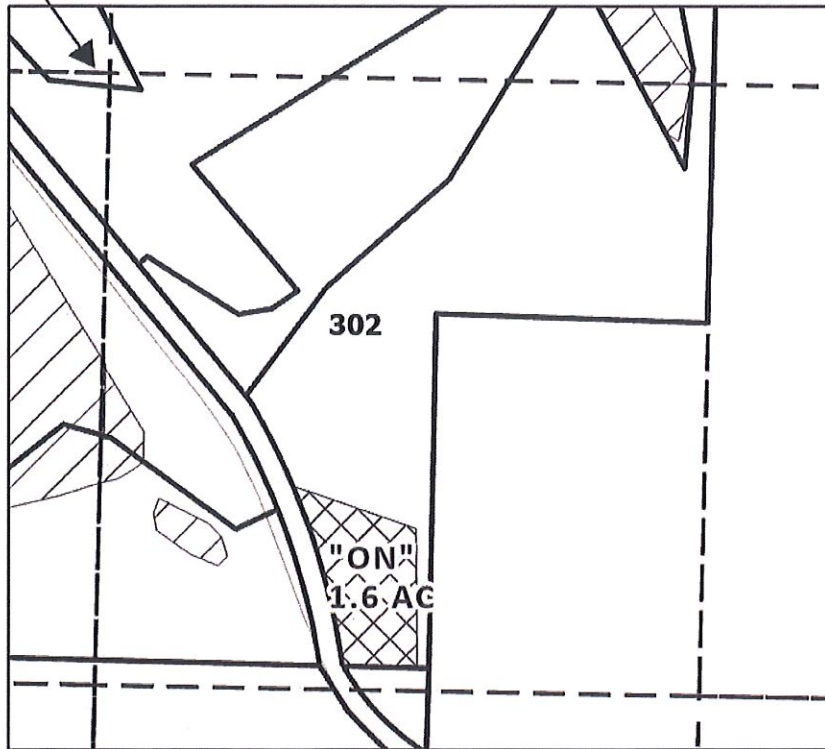

EXISTING RIGHTS
CERTIFICATE #:
83727 (P): 1.0 AC

ON LANDS
CERTIFICATE #:
83724 (IR)

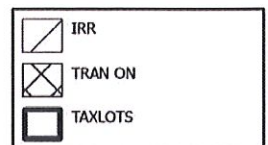

CLAIM OF BENEFICIAL USE MAP

NAME: DRR PROPERTIES, INC (ROBERTS COMMUNITY)
TAXLOT #: 302
1.6 AC



CLAIM OF BENEFICIAL USE Site Report

Transfer Number: **T-13083** District Internal Notice #: **18-4**

User Name: Mel / Shiela Canal Phone: 541-482-8467

Property: 220 E Butler Ln, Ashland, OR 97520

Place of Use:

USE	POD #	TWP	RNG	SEC	QQ	DLC	GOV'T LOT	TAX LOT	ACRES
IR	ALL	38S	1E	29	SW SW	45		6400	.20

TOTAL ACRES = .20

District Conveyance System:

Description of Delivery System: Private pump station on the E-7 lateral of the East Canal

Headgate: None Canal: East Canal

Beneficial Use:

Description of Beneficial Use: Lawn and Landscape

Method Used to Apply Water: Drip irrigated. The water use is metered

Method Used to Calculate Beneficial Use: Ariel Map Verification 7/5/24 HH

User Interviewed: () Yes (X) No

Beneficial Use Made as Authorized: (X) Yes () No

Description of Beneficial Use if Less than Authorized:

None

Inspected By: Shawn D. Burns Date: 11/22/2024

Instructions: Attach and label the corresponding final proof map.

**JACKSON COUNTY
SEC. 29 T38S R1E**

SCALE - 1" = 400'





E-RECEIVED
1/21/2025
OWRD

T-13083

SW 1/4 OF THE SW 1/4

DIN 18-04

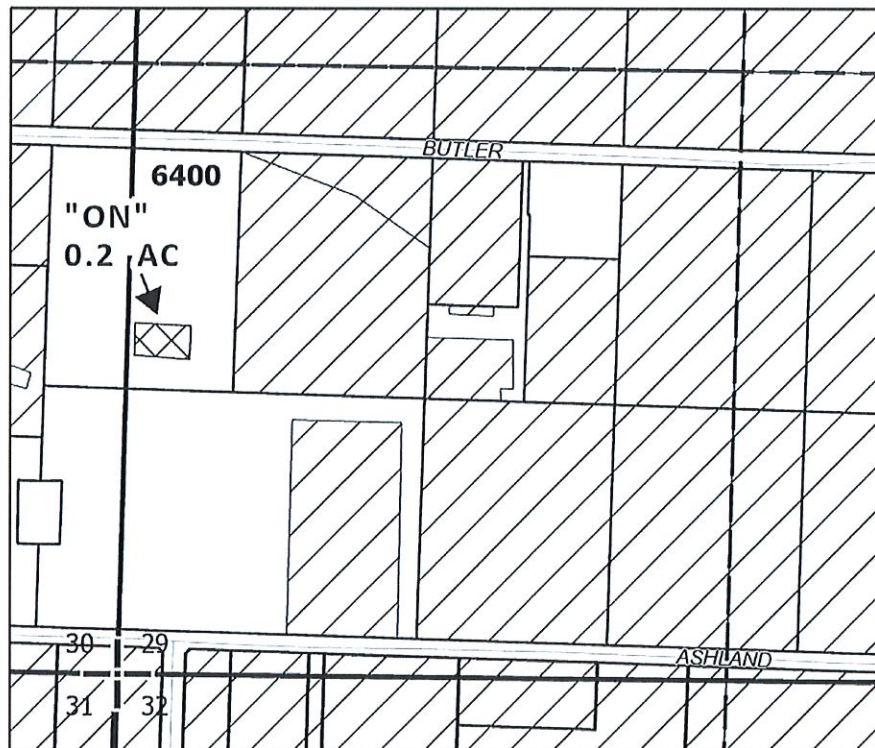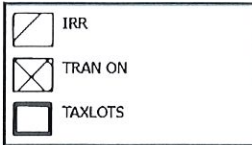

EXISTING RIGHTS
CERTIFICATE #:
79212 (IR): 28.8 AC
83727 (IS): 28.8 AC



DATE: 12/20/24

CLAIM OF BENEFICIAL USE MAP

NAME: MEL / SHIELA CANAL
TAXLOT# 6400
SWNW 0.2 AC

ON LANDS
CERTIFICATE #:
79212 (IR) 0.2 AC
83727 (IS) 0.2 AC

This map is not intended to provide legal dimensions
or locations of property ownership lines

SUPERSEDED

JACKSON COUNTY
SEC. 35 T39S R2E & SEC. 02 T40S R2E

E-RECEIVED

1/21/2025

OWRD


SCALE - 1" = 400'



T-13083

S 1/2 OF THE SW 1/4 (SEC 35); N 1/2 OF THE NW 1/4 (SEC 02)

DIN-16-01
MAP 1 OF 2

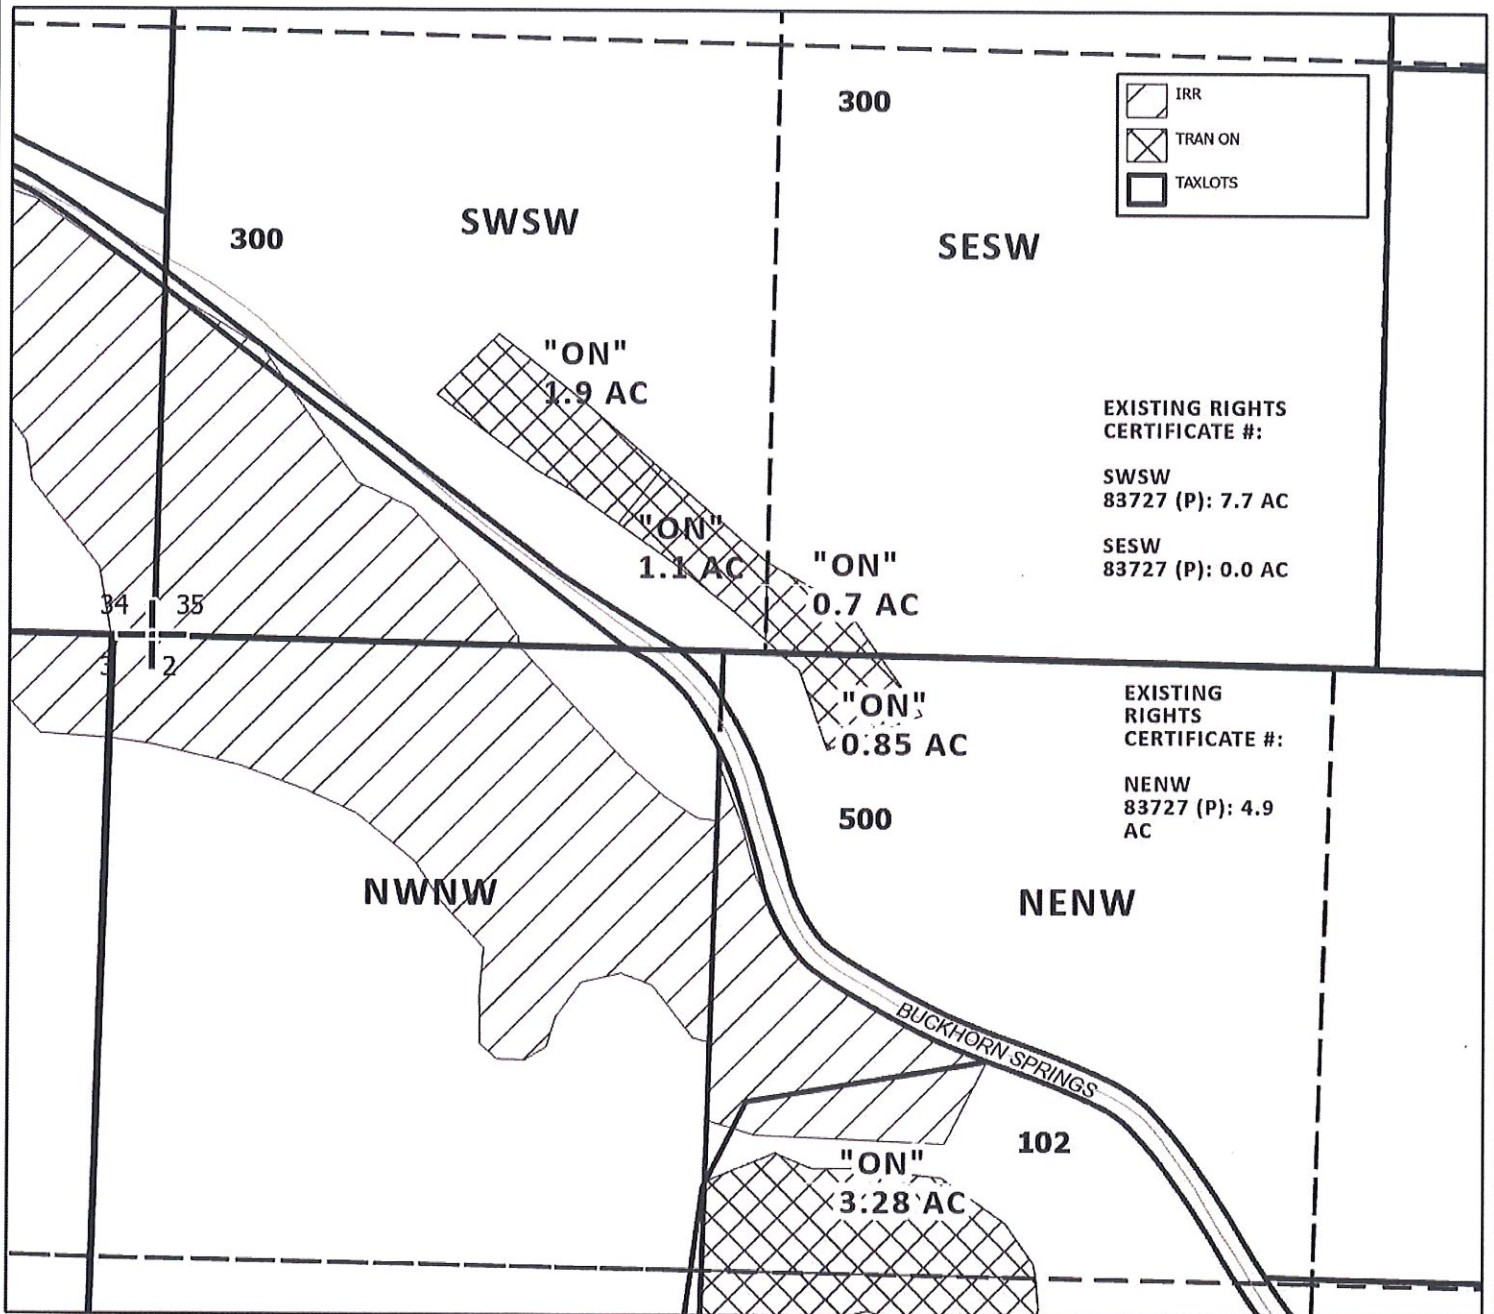

CLAIM OF BENEFICIAL USE MAP



NAME: SODA SPRINGS (SEVEN GENERATIONS)

TAXLOT #: 300 3.7 AC

SWSW 3.0 AC

SESW 0.7 AC

TAXLOT # 500

NENW 0.85 AC

TAXLOT# 102

NENW 3.28 AC

ON LANDS

CERTIFICATE #:

79212 (IR) 1.9 AC

83724 (IS) 1.9 AC

83724 (IR) 5.93 AC

SUPERSEDED

**JACKSON COUNTY
SEC. 19 T38S R1E**

E-RECEIVED
1/21/2025
OWRD

SCALE - 1" = 400'




NW 1/4 OF THE SW 1/4; NE 1/4 OF THE SW 1/4

T-13083


DIN-15-01
MAP 2 OF 2

W 1/4 COR

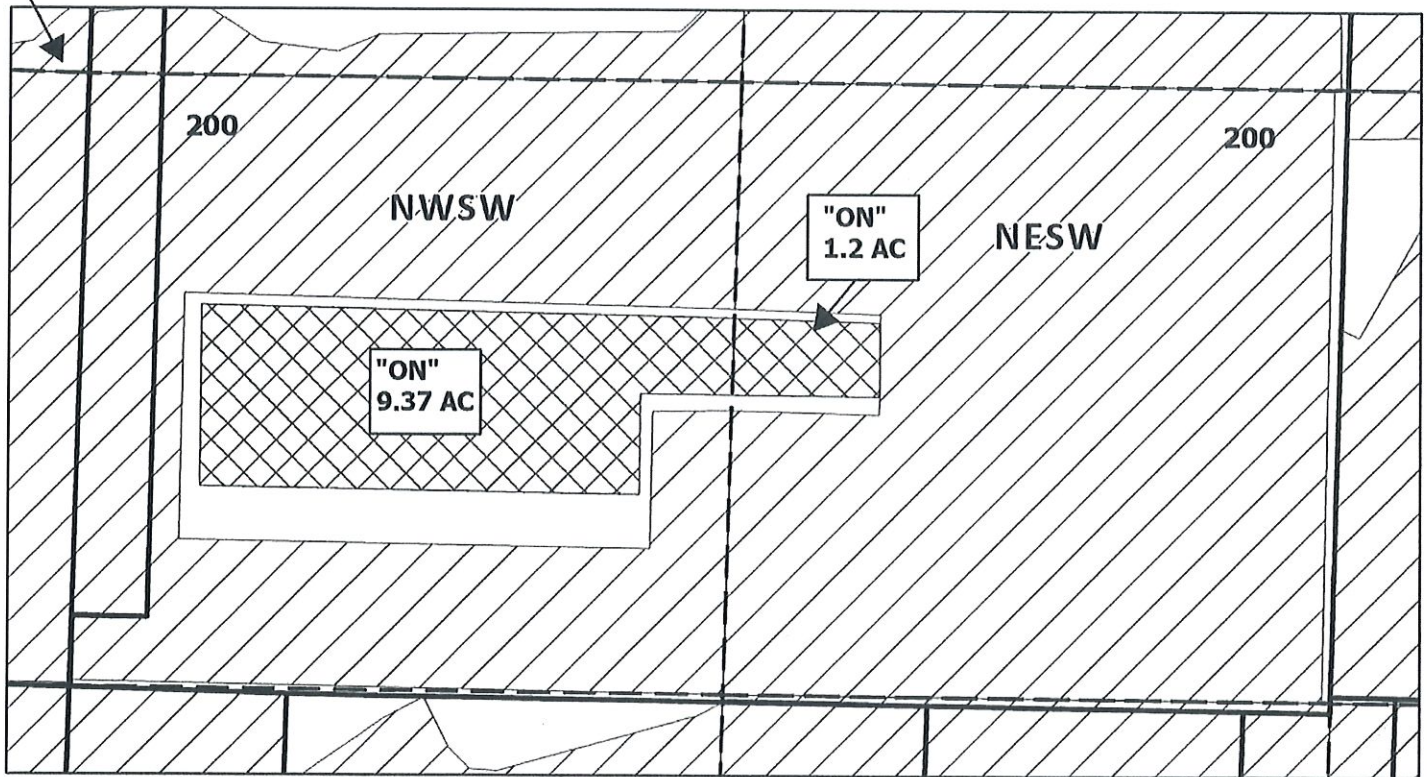

EXISTING RIGHTS
CERTIFICATE #:
NESW
79212 (P): 37.68 AC
83727 (P): 0.0 AC

NWSW
79212 (P): 29.25 AC
83727 (P): 0.0 AC

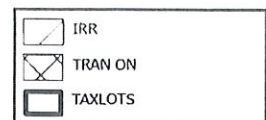

CLAIM OF BENEFICIAL USE MAP

NAME: NAUMES, INC
TAXLOT #: 200 10.57 AC
NESW 1.2 AC
NWSW 9.37 AC

CERTIFICATE #:
79212 (IR)
83724 (IR)

SUPERSEDED

**JACKSON COUNTY
SEC. 14 T38S R1W**

E-RECEIVED
1/21/2025
OWRD


SCALE - 1" = 400'




T-13083


DIN-15-03

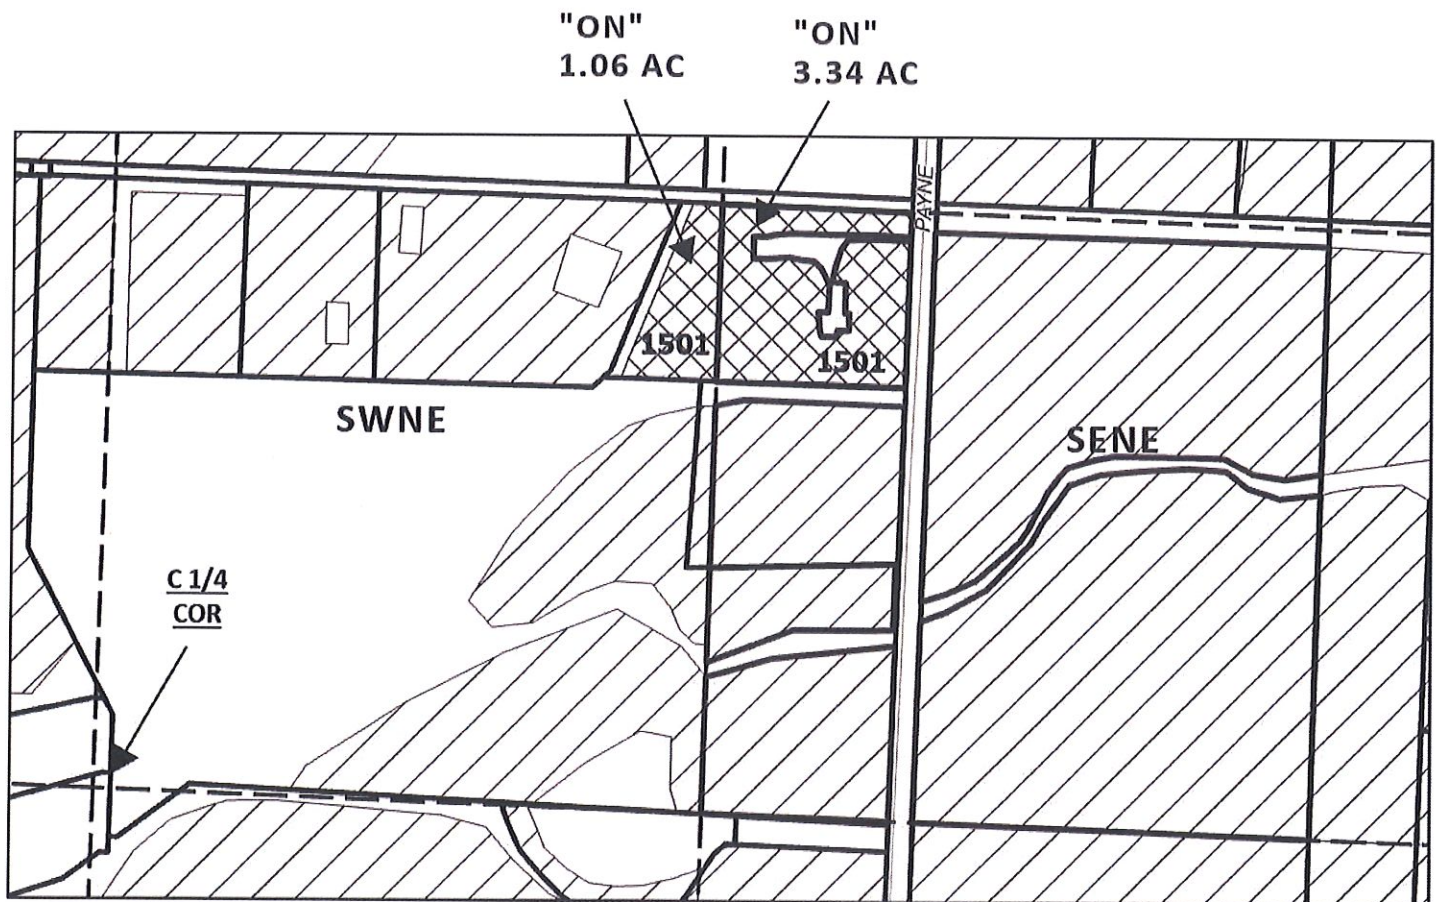

EXISTING RIGHTS
CERTIFICATE #:

SWNE
79212 (P): 17.9 AC
83727 (S): 17.9 AC

SENE
79212 (P): 33.2 AC
83727 (S): 33.2 AC

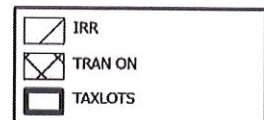

CLAIM OF BENEFICIAL USE MAP

NAME: ELLEN TUOHEY
TAXLOT #: 1501 4.5 AC
SWNE 1.06 AC
SENE 3.44 AC

CERTIFICATE #:
79212 (IR)
83724 (IR)
83724 (IS)

SUPERSEDED

**JACKSON COUNTY
SEC. 24 T38S R1W**

E-RECEIVED
1/21/2025
OWRD


SCALE - 1" = 400'



NE 1/4 OF THE SW 1/4; NW 1/4 OF THE SE 1/4


T-13083

DIN-15-01
MAP 1 OF 2

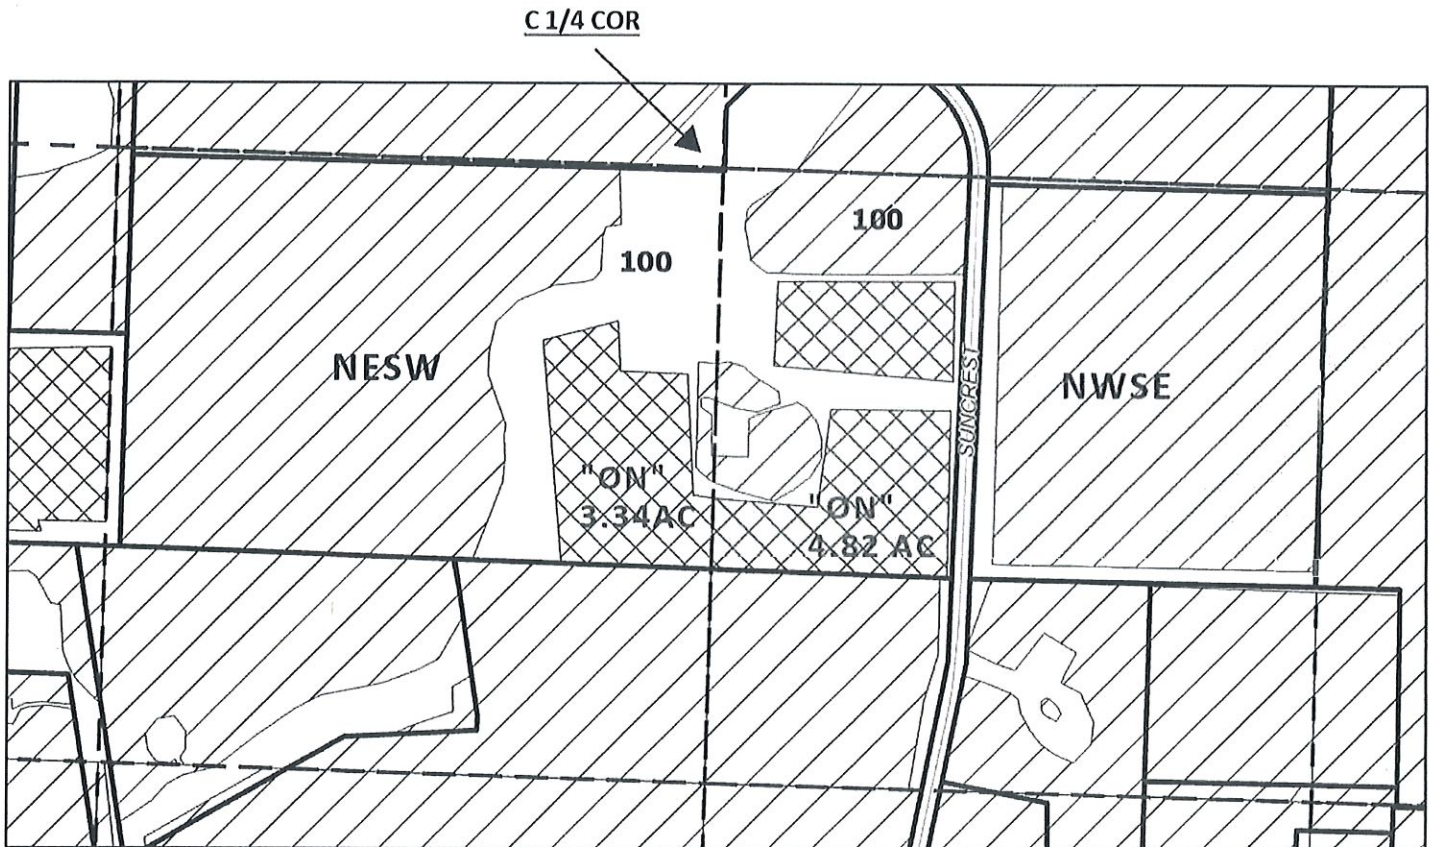

EXISTING RIGHTS
CERTIFICATE #:
NESW
79212 (P): 30.3 AC
83727 (S): 30.3 AC

NWSE
79212 (P): 28.4 AC
83727 (S): 28.4 AC

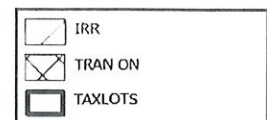

CLAIM OF BENEFICIAL USE MAP

NAME: NAUMES
TAXLOT #: 100 8.16 AC
NESW 3.34 AC
NWSE 4.82 AC

CERTIFICATE #:
79212 (IR)
83724 (IS)