

TALENT IRRIGATION DISTRICT

P.O. Box 467
104 W. Valley View Rd.
Talent OR 97540-0467



Phone: 541-535-1529
Fax: 541-535-4108
Email: tid@talentid.org
Web: www.talentid.org

CLAIM OF BENEFICIAL USE 1916-2016

Priority Mail

January 20, 2025

Ann Reece
Oregon Water Resources Department
725 Summer Street NE Suite A
Salem, OR 97301-1271

RE: Claim of Beneficial Use for T-10277 **District Transfer Year: 2006**

Dear Ann:

Enclosed is Talent Irrigation District's form entitled "District Permanent Water Right Transfer Claim of Beneficial Use" for your Transfer Number T-10277. Also enclosed are the "Claim of Beneficial Use Site Reports" and copies of the "To" land maps showing the new location of the water rights on each property. The following is a summary of the transfers listed with our internal file number and landowner name:

<u>TID FILE NO.</u>	<u>NAME</u>
04-1	Sage & Jenna Jensen (Jerry & Debra Quast)
04-2	Daniel & Virginia McGregor
04-3	Brandt Cullen (Wes & Marian Froelich)
04-4	Russel & Dana Reynolds (Catharine Church)
04-5	Jay & Rose Graham
04-21	Richard Schultz
04-23	Shawn McLoughlin
04-26	Pratt Family Trust Et Al (Sophia Cochran)
04-27	3115 Deer Trail LLC (Gene Morgan)
04-28	Robin Bell (Jann & Elizabeth Williams)
04-29	Gary & Deborah Jones Living Trust (Jann & Elizabeth Williams)
04-31	Etherly-Van Wambeke Trust (Robert & Debra Christian)
04-31	Eckmann Family Trust (Robert & Debra Christian)
04-31	Allyson Brown Living Trust (Robert & Debra Christian)
04-32	Nicholas Baida & Angelica Monroy (Jean James & Ruth Wink)
04-36	Stuart & Lynn Smith
04-51	Silbowitz Family Trust (Alfred & Virginia Silbowitz)
04-53	Dodds Family Trust (Stephen & Rebekah Dodds)
04-54	J E Kastroll & M K McCully
04-55	Debra Diane Blair & Emily Len Coleman
04-56	Willis & Lizbeth Lee
04-57	Kris Yvon Yenney (Herman & Mavis Blum)
04-59	Kenneth & Amy Korth


04-61	Wilson Family Trust (B. Conrad & S. Claypool)
05-1	James & Karen Hughes
05-1	Julie L Hauge Gray (Donald & Julie Gray)
05-2	Mount Family Living Trust (Michael & Patricia Benton)
05-3	Silver Spring Farm LLC (Laura Schleining)
05-4	Kenne Troy LLC (Ron & Susan Crowell)
05-4	261 Holdings LLC (Ron & Susan Crowell)
05-5	Jorge Yant (David White)
05-9	Barry & Susan Miller (C & G James / Claire Elliott)
05-10	Trevor & Bree Peterson (Peter & Vera Kirkpatrick)
05-12	Columbia Vista LLC (Raul & Thalia Keple)
05-15	Richard & Karen Titus Family Trust
05-16	Gerry & Dyan Osterland
05-19	Charlene, Ben & Marie Davol (Howard & Charlene Davol)
05-20	Grupe' Family Trust (Darryl & Laurie Grupe')
05-23	Elaine Henry Living Trust (Elaine Henry)
05-25	HEP Enterprises LLC (Scott & Susan Wood)
05-26	C F Stewart Ltd
05-27	Heaslip Revocable Living Trust (Mark & Stacy Skillman)
05-35	John & Helen Gritsch
05-35	Gritsch Company LLC
05-36	Lynda Marikos Trust
05-39	Robinson Family Trust (Jason & Christine Robinson)
05-42	Deason Family Trust (John & Virginia Deason)
05-43	Nancy/Reed Bentley & Bonnie Crimson (Mack & Amy Ransom)
05-44	Roger Rolfsness
05-45	Rasmussen Revocable Living Trust (Cecil & Patricia Pierson)
05-47	Stephen & Kathleen Foley
06-1	Mary Elizabeth Taylor (Carolyn Kyzer)
06-4	Gary & Gabriella Yamamura (Larry & Jill Henderson)

The Site Reports are attached to each map and are signed by the District representative inspecting each property. Specific details about the properties are contained in each site report.

The District has inspected all of the above parcels to confirm that the changes have been made as mapped and contained in the final proof report.

I hereby certify the changes are completed as authorized and that each property has met their Claim of Beneficial Use as mapped.

I am authorized to sign on behalf of Talent Irrigation District.

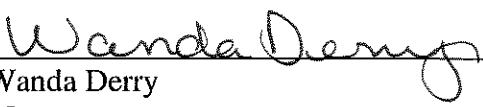

Wanda Derry
Manager
Talent Irrigation District

Date: 1-20-2025

Enclosures



Oregon Water Resources Department
725 Summer Street NE, Suite A
Salem, Oregon 97301-1266
(503) 986-0900
www.wrd.state.or.us

District Permanent Water Right Transfer Claim of Beneficial Use

1. APPLICANT INFORMATION

District: Talent Irrigation District District Transfer Year: 2006
Contact Person: Wanda Derry, Manager Phone: 541-535-1529
Mailing Address: PO Box 467
City: Talent State: OR Zip: 97540
E-Mail address: tid@talentid.org
Transfer Number: T - 10277

2. WATER RIGHT(S)

Pursuant to OAR Chapter 690, Division 385, the district is submitting to the Water Resources Department this claim of beneficial use, with the appropriate fee, for the following water right(s):

NOTE: Fees do not apply if the priority date is prior to July 9, 1987.

PERMIT NUMBER	CERTIFICATE NUMBER	DECREE (name, volume, and page)	PRIMARY (P) OR SUPP (S)
-	83727		☒ P ☒ S
-	79212		☒ P ☒ S
-			☐ P ☐ S
-			☐ P ☐ S

3. AUTHORIZED POINT(S) OF DIVERSION (POD) / APPROPRIATION (POA)

The authorized point(s) of diversion / appropriation for the water right modified by the transfer are as follows:

PERMIT NUMBER	DECREE or CERTIFICATE	POD / POA #	SOURCE	LOCATION – MEASURED DISTANCES
-	79212			SEE ATTACHED POD CERTIFICATE TABLE
-	83727			SEE ATTACHED POD CERTIFICATE TABLE
-				
-				

1/21/2025

OWRD

4. AUTHORIZED PLACE OF USE

The summary of the perfected change in place of use authorized by the final order approving the water right transfer is listed in Table 1.

TABLE 1 – AUTHORIZED PLACE OF USE (POU)												
CERTIFICATE DECREE or PERMIT	DIN #	POD / POA #	PRIORITY DATE	USE	LEGAL DESCRIPTION						ACRES	USER NAME
					TWP	RNG	SEC	QQ	DLC	GOV'T LOT	TAX LOT	
79212	04-1	ALL	5/23/1912	IR	39S	1E	2	SE NW			208	Sage/Jenna Jensen (Jerry/Debra Quast)
83727	04-1	ALL	9/16/1915	IS	39S	1E	2	SE NW			208	Sage/Jenna Jensen (Jerry/Debra Quast)
79212	04-2	ALL	5/23/1912	IR	39S	1E	2	NE NW			207	Daniel/Virginia McGregor
83727	04-2	ALL	9/16/1915	IS	39S	1E	2	NE NW			207	Daniel/Virginia McGregor
79212	04-2	ALL	5/23/1912	IR	39S	1E	2	NE NW			247	Daniel/Virginia McGregor
83727	04-2	ALL	9/16/1915	IS	39S	1E	2	NE NW			247	Daniel/Virginia McGregor
79212	04-3	ALL	5/23/1912	IR	39S	1E	2	NE NW			206	Brandt Cullen (Wes/Marian Froelich)
83727	04-3	ALL	9/16/1915	IS	39S	1E	2	NE NW			206	Brandt Cullen (Wes/Marian Froelich)
79212	04-4	ALL	5/23/1912	IR	39S	1E	2	SE NW			225	Russell/Dana Reynolds (Catharine Church)
83727	04-4	ALL	9/16/1915	IS	39S	1E	2	SE NW			225	Russell/Dana Reynolds (Catharine Church)
79212	04-4	ALL	5/23/1912	IR	39S	1E	2	NE NW			225	Russell/Dana Reynolds (Catharine Church)
83727	04-4	ALL	9/16/1915	IS	39S	1E	2	NE NW			225	Russell/Dana Reynolds (Catharine Church)
79212	04-5	ALL	5/23/1912	IR	38S	2W	12	SW SE			2000	Jay/Rose Graham
83727	04-5	ALL	9/16/1915	IS	38S	2W	12	SW SE			2000	Jay/Rose Graham
79212	04-5	ALL	5/23/1912	IR	38S	2W	12	SE SW			2000	Jay/Rose Graham
83727	04-5	ALL	9/16/1915	IS	38S	2W	12	SE SW			2000	Jay/Rose Graham
83727	04-21	ALL	9/16/1915	IR	38S	1E	34	SW SE			205	Richard Schultz
83727	04-21	ALL	9/16/1915	IR	38S	1E	34	SW SE			208	Richard Schultz
79212	04-23	ALL	5/23/1912	IR	38S	2W	2C	SE SW			1700	Shawn McLoughlin
83727	04-23	ALL	9/16/1915	IS	38S	2W	2C	SE SW			1700	Shawn McLoughlin

83727	04-26	ALL	9/16/1915	IR	38S	1W	18	NE SW			1604	1.80	Pratt Family Trust Et Al (Sophia Cochran)
83727	04-26	ALL	9/16/1915	IR	38S	1W	18	SW SE			1604	.70	Pratt Family Trust Et Al (Sophia Cochran)
79212	04-27	ALL	5/23/1912	IR	38S	1W	20	SE NW			1700	.70	3115 Deer Trail LLC (Gene Morgan)
83727	04-27	ALL	9/16/1915	IS	38S	1W	20	SE NW			1700	.70	3115 Deer Trail LLC (Gene Morgan)
79212	04-27	ALL	5/23/1912	IR	38S	1W	20	SE NE			1700	3.60	3115 Deer Trail LLC (Gene Morgan)
83727	04-27	ALL	9/16/1915	IS	38S	1W	20	SW NE			1700	3.60	3115 Deer Trail LLC (Gene Morgan)
83727	04-28	ALL	9/16/1915	IR	38S	1W	12	SW SE			700	4.11	Robin Bell (Jann/Elizabeth Williams)
83727	04-28	ALL	9/16/1915	IR	38S	1W	12	NW SE			700	.04	Robin Bell (Jann/Elizabeth Williams)
79212	04-29	ALL	5/23/1912	IR	39S	1E	15AC	SW NE			7300	.12	Gary/Deborah Jones Liv Tr (Jann/Elizabeth Williams)
83727	04-29	ALL	9/16/1915	IS	39S	1E	15AC	SW NE			7300	.12	Gary/Deborah Jones Liv Tr (Jann/Elizabeth Williams)
79212	04-31	ALL	5/23/1912	IR	38S	1W	7	SW SE			2000	.40	Etherly-Van Wambeke Tr (Robert/Debra Christian)
83727	04-31	ALL	9/16/1915	IS	38S	1W	7	SW SE			2000	.40	Etherly-Van Wambeke Tr (Robert/Debra Christian)
79212	04-31	ALL	5/23/1912	IR	38S	1W	7	SW SE			2100	1.40	Eckmann Family Trust (Robert/Debra Christian)
83727	04-31	ALL	9/16/1915	IS	38S	1W	7	SW SE			2100	1.40	Eckmann Family Trust (Robert/Debra Christian)
79212	04-31	ALL	5/23/1912	IR	38S	1W	18	NW NE			2000	2.90	Allyson Brown Living Tr (Robert/Debra Christian)
83727	04-31	ALL	9/16/1915	IS	38S	1W	18	NW NE			2000	2.90	Allyson Brown Living Tr (Robert/Debra Christian)
79212	04-32	ALL	5/23/1912	IR	39S	1E	11	NE SE			501	.50	N. Baida/A. Monroy (James Jean/Wink Ruth)
83727	04-32	ALL	9/16/1915	IS	39S	1E	11	NE SE			501	.50	N. Baida/A. Monroy (James Jean/Wink Ruth)
79212	04-36	ALL	5/23/1912	IR	38S	1W	14	SW SE			2502	3.00	Stuart/Lynn Smith
83727	04-36	ALL	9/16/1915	IS	38S	1W	14	SW SE			2502	3.00	Stuart/Lynn Smith

79212	04-51	ALL	5/23/1912	IR	38S	1E	35	NW SW			200	2.06	Silbowitz Family Tr (Alfred/Virginia Silbowitz)
83727	04-51	ALL	9/16/1915	IS	38S	1E	35	NW SW			200	2.06	Silbowitz Family Tr (Alfred/Virginia Silbowitz)
79212	04-51	ALL	5/23/1912	IR	38S	1E	35	NW SW			201	2.12	Silbowitz Family Tr (Alfred/Virginia Silbowitz)
83727	04-51	ALL	9/16/1915	IS	38S	1E	35	NW SW			201	2.12	Silbowitz Family Tr (Alfred/Virginia Silbowitz)
79212	04-51	ALL	5/23/1912	IR	38S	1E	35	NW SW			202	8.65	Silbowitz Family Tr (Alfred/Virginia Silbowitz)
83727	04-51	ALL	9/16/1915	IS	38S	1E	35	NW SW			202	8.65	Silbowitz Family Tr (Alfred/Virginia Silbowitz)
83727	04-51	ALL	9/16/1915	IR	38S	1E	35	NW SW			202	4.20	Silbowitz Family Tr (Alfred/Virginia Silbowitz)
79212	04-51	ALL	5/23/1912	IR	38S	1E	35	NW SW			203	20.53	Silbowitz Family Tr (Alfred/Virginia Silbowitz)
83727	04-51	ALL	9/16/1915	IS	38S	1E	35	NW SW			203	20.53	Silbowitz Family Tr (Alfred/Virginia Silbowitz)
83727	04-53	ALL	9/16/1915	IR	38S	1E	34	SE SE			101 (500)	5.00	Dodds Family Trust (Stephen/Rebekah Dodds)
83727	04-54	ALL	9/16/1915	IR	38S	1E	35	SW SW			702	2.00	J E Kastroll/ M K McCully
83727	04-55	ALL	9/16/1915	IR	38S	1E	35	SW SW			500	1.00	D D Blair/E L Coleman
79212	04-56	ALL	5/23/1912	IR	38S	1E	35	SW SW			700	22.95	Willis/Lizbeth Lee
83727	04-56	ALL	9/16/1915	IS	38S	1E	35	SW SW			700	22.95	Willis/Lizbeth Lee
79212	04-57	ALL	5/23/1912	IR	38S	1E	35	SW SW			600	3.44	Kris Yvon Yenney (Herman/Mavis Blum)
83727	04-57	ALL	9/16/1915	IS	38S	1E	35	SW SW			600	3.44	Kris Yvon Yenney (Herman/Mavis Blum)
83727	04-59	ALL	9/16/1915	IR	38S	1E	35	SW SW			502	.50	Kenneth/Amy Korth
83727	04-61	ALL	9/16/1915	IR	38S	1E	35	NE SW			302	2.00	Wilson Family Trust (B Conrad/S Claypool)
79212	05-1	ALL	5/23/1912	IR	38S	1W	18	SE NE			200	.43	James/Karen Hughes
83727	05-1	ALL	9/16/1915	IS	38S	1W	18	SE NE			200	.43	James/Karen Hughes
79212	05-1	ALL	5/23/1912	IR	38S	1W	18	NE SE			200	4.57	James/Karen Hughes
83727	05-1	ALL	9/16/1915	IS	38S	1W	18	NE SE			200	4.57	James/Karen Hughes
79212	05-1	ALL	5/23/1912	IR	38S	1W	18	NE SE			2001	1.90	Julie L Hauge Gray (Donald/Julie Gray)

83727	05-1	ALL	9/16/1915	IS	38S	1W	18	NE SE			2001	1.90	Julie L Hauge Gray (Donald/Julie Gray)
79212	05-1	ALL	5/23/1912	IR	38S	1W	18	SE SE			2001	2.00	Julie L Hauge Gray (Donald/Julie Gray)
83727	05-1	ALL	9/16/1915	IS	38S	1W	18	SE SE			2001	2.00	Julie L Hauge Gray (Donald/Julie Gray)
83727	05-2	ALL	9/16/1915	IR	38S	2W	14	NW NW			209	.60	Mount Family Liv Tr (Michael/Patricia Benton)
83727	05-2	ALL	9/16/1915	IR	38S	2W	15	NE NE			209	4.90	Mount Family Liv Tr (Michael/Patricia Benton)
79212	05-3	ALL	5/23/1912	IR	38S	1E	34	SE SE			100	.70	Silver Spring Farm LLC (Lara Schleining)
83727	05-3	ALL	9/16/1915	IS	38S	1E	34	SE SE			100	.70	Silver Spring Farm LLC (Lara Schleining)
83727	05-3	ALL	9/16/1915	IR	38S	1E	34	SE SE			100	12.67	Silver Spring Farm LLC (Lara Schleining)
79212	05-3	ALL	5/23/1912	IR	39S	1E	3	NE NE			100	2.50	Silver Spring Farm LLC (Lara Schleining)
83727	05-3	ALL	9/16/1915	IS	39S	1E	3	NE NE			100	2.50	Silver Spring Farm LLC (Lara Schleining)
79212	05-3	ALL	5/23/1912	IR	39S	1E	3	NE NE			100	1.40	Silver Spring Farm LLC (Lara Schleining)
83727	05-3	ALL	9/16/1915	IS	39S	1E	3	NE NE			100	1.40	Silver Spring Farm LLC (Lara Schleining)
79212	05-3	ALL	5/23/1912	IR	39S	1E	3	NE NE			100	5.10	Silver Spring Farm LLC (Lara Schleining)
83727	05-3	ALL	9/16/1915	IS	39S	1E	3	NE NE			100	5.10	Silver Spring Farm LLC (Lara Schleining)
79212	05-3	ALL	5/23/1912	IR	38S	1E	34	SE SE			100	.43	Silver Spring Farm LLC (Lara Schleining)
83727	05-3	ALL	9/16/1915	IS	38S	1E	34	SE SE			100	.43	Silver Spring Farm LLC (Lara Schleining)
83727	05-3	ALL	9/16/1915	IR	39S	1E	3	NE NE			100	1.90	Silver Spring Farm LLC (Lara Schleining)
83727	05-4	ALL	9/16/1915	IR	39S	2E	19	NW NE			133	.70	Keene Troy LLC (Ron/Susan Crowell)
83727	05-4	ALL	9/16/1915	IR	39S	2E	19	NW NE			134	1.70	261 Holdings LLC (Ron/Susan Crowell)

1/21/2025

OWRD

83727	05-4	ALL	9/16/1915	IR	39S	2E	19	NW NE			134	.30	261 Holdings LLC (Ron/Susan Crowell)
83727	05-4	ALL	9/16/1915	IR	39S	2E	19	SW NE			134	.30	261 Holdings LLC (Ron/Susan Crowell)
83727	05-5	ALL	9/16/1915	IR	39S	2E	19	NE NE			130	1.00	Jorge Yant (David White)
83727	05-9	ALL	9/16/1915	IR	39S	2E	19	NE NE			129	1.00	Barry/Susan Miller (James c/g and Claire Elliott)
83727	05-10	ALL	9/16/1915	IR	39S	2E	19	SE NE			110	1.00	Trevor/Bree Peterson (Peter/Vera Kirkpatrick)
83727	05-10	ALL	9/16/1915	IR	39S	2E	19	SE NE			110	1.00	Trevor/Bree Peterson (Peter/Vera Kirkpatrick)
83727	05-10	ALL	9/16/1915	IR	39S	2E	19	SE NE			128	1.00	Trevor/Bree Peterson (Peter/Vera Kirkpatrick)
83727	05-10	ALL	9/16/1915	IR	39S	2E	19	SE NE			128	1.00	Trevor/Bree Peterson (Peter/Vera Kirkpatrick)
79212	05-12	ALL	5/23/1912	IR	39S	2E	20	NE SW			505	.50	Columbia Vista LLC (Raul/Thalia Keple)
83727	05-12	ALL	9/16/1915	IS	39S	2E	20	NE SW			505	.50	Columbia Vista LLC (Raul/Thalia Keple)
79212	05-15	ALL	5/23/1912	IR	39S	2E	20	SW NW			400	.40	Richard/Karen Titus Fam Tr
83727	05-15	ALL	9/16/1915	IS	39S	2E	20	SW NW			400	.40	Richard/Karen Titus Fam Tr
83727	05-15	ALL	9/16/1915	IR	39S	2E	20	SW NW			400	.60	Richard/Karen Titus Fam Tr
83727	05-16	ALL	9/16/1915	IR	39S	2E	20	SW NW			405	.80	Gerry/Dyan Osterland
83727	05-16	ALL	9/16/1915	IR	39S	2E	20	NW NW			405	.20	Gerry/Dyan Osterland
83727	05-19	ALL	9/16/1915	IR	39S	2E	19	NE SE			123	.20	Charlene/Ben/Marie Davol (Howard/Charlene Davol)
83727	05-19	ALL	9/16/1915	IR	39S	2E	19	SE SE			123	1.80	Charlene/Ben/Marie Davol (Howard/Charlene Davol)
83727	05-20	ALL	9/16/1915	IR	39S	2E	19	SW SE			2101	1.60	Grupe' Family Trust (Darryl/Laurie Grupe')
83727	05-20	ALL	9/16/1915	IR	39S	2E	30	NW NE			2101	.40	Grupe' Family Trust (Darryl/Laurie Grupe')
79212	05-23	ALL	5/23/1912	IR	39S	2E	19	NW SE			113	1.17	Elaine Henry Living Trust
83727	05-23	ALL	9/16/1915	IS	39S	2E	19	NW SE			113	1.17	Elaine Henry Living Trust
83727	05-23	ALL	9/16/1915	IR	39S	2E	19	NW SE			113	.83	Elaine Henry Living Trust
83727	05-25	ALL	9/16/1915	IR	39S	2E	19	NE SE			114	1.00	HEP Enterprises LLC (Scott/Susan Wood)

79212	05-26	ALL	5/23/1912	IR	39S	2E	19	SW SE				117	2.30	C F Stewart Ltd
83727	05-26	ALL	9/16/1915	IS	39S	2E	19	SW SE				117	2.30	C F Stewart Ltd
83727	05-26	ALL	9/16/1915	IR	39S	2E	19	SW SE				117	1.10	C F Stewart Ltd
83727	05-26	ALL	9/16/1915	IR	39S	2E	19	NW SE				117	.60	C F Stewart Ltd
83727	05-27	ALL	9/16/1915	IR	39S	2E	30	SW NE				107	1.60	Heaslip Rev Liv Trust (Mark/Stacy Skillman)
83727	05-27	ALL	9/16/1915	IR	39S	2E	30	SE NE				107	1.40	Heaslip Rev Liv Trust (Mark/Stacy Skillman)
79212	05-35	ALL	5/23/1912	IR	38S	1W	17	SW NW				4403	1.25	John/Helen Gritsch
83727	05-35	ALL	9/16/1915	IS	38S	1W	17	SW NW				4403	1.25	John/Helen Gritsch
79212	05-35	ALL	5/23/1912	IR	38S	1W	17	SE NW				4404	.75	Gritsch Company LLC
83727	05-35	ALL	9/16/1915	IS	38S	1W	17	SE NW				4404	.75	Gritsch Company LLC
83727	05-36	ALL	9/16/1915	IR	38S	1E	20	SW SE				901	2.00	Lynda Marikos Trust
79212	05-39	ALL	5/23/1912	IR	38S	1W	09C	SW SW				700	2.00	Robinson Famil Trust (Jason/Christine Robinson)
83727	05-39	ALL	9/16/1915	IS	38S	1W	09C	SW SW				700	2.00	Robinson Famil Trust (Jason/Christine Robinson)
83727	05-42	ALL	9/16/1915	IR	38S	2W	15	NE NE				205	.90	Deason Family Trust (John/Virgina Deason)
83727	05-42	ALL	9/16/1915	IR	38S	2W	15	SE NE				205	.10	Deason Family Trust (John/Virgina Deason)
79212	05-43	ALL	5/23/1912	IR	39S	1E	15CA	NW SE				122	.25	Nancy/Reed Bently & Bonnie Crimmon (Ransom)
83727	05-43	ALL	9/16/1915	IS	39S	1E	15CA	NW SE				122	.25	Nancy/Reed Bently & Bonnie Crimmon (Ransom)
83727	05-44	ALL	9/16/1915	IR	39S	2E	30	SE SE				110	.20	Roger Rolfsness
83727	05-44	ALL	9/16/1915	IR	39S	2E	30	NE SE				110	2.80	Roger Rolfsness
79212	05-45	ALL	5/23/1912	IR	38S	2W	13	NE SW				2619	1.50	Rasmussen Rev Liv Trust (Cecil/Patricia Pierson)
83727	05-45	ALL	9/16/1915	IS	38S	2W	13	NE SW				2619	1.50	Rasmussen Rev Liv Trust (Cecil/Patricia Pierson)
79212	05-47	ALL	5/23/1912	IR	39S	2E	19	SE NE				125	2.00	Stephen/Kathleen Foley
83727	05-47	ALL	9/16/1915	IS	39S	2E	19	SE NE				125	2.00	Stephen/Kathleen Foley
79212	06-1	ALL	5/23/1912	IR	38S	1W	16C	NW SW				2505	1.00	Mary Elizabeth Tayler (Carolyn Kyzer)
83727	06-1	ALL	9/16/1915	IS	38S	1W	16C	NW SW				2505	1.00	Mary Elizabeth Tayler (Carolyn Kyzer)

E-RECEIVED
1/21/2025
WRD

83727	06-4	ALL	9/16/1915	IR	39S	2E	19	SW NE		135	.90	Gary/Gabriella Yamamura (Larry/Jill Henderson)
83727	06-4	ALL	9/16/1915	IR	39S	2E	19	NW NE		135	.10	Gary/Gabriella Yamamura (Larry/Jill Henderson)
TOTAL											334.09	

*Wherever primary irrigation (IR) is being perfected under C 79212, supplemental irrigation is also being perfected under C 83727 (IS)

5. MAP AND SITE REPORT

☒ Attached is a map and site report for each water right listed in Table 1 that satisfies the requirements of OAR 690-385-7400.

6. SIGNATURES

The district certifies that it has inspected the place of use listed in Table I, and confirms the change in place of use has been completed consistent with the terms and conditions of the final order approving the transfer.

Wanda Derry
Signature of District Manager
or District Board Chairperson

1-20-2025
Date

Wanda Derry
Type or Print Name of District Manager
or District Board Chairperson

Certificate 79212: Authorized Sources, Tributaries (Trib.), Priority Dates and description of Points of Diversion:

Source	Trib.	Priority Date	Twp	Rng	Mer	Sec	Q-Q	Measured Distances/Description
Emigrant Creek	Bear Creek	05/23/1912	39 S	2 E	WM	20	SE SE	POINT OF DIVERSION IS LOCATED AT THE TOE OF EMIGRANT DAM
McDonald Creek	Little Applegate River	08/20/1915	40 S	1 W	WM	10	SE SE	INTO MCDONALD CREEK CANAL; 700 FEET NORTH AND 300 FEET WEST FROM THE SE CORNER OF SECTION 10
Greeley Creek	Little Applegate River	08/20/1915	40 S	1 W	WM	3	NW SE	INTO MCDONALD CREEK CANAL; 2400 FEET NORTH AND 2300 FEET WEST FROM THE SE CORNER OF SECTION 3
Bear Creek	Rogue River	07/31/1915	38 S	1 E	WM	33	SE SW	OAK STREET DAM; 150 FEET NORTH AND 2020 FEET EAST FROM THE SW CORNER OF SECTION 33
Neil Creek	Bear Creek	07/31/1915	39 S	2 E	WM	30	SE SW	ASHLAND LATERAL; 600 FEET NORTH AND 1350 FEET EAST FROM THE SW CORNER OF SECTION 30
Ashland Creek	Bear Creek	07/31/1915	39 S	1 E	WM	4	NE NW	710 FEET SOUTH AND 2000 FEET EAST FROM THE NW CORNER OF SECTION 4
Emigrant Creek	Bear Creek	07/31/1915	40 S	2 E	WM	2	SW NE	ASHLAND LATERAL; 520 FEET NORTH AND 1900 FEET WEST FROM THE E1/4 CORNER OF SECTION 2
Wagner Creek	Bear Creek	07/31/1915	39 S	1 W	WM	2	SW SE	UPPER WEST LATERAL; 100 FEET NORTH AND 1800 FEET WEST FROM THE SE CORNER OF SECTION 2
Wagner Creek	Bear Creek	07/31/1915	38 S	1 W	WM	35	SE SW	WEST LATERAL; 600 FEET NORTH AND 3600 FEET WEST FROM THE SE CORNER OF SECTION 35
Anderson Creek	Bear Creek	07/31/1915	38 S	1 W	WM	33	NE SE	2100 FEET NORTH AND 600 FEET WEST FROM THE SE CORNER OF SECTION 33
Anderson Creek	Bear Creek	07/31/1915	38 S	1 W	WM	34	NE NW	WEST LATERAL; 800 FEET SOUTH AND 2400 FEET EAST FROM THE NW CORNER OF SECTION 34
Anderson Creek	Bear Creek	07/31/1915	38 S	1 W	WM	27	NE NW	TALENT MIDDLE CANAL; 4000 FEET NORTH AND 2500 FEET EAST FROM THE SW CORNER OF SECTION 27
Coleman Creek	Bear Creek	09/06/1915	38 S	1 W	WM	20	SE NW	2100 FEET SOUTH AND 1500 FEET EAST FROM THE NW CORNER OF SECTION 20
Coleman Creek	Bear Creek	09/06/1915	38 S	1 W	WM	17	SE SE	TALENT MIDDLE CANAL; 900 FEET NORTH AND 1100 FEET WEST FROM THE SE CORNER OF SECTION 17
Kenutchen Creek (Knudsen Creek)	Bear Creek	09/06/1915	38 S	1 E	WM	18	SW NW	1450 FEET SOUTH AND 700 FEET EAST FROM THE NW CORNER OF SECTION 18

Source	Trib.	Priority Date	Twp	Rng	Mer	Sec	Q-Q	Measured Distances/Description
Meyers Creek (Myers Creek)	Bear Creek	09/06/1915	38 S	1 E	WM	20	SE SE	700 FEET NORTH AND 20 FEET WEST FROM THE SE CORNER OF SECTION 20
Butler Creek	Bear Creek	09/06/1915	38 S	1 E	WM	28	SE NW	2500 FEET SOUTH AND 2000 FEET EAST FROM THE NW CORNER OF SECTION 28
Keene Creek and Keene Creek Reservoir (Hyatt Reservoir)	Jenny Creek	05/23/1912	--	--	--	--	--	SOURCES ARE TRIBUTARIES OF JENNY CREEK IN THE KLAMATH RIVER BASIN. LIMITED TO 100 CFS
Keene Creek	Jenny Creek	09/06/1915	39 S	3 E	WM	16	SE SE	HYATT RESERVOIR; 15 FEET NORTH AND 1200 FEET WEST FROM THE SE CORNER OF SECTION 16
Keene Creek	Jenny Creek	09/06/1915	39 S	3 E	WM	20	SE SE	REDIVERSION-LITTLE HYATT POOL DIVERSION; 800 FEET NORTH AND 750 FEET WEST FROM THE SE CORNER OF SECTION 20
Keene Creek	Jenny Creek	09/06/1915	39 S	3 E	WM	33	SW SW	REDIVERSION AT KEENE CREEK DIVERSION DAM (beginning point of Green Springs Tunnel); 1200 FEET NORTH AND 1200 FEET EAST FROM THE SW CORNER OF SECTION 33
Emigrant Reservoir	Emigrant Creek	01/27/1920	39 S	2 E	WM	20	SE SE	POINT OF DIVERSION IS LOCATED AT THE TOE OF EMIGRANT DAM

CLAIM OF BENEFICIAL USE Site Report

Transfer Number: **T-10277**

District Internal Notice #: **04-1**

User Name: Sage & Nenna Jensen
(Jerry/Debra Quast)

Phone: 541-601-5265
Certificate: 79212 (IR)
Certificate: 83727 (IS)

Property: 300 Gaerky Crk. Rd., Ashland

Place of Use:

USE	POD #	TWP	RNG	SEC	QQ	DLC	GOV'T LOT	TAX LOT	ACRES
IR	ALL	39 S	1 E	02	SE NW			208	4.0
TOTAL ACRES =									4.0

District Conveyance System:

Description of Delivery System: Private Pump Station

Headgate: None Canal: East Main

Beneficial Use:

Description of Beneficial Use: Lawn & Garden

Method Used to Apply Water: Sprinkler irrigated. The water use is metered.

Method Used to Calculate Beneficial Use: Use confirmed by water order history.

User Interviewed: () Yes (X) No

Beneficial Use Made as Authorized: (X) Yes () No

Description of Beneficial Use if Less than Authorized:

None

Inspected By: Sharee Burns Date: 11/22/2024
Sharee Burns, Executive Assistant

Instructions: Attach and label the corresponding final proof map.

**JACKSON COUNTY
SEC. 02 T39S R1E**

SCALE - 1" = 400'



SE 1/4 OF THE NW 1/4


E-RECEIVED

1/21/2025

OWRD

T-10277

DIN-04-01

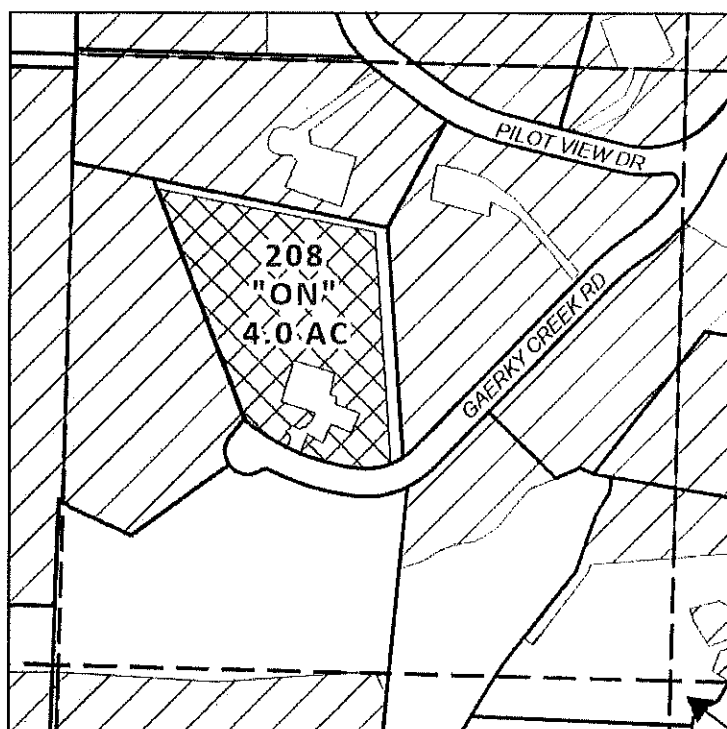

C 1/4
COR


EXISTING RIGHTS

CERTIFICATE #:

79212 (IR): 4.5 AC

83727 (IS): 4.5 AC

83727 (IR): 17.4 AC

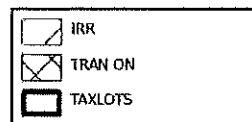

10/31/2024

CLAIM OF BENEFICIAL USE MAP

**NAME: SAGE & NENNA JENSEN
(JERRY & DEBRA QUAST)
TAXLOT #: 208 4.0 AC**

**ON LANDS
CERTIFICATE #:
79212 (IR): 4.0 AC
83727 (IS): 4.0 AC**

This map is not intended to provide legal dimensions
or locations of property ownership lines

CLAIM OF BENEFICIAL USE Site Report

Transfer Number: **T-10277**

District Internal Notice #: **04-2**

User Name: Daniel/Virginia McGregor

Phone: 541-482-4076

Certificate: 79212 (IR)

Certificate: 83727 (IS)

Property: 40 Pilot View Dr., Ashland

Place of Use:

USE	POD #	TWP	RNG	SEC	QQ	DLC	GOV'T LOT	TAX LOT	ACRES
IR	ALL	39 S	1 E	02	NE NW			207	4.5
IR	ALL	39 S	1 E	02	NE NW			247	3.0
TOTAL ACRES =									7.5

District Conveyance System:

Description of Delivery System: Private Pump Station

Headgate: None

Canal: Upper East

Beneficial Use:

Description of Beneficial Use: Lawn & Garden

Method Used to Apply Water: Sprinkler irrigated. The water use is metered.

Method Used to Calculate Beneficial Use: Confirmed use by history of meter readings.

User Interviewed: () Yes (X) No

Beneficial Use Made as Authorized: (X) Yes () No

Description of Beneficial Use if Less than Authorized:

None

Inspected By: Sharee O. Burns

Sharee Burns, Executive Assistant

Date: 11/22/2024

Instructions: Attach and label the corresponding final proof map.

JACKSON COUNTY
SEC. 02 T39S R1E

SCALE - 1" = 400'



NE 1/4 OF THE NW 1/4


E-RECEIVED

1/21/2025


OWRD

T-10277

DIN-04-02

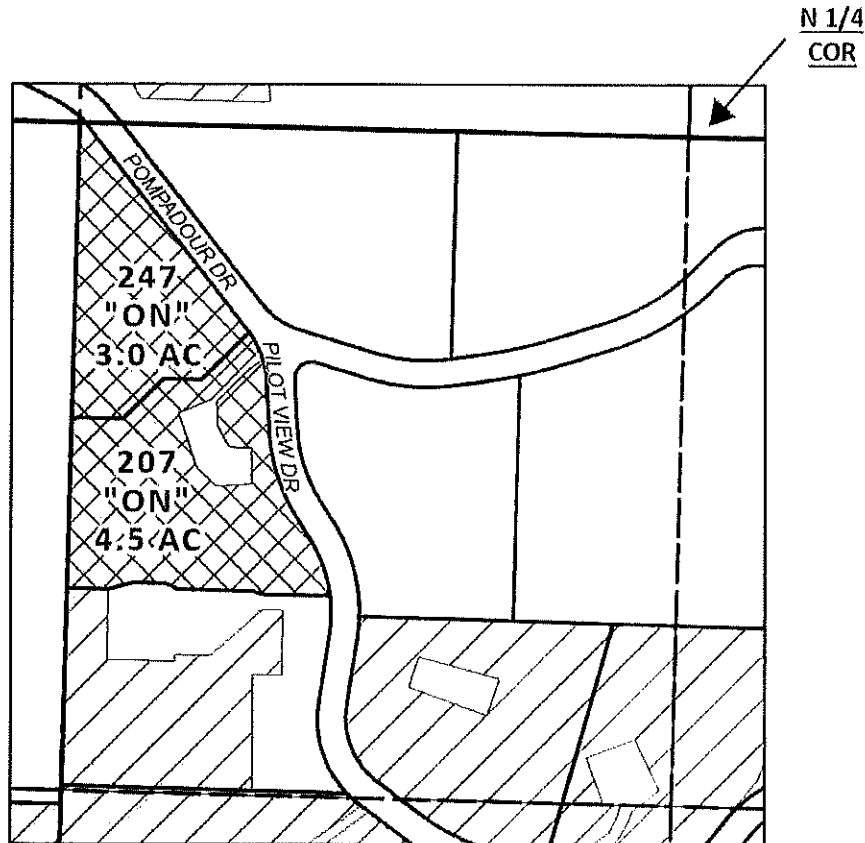

EXISTING RIGHTS
CERTIFICATE #:
79212 (IR): 0 AC
83727 (IS): 0 AC
83727 (IR): 5.5 AC

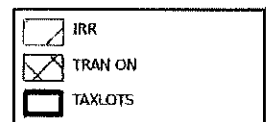

10/31/2024

CLAIM OF BENEFICIAL USE MAP

NAME: DANIEL & VIRGINIA MCGREGOR
TAXLOT #: 207 4.5 AC
TAXLOT #: 247 3.0 AC

ON LANDS
CERTIFICATE #:
79212 (IR): 7.5 AC
83727 (IS): 7.5 AC

This map is not intended to provide legal dimensions
or locations of property ownership lines.

CLAIM OF BENEFICIAL USE Site Report

Transfer Number: **T-10277**

District Internal Notice #: **04-3**

User Name: Brandt Cullen
(Wes/Marian Froelich)

Phone: 503-545-8325
Certificate: 79212 (IR)
Certificate: 83727 (IS)

Property: 120 Pilot View Dr., Ashland

Place of Use:

USE	POD #	TWP	RNG	SEC	QQ	DLC	GOVT LOT	TAX LOT	ACRES
IR	ALL	39 S	1 E	02	NE NW			206	3.3
TOTAL ACRES =									3.3

District Conveyance System:

Description of Delivery System: Private Pump Station

Headgate: None Canal: Upper East

Beneficial Use:

Description of Beneficial Use: Pasture

Method Used to Apply Water: Sprinkler irrigated. The water use is metered.

Method Used to Calculate Beneficial Use: Ariel map view verification comparing transfer map to the actual place of use 6/19/2024 HH

User Interviewed: () Yes (X) No

Beneficial Use Made as Authorized: (X) Yes () No

Description of Beneficial Use if Less than Authorized:

None

Inspected By: Sharee A. Burns Date: 10/14/2024
Sharee Burns, Executive Assistant

Instructions: Attach and label the corresponding final proof map.

**JACKSON COUNTY
SEC. 02 T39S R1E**

SCALE - 1" = 400'



NE 1/4 OF THE NW 1/4

E-RECEIVED

1/21/2025

QWRD


RECEIVED

JUL 29 2024


TALENT
IRRIGATION DISTRICT

T-10277

DIN-04-03

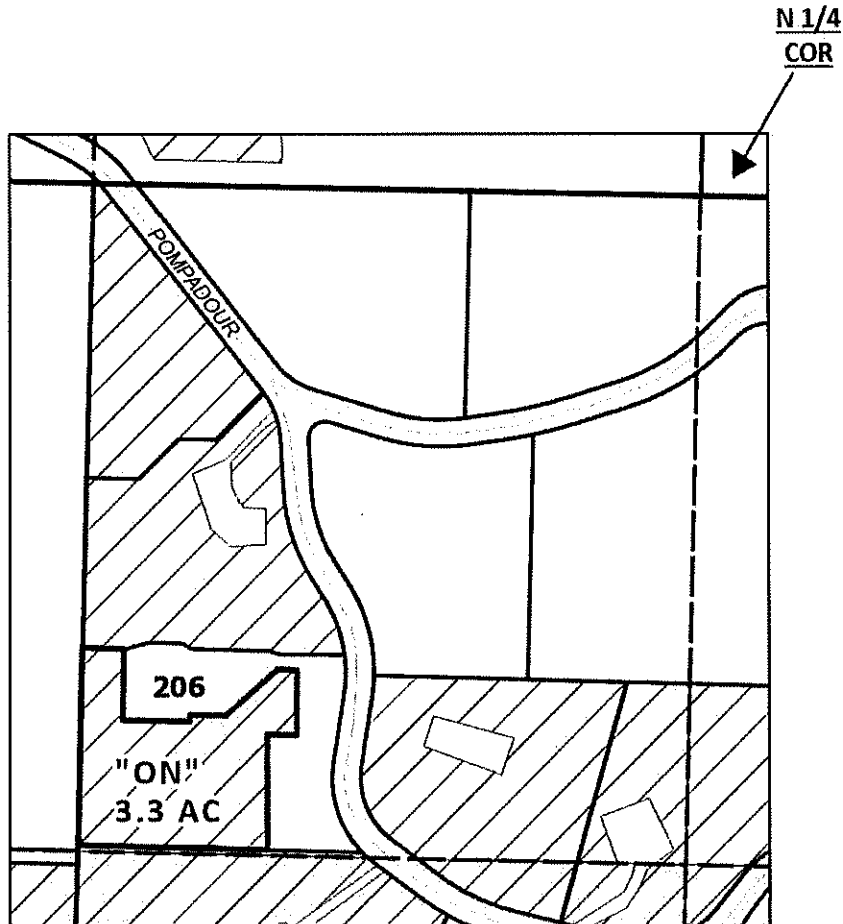

EXISTING RIGHTS
CERTIFICATE #:
79212 (IR): 0 AC
83727 (IS): 0 AC
83727 (IR): 5.5 AC

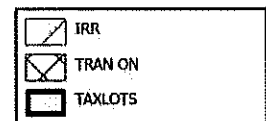

CLAIM OF BENEFICIAL USE MAP

NAME: BRANDT CULLEN (FROELICH)

ON LANDS
CERTIFICATE #:
79212 (IR): 3.3 AC
83727 (IS): 3.3 AC



CLAIM OF BENEFICIAL USE Site Report

Transfer Number: T-10277

District Internal Notice #: 04-4

User Name: Russell/Dana Reynolds
(Catharine Church)

Phone: 503-338-0484
Certificate: 79212 (IR)
Certificate: 83727 (IS)

Property: 166 Pilot View Dr., Ashland

Place of Use:

USE	POD #	TWP	RNG	SEC	QQ	DLC	GOV'T LOT	TAX LOT	ACRES
IR	ALL	39 S	1 E	02	SE NW			225	4.5
IR	ALL	39 S	1 E	02	NE NW			225	.2
TOTAL ACRES =									4.7

District Conveyance System:

Description of Delivery System: Private Pump Station

Headgate: None Canal: Upper East

Beneficial Use:

Description of Beneficial Use: Pasture

Method Used to Apply Water: Sprinkler irrigated. The water use is metered.

Method Used to Calculate Beneficial Use: Ariel map view verification comparing transfer map to the actual place of use 6/19/2024 HH

User Interviewed: () Yes (X) No

Beneficial Use Made as Authorized: (X) Yes () No

Description of Beneficial Use if Less than Authorized:

None

Inspected By: Sharee D. Burns Date: 10/14/2024
Sharee Burns, Executive Assistant

Instructions: Attach and label the corresponding final proof map.

JACKSON COUNTY SEC.02 T39S R1E

SCALE - 1" = 400'



E 1/2 OF THE NW 1/4

E-RECEIVED

1/21/2025

OWRD


RECEIVED

JUL 29 2024

TALENT
IRRIGATION DISTRICT




TRAN #: T-10277
DIN #:04-4

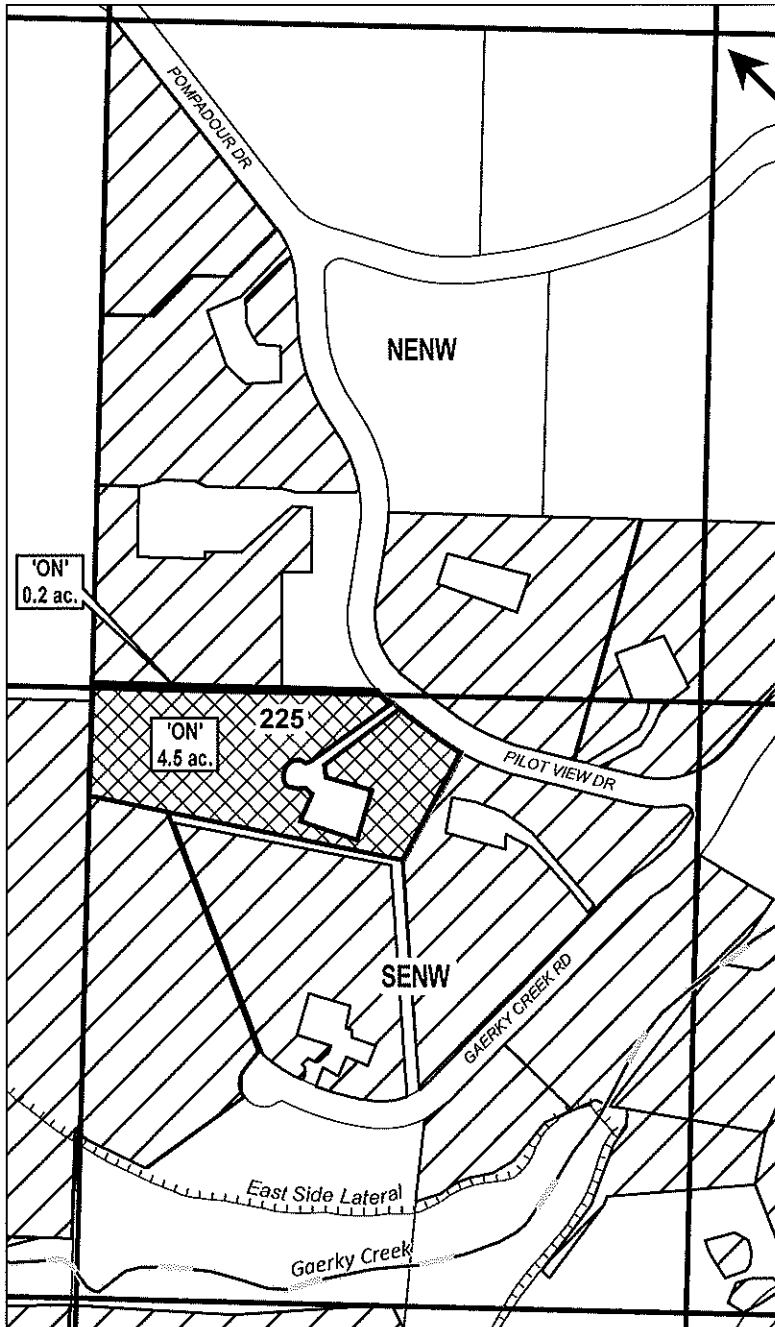

N 1/4 COR

EXISTING RIGHTS
CERTIFICATE #:
NENW
79212 (IR): 0.0 AC .
83727 (IS): 0.0 AC
83727 (IR): 5.5 AC
SENW:
79212 (IR): 0.0 AC .
83727 (IS): 0.0 AC
83727 (IR): 17.4 AC

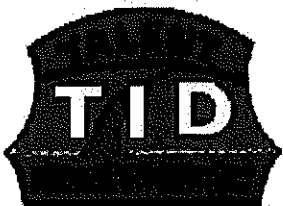

Date: 6/24/2024

CLAIM OF BENEFICIAL USE MAP
NAME: RUSSELL & DANA REYNOLDS (CHURCH)

NENW: 0.2 AC
SENW: 4.5 AC

CERTIFICATE #:
79212(IR)
83727(IR)
83727(IS)

CLAIM OF BENEFICIAL USE Site Report

Transfer Number: T-10277

District Internal Notice #: 04-5

User Name: Jay/Rose Graham

Phone: 541-772-4921

Certificate: 79212 (IR)

Certificate: 83727 (IS)

Property: 5580 Pioneer Rd., Medford

Place of Use: Tax Lot remapped to 382W12C 1900

USE	POD #	TWP	RNG	SEC	QQ	DLC	GOV'T LOT	TAX LOT	ACRES
IR	ALL	38 S	2 W	12	SW SE			2000	.6
IR	ALL	38 S	2 W	12	SE SW			2000	.4

TOTAL ACRES = 1.0

District Conveyance System:

Description of Delivery System: Private Turnout on W-5 pipeline

Headgate: None

Canal: West

Beneficial Use:

Description of Beneficial Use: Lawn & Landscaping

Method Used to Apply Water: Sprinkler irrigated. The water use is metered.

Method Used to Calculate Beneficial Use: Ariel map view verification comparing transfer map to the actual place of use 6/19/2024 HH

User Interviewed: () Yes (X) No

Beneficial Use Made as Authorized: (X) Yes () No

Description of Beneficial Use if Less than Authorized:

None

Inspected By: Sharee Burns
Sharee Burns, Executive Assistant

Date: 11/22/2024

Instructions: Attach and label the corresponding final proof map.

**JACKSON COUNTY
SEC. 12 T38S R2W**

SCALE - 1" = 400'



SE 1/4 OF THE SW 1/4; SW 1/4 OF THE SE 1/4


E-RECEIVED

1/21/2025

OWRD


T-10277

DIN-04-05

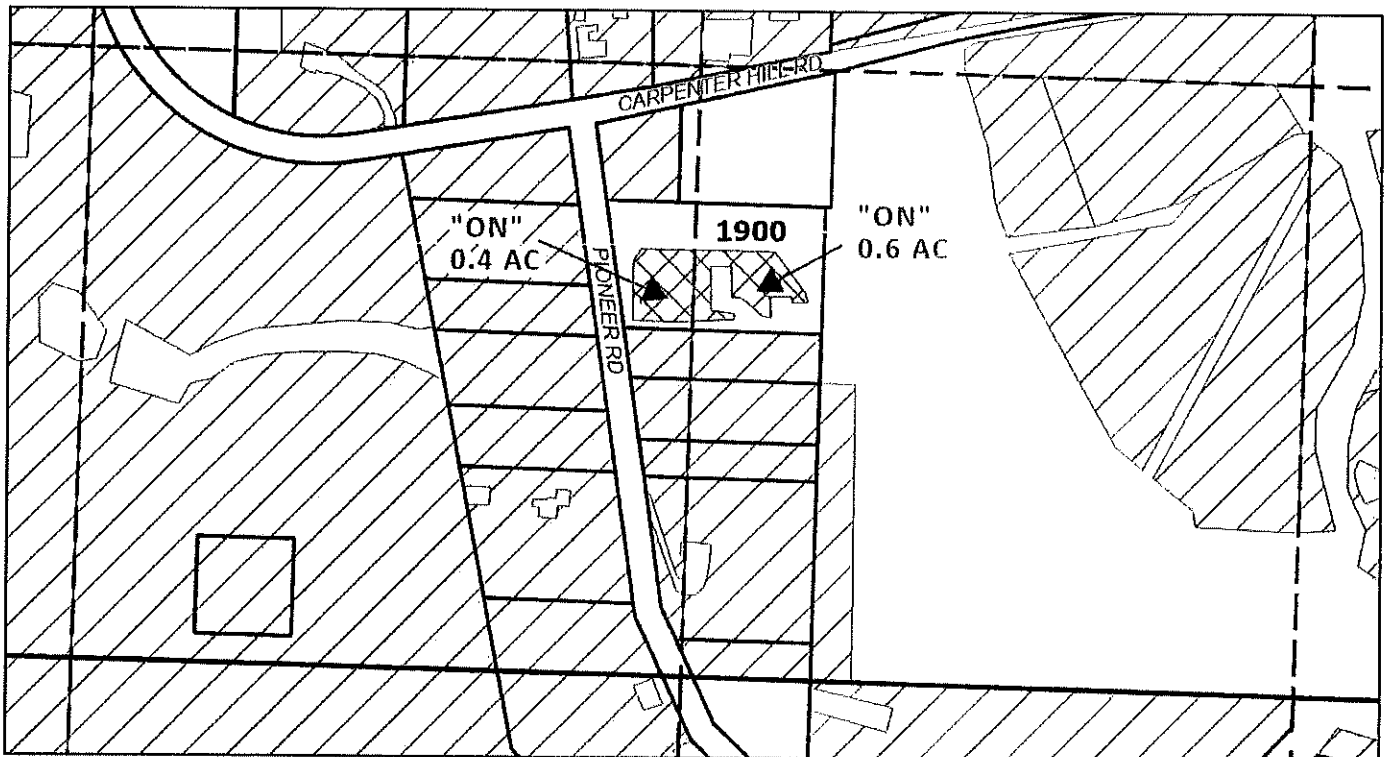

EXISTING RIGHTS
CERTIFICATE #:

SESW
79212 (IR): 33.7 AC
83727 (IS): 33.7 AC
SWSE
79212 (IR): 15.16 AC
83727 (IS): 15.16 AC
83727 (IR): 1.5 AC

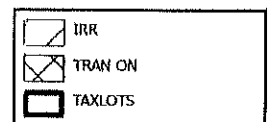

DATE: 11/04/2024

CLAIM OF BENEFICIAL USE MAP

NAME: JAY & ROSE GRAHAM
TAXLOT #: 1900 1.0 AC
SWSE: 0.6 AC
SESW: 0.4 AC

ON LANDS
CERTIFICATE #:
79212 (IR): 1.0 AC
83727 (IS): 1.0 AC

This map is not intended to provide legal dimensions
or locations of property ownership lines

CLAIM OF BENEFICIAL USE Site Report

Transfer Number: T-10277

District Internal Notice #: 04-21

User Name: Richard Schultz

Phone: 541-482-5170

Certificate: 83727 (IR)

Property: 1111 E. Nevada St., Ashland

Place of Use: Tax lot 205 remapped to 209

USE	POD #	TWP	RNG	SEC	QQ	DLC	GOVT LOT	TAX LOT	ACRES
IR	ALL	38 S	1 E	34	SW SE			208	.3
IR	ALL	38 S	1 E	34	SW SE			205, NOW 209	12.7
TOTAL ACRES =									13.0

District Conveyance System:

Description of Delivery System: Private Pump Station

Headgate: None Canal: Upper East

Beneficial Use:

Description of Beneficial Use: Vineyard

Method Used to Apply Water: Sprinkler irrigated. The water use is metered.

Method Used to Calculate Beneficial Use: Ariel map view verification comparing transfer map to the actual place of use 6/19/2024 HH

User Interviewed: () Yes (X) No

Beneficial Use Made as Authorized: (X) Yes () No

Description of Beneficial Use if Less than Authorized:

None

Inspected By: Sharee D. Burns

Sharee Burns, Executive Assistant

Date: 10/14/2024

Instructions: Attach and label the corresponding final proof map.

**JACKSON COUNTY
SEC. 34 T38S R1E**

SCALE - 1" = 400'



SW 1/4 OF THE SE 1/4


E-RECEIVED

1/21/2025

OWRD

T-10277

DIN-04-21


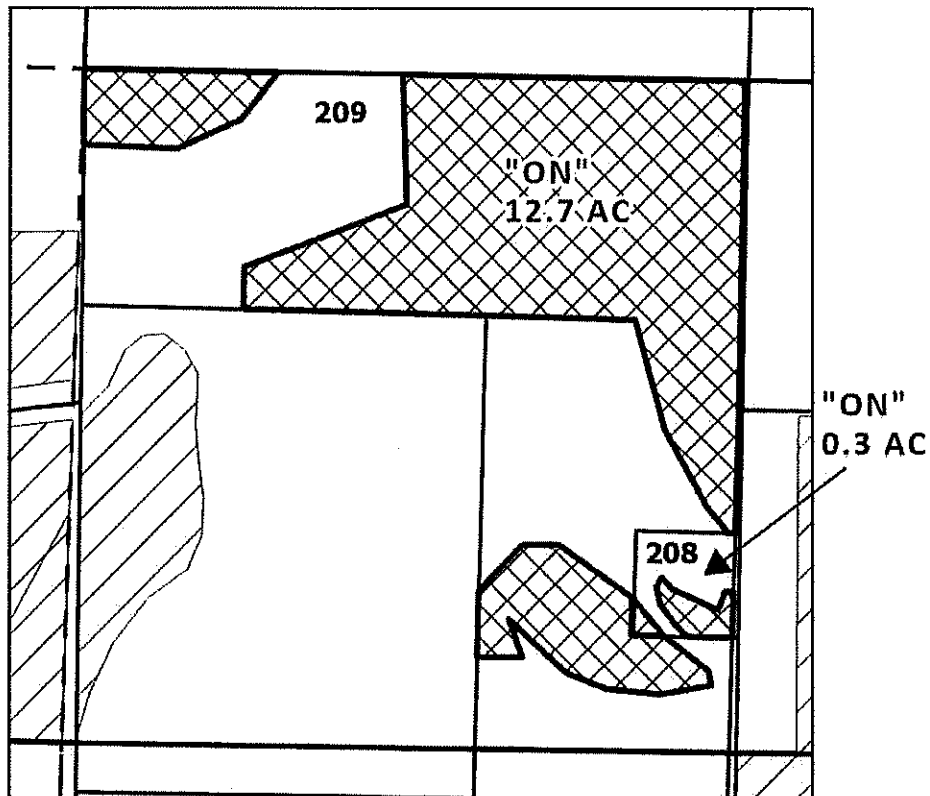


EXISTING RIGHTS
CERTIFICATE #:
83727 3.0 AC

RECEIVED

JUL 29 2024

TALENT
IRRIGATION DISTRICT

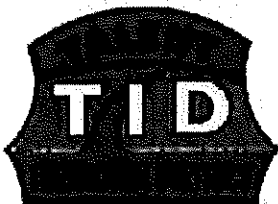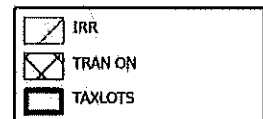

7/20/2024

CLAIM OF BENEFICIAL USE MAP

NAME: RICHARD & MARY SCHULTZ

TAXLOT #: 205 (NOW 209) 12.7 AC

TAXLOT #: 208 0.3 AC

ON LANDS
CERTIFICATE #:

83727 (IR): 13.0 AC

CLAIM OF BENEFICIAL USE Site Report

Transfer Number: T-10277

District Internal Notice #: 04-23

User Name: Shawn McLoughlin

Phone: 541-621-3869

Certificate: 79212 (IR)

Certificate: 83727 (IS)

Property: 2720 Griffin Creek Rd., Medford

Place of Use: Tax Lot remapped to 382WCD 100

USE	POD #	TWP	RNG	SEC	QQ	DLC	GOV'T LOT	TAX LOT	ACRES
IR	ALL	38 S	2 W	02C	SE SW			1700	.75
TOTAL ACRES =									.75

District Conveyance System:

Description of Delivery System: Private Pipeline and Pump Station off of the T-26 Lateral

Headgate: None

Canal: Talent

Beneficial Use:

Description of Beneficial Use: Lawn and Landscaping

Method Used to Apply Water: Sprinkler irrigated. The water use is metered.

Method Used to Calculate Beneficial Use: Ariel map view verification comparing transfer map to the actual place of use 6/19/2024 HH

User Interviewed: () Yes (X) No

Beneficial Use Made as Authorized: (X) Yes () No

Description of Beneficial Use if Less than Authorized:

None

Inspected By: Sharee Burns Date: 10/14/2024
Sharee Burns, Executive Assistant

Instructions: Attach and label the corresponding final proof map.

**JACKSON COUNTY
SEC. 02 T38S R2W**

SCALE - 1" = 400'



SE 1/4 OF THE SW 1/4


RECEIVED

JUL 29 2024



TALENT
IRRIGATION DISTRICT

T-10277

DIN-04-23

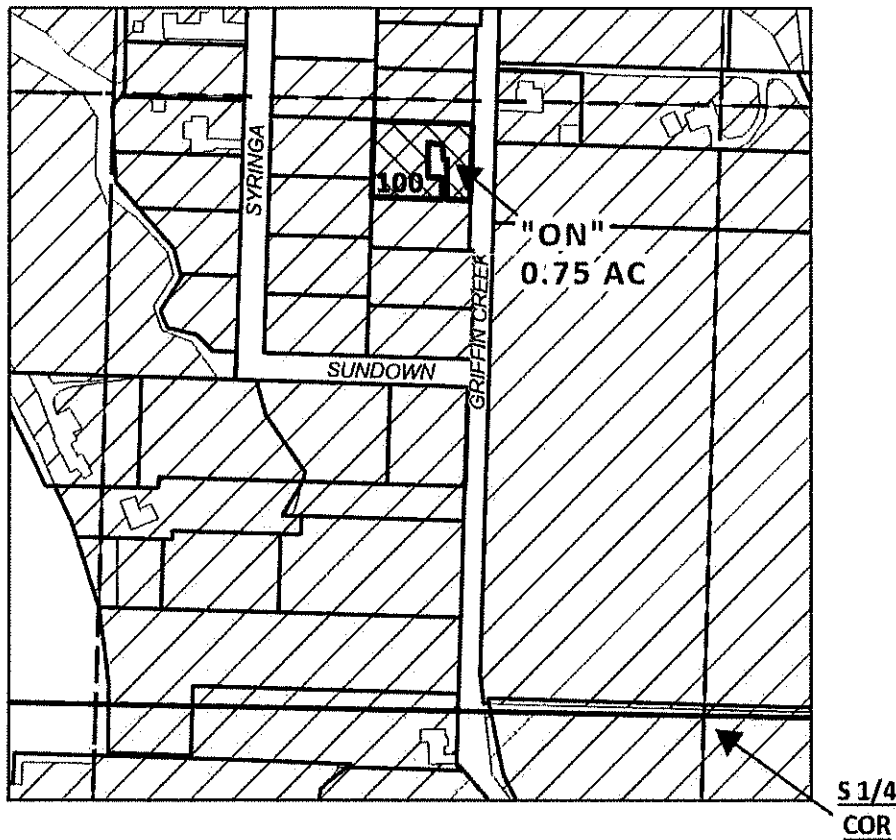

EXISTING RIGHTS
CERTIFICATE #:
79212 (IR): 37.2 AC
83727 (IS): 37.2 AC

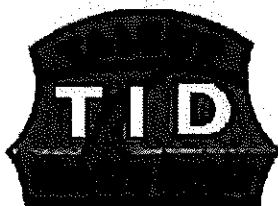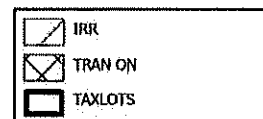

07/20/24

CLAIM OF BENEFICIAL USE MAP

NAME: SHAUN MCLOUGHLIN

TAXLOT #: 100 (WAS 1700) 0.75 AC

ON LANDS
CERTIFICATE #:
79212 (IR): 0.75 AC
83727 (IS): 0.75 AC

CLAIM OF BENEFICIAL USE Site Report

Transfer Number: **T-10277**

District Internal Notice #: **04-26**

User Name: Pratt Family Trust Et Al
(Sophia Cochran)

Phone: 541-535-1838
Certificate: 83727 (IR)

Property: 6913 Dark Hollow Rd., Medford

Place of Use:

USE	POD #	TWP	RNG	SEC	QQ	DLC	GOV'T LOT	TAX LOT	ACRES
IR	ALL	38 S	1 W	18	NE SW			1604	1.8
IR	ALL	38 S	1 W	18	SW SE			1604	.7
TOTAL ACRES =									2.5

District Conveyance System:

Description of Delivery System: Private Irrigation Line and Pump Station
Headgate: None Canal: West

Beneficial Use:

Description of Beneficial Use: Vineyard
Method Used to Apply Water: Sprinkler irrigated. The water use is metered.
Method Used to Calculate Beneficial Use: Ariel map view verification comparing transfer map to the actual place of use 6/19/2024 HH

User Interviewed: () Yes (X) No

Beneficial Use Made as Authorized: (X) Yes () No

Description of Beneficial Use if Less than Authorized:

None

Inspected By: Sharee D. Burns Date: 10/14/2024
Sharee Burns, Executive Assistant

Instructions: Attach and label the corresponding final proof map.

RECEIVED

JUL 29 2024

TALENT
IRRIGATION DISTRICT

JACKSON COUNTY
SEC. 18 T38S R1W

SCALE - 1" = 400'



E-RECEIVED



1/21/2025

OWRD

T-10277

NE1/4 OF THE SW 1/4; SW1/4 OF THE SE 1/4

DIN-04-26

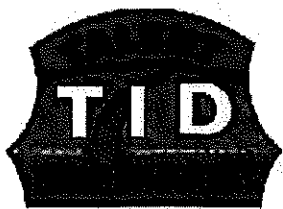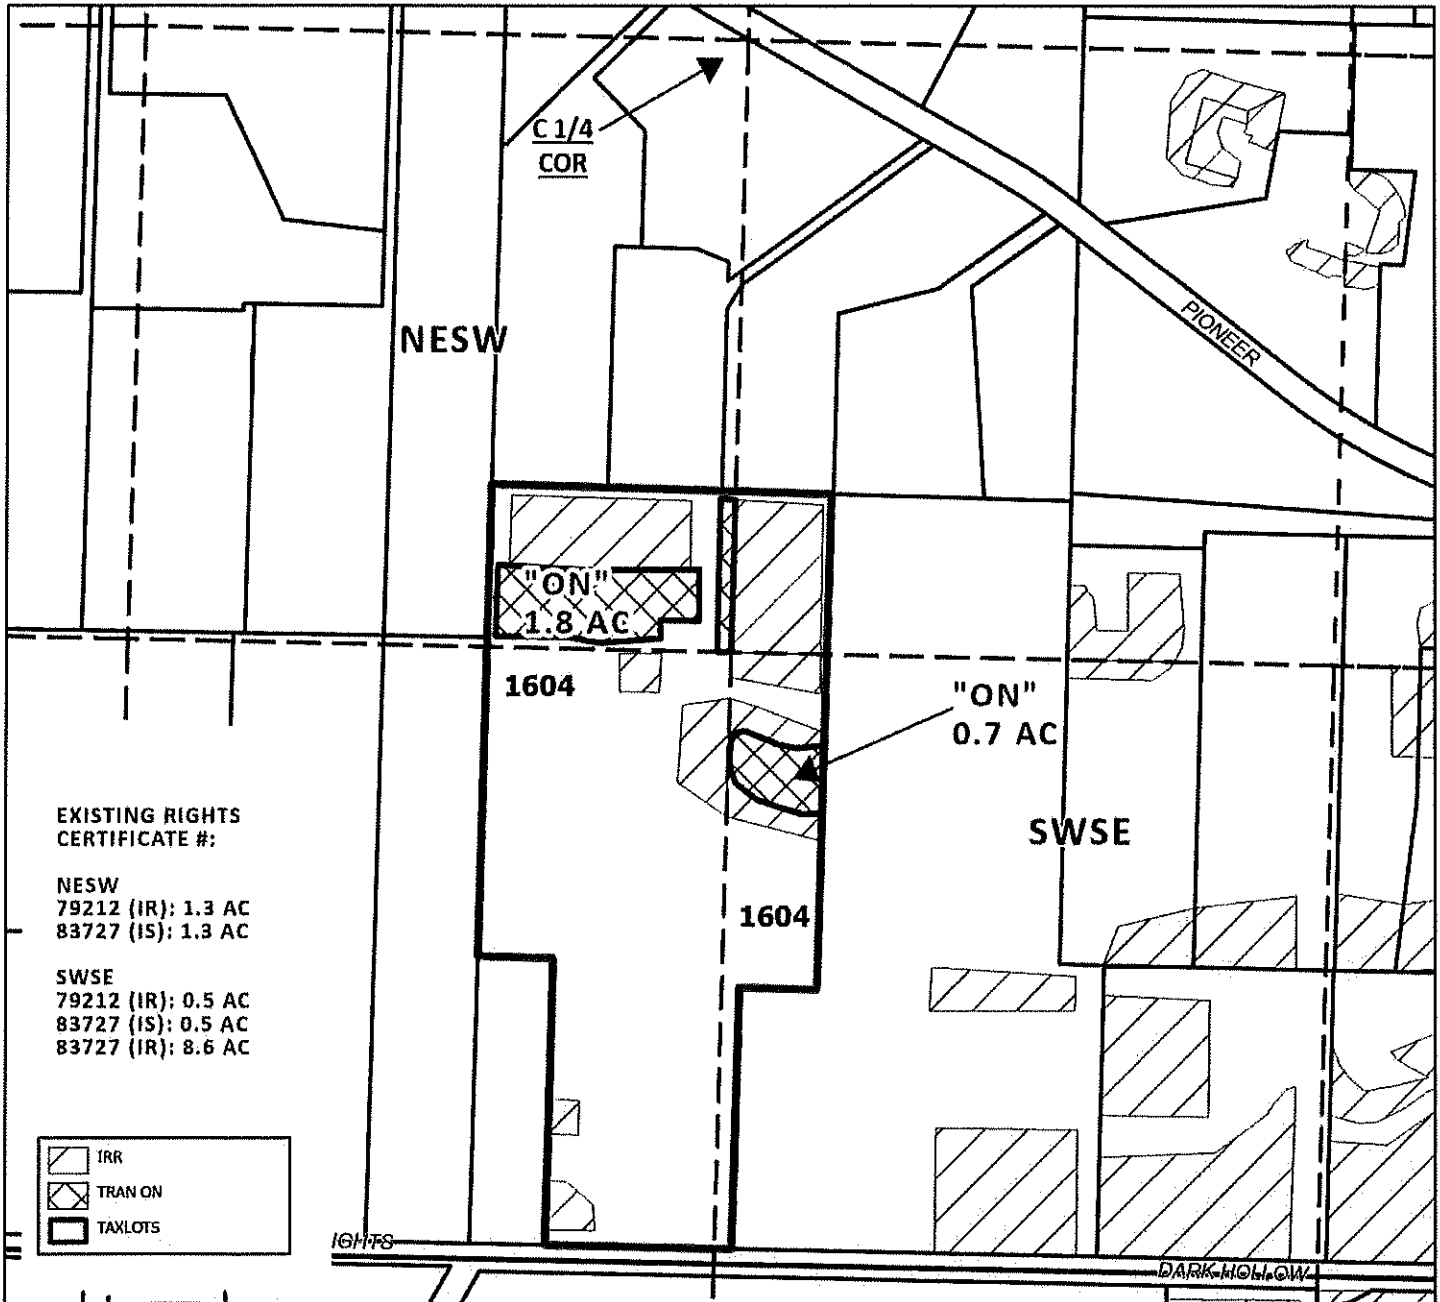

LAST UPDATE: 07/22/2024

CLAIM OF BENEFICIAL USE MAP

NAME: PRATT FAMILY TRUST (COCHRAN)

TAXLOT #: 1604 2.5 AC

NESW: 1.8 AC

SWSE: 0.7 AC

ON LANDS
CERTIFICATE #:

83727 (IR): 2.5 AC

This map is not intended to provide legal dimensions
or locations of property ownership lines

CLAIM OF BENEFICIAL USE Site Report

Transfer Number: **T-10277**

District Internal Notice #: **04-27**

User Name: 3115 Deer Trail, LLC
(Gene Morgan)

Phone: 541-944-4764
Certificate: 79212 (IR)
Certificate: 83727 (IS)

Property: 3115 Deer Trail Ln., Medford

Place of Use:

USE	POD #	TWP	RNG	SEC	QQ	DLC	GOVT LOT	TAX LOT	ACRES
IR	ALL	38 S	1 W	20	SE NW			1700	.7
IR	ALL	38 S	1 W	20	SW NE			1700	3.6
TOTAL ACRES =									4.3

District Conveyance System:

Description of Delivery System: Private Turnout

Headgate: None Canal: West

Beneficial Use:

Description of Beneficial Use: Lawn and Landscaping

Method Used to Apply Water: Sprinkler irrigated. The water use is metered.

Method Used to Calculate Beneficial Use: Ariel map view verification comparing transfer map to the actual place of use 6/19/2024 HH

User Interviewed: () Yes (X) No

Beneficial Use Made as Authorized: (X) Yes () No

Description of Beneficial Use if Less than Authorized:

None

Inspected By: Sharee D. Burns Date: 10/14/2024
Sharee Burns, Executive Assistant

Instructions: Attach and label the corresponding final proof map.

**JACKSON COUNTY
SEC. 20 T38S R1W**

E-RECEIVED
1/21/2025
OWRD

RECEIVED

JUL 29 2024

TALENT
IRRIGATION DISTRICT

SCALE - 1" = 400'



T-10277

SE1/4 OF THE NW 1/4; SW1/4 OF THE NE 1/4

DIN-04-27

**EXISTING RIGHTS
CERTIFICATE #:**

SENE




79212 (IR): 3.3 AC

83727 (IS): 3.3 AC

SWSE

79212 (IR): 19.0 AC

83727 (IS): 19.0 AC

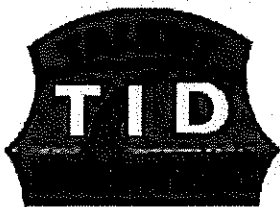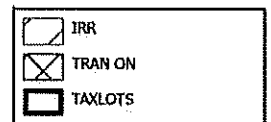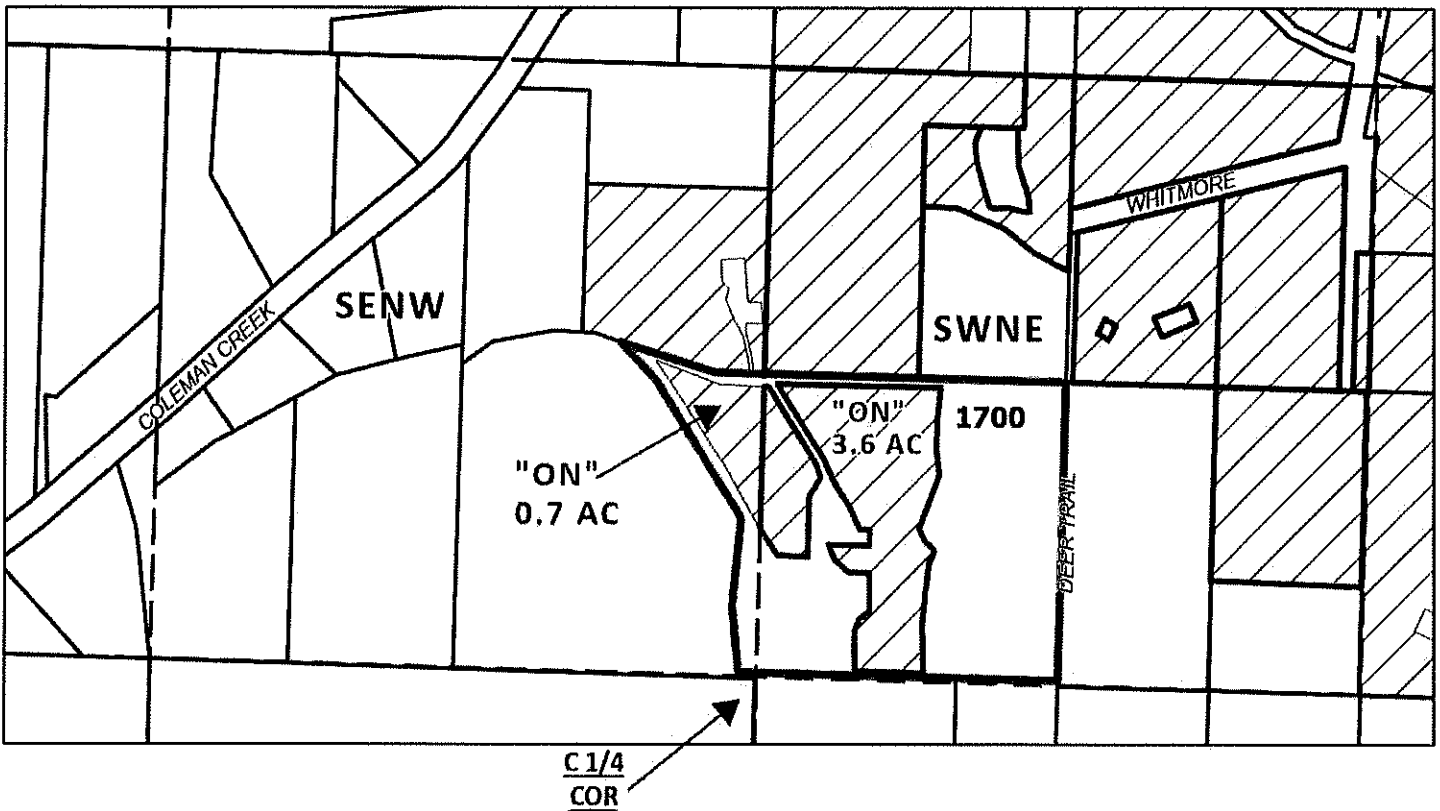

LAST UPDATE: 07/22/2024

CLAIM OF BENEFICIAL USE MAP

NAME: 3115 DEER TRAIL, LLC (MORGAN)

TAXLOT #: 1700 4.3 AC

SENE: 0.7 AC

SWNE: 3.6 AC

ON LANDS

CERTIFICATE #:

79212 (IR): 4.3 AC

83727 (IS): 4.3AC

This map is not intended to provide legal dimensions
or locations of property ownership lines

CLAIM OF BENEFICIAL USE Site Report

Transfer Number: **T-10277**

District Internal Notice #: **04-28**

User Name: Robin Bell
(Jann/Elizabeth Williams)

Phone: 607-262-6578
Certificate: 83727 (IR)

Property: 6105 Hughes Rd., Medford

Place of Use:

USE	POD #	TWP	RNG	SEC	QQ	DLC	GOV'T LOT	TAX LOT	ACRES
IR	ALL	38 S	1 W	12	SW SE			700	4.11
IR	ALL	38 S	1 W	12	NW SE			700	.04

TOTAL ACRES = 4.15

District Conveyance System:

Description of Delivery System: Private Turnout

Headgate: None Canal: Lower East

Beneficial Use:

Description of Beneficial Use: Lawn and Landscaping

Method Used to Apply Water: Drip irrigated. The water use is metered.

Method Used to Calculate Beneficial Use: Ariel map view verification comparing transfer map to the actual place of use 6/19/2024 HH

User Interviewed: () Yes (X) No

Beneficial Use Made as Authorized: (X) Yes () No

Description of Beneficial Use if Less than Authorized:

None

Inspected By: Sharee D. Burns Date: 10/14/2024
Sharee Burns, Executive Assistant

Instructions: Attach and label the corresponding final proof map.

**JACKSON COUNTY
SEC. 12 T38S R1W**

SCALE - 1" = 400'

E-RECEIVED


1/21/2025

OWRD

T-10277

NW1/4 OF THE SE 1/4; SW1/4 OF THE SE 1/4



DIN-04-28

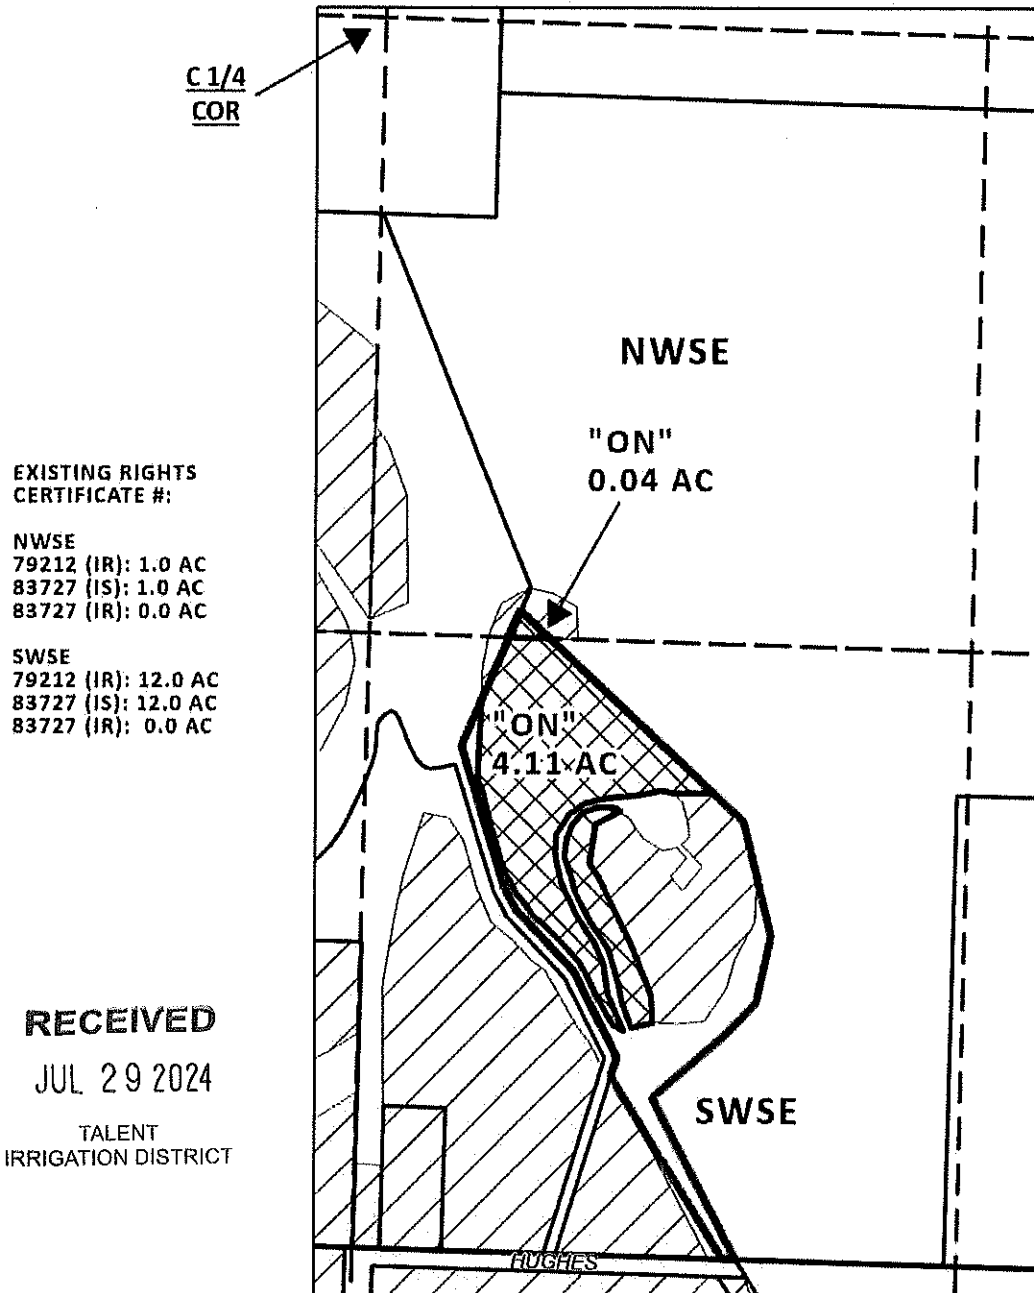

RECEIVED

JUL 29 2024

TALENT
IRRIGATION DISTRICT

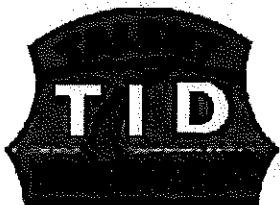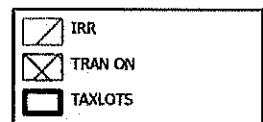

LAST UPDATE: 07/24/2024

CLAIM OF BENEFICIAL USE MAP

NAME: ROBIN BELL REV TRUST (WILLIAMS)

TAXLOT #: 700 4.15 AC

NWSE: 0.04 AC

SWSE: 4.11 AC

ON LANDS
CERTIFICATE #:

83727 (IR): 4.15 AC

This map is not intended to provide legal dimensions
or locations of property ownership lines

CLAIM OF BENEFICIAL USE Site Report

Transfer Number: **T-10277**

District Internal Notice #: **04-29**

User Name: Gary/Deborah Jones Living Trust
(Jann/Elizabeth Williams)

Phone: 541-482-9450
Certificate: 79212 (IR)
Certificate: 83727 (IS)

Property: 913 Garden Wy., Ashland

Place of Use:

USE	POD #	TWP	RNG	SEC	QQ	DLC	GOV'T LOT	TAX LOT	ACRES
IR	ALL	39 S	1 E	15AC	SW NE			7300	.12
TOTAL ACRES =									.12

District Conveyance System:

Description of Delivery System: Private Pump from Paradise Creek

Headgate: None Canal: Ashland

Beneficial Use:

Description of Beneficial Use: Lawn and Landscaping

Method Used to Apply Water: Sprinkler irrigated. The water use is metered.

Method Used to Calculate Beneficial Use: Ariel map view verification comparing transfer map to the actual place of use 6/19/2024 HH

User Interviewed: () Yes (X) No

Beneficial Use Made as Authorized: (X) Yes () No

Description of Beneficial Use if Less than Authorized:

None

Inspected By: Sharee Burns Date: 10/14/2024
Sharee Burns, Executive Assistant

Instructions: Attach and label the corresponding final proof map.

JACKSON COUNTY
SEC. 15 T39S R1E

E-RECEIVED
1/21/2025
OWRD

RECEIVED

JUL 29 2024

TALENT
IRRIGATION DISTRICT


SCALE - 1" = 400'



T-10277

SW1/4 OF THE NE 1/4



DIN-04-29

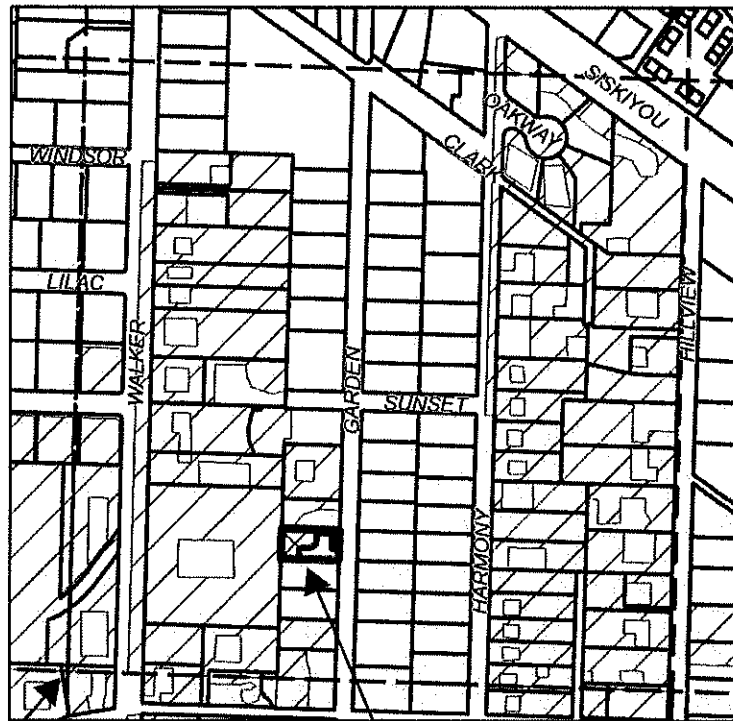

EXISTING RIGHTS
CERTIFICATE #:
79212 (IR): 19.0 AC
83727 (IS): 19.0 AC

C 1/4
COR

7300
"ON"
0.12 AC

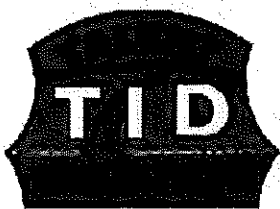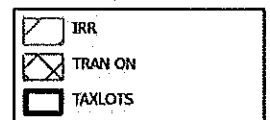

LAST UPDATE: 07/24/2024

CLAIM OF BENEFICIAL USE MAP

NAME: GARY AND DEBORAH JONES REV LIV TR
TAXLOT #: 7300 0.12 AC

ON LANDS
CERTIFICATE #:
79212 (IR): 0.12 AC
83727 (IS): 0.12 AC

This map is not intended to provide legal dimensions
or locations of property ownership lines

CLAIM OF BENEFICIAL USE Site Report

Transfer Number: T-10277

District Internal Notice #: 04-31

User Name: Etherly-Van Wambeke Tr
(Robert/Debra Christian)

Phone: 916-807-0001
Certificate: 79212 (IR)
Certificate: 83727 (IS)

Property: 3960 Independence School Rd. Medford

Place of Use:

USE	POD #	TWP	RNG	SEC	QQ	DLC	GOV'T LOT	TAX LOT	ACRES
IR	ALL	38 S	1 W	07	SW SE			2000	.4
TOTAL ACRES =									.4

District Conveyance System:

Description of Delivery System: Private Turnout

Headgate: None Canal: Talent

Beneficial Use:

Description of Beneficial Use: Lawn and Landscaping

Method Used to Apply Water: Sprinkler irrigated. The water use is metered.

Method Used to Calculate Beneficial Use: Ariel map view verification comparing transfer map to the actual place of use 6/20/2024 HH

User Interviewed: () Yes (X) No

Beneficial Use Made as Authorized: (X) Yes () No

Description of Beneficial Use if Less than Authorized:

None

Inspected By: Sharee D. Burns Date: 10/14/2024
Sharee Burns, Executive Assistant

Instructions: Attach and label the corresponding final proof map.

**JACKSON COUNTY
SEC. 07, 18 T38S R1W**

SCALE - 1" = 400'



SW 1/4 OF THE SE 1/4 (SEC 07); NW 1/4 OF THE NE 1/4 (SEC 18)


E-RECEIVED

1/21/2025

OWRD

T-10277

DIN-04-31

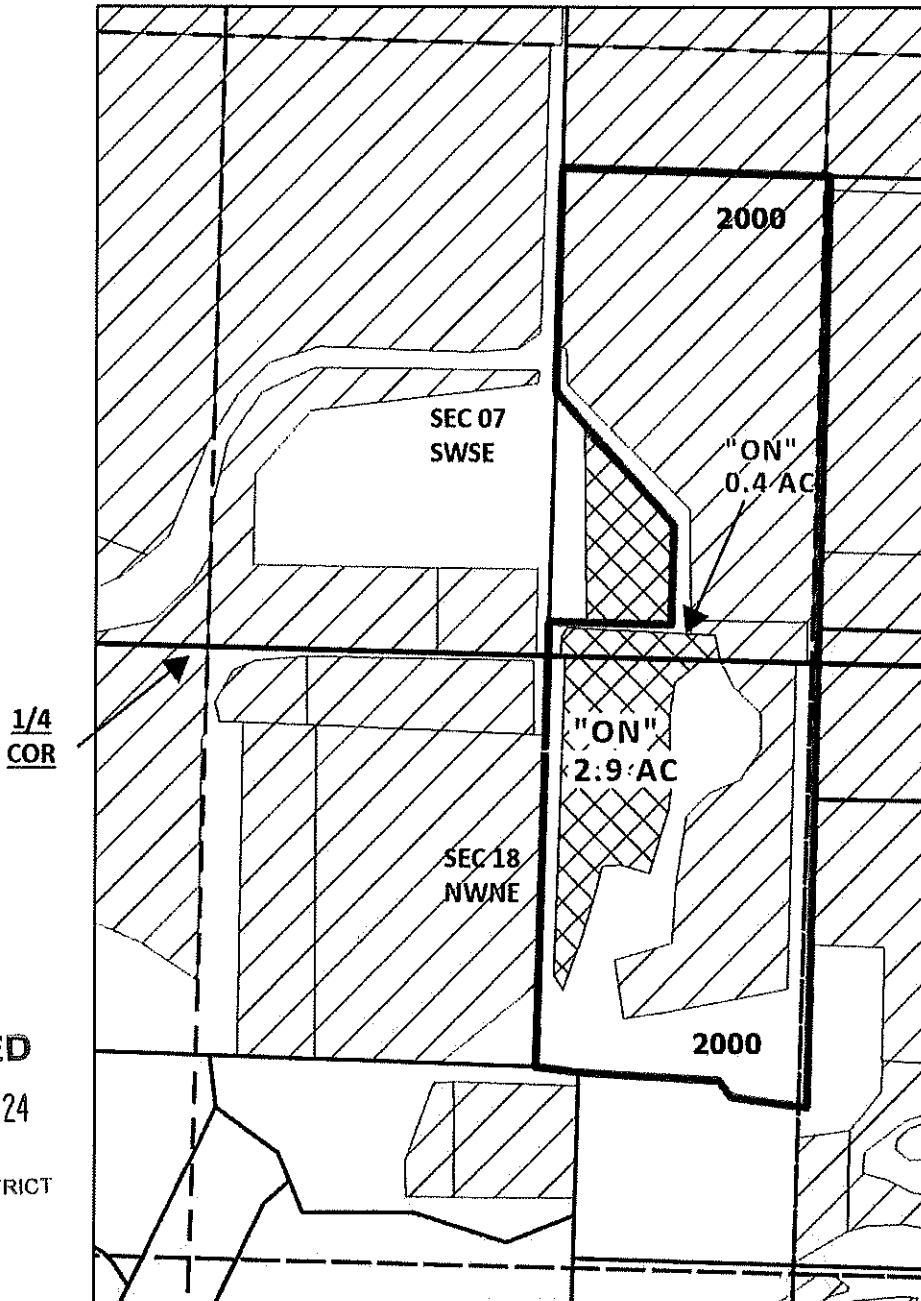

EXISTING RIGHTS

CERTIFICATE #:

SWSE (SEC 07)

79212 (IR): 30.6 AC

83727 (IS): 30.6 AC

83727 (IR): 0.9 AC

NWNE (SEC 18)

79212 (IR): 15.7 AC


83727 (IS): 15.7 AC

83727 (IR): 2.2 AC

RECEIVED

JUL 29 2024

TALENT
IRRIGATION DISTRICT

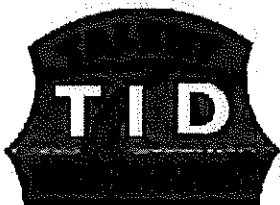

DATE: 07/22/2024

CLAIM OF BENEFICIAL USE MAP

NAME: ETHERLY VAN WAMBEKE TR (CHRISTIAN)

TAXLOT #: 2000 3.3 AC

SWSE (SEC 07): 0.4 AC

NWNE (SEC 18): 2.9 AC

ON LANDS

CERTIFICATE #:

79212 (IR): 3.3 AC

83727 (IS): 3.3 AC

This map is not intended to provide legal dimensions
or locations of property ownership lines

CLAIM OF BENEFICIAL USE Site Report

Transfer Number: T-10277

District Internal Notice #: 04-31

User Name: Eckmann Family Trust
(Robert/Debra Christian)

Phone: 503-516-8000
Certificate: 79212 (IR)
Certificate: 83727 (IS)

Property: 3986 Independence School Rd. Medford

Place of Use:

USE	POD #	TWP	RNG	SEC	QQ	DLC	GOV'T LOT	TAX LOT	ACRES
IR	ALL	38 S	1 W	07	SW SE			2100	1.4
TOTAL ACRES =									1.4

District Conveyance System:

Description of Delivery System: Private Turnout

Headgate: None Canal: Talent

Beneficial Use:

Description of Beneficial Use: Lawn and Landscaping

Method Used to Apply Water: Sprinkler irrigated. The water use is metered.

Method Used to Calculate Beneficial Use: Ariel map view verification comparing transfer map to the actual place of use 6/20/2024 HH

User Interviewed: () Yes (X) No

Beneficial Use Made as Authorized: (X) Yes () No

Description of Beneficial Use if Less than Authorized:

None

Inspected By: Sharee D. Burns Date: 10/14/2024
Sharee Burns, Executive Assistant

Instructions: Attach and label the corresponding final proof map.

**JACKSON COUNTY
SEC. 07 T38S R1W**

E-RECEIVED

1/21/2025

OWRD


SCALE - 1" = 400'



T-10277

SW1/4 OF THE SE 1/4

DIN-04-31

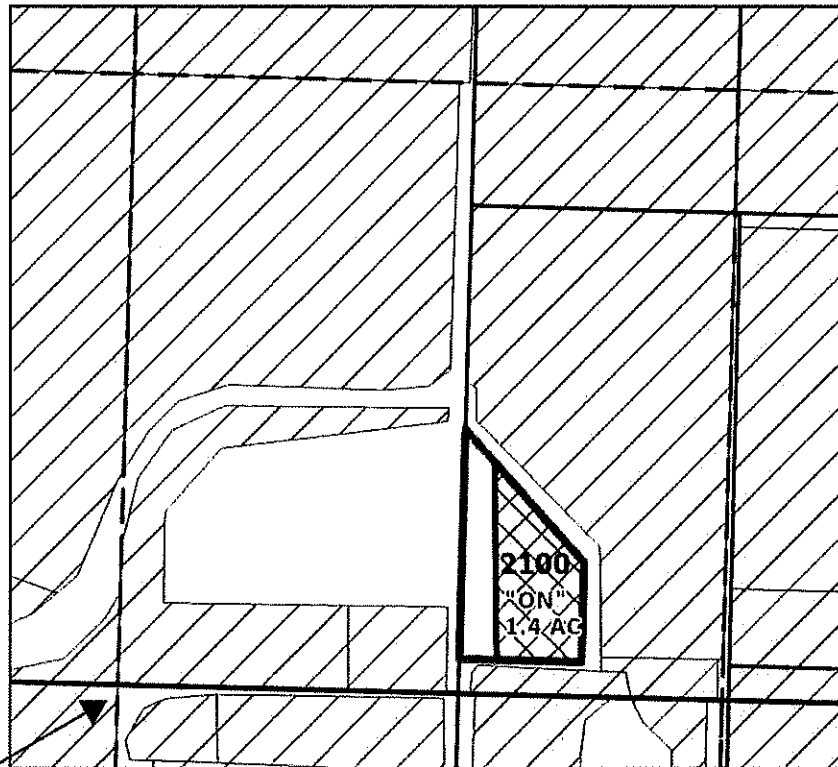



EXISTING RIGHTS
CERTIFICATE #:
79212 (IR): 29.6 AC
83727 (IS): 29.6 AC
83727 (IR): 0.9 AC

S1/4
COR

RECEIVED

JUL 29 2024

TALENT
IRRIGATION DISTRICT

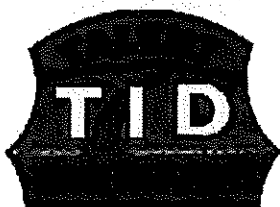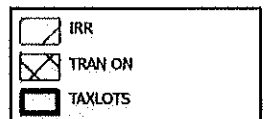

LAST UPDATE: 07/22/2024

CLAIM OF BENEFICIAL USE MAP

NAME: ECKMANN FAMILY TRUST (CHRISTIAN)
TAXLOT #: 2100 1.4 AC

ON LANDS
CERTIFICATE #:
79212 (IR): 1.4 AC
83727 (IS): 1.4 AC

This map is not intended to provide legal dimensions
or locations of property ownership lines

CLAIM OF BENEFICIAL USE Site Report

Transfer Number: **T-10277**

District Internal Notice #: **04-31**

User Name: Allyson Brown Living Trust
(Robert/Debra Christian)

Phone: 541-535-4345
Certificate: 79212 (IR)
Certificate: 83727 (IS)

Property: 3811 Pioneer Rd. Medford

Place of Use:

USE	POD #	TWP	RNG	SEC	QQ	DLC	GOV'T LOT	TAX LOT	ACRES
IR	ALL	38 S	1 W	18	NW NE			2000	2.9
TOTAL ACRES =									2.9

District Conveyance System:

Description of Delivery System: Private Turnout

Headgate: None Canal: West

Beneficial Use:

Description of Beneficial Use: Lawn and Landscaping

Method Used to Apply Water: Sprinkler irrigated. The water use is metered.

Method Used to Calculate Beneficial Use: Ariel map view verification comparing transfer map to the actual place of use 6/20/2024 HH

User Interviewed: () Yes (X) No

Beneficial Use Made as Authorized: (X) Yes () No

Description of Beneficial Use if Less than Authorized:

None

Inspected By: Sharee Burns Date: 7/25/2024
Sharee Burns, Executive Assistant

Instructions: Attach and label the corresponding final proof map.

**JACKSON COUNTY
SEC. 18 T38S R1W**

E-RECEIVED
1/21/2025
OWRD

SCALE - 1" = 400'




T-10277


NW1/4 OF THE NE 1/4

DIN-04-31

N 1/4
COR

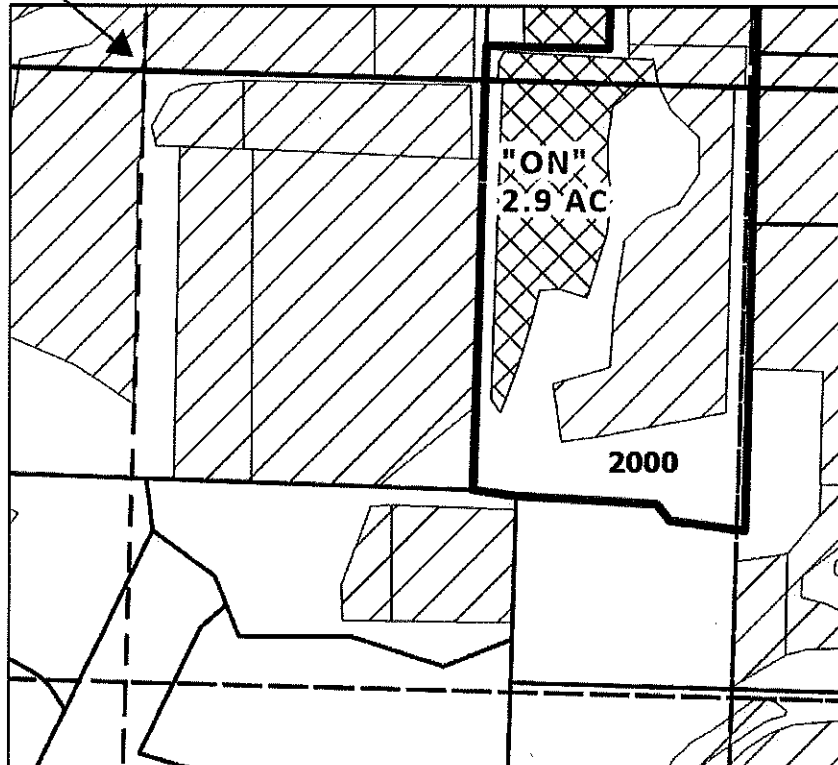

EXISTING RIGHTS
CERTIFICATE #:
79212 (IR): 15.7 AC
83727 (IS): 15.7 AC
83727 (IR): 2.2 AC

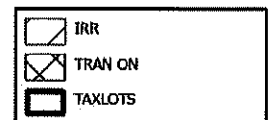

LAST UPDATE: 07/22/2024

CLAIM OF BENEFICIAL USE MAP

NAME: ETHERLY VAN WAMBEKE TR (CHRISTIAN)
TAXLOT #: 2000 2.9 AC

ON LANDS
CERTIFICATE #:
79212 (IR): 2.9 AC
83727 (IS): 2.9 AC

This map is not intended to provide legal dimensions
or locations of property ownership lines

CLAIM OF BENEFICIAL USE Site Report

Transfer Number: **T-10277**

District Internal Notice #: **04-32**

User Name: Nicholas Baida/Angelica Monroy
(James Jean/Wink Ruth)

Phone: 541-441-2210
Certificate: 79212 (IR)
Certificate: 83727 (IS)

Property: 2855 East Main St., Ashland

Place of Use: Tax Lot remapped to 391E11D 1700

USE	POD #	TWP	RNG	SEC	QQ	DLC	GOV'T LOT	TAX LOT	ACRES
IR	ALL	39 S	1 E	11	NE SE			501	.5
TOTAL ACRES =									.5

District Conveyance System:

Description of Delivery System: Private Pump

Headgate: None Canal: Upper East

Beneficial Use:

Description of Beneficial Use: Lawn and Landscaping

Method Used to Apply Water: Sprinkler irrigated. The water use is metered.

Method Used to Calculate Beneficial Use: Ariel map view verification comparing transfer map to the actual place of use 6/20/2024 HH

User Interviewed: () Yes (X) No

Beneficial Use Made as Authorized: (X) Yes () No

Description of Beneficial Use if Less than Authorized:

None

Inspected By: Sharee D. Burns Date: 10/14/2024
Sharee Burns, Executive Assistant

Instructions: Attach and label the corresponding final proof map.

**JACKSON COUNTY
SEC. 11 T39S R1E**

SCALE - 1" = 400'



NE1/4 OF THE SE 1/4

E-RECEIVED
1/21/2025
OWRD


RECEIVED

JUL 29 2024



TALENT
IRRIGATION DISTRICT

T-10277

DIN-04-32

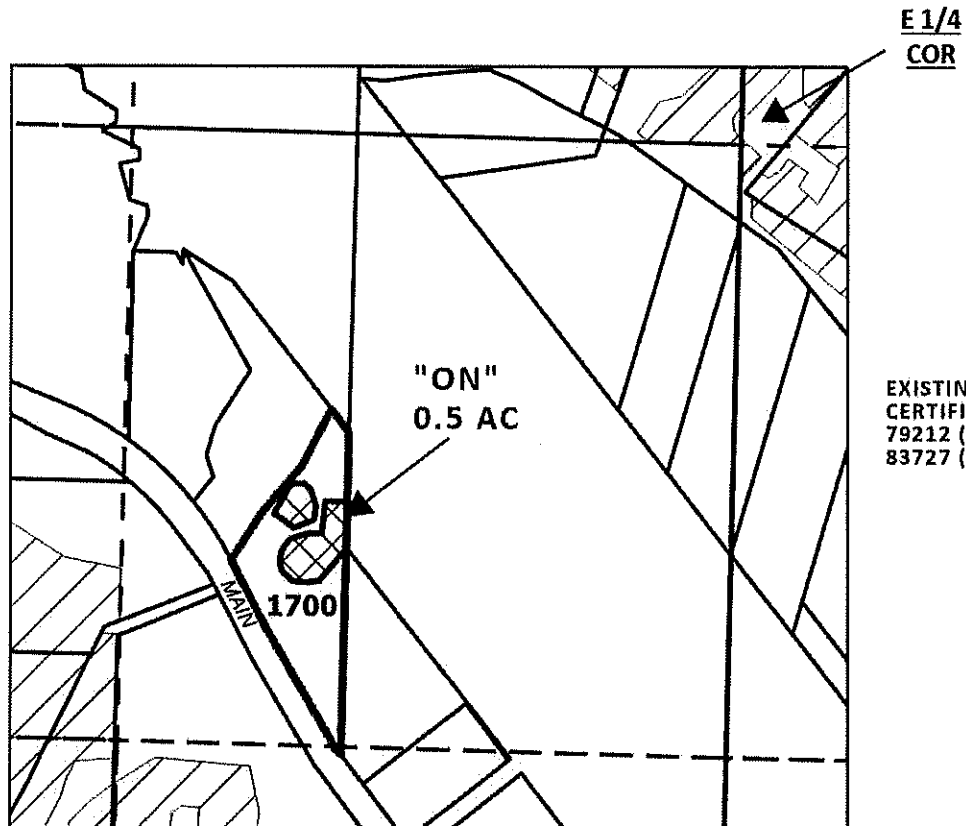

EXISTING RIGHTS
CERTIFICATE #:
79212 (IR): 0 AC
83727 (IS): 0 AC

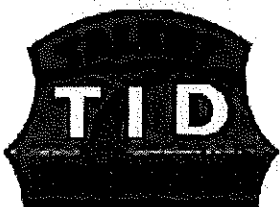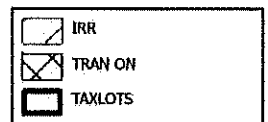

DATE: 07/27/2024

CLAIM OF BENEFICIAL USE MAP

NAME: NICHOLAS BAIDA & ANGELICA MONROY
(JAMES JEAN)
TAXLOT #: 1700 0.5 AC

ON LANDS
CERTIFICATE #:
79212 (IR): 0.5 AC
83727 (IS): 0.5 AC

This map is not intended to provide legal dimensions
or locations of property ownership lines

CLAIM OF BENEFICIAL USE Site Report

Transfer Number: T-10277

District Internal Notice #: 04-36

User Name: Stuart/Lynn Smith

Phone: 541-512-0399

Certificate: 79212 (IR)

Certificate: 83727 (IS)

Property: 4862 Payne Rd., Medford

Place of Use:

USE	POD #	TWP	RNG	SEC	QQ	DLC	GOV'T LOT	TAX LOT	ACRES
IR	ALL	38 S	1 W	14	SW SE			2502	3.0
TOTAL ACRES =									3.0

District Conveyance System:

Description of Delivery System: Private Lateral

Headgate: None Canal: Lower East

Beneficial Use:

Description of Beneficial Use: Lawn and Landscaping

Method Used to Apply Water: Sprinkler irrigated. The water use is metered.

Method Used to Calculate Beneficial Use: Ariel map view verification comparing transfer map to the actual place of use 6/20/2024 HH

User Interviewed: () Yes (X) No

Beneficial Use Made as Authorized: (X) Yes () No

Description of Beneficial Use if Less than Authorized:

None

Inspected By: Sharee Burns Date: 10/17/2024
Sharee Burns, Executive Assistant

Instructions: Attach and label the corresponding final proof map.

**JACKSON COUNTY
SEC. 14 T38S R1W**

SCALE - 1" = 400'



T-10277


SW 1/4 OF THE SE 1/4

E-RECEIVED

1/21/2025

OWRD

DIN-04-36

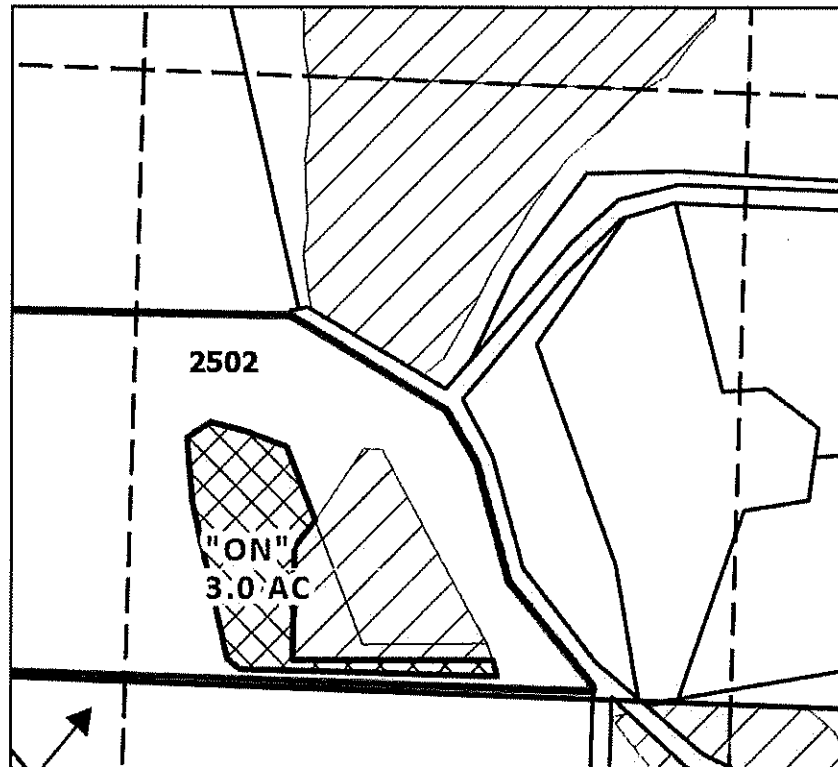



S 1/4
COR

EXISTING RIGHTS
CERTIFICATE #:
79212 (IR): 9.46 AC

RECEIVED

JUL 29 2024

TALENT
IRRIGATION DISTRICT

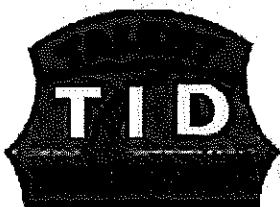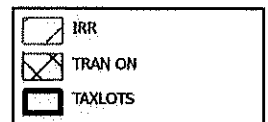

DATE: 07/27/2024

CLAIM OF BENEFICIAL USE MAP

NAME: STUART & LYNN SMITH
TAXLOT #: 2502 3.0 AC

ON LANDS
CERTIFICATE #:
79212 (IR): 3.0 AC
83727 (IS): 3.0 AC

This map is not intended to provide legal dimensions
or locations of property ownership lines

CLAIM OF BENEFICIAL USE Site Report

Transfer Number: **T-10277**

District Internal Notice #: **04-51**

User Name: Silbowitz Family Trust
(Alfred/Virginia Silbowitz)

Phone: 541-482-5700

Certificate: 79212 (IR)

Certificate: 83727 (IS)

Certificate: 83727 (IR)- TL 202 4,20

Property: 1601 E Nevada St., Ashland

Place of Use:

USE	POD #	TWP	RNG	SEC	QQ	DLC	GOVT LOT	TAX LOT	ACRES
IR	ALL	38 S	1 E	35	NW SW			200	2.06
IR	ALL	38 S	1 E	35	NW SW			201	2.12
IR	ALL	38 S	1 E	35	NW SW			202	8.65
IR	ALL	38 S	1 E	35	NW SW			202	4.20
IR	ALL	38 S	1 E	35	NW SW			203	20.53

TOTAL ACRES = 37.56

District Conveyance System:

Description of Delivery System: Private Turnout

Headgate: None

Canal: Upper East

Beneficial Use:

Description of Beneficial Use: Lawn and Landscaping

Method Used to Apply Water: Sprinkler irrigated. The water use is metered.

Method Used to Calculate Beneficial Use: Ariel map view verification comparing transfer map to the actual place of use 6/20/2024 HH

User Interviewed: () Yes (X) No

Beneficial Use Made as Authorized: (X) Yes () No

Description of Beneficial Use if Less than Authorized:

None

Inspected By: Sharee J. Burns Date: 7/9/2024
Sharee Burns, Executive Assistant

Instructions: Attach and label the corresponding final proof map.

**JACKSON COUNTY
SEC. 35 T38S R1E**

OWRD E-RECEIVED

1/28/2025

AMENDED

SCALE - 1" = 400'




T-10277


NW 1/4 OF THE SW 1/4

DIN-04-51

W 1/4
COR

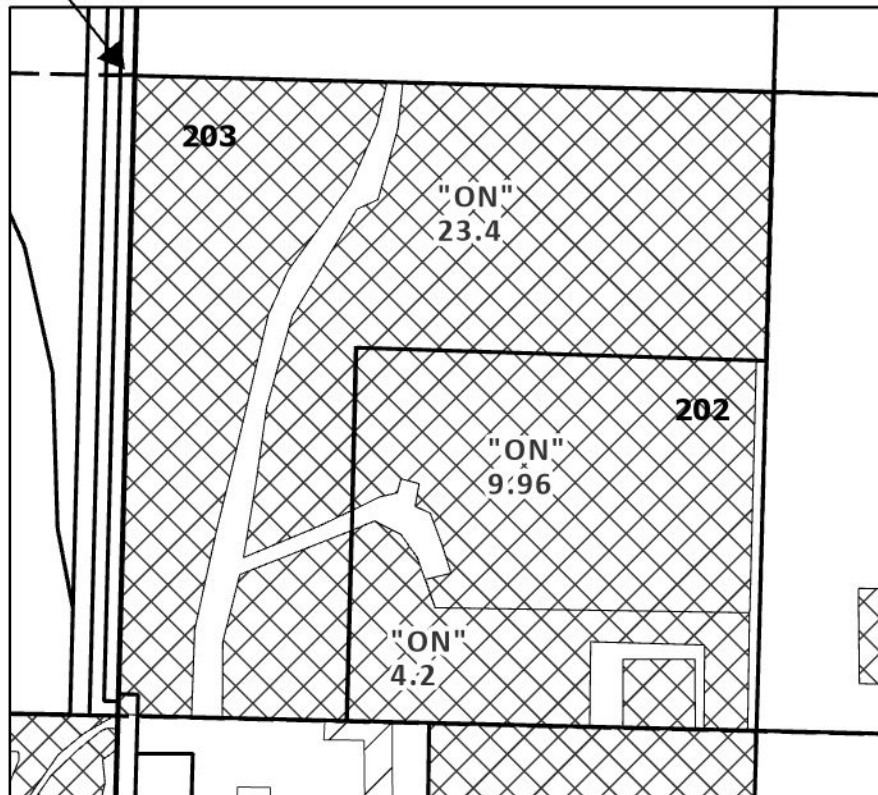

EXISTING RIGHTS
CERTIFICATE #:
79212 (IR): 0 AC
83727 (IS): 0 AC
83727 (IR): 0 AC

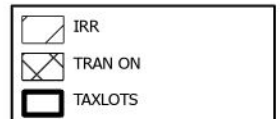

DATE: 1/22/2025

CLAIM OF BENEFICIAL USE MAP

NAME: SILBOWITZ FAMILY TRUST
(ALFRED/VIRGINIA SILBOWITZ)
TAXLOT #: 202 9.96 AC C79212
TAXLOT #: 202 4.2 AC C83727
TAXLOT #: 203 23.4 AC C79212

ON LANDS
CERTIFICATE #:
79212 (IR): 33.36 AC
83727 (IS): 33.36 AC
83727 (IR): 4.2 AC

This map is not intended to provide legal dimensions
or locations of property ownership lines

CLAIM OF BENEFICIAL USE Site Report

Transfer Number: **T-10277**

District Internal Notice #: **04-53**

User Name: Dodds Family Trust

Phone: 541-482-1532

1575 E Nevada St., Ashland

Place of Use:

USE	POD #	TWP	RNG	SEC	QQ	DLC	GOV'T LOT	TAX LOT	ACRES
IR	04-53	38S	1E	34	SE SE			101 (now 500)	5.0
TOTAL ACRES =									5.0

District Conveyance System:

Description of Delivery System: Private Turnout through a private pipeline on the East Canal

Headgate: None

Canal: Upper East Main Canal

Beneficial Use:

Description of Beneficial Use: Lawn and Landscaping

Method Used to Apply Water: Sprinkler irrigated. The water use is metered.

Method Used to Calculate Beneficial Use: Ariel Map View Verification 6/19/2024 HH

User Interviewed: () Yes (X) No

Beneficial Use Made as Authorized: (X) Yes () No

Description of Beneficial Use if Less than Authorized:

None

Inspected By: Sharee O. Burns Date: 10/14/2024
Sharee Burns, Executive Assistant

Instructions: Attach and label the corresponding final proof map.

**JACKSON COUNTY
SEC. 34 T38S R1E**

E-RECEIVED
1/21/2025
OWRD

SCALE - 1" = 400'



T-10277

SE 1/4 OF THE SE 1/4

DIN-04-53





EXISTING RIGHTS
CERTIFICATE #:
79212 (IR): 0 AC
83727 (IS): 0 AC
83727 (IR): 0 AC

RECEIVED

JUL 29 2024

TALENT
IRRIGATION DISTRICT

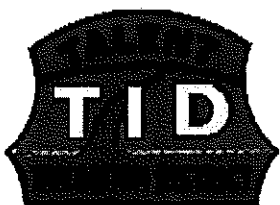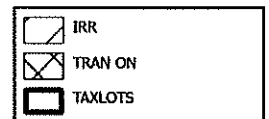

DATE: 07/27/2024

CLAIM OF BENEFICIAL USE MAP

NAME: DODDS FAMILY TRUST
TAXLOT #: 500 5.0 AC

ON LANDS
CERTIFICATE #:
83727 (IR): 5.0 AC

This map is not intended to provide legal dimensions
or locations of property ownership lines

CLAIM OF BENEFICIAL USE Site Report

Transfer Number: T-10277

District Internal Notice #: 04-54

User Name: J E Kastroll/M K McCully

Phone: 541-488-8904

Certificate: 83727 (IR)

Property: 26 Pompadour Dr., Ashland

Place of Use:

USE	POD #	TWP	RNG	SEC	QQ	DLC	GOV'T LOT	TAX LOT	ACRES
IR	ALL	38 S	1 E	35	SW SW			702	2.0
TOTAL ACRES =									2.0

District Conveyance System:

Description of Delivery System: Private Turnout

Headgate: None Canal: Upper East

Beneficial Use:

Description of Beneficial Use: Lawn and Landscaping

Method Used to Apply Water: Sprinkler irrigated. The water use is metered.

Method Used to Calculate Beneficial Use: Usage confirmed by meter reading reports.

User Interviewed: () Yes (X) No

Beneficial Use Made as Authorized: (X) Yes () No

Description of Beneficial Use if Less than Authorized:

None

Inspected By: Sharee D. Burns Date: 11/22/2024
Sharee Burns, Executive Assistant

Instructions: Attach and label the corresponding final proof map.

**JACKSON COUNTY
SEC. 35 T38S R1E**

SCALE - 1" = 400'



SW 1/4 OF THE SW 1/4


E-RECEIVED

1/21/2025

OWRD


T-10277

DIN-04-54

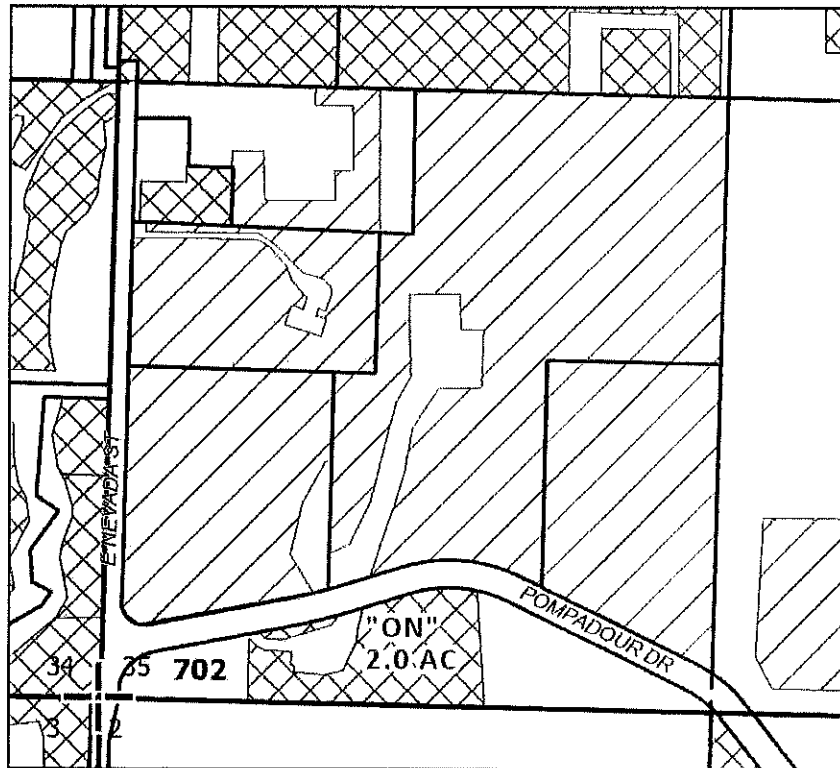

EXISTING RIGHTS
CERTIFICATE #:

83727 (IR): 0 AC

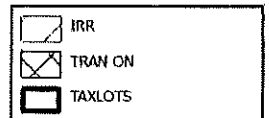

DATE: 10/28/2024

CLAIM OF BENEFICIAL USE MAP

NAME: J. E. KASTROLL/ M. K. MCCULLY
TAXLOT #: 702 2.0 AC

ON LANDS
CERTIFICATE #:
83727 (IR): 2.0 AC

This map is not intended to provide legal dimensions
or locations of property ownership lines

CLAIM OF BENEFICIAL USE Site Report

Transfer Number: **T-10277**

District Internal Notice #: **04-55**

User Name: Debra Diane Blair / Emily Len Coleman
(D.D. Blair/ E Coleman)

Phone: 541-482-8527
Certificate: 83727 (IR)

Property: 1570 E Nevada St., Ashland

Place of Use:

USE	POD #	TWP	RNG	SEC	QQ	DLC	GOV'T LOT	TAX LOT	ACRES
IR	ALL	38 S	1 E	35	SW SW			500	1.0
TOTAL ACRES =									1.0

District Conveyance System:

Description of Delivery System: Private Turnout

Headgate: None Canal: Upper East

Beneficial Use:

Description of Beneficial Use: Lawn and Landscaping

Method Used to Apply Water: Sprinkler irrigated. The water use is metered.

Method Used to Calculate Beneficial Use: Ariel map view verification comparing transfer map to the actual place of use 6/20/2024 HH

User Interviewed: () Yes (X) No

Beneficial Use Made as Authorized: (X) Yes () No

Description of Beneficial Use if Less than Authorized:

None

Inspected By: Sharee R. Burns Date: 10/14/2024
Sharee Burns, Executive Assistant

Instructions: Attach and label the corresponding final proof map.

**JACKSON COUNTY
SEC. 35 T38S R1E**

E-RECEIVED
1/21/2025
OWRD


SCALE - 1" = 400'



T-10277

SW 1/4 OF THE SW 1/4

DIN-04-55


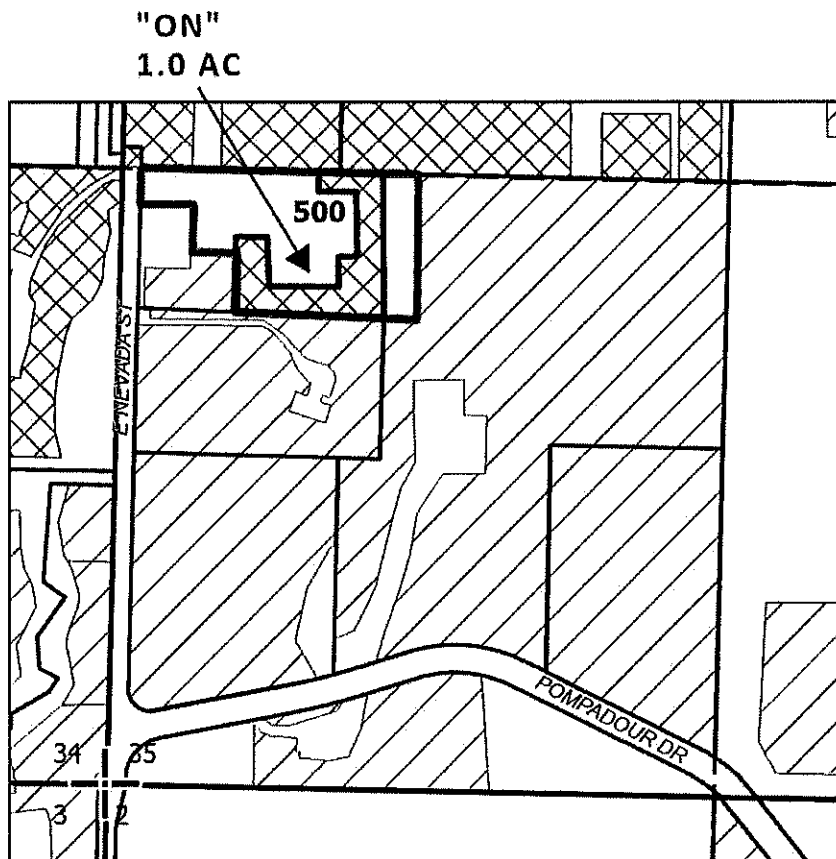


RECEIVED

JUL 29 2024

TALENT
IRRIGATION DISTRICT

EXISTING RIGHTS
CERTIFICATE #:
79212 (IR): 0 AC
83727 (IS): 0 AC
83727 (IR): 0 AC

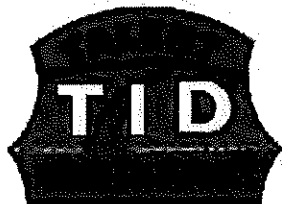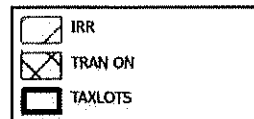

DATE: 07/28/2024

CLAIM OF BENEFICIAL USE MAP

NAME: DEBRA BLAIR, DAVID & EMILY COLEMAN
TAXLOT #: 500 1.0 AC

ON LANDS
CERTIFICATE #:
83727 (IR): 1.0 AC

This map is not intended to provide legal dimensions
or locations of property ownership lines

CLAIM OF BENEFICIAL USE Site Report

Transfer Number: T-10277

District Internal Notice #: 04-56

User Name: Willis/Lizbeth Lee

Phone: 541-482-5700

Certificate: 79212 (IR)

Certificate: 83727 (IS)

Property: 37 Pomadour Dr., Ashland

Place of Use:

USE	POD #	TWP	RNG	SEC	QQ	DLC	GOVT LOT	TAX LOT	ACRES
IR	ALL	38 S	1 E	35	SW SW			700	22.95

TOTAL ACRES = 22.95

District Conveyance System:

Description of Delivery System: Private Turnout

Headgate: None Canal: Upper East

Beneficial Use:

Description of Beneficial Use: Pasture

Method Used to Apply Water: Sprinkler irrigated. The water use is metered.

Method Used to Calculate Beneficial Use: Usage confirmed by meter reading reports.

User Interviewed: () Yes (X) No

Beneficial Use Made as Authorized: (X) Yes () No

Description of Beneficial Use if Less than Authorized:

None

Inspected By: Sharee Burns Date: 11/22/2024
Sharee Burns, Executive Assistant

Instructions: Attach and label the corresponding final proof map.

**JACKSON COUNTY
SEC. 35 T38S R1E**

SCALE - 1" = 400'



SW 1/4 OF THE SW 1/4


E-RECEIVED

1/21/2025

OWRD


T-10277

DIN-04-56

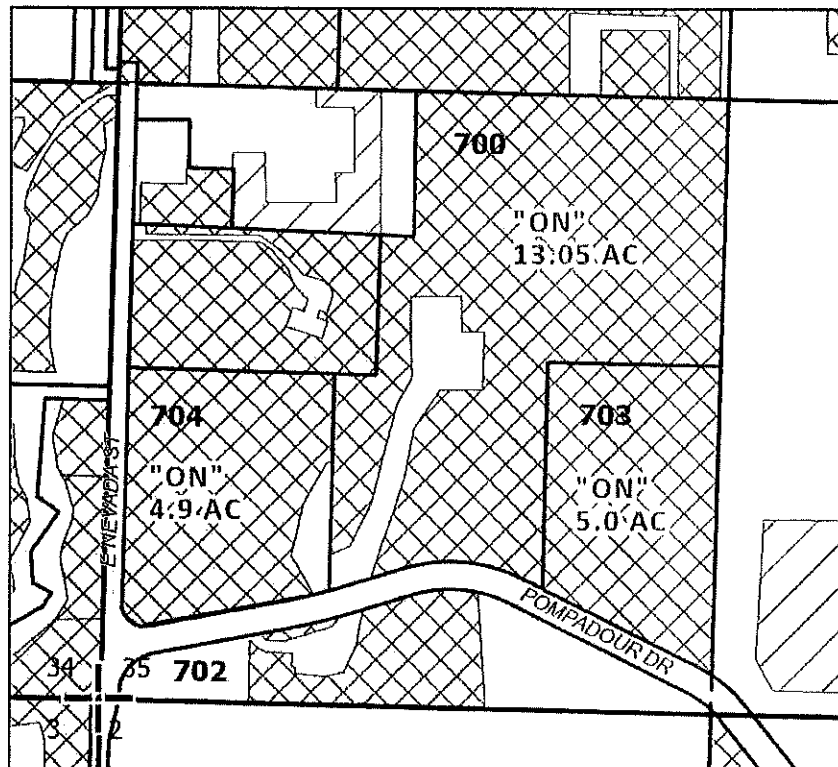

EXISTING RIGHTS
CERTIFICATE #:

79212 (IR): 0 AC
83727 (IS): 0 AC

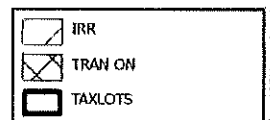

DATE: 10/28/2024

CLAIM OF BENEFICIAL USE MAP

NAME: WILLIS & LIZBETH LEE
TAXLOT #: 700 13.05 AC
TAXLOT #: 703 5.0 AC
TAXLOT #: 704 4.9 AC

ON LANDS
CERTIFICATE #:
79212 (IR): 22.95 AC
83727 (IS): 22.95 AC

This map is not intended to provide legal dimensions
or locations of property ownership lines.

CLAIM OF BENEFICIAL USE Site Report

Transfer Number: T-10277

District Internal Notice #: 04-57

User Name: Kris Yvon Yenney
(Herman/Mavis Blum)

Phone: 650-814-0580
Certificate: 79212 (IR)
Certificate: 83727 (IS)

Property: 1564 E Nevada St., Ashland

Place of Use:

USE	POD #	TWP	RNG	SEC	QQ	DLC	GOV'T LOT	TAX LOT	ACRES
IR	ALL	38 S	1 E	35	SW SW			600	3.44

TOTAL ACRES = 3.44

District Conveyance System:

Description of Delivery System: Private Turnout

Headgate: None Canal: Upper East

Beneficial Use:

Description of Beneficial Use: Lawn and Pasture

Method Used to Apply Water: Sprinkler irrigated. The water use is metered.

Method Used to Calculate Beneficial Use: Ariel map view verification comparing transfer map to the actual place of use 6/20/2024 HH

User Interviewed: () Yes (X) No

Beneficial Use Made as Authorized: (X) Yes () No

Description of Beneficial Use if Less than Authorized:

None

Inspected By: Sharee D. Burns Date: 10/14/2024
Sharee Burns, Executive Assistant

Instructions: Attach and label the corresponding final proof map.

**JACKSON COUNTY
SEC. 35 T38S R1E**

E-RECEIVED
1/21/2025
OWRD

SCALE - 1" = 400'



T-10277

SW 1/4 OF THE SW 1/4

DIN-04-57





RECEIVED

JUL 29 2024

TALENT
IRRIGATION DISTRICT

EXISTING RIGHTS
CERTIFICATE #:
79212 (IR): 0 AC
83727 (IS): 0 AC
83727 (IR): 0 AC

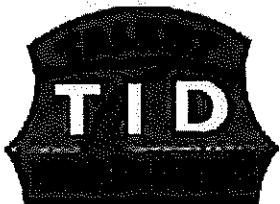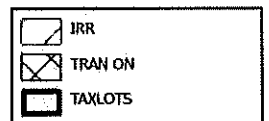

DATE: 07/28/2024

CLAIM OF BENEFICIAL USE MAP

NAME: KRIS YVON YENNEY
TAXLOT #: 600 3.44 AC

ON LANDS
CERTIFICATE #:
79212 (IR): 3.44 AC
83727 (IS): 3.44 AC

This map is not intended to provide legal dimensions
or locations of property ownership lines

CLAIM OF BENEFICIAL USE Site Report

Transfer Number: **T-10277**

District Internal Notice #: **04-59**

User Name: Kenneth and Amy Korth

Phone: 541-482-1843

Certificate: 83727 (IR)

Property: 1566 E Nevada St., Ashland

Place of Use:

USE	POD #	TWP	RNG	SEC	QQ	DLC	GOV'T LOT	TAX LOT	ACRES
IR	ALL	38 S	1 E	35	SW SW			502	.5
TOTAL ACRES =									.5

District Conveyance System:

Description of Delivery System: Private Turnout

Headgate: None Canal: Upper East

Beneficial Use:

Description of Beneficial Use: Lawn and Landscaping

Method Used to Apply Water: Sprinkler irrigated. The water use is metered.

Method Used to Calculate Beneficial Use: Ariel map view verification comparing transfer map to the actual place of use 6/20/2024 HH

User Interviewed: () Yes (X) No

Beneficial Use Made as Authorized: (X) Yes () No

Description of Beneficial Use if Less than Authorized:

None

Inspected By: Sharee I. Burns Date: 10/14/2024
Sharee Burns, Executive Assistant

Instructions: Attach and label the corresponding final proof map.

**JACKSON COUNTY
SEC. 35 T38S R1E**

E-RECEIVED
1/21/2025
OWRD

SCALE - 1" = 400'




T-10277

SW 1/4 OF THE SW 1/4

DIN-04-59

502
"ON"
0.5 AC


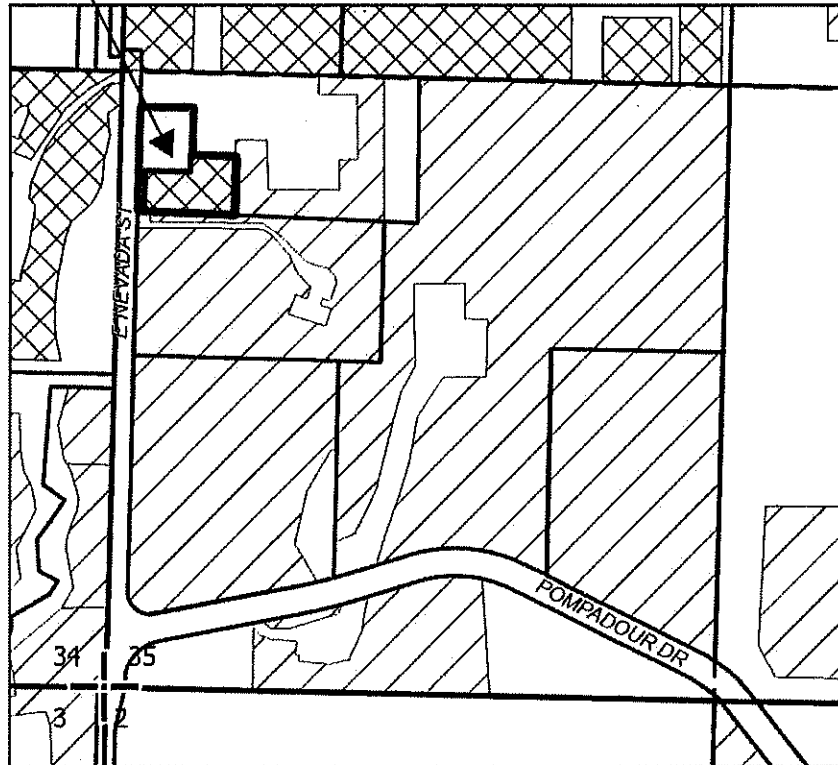


RECEIVED

JUL 29 2024

TALENT
IRRIGATION DISTRICT

EXISTING RIGHTS
CERTIFICATE #:
79212 (IR): 0 AC
83727 (IS): 0 AC
83727 (IR): 0 AC

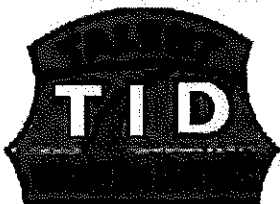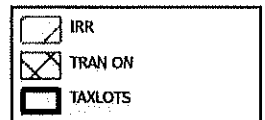

DATE: 07/28/2024

CLAIM OF BENEFICIAL USE MAP

NAME: KENNETH & AMY KORTH
TAXLOT #: 502 0.5 AC

ON LANDS
CERTIFICATE #:
83727 (IR): 0.5 AC

This map is not intended to provide legal dimensions
or locations of property ownership lines

CLAIM OF BENEFICIAL USE Site Report

Transfer Number: **T-10277**

District Internal Notice #: **04-61**

User Name: Wilson Family Trust
(B. Conrad/S. Claypool)

Phone: 310-488-6850
Certificate: 83727 (IR)

Property: 155 Pompadour Dr., Ashland

Place of Use:

USE	POD #	TWP	RNG	SEC	QQ	DLC	GOV'T LOT	TAX LOT	ACRES
IR	ALL	38 S	1 E	35	NE SW			302	2.0
TOTAL ACRES =									2.0

District Conveyance System:

Description of Delivery System: Private Turnout

Headgate: None Canal: Upper East

Beneficial Use:

Description of Beneficial Use: Lawn and Landscaping

Method Used to Apply Water: Sprinkler irrigated. The water use is metered.

Method Used to Calculate Beneficial Use: Ariel map view verification comparing transfer map to the actual place of use 6/20/2024 HH

User Interviewed: () Yes (X) No

Beneficial Use Made as Authorized: (X) Yes () No

Description of Beneficial Use if Less than Authorized:

None

Inspected By: Sharee Burns Date: 10/14/2024
Sharee Burns, Executive Assistant

Instructions: Attach and label the corresponding final proof map.

**JACKSON COUNTY
SEC. 35 T38S R1E**

E-RECEIVED
1/21/2025
OWRD


SCALE - 1" = 400'



T-10277

NE1/4 OF THE SW 1/4

DIN-04-61


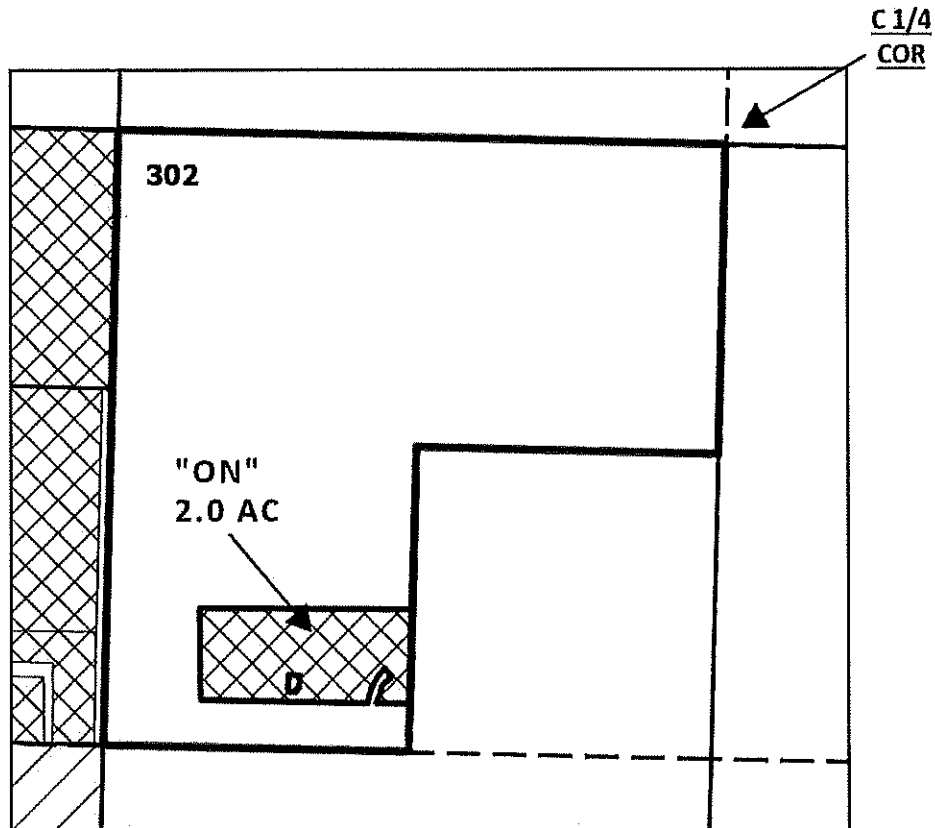


EXISTING RIGHTS
CERTIFICATE #:
83727 (IR): 0 AC

RECEIVED

JUL 29 2024

TALENT
IRRIGATION DISTRICT

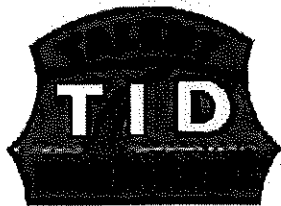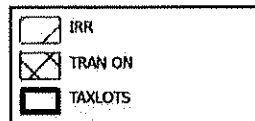

DATE: 07/28/2024

CLAIM OF BENEFICIAL USE MAP

NAME: WILSON FAMILY TRUST (CONRAD)
TAXLOT #: 302 2.0 AC

ON LANDS
CERTIFICATE #:
83727 (IR): 2.0 AC

This map is not intended to provide legal dimensions
or locations of property ownership lines

CLAIM OF BENEFICIAL USE Site Report

Transfer Number: **T-10277**

District Internal Notice #: **05-1**

User Name: James and Karen Hughes

Phone: 541-535-9570

Certificate: 79212 (IR)

Certificate: 83727 (IS)

Property: 3800 Pioneer Rd. Medford, OR 97501

Place of Use:

USE	POD #	TWP	RNG	SEC	QQ	DLC	GOV'T LOT	TAX LOT	ACRES
IR	ALL	38 S	1 W	18	SE NE			200	.43
IR	ALL	38 S	1W	18	NE SE			200	4.57
TOTAL ACRES =									5.0

District Conveyance System:

Description of Delivery System: Private turn out

Headgate: None

Canal: West Main

Beneficial Use:

Description of Beneficial Use: Lawn and Landscaping

Method Used to Apply Water: Sprinkler irrigated. The water use is metered.

Method Used to Calculate Beneficial Use: Ariel map view verification comparing transfer map to the actual place of use 6/20/2024 HH

User Interviewed: () Yes (X) No

Beneficial Use Made as Authorized: (X) Yes () No

Description of Beneficial Use if Less than Authorized:

None

Inspected By: Sharee Burns Date: 10/14/2024
Sharee Burns, Executive Assistant

Instructions: Attach and label the corresponding final proof map.

**JACKSON COUNTY
SEC. 18 T38S R1W**

E-RECEIVED
1/21/2025
OWRD

RECEIVED

JUL 29 2024

TALENT
IRRIGATION DISTRICT

SCALE - 1" = 400'



SE 1/4 OF THE NE 1/4; NE 1/4 OF THE SE 1/4



T-10277

DIN-05-01

EXISTING RIGHTS
CERTIFICATE #:

SENE
79212 (IR): 18.8 AC
83727 (IS): 18.8 AC

NESE
79212 (IR): 0.37 AC
83727 (IS): 0.37 AC
83727 (IR): 0.9 AC

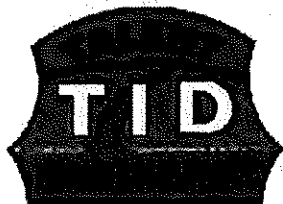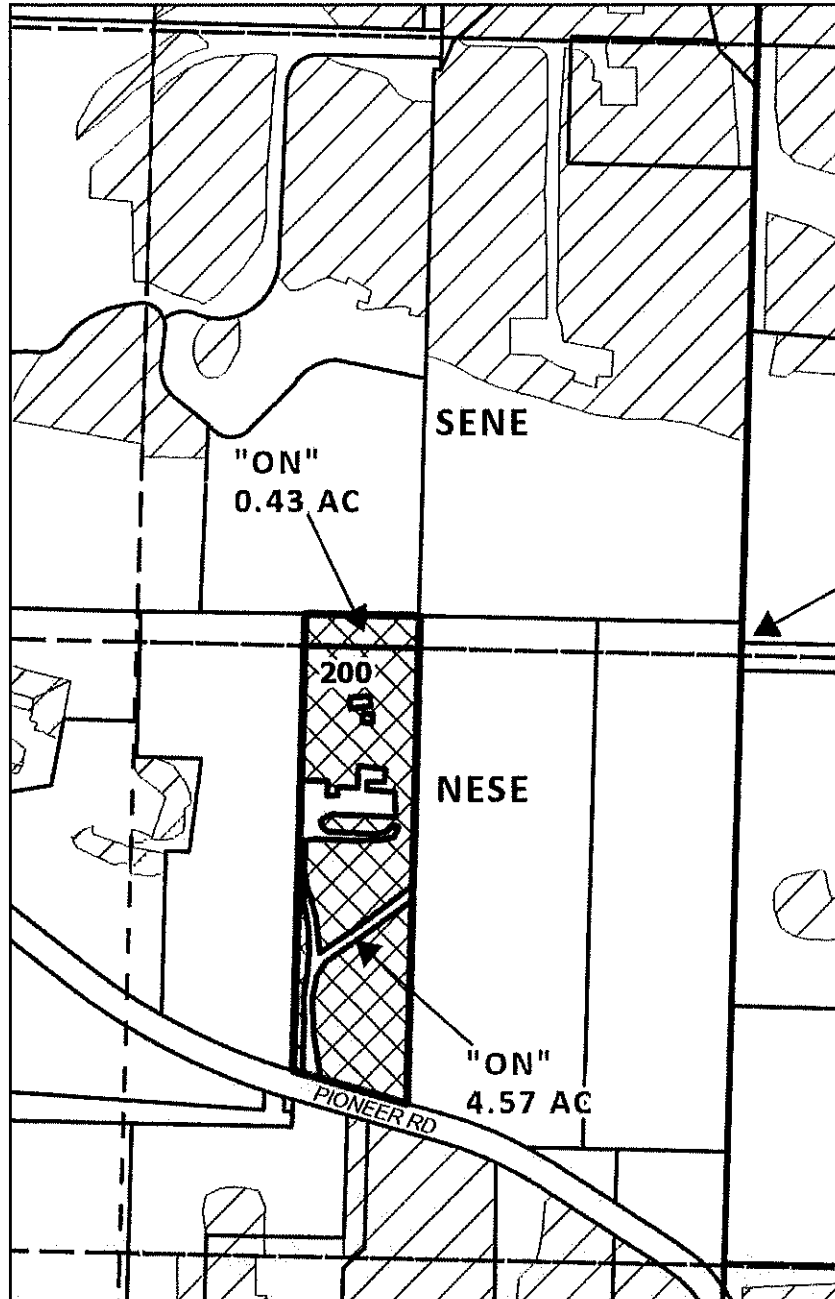

DATE: 07/22/2024

CLAIM OF BENEFICIAL USE MAP

NAME: JAMES & KAREN HUGHES
TAXLOT #: 200 5.0 AC
SENE: 0.43 AC
NESE: 4.57 AC

ON LANDS
CERTIFICATE #:
79212 (IR): 5.0 AC
83727 (IS): 5.0 AC

This map is not intended to provide legal dimensions
or locations of property ownership lines

CLAIM OF BENEFICIAL USE Site Report

Transfer Number: T-10277

District Internal Notice #: 05-1

User Name: Julie L Hauge Gray
(Donald and Julie Gray)

Phone: 541-261-7896
Certificate: 79212 (IR)
Certificate: 83727 (IS)

Property: 3557 Pioneer Rd. Medford, OR 97501

Place of Use:

USE	POD #	TWP	RNG	SEC	QQ	DLC	GOV'T LOT	TAX LOT	ACRES
IR	ALL	38 S	1 W	18	NE SE			2001	1.90
IR	ALL	38 S	1W	18	SE SE			2001	2.00
TOTAL ACRES =									3.9

District Conveyance System:

Description of Delivery System: Private turn out

Headgate: None Canal: West Main

Beneficial Use:

Description of Beneficial Use: Lawn and Landscaping

Method Used to Apply Water: Sprinkler irrigated. The water use is metered.

Method Used to Calculate Beneficial Use: Ariel map view verification comparing transfer map to the actual place of use 6/20/2024 HH

User Interviewed: () Yes (X) No

Beneficial Use Made as Authorized: (X) Yes () No

Description of Beneficial Use if Less than Authorized:

None

Inspected By: Sharee D. Burns Date: 10/14/2024
Sharee Burns, Executive Assistant

Instructions: Attach and label the corresponding final proof map.

**JACKSON COUNTY
SEC. 18 T38S R1W**

E-RECEIVED
1/21/2025
OWRD

RECEIVED

JUL 29 2024

TALENT
IRRIGATION DISTRICT

SCALE - 1" = 400'



NE 1/4 OF THE SE 1/4; SE 1/4 OF THE SE 1/4




T-10277

DIN-05-01

EXISTING RIGHTS
CERTIFICATE #:

NESE
79212 (IR): 0.37 AC
83727 (IS): 0.37 AC
83727 (IR): 0.9 AC

SESE
79212 (IR): 24.7 AC
83727 (IS): 24.7 AC

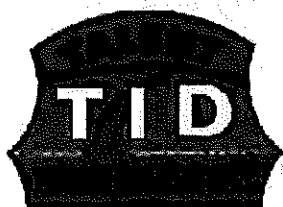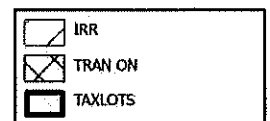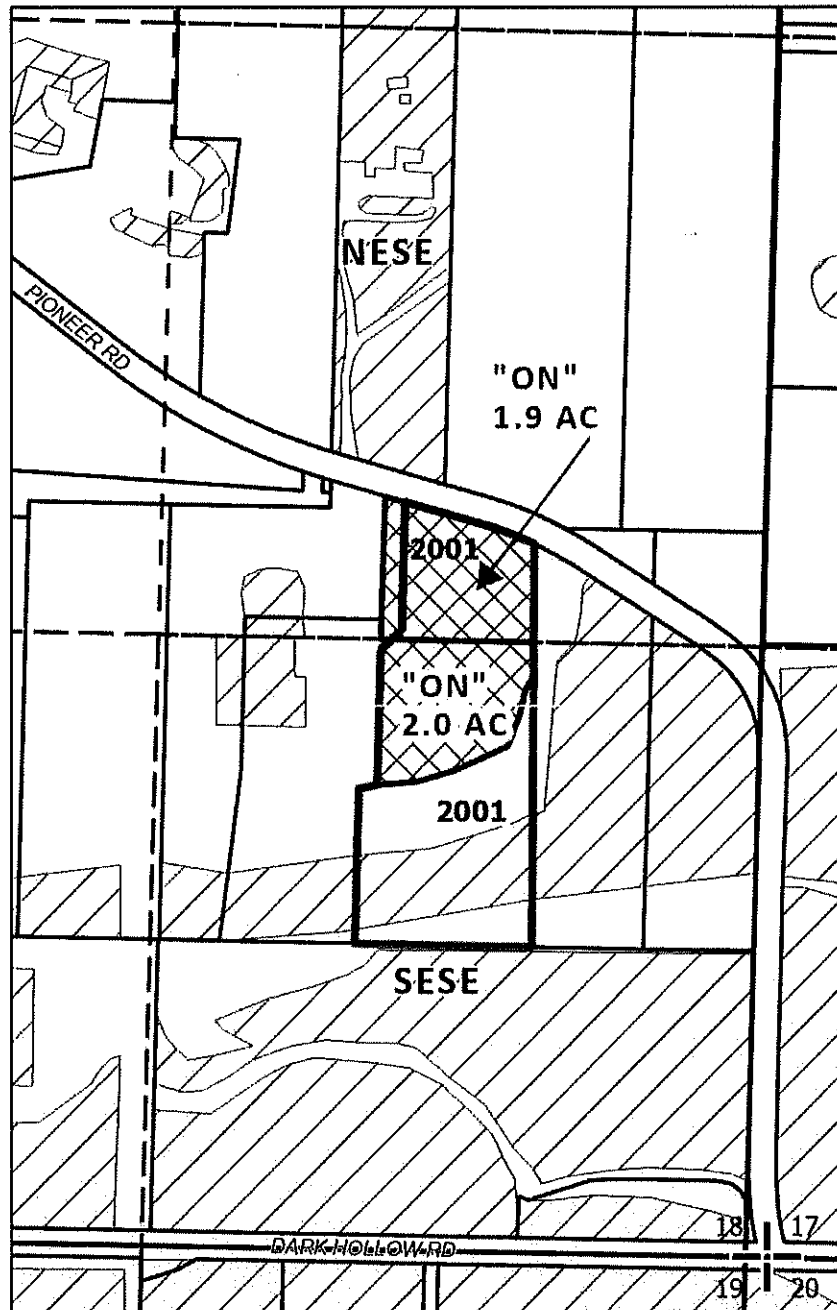

DATE: 07/22/2024

CLAIM OF BENEFICIAL USE MAP

NAME: DONALD & JULIE GRAY

TAXLOT #: 2001 3.9 AC

NESE: 1.9 AC

SESE: 2.0 AC

ON LANDS
CERTIFICATE #:
79212 (IR): 3.9 AC
83727 (IS): 3.9 AC

This map is not intended to provide legal dimensions
or locations of property ownership lines

CLAIM OF BENEFICIAL USE Site Report

Transfer Number: **T-10277**

District Internal Notice #: **05-2**

User Name: Mount Family Living Trust
(Michael and Patricia Benton)

Phone: 509-592-3804
Certificate: 83727 (IR)

Property: 4398 Griffin Creek Rd. Medford, OR 97501

Place of Use:

USE	POD #	TWP	RNG	SEC	QQ	DLC	GOV'T LOT	TAX LOT	ACRES
IR	ALL	38 S	2 W	14	NW NW			209	.60
IR	ALL	38 S	2 W	15	NE NE			209	4.90

TOTAL ACRES = 5.50

District Conveyance System:

Description of Delivery System: Private turn out

Headgate: None Canal: West Main

Beneficial Use:

Description of Beneficial Use: Lawn and Landscaping

Method Used to Apply Water: Sprinkler irrigated. The water use is metered.

Method Used to Calculate Beneficial Use: Ariel map view verification comparing transfer map to the actual place of use 6/20/2024 HH

User Interviewed: () Yes (X) No

Beneficial Use Made as Authorized: (X) Yes () No

Description of Beneficial Use if Less than Authorized:

None

Inspected By: Sharee O. Burns Date: 10/14/2024
Sharee Burns, Executive Assistant

Instructions: Attach and label the corresponding final proof map.

**JACKSON COUNTY
SEC. 14, 15 T38S R2W**

E-RECEIVED
1/21/2025
OWRD

RECEIVED
AUG 14 2024

SCALE - 1" = 400'



TALENT
IRRIGATION DISTRICT


NE 1/4 OF THE NE 1/4 (SEC 15); NW 1/4 OF THE NW 1/4 (SEC 14)

T-10277

DIN-05-02



**SEC 15
NENE**

**SEC 14
NWNW**

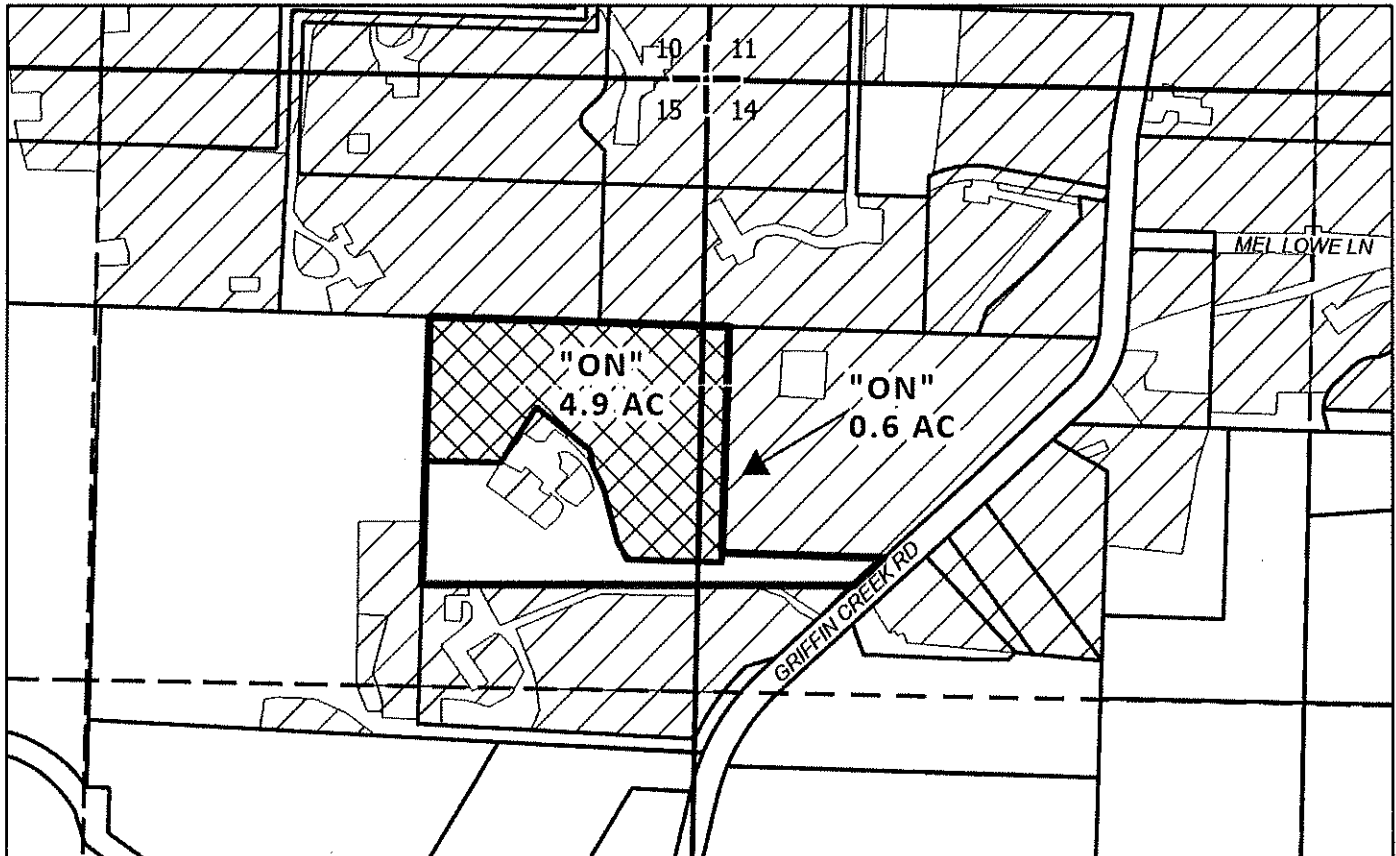

EXISTING RIGHTS
CERTIFICATE #:

NENE (SEC 15)	NWNW (SEC 14)
79212 (IR): 17.1 AC	79212 (IR): 26.45 AC
83727 (IS): 17.1 AC	83727 (IS): 26.45 AC
83727 (IR): 1.6 AC	83727 (IR): 0 AC

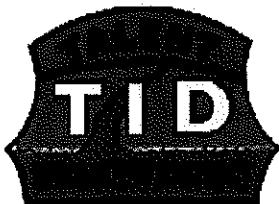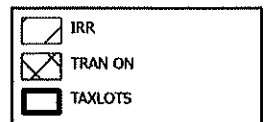

DATE: 07/28/2024

CLAIM OF BENEFICIAL USE MAP

NAME: MOUNT FAMILY LIV TR (BENTON)
TAXLOT #: 209 5.5 AC
NWNW (SEC 14): 0.6 AC
NENE (SEC 15): 4.9 AC

ON LANDS
CERTIFICATE #:

83727 (IR): 5.5 AC

This map is not intended to provide legal dimensions
or locations of property ownership lines

CLAIM OF BENEFICIAL USE Site Report

Transfer Number: **T-10277**

District Internal Notice #: **05-3**

User Name: Silver Spring Farm, LLC
(Lara Schleining)

Phone: 541-631-9887
Certificate: 79212 (IR)
Certificate: 83727 (IS)
Certificate: 83727 (IR) 1.9 & 12.67

Property: 1313 E Nevada St. Ashland, OR 97520

Place of Use:

USE	POD #	TWP	RNG	SEC	QQ	DLC	GOV'T LOT	TAX LOT	ACRES
IR	ALL	39 S	1 E	03	NE NE			100	5.10
IR	ALL	39 S	1 E	03	NE NE			100	2.50
IR	ALL	39 S	1 E	03	NE NE			100	1.40
IR	ALL	39 S	1 E	03	NE NE			100	1.90
IR	ALL	38 S	1 E	34	SE SE			100	.70
IR	ALL	38 S	1 E	34	SE SE			100	12.67
IR	ALL	38 S	1 E	34	SE SE			100	.43

TOTAL ACRES = 24.70

District Conveyance System:

Description of Delivery System: Private turn out

Headgate: None Canal: East Main

Beneficial Use:

Description of Beneficial Use: Pasture

Method Used to Apply Water: Sprinkler irrigated. The water use is metered.

Method Used to Calculate Beneficial Use: Ariel map view verification comparing transfer map to the actual place of use 6/20/2024 HH

User Interviewed: () Yes (X) No

Beneficial Use Made as Authorized: (X) Yes () No

Description of Beneficial Use if Less than Authorized:

None

Inspected By: Sharee D. Burns Date: 10/14/2024
Sharee Burns, Executive Assistant

Instructions: Attach and label the corresponding final proof map.

JACKSON COUNTY

SEC. 34 T38S R1E, SEC. 03 T39S R1E

OWRD E-RECEIVED
1/28/2025
AMENDED


SCALE - 1" = 400'



SE 1/4 OF THE SE 1/4 (SEC 34); NE 1/4 OF THE NE 1/4 (SEC 03)

T-10277

DIN-05-03

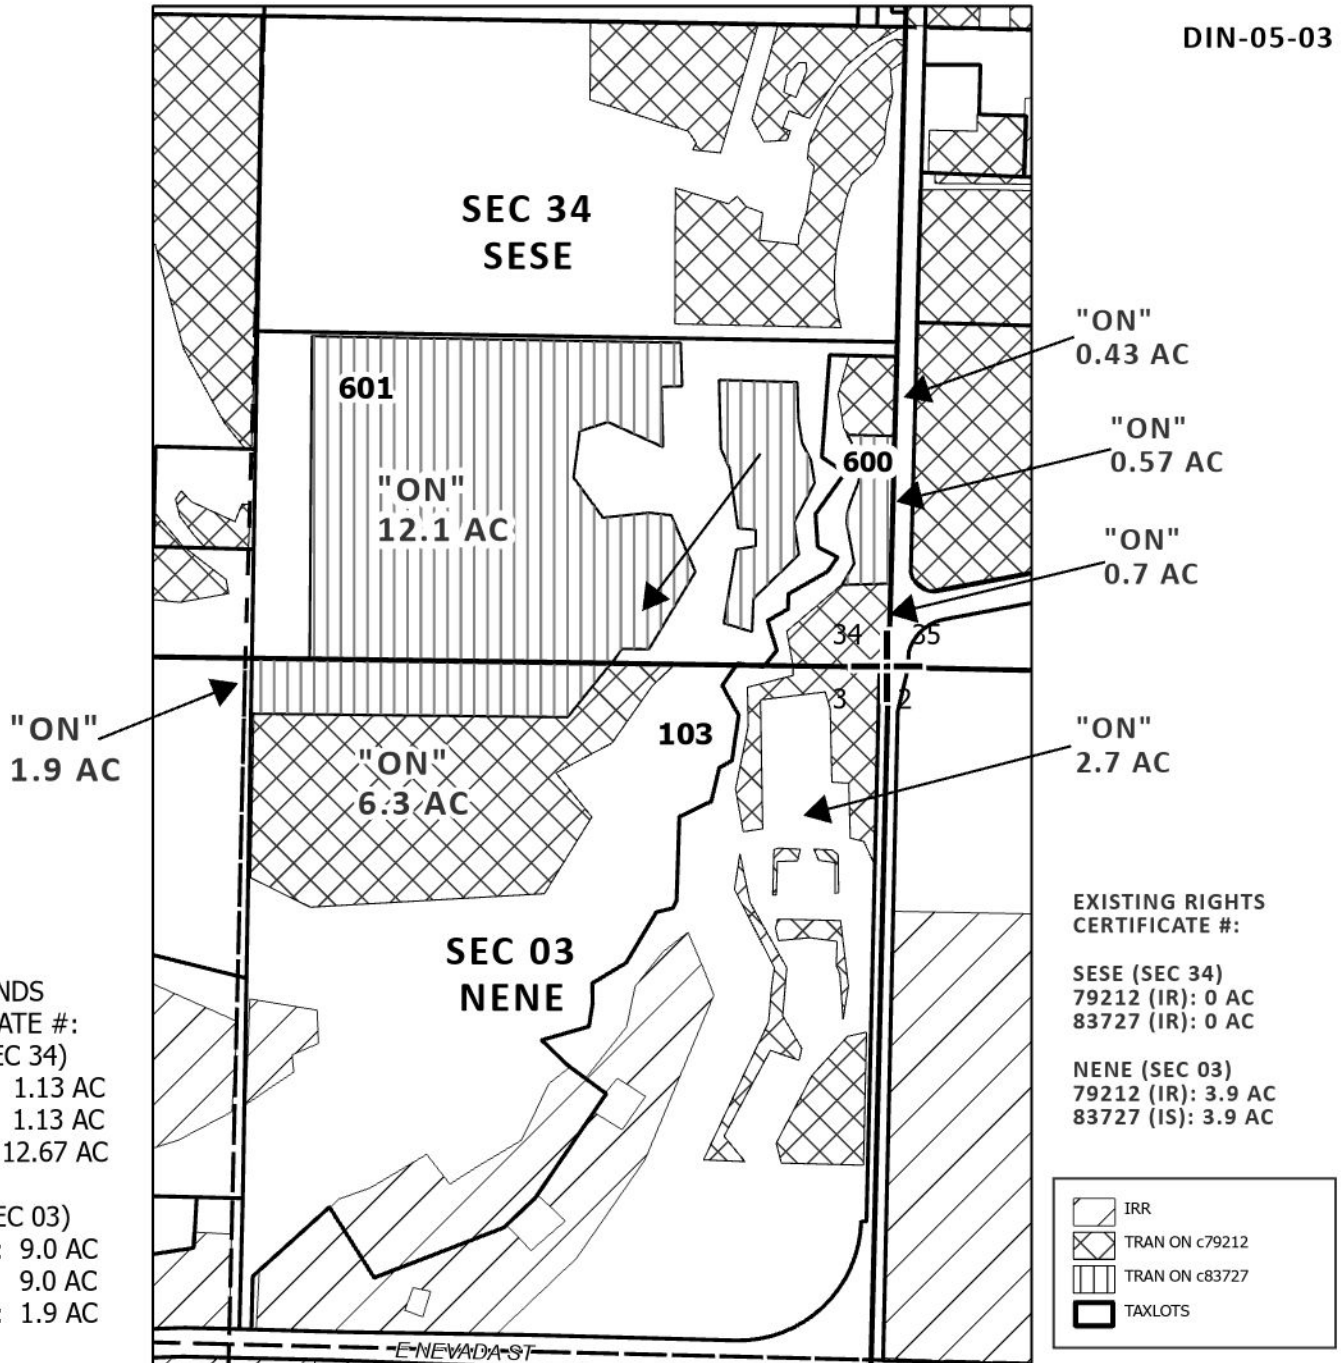

ON LANDS
CERTIFICATE #:
SESE (SEC 34)
79212 (IR): 1.13 AC
83727 (IS): 1.13 AC
83727 (IR): 12.67 AC

NENE (SEC 03)
79212 (IR): 9.0 AC
83727 (IS): 9.0 AC
83727 (IR): 1.9 AC

EXISTING RIGHTS
CERTIFICATE #:

SESE (SEC 34)
79212 (IR): 0 AC
83727 (IR): 0 AC

NENE (SEC 03)
79212 (IR): 3.9 AC
83727 (IS): 3.9 AC

CLAIM OF BENEFICIAL USE MAP

NAME: LARA SCHLEINING (DBA SILVER SPRINGS RANCH)	
TAXLOT #: 600	TAXLOT #: 601
SESE (SEC 34): 1.7 AC	SESE (SEC 34): 12.1 AC
TAXLOT #: 100	TAXLOT #: 601
NENE (SEC 03): 2.7 AC	NENE (SEC 03): 8.2 AC



DATE: 01/22/2025

This map is not intended to provide
legal dimensions or locations of
property ownership lines

CLAIM OF BENEFICIAL USE Site Report

Transfer Number: **T-10277**

District Internal Notice #: **05-4**

User Name: 261 Holdings LLC
(Ron and Susan Crowell)

Phone: 562-882-3575
Certificate: 83727 (IR)

Property: 261 Ryder Ln. Ashland, OR 97520

Place of Use:

USE	POD #	TWP	RNG	SEC	QQ	DLC	GOV'T LOT	TAX LOT	ACRES
IR	ALL	39 S	2 E	19	NW NE			134	1.70
IR	ALL	39 S	2 E	19	NW NE			134	.30
IR	ALL	39 S	2 E	19	SW NE			134	.30

TOTAL ACRES = 2.30

District Conveyance System:

Description of Delivery System: Private turn out in the Corp Ranch Road Water
Improvement District.

Headgate: None Canal: Ashland Main

Beneficial Use:

Description of Beneficial Use: Lawn and Landscaping

Method Used to Apply Water: Sprinkler irrigated. The water use is metered.

Method Used to Calculate Beneficial Use: Ariel map view verification comparing transfer map
to the actual place of use 6/20/2024 HH

User Interviewed: () Yes (X) No

Beneficial Use Made as Authorized: (X) Yes () No

Description of Beneficial Use if Less than Authorized:

None

Inspected By: Sheree Burns Date: 10/14/2024
Sheree Burns, Executive Assistant

Instructions: Attach and label the corresponding final proof map.

JACKSON COUNTY
SEC. 19 T39S R2E

E-RECEIVED
1/21/2025
OWRD

RECEIVED
AUG 14 2024

SCALE - 1" = 400'


TALENT
IRRIGATION DISTRICT

NW 1/4 OF THE NE 1/4 ; SW 1/4 OF THE NE 1/4

T-10277

DIN-05-04

N 1/4
COR

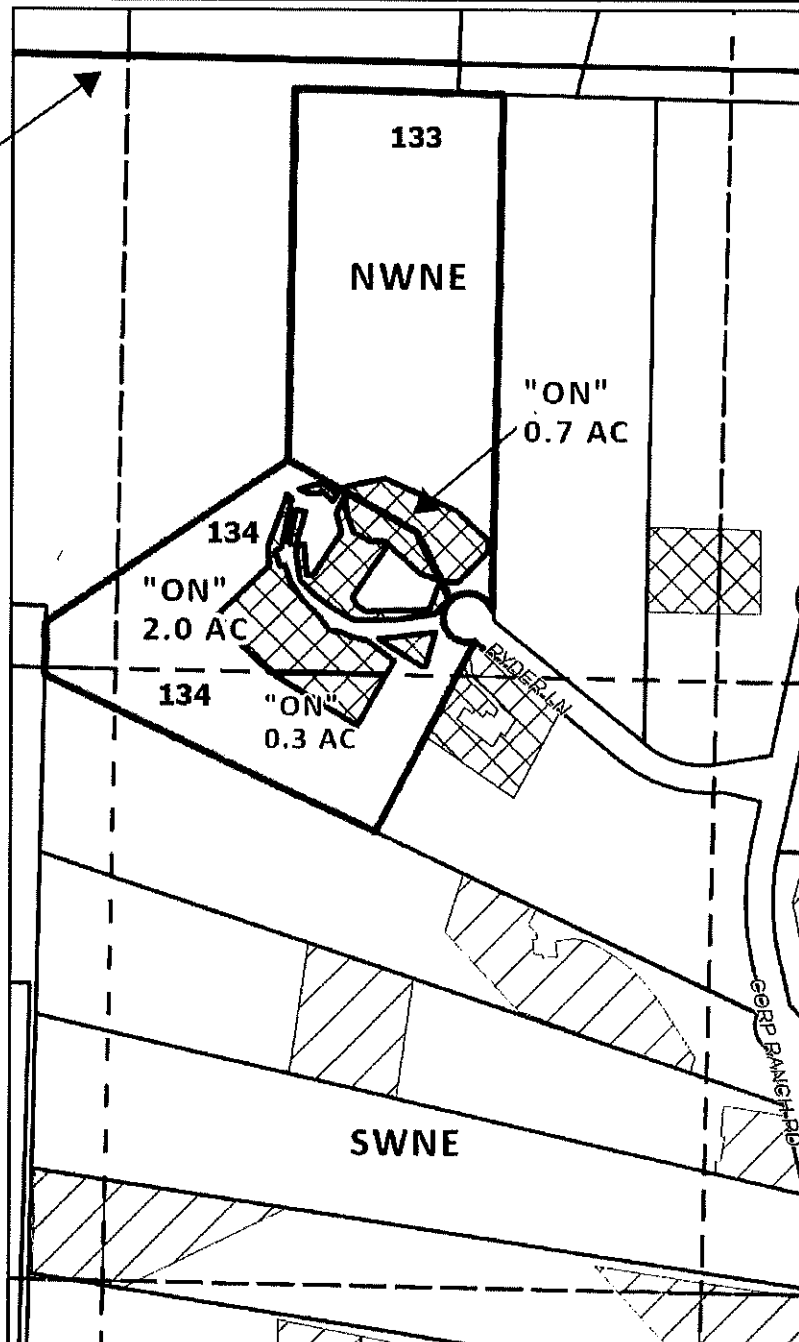

EXISTING RIGHTS
CERTIFICATE #:

NWNE
83727 (IR): 0 AC


SWNE
83727 (IR): 0 AC

ON LANDS
CERTIFICATE #:
NWNE
83727 (IR) 2.7 AC

SWNE
83727 (IR) 0.3 AC

CLAIM OF BENEFICIAL USE MAP

NAME: RONALD & SUSAN CROWELL
TAXLOT #: 133
NWNE: 0.7 AC
TAXLOT #: 134
NWNE: 2.0 AC
SWNE: 0.3 AC

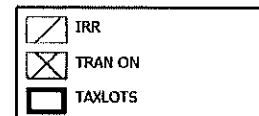

This map is not intended to provide legal dimensions
or locations of property ownership lines



DATE: 08/2/2024

CLAIM OF BENEFICIAL USE Site Report

Transfer Number: **T-10277**

District Internal Notice #: **05-4**

User Name: Keene Troy LLC
(Ron and Susan Crowell)

Phone: 562-882-3575
Certificate: 83727 (IR)

Property: 133 Ryder Ln. Ashland, OR 97520

Place of Use:

USE	POD #	TWP	RNG	SEC	QQ	DLC	GOV'T LOT	TAX LOT	ACRES
IR	ALL	39 S	2 E	19	NW NE			133	.70
TOTAL ACRES =									.70

District Conveyance System:

Description of Delivery System: Private turn out in the Corp Ranch Road Water

Improvement District.

Headgate: None

Canal: Ashland Main

Beneficial Use:

Description of Beneficial Use: Lawn and Landscaping

Method Used to Apply Water: Sprinkler irrigated. The water use is metered.

Method Used to Calculate Beneficial Use: Ariel map view verification comparing transfer map to the actual place of use 6/20/2024 HH

User Interviewed: () Yes (X) No

Beneficial Use Made as Authorized: (X) Yes () No

Description of Beneficial Use if Less than Authorized:

None

Inspected By: Sharee D. Burns Date: 7/5/2024
Sharee Burns, Executive Assistant

Instructions: Attach and label the corresponding final proof map.

**JACKSON COUNTY
SEC. 19 T39S R2E**

E-RECEIVED

1/21/2025

OWRD

SCALE - 1" = 400'




NW 1/4 OF THE NE 1/4 ; SW 1/4 OF THE NE 1/4

T-10277

DIN-05-04

N 1/4
COR

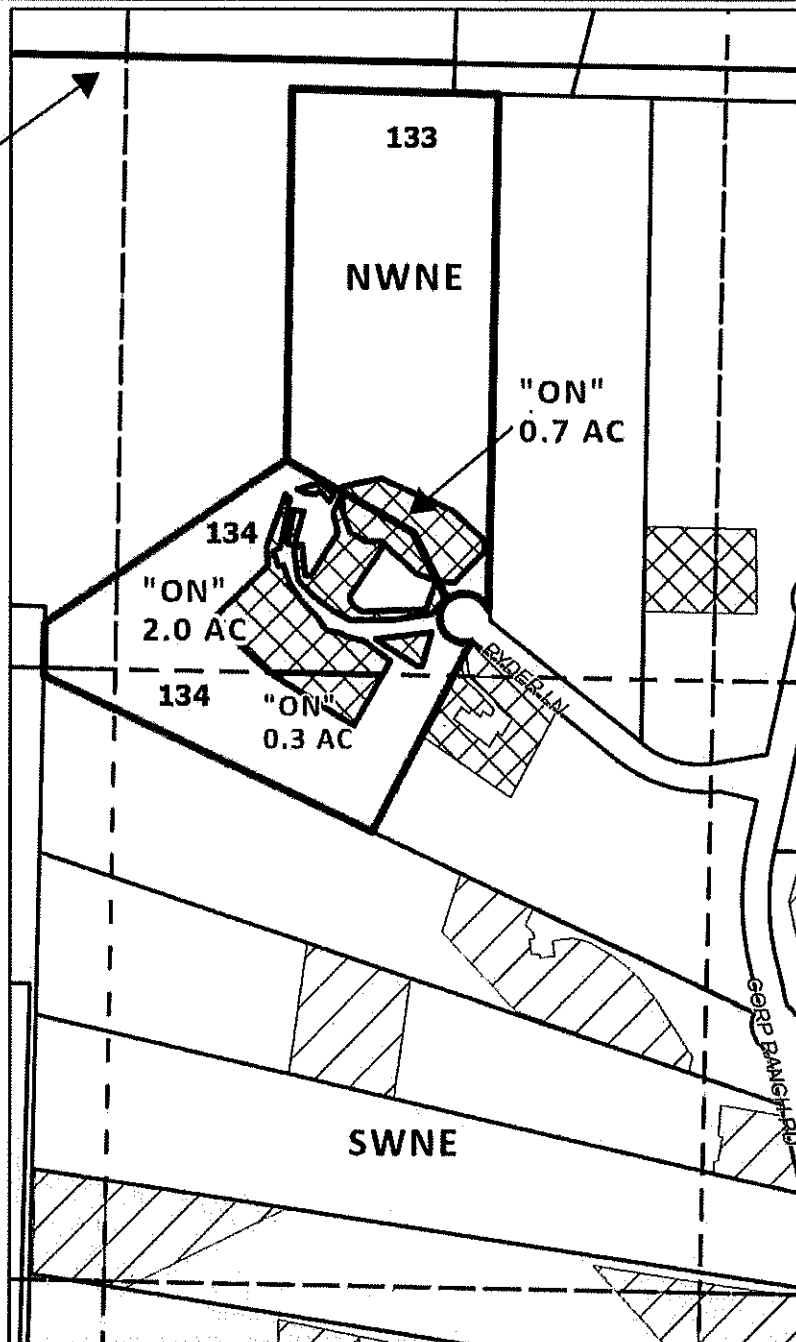


EXISTING RIGHTS
CERTIFICATE #:

NWNE
83727 (IR): 0 AC

SWNE
83727 (IR): 0 AC

ON LANDS
CERTIFICATE #:
NWNE
83727 (IR) 2.7 AC

SWNE
83727 (IR) 0.3 AC

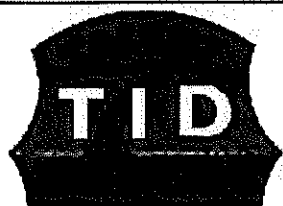

DATE: 08/2/2024

CLAIM OF BENEFICIAL USE MAP

NAME: RONALD & SUSAN CROWELL


TAXLOT #: 133

NWNE: 0.7 AC

TAXLOT #: 134

NWNE: 2.0 AC

SWNE: 0.3 AC

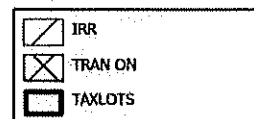

This map is not intended to provide legal dimensions
or locations of property ownership lines

CLAIM OF BENEFICIAL USE Site Report

Transfer Number: **T-10277**

District Internal Notice #: **05-5**

User Name: Jorge Yant
(David White)

Phone: 541-944-7317
Certificate: 83727 (IR)

Property: 10880 Corp Ranch Rd. Ashland, OR 97520

Place of Use:

USE	POD #	TWP	RNG	SEC	QQ	DLC	GOV'T LOT	TAX LOT	ACRES
IR	ALL	39 S	2 E	19	NE NE			130	1.0
TOTAL ACRES =									1.0

District Conveyance System:

Description of Delivery System: Private turn out in the Corp Ranch Road Water
Improvement District.

Headgate: None Canal: Ashland Main

Beneficial Use:

Description of Beneficial Use: Lawn and Landscaping

Method Used to Apply Water: Sprinkler irrigated. The water use is metered.

Method Used to Calculate Beneficial Use: Ariel map view verification comparing transfer map
to the actual place of use 6/20/2024 HH

User Interviewed: () Yes (X) No

Beneficial Use Made as Authorized: (X) Yes () No

Description of Beneficial Use if Less than Authorized:

None

Inspected By: Sharee Burns Date: 10/14/2024
Sharee Burns, Executive Assistant

Instructions: Attach and label the corresponding final proof map.

**JACKSON COUNTY
SEC. 19 T39S R2E**

SCALE - 1" = 400'



NE 1/4 OF THE NE 1/4

E-RECEIVED
1/21/2025
OWRD


RECEIVED

AUG 14 2024



TALENT
IRRIGATION DISTRICT

T-10277

DIN-05-05

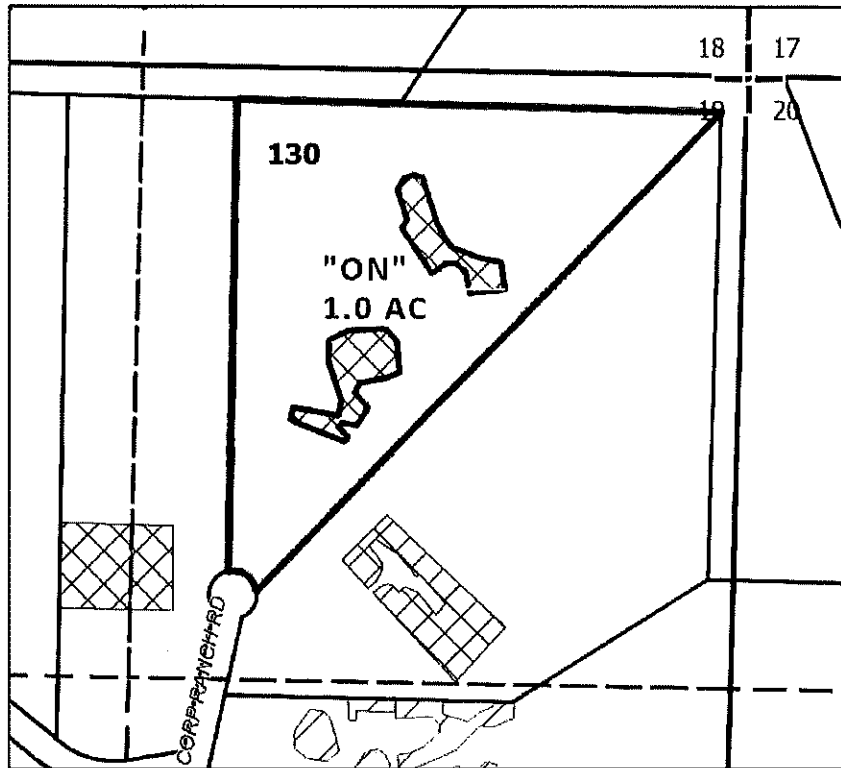

EXISTING RIGHTS
CERTIFICATE #:
83727 (IR): 0 AC

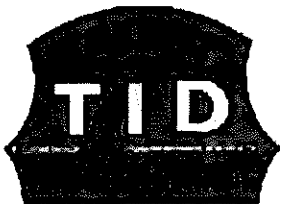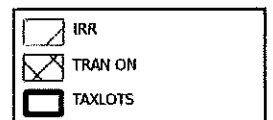

DATE: 07/28/2024

CLAIM OF BENEFICIAL USE MAP

NAME: JORGE YANT (WHITE)
TAXLOT #: 130 1.0 AC

ON LANDS
CERTIFICATE #:
83727 (IR): 1.0 AC

This map is not intended to provide legal dimensions
or locations of property ownership lines

CLAIM OF BENEFICIAL USE Site Report

Transfer Number: **T-10277**

District Internal Notice #: **05-9**

User Name: Barry and Susan Miller
(James C./G. and Claire Elliott)

Phone: 925-895-9292
Certificate: 83727 (IR)

Property: 10888 Corp Ranch Rd. Ashland, OR 97520

Place of Use:

USE	POD #	TWP	RNG	SEC	QQ	DLC	GOV'T LOT	TAX LOT	ACRES
IR	ALL	39 S	2 E	19	NE NE			129	1.0
TOTAL ACRES =									1.0

District Conveyance System:

Description of Delivery System: Private turn out in the Corp Ranch Road Water

Improvement District.

Headgate: None

Canal: Ashland Main

Beneficial Use:

Description of Beneficial Use: Lawn and Landscaping

Method Used to Apply Water: Sprinkler irrigated. The water use is metered.

Method Used to Calculate Beneficial Use: Ariel map view verification comparing transfer map to the actual place of use 6/21/2024 HH

User Interviewed: () Yes (X) No

Beneficial Use Made as Authorized: (X) Yes () No

Description of Beneficial Use if Less than Authorized:

None

Inspected By: Sharee Burns Date: 10/14/2024
Sharee Burns, Executive Assistant

Instructions: Attach and label the corresponding final proof map.

**JACKSON COUNTY
SEC. 19 T39S R2E**

SCALE - 1" = 400'



NE 1/4 OF THE NE 1/4

E-RECEIVED
1/21/2025
OWRD


RECEIVED

AUG 14 2024



TALENT
IRRIGATION DISTRICT

T-10277

DIN-05-09

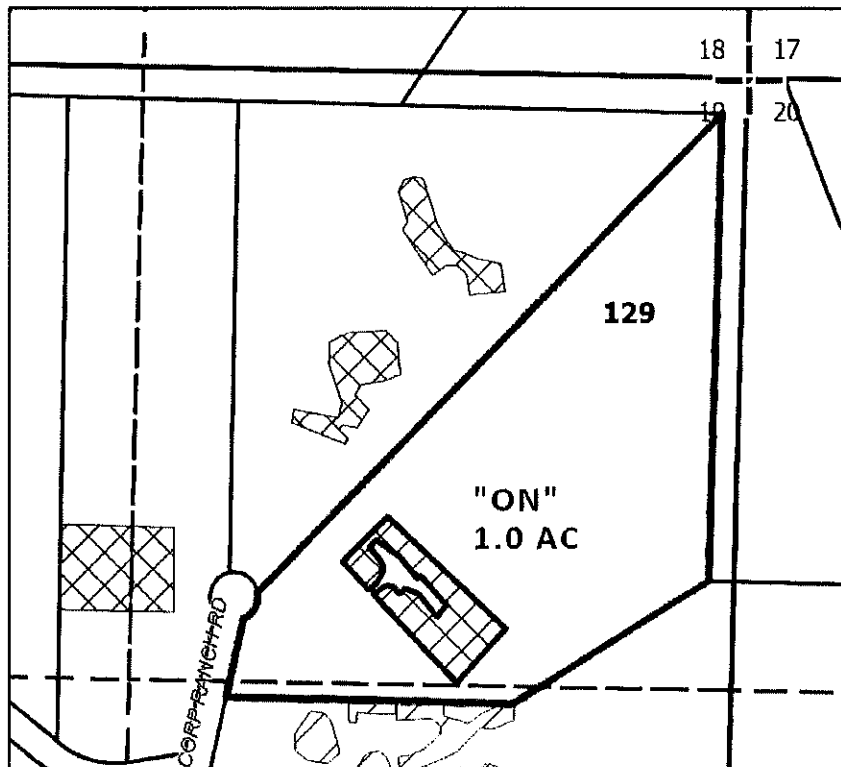

EXISTING RIGHTS
CERTIFICATE #:
83727 (IR): 0 AC

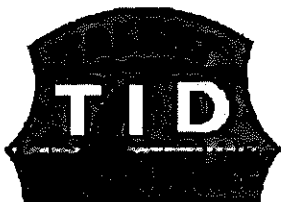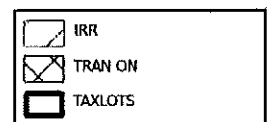

DATE: 08/03/2024

CLAIM OF BENEFICIAL USE MAP

NAME: BARRY & SUSAN MILLER (ELLIOT)
TAXLOT #: 129 1.0 AC

ON LANDS
CERTIFICATE #:
83727 (IR): 1.0 AC

This map is not intended to provide legal dimensions
or locations of property ownership lines

CLAIM OF BENEFICIAL USE Site Report

 Transfer Number: **T-10277**

 District Internal Notice #: **05-10**

 User Name: Trevor and Bree Peterson
 (Peter and Vera Kirkpatrick)

 Phone: 702-813-3335
 Certificate: 83727 (IR)

 Property: 10950 Corp Ranch Rd. Ashland, OR 97520

Place of Use:

USE	POD #	TWP	RNG	SEC	QQ	DLC	GOV'T LOT	TAX LOT	ACRES
IR	ALL	39 S	2 E	19	SE NE			110	1.0
IR	ALL	39 S	2 E	19	SE NE			110	1.0
IR	ALL	39 S	2 E	19	SE NE			128	1.0
IR	ALL	39 S	2 E	19	SE NE			128	1.0

TOTAL ACRES = 4.0

District Conveyance System:

 Description of Delivery System: Private turn out in the Corp Ranch Road Water
Improvement District.

 Headgate: None Canal: Ashland Main

Beneficial Use:

 Description of Beneficial Use: Lawn and Landscaping

 Method Used to Apply Water: Sprinkler irrigated. The water use is metered.

 Method Used to Calculate Beneficial Use: Ariel map view verification comparing transfer map
to the actual place of use 6/21/2024 HH

User Interviewed: () Yes (X) No

Beneficial Use Made as Authorized: (X) Yes () No

Description of Beneficial Use if Less than Authorized:

None

 Inspected By: Sharee D. Burns Date: 10/14/2024
 Sharee Burns, Executive Assistant

Instructions: Attach and label the corresponding final proof map.

**JACKSON COUNTY
SEC. 19 T39S R2E**

SCALE - 1" = 400'



SE 1/4 OF THE NE 1/4

E-RECEIVED
1/21/2025
OWRD


RECEIVED

AUG 14 2024

TALENT
IRRIGATION DISTRICT


T-10277

DIN-05-10

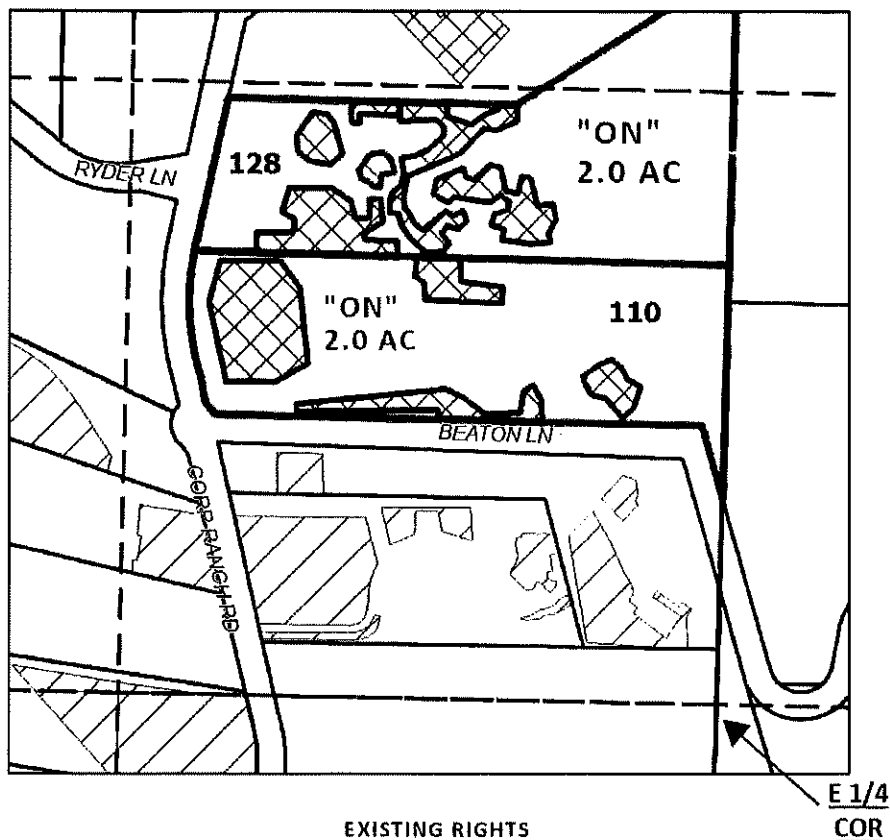

EXISTING RIGHTS
CERTIFICATE #:
83727 (IR): 0 AC

E 1/4
COR

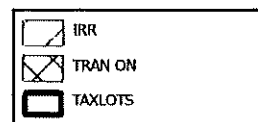

DATE: 07/28/2024

CLAIM OF BENEFICIAL USE MAP

NAME: TREVOR & BREE PETERSON (KIRKPATRICK)
TAXLOT #: 110 2.0 AC
TAXLOT #: 128 2.0 AC

ON LANDS
CERTIFICATE #:
83727 (IR): 4.0 AC

This map is not intended to provide legal dimensions
or locations of property ownership lines

CLAIM OF BENEFICIAL USE Site Report

Transfer Number: **T-10277**

District Internal Notice #: **05-12**

User Name: Columbia Vista LLC
(Raul and Thalia Keple)

Phone: 503-519-1009
Certificate: 79212 (IR)
Certificate: 83727 (IS)

Property: 500 Jeffrey Dr. Ashland, OR 97520

Place of Use:

USE	POD #	TWP	RNG	SEC	QQ	DLC	GOV'T LOT	TAX LOT	ACRES
IR	ALL	39 S	2 E	20	NE SW			505	.50
TOTAL ACRES =									.50

District Conveyance System:

Description of Delivery System: Private turn out in the Corp Ranch Road Water
Improvement District.

Headgate: None Canal: Ashland Main

Beneficial Use:

Description of Beneficial Use: Lawn and Landscaping

Method Used to Apply Water: Sprinkler irrigated. The water use is metered.

Method Used to Calculate Beneficial Use: Ariel map view verification comparing transfer map
to the actual place of use 6/21/2024 HH

User Interviewed: () Yes (X) No

Beneficial Use Made as Authorized: (X) Yes () No

Description of Beneficial Use if Less than Authorized:

None

Inspected By: Sharee D. Burns Date: 10/14/2024
Sharee Burns, Executive Assistant

Instructions: Attach and label the corresponding final proof map.

**JACKSON COUNTY
SEC. 20 T39S R2E**

SCALE - 1" = 400'



NE 1/4 OF THE SW 1/4

E-RECEIVED

1/21/2025

OWRD


RECEIVED

AUG 14 2024



TALENT
IRRIGATION DISTRICT

T-10277

DIN-05-12

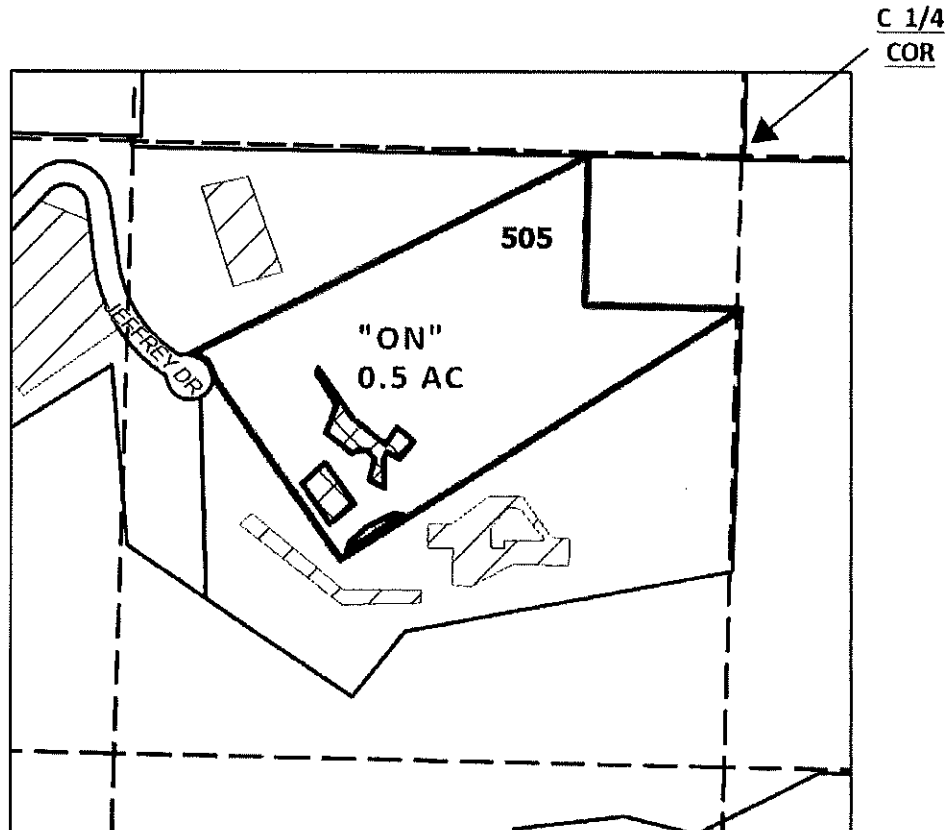

EXISTING RIGHTS
CERTIFICATE #:
79212 (IR): 0 AC
83727 (IS): 0 AC

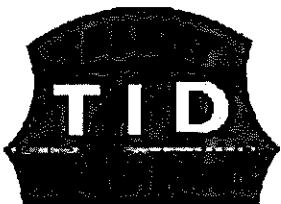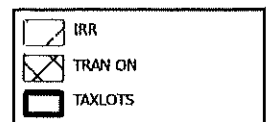

DATE: 08/04/2024

CLAIM OF BENEFICIAL USE MAP

NAME: COLUMBIA VISTA, LLC (KEPLE)
TAXLOT #: 505 0.5 AC

ON LANDS
CERTIFICATE #:
79212 (IR): 0.5 AC
83727 (IS): 0.5 AC

This map is not intended to provide legal dimensions
or locations of property ownership lines

CLAIM OF BENEFICIAL USE Site Report

Transfer Number: **T-10277**

District Internal Notice #: **05-15**

User Name: Richard and Karen Titus Family Trust

Phone: 541-488-3031

Certificate: 79212 (IR) Certificate: 83727 (IS) - .40

Certificate: 83727 (IR) - .60

Property: 133 Jeffrey Dr. Ashland, OR 97520

Place of Use:

USE	POD #	TWP	RNG	SEC	QQ	DLC	GOV'T LOT	TAX LOT	ACRES
IR	ALL	39 S	2 E	20	SW NW			400	.60
IR	ALL	39 S	2 E	20	SW NW			400	.40

TOTAL ACRES = 1.0

District Conveyance System:

Description of Delivery System: Private turn out in the Corp Ranch Road Water

Improvement District.

Headgate: None

Canal: Ashland Main

Beneficial Use:

Description of Beneficial Use: Lawn and Landscaping

Method Used to Apply Water: Sprinkler irrigated. The water use is metered.

Method Used to Calculate Beneficial Use: Ariel map view verification comparing transfer map to the actual place of use 6/21/2024 HH

User Interviewed: () Yes (X) No

Beneficial Use Made as Authorized: (X) Yes () No

Description of Beneficial Use if Less than Authorized:

None

Inspected By: Sharee I. Burns

Sharee Burns, Executive Assistant

Date: 7/9/2024

Instructions: Attach and label the corresponding final proof map.

JACKSON COUNTY
SEC. 20 T39S R2E

SCALE - 1" = 400'



SW 1/4 OF THE NW 1/4


E-RECEIVED

1/21/2025

OWRD

T-10277

DIN-05-15

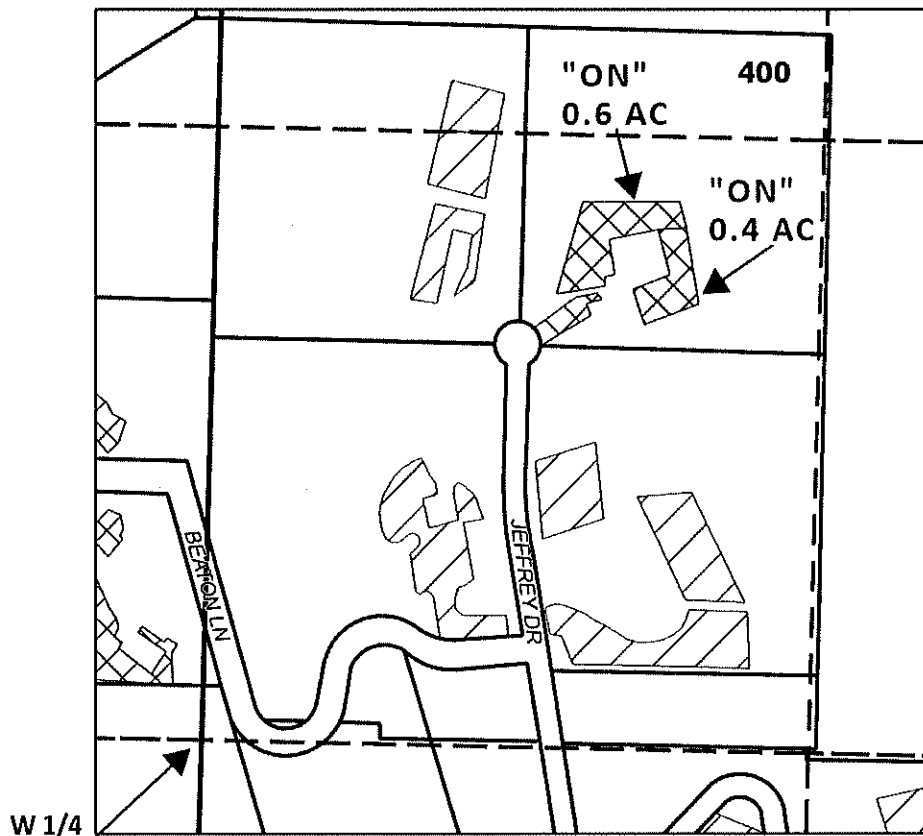


W 1/4
COR

EXISTING RIGHTS
CERTIFICATE #:
C79212: 0.0 AC
C83727: 0.0 AC

RECEIVED
JAN 20 2025
TALENT
IRRIGATION DISTRICT

	IRR
	TRAN ON
	TAXLOTS

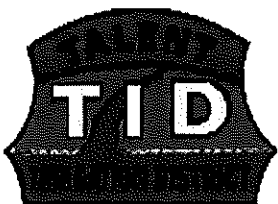

DATE: 1/16/2025

CLAIM OF BENEFICIAL USE MAP

NAME: RICHARD AND KAREN
TITUS FAMILY TRUST
TAXLOT #: 400 1.0 AC

ON LANDS
CERTIFICATE #:
79313 (IR): 0.4 AC
83727 (IS): 0.4 AC
83727 (IR): 0.6 AC

This map is not intended to provide legal dimensions
or locations of property ownership lines

CLAIM OF BENEFICIAL USE Site Report

Transfer Number: **T-10277**

District Internal Notice #: **05-16**

User Name: Gerry and Dyan Osterland

Phone: 541-488-2822

Certificate: 83727 (IR)

Property: 146 Jeffrey Dr. Ashland, OR 97520

Place of Use:

USE	POD #	TWP	RNG	SEC	QQ	DLC	GOV'T LOT	TAX LOT	ACRES
IR	ALL	39 S	2 E	20	SW NW			405	.80
IR	ALL	39 S	2 E	20	NW NW			405	.20
TOTAL ACRES =									1.0

District Conveyance System:

Description of Delivery System: Private turn out in the Corp Ranch Road Water

Improvement District.

Headgate: None

Canal: Ashland Main

Beneficial Use:

Description of Beneficial Use: Lawn and Landscaping

Method Used to Apply Water: Sprinkler irrigated. The water use is metered.

Method Used to Calculate Beneficial Use: Ariel map view verification comparing transfer map to the actual place of use 6/21/2024 HH

User Interviewed: () Yes (X) No

Beneficial Use Made as Authorized: (X) Yes () No

Description of Beneficial Use if Less than Authorized:

None

Inspected By: Sharee O. Burns Date: 10/24/2024
Sharee Burns, Executive Assistant

Instructions: Attach and label the corresponding final proof map.

E-RECEIVED

1/21/2025

OWRD

**JACKSON COUNTY
SEC. 20 T39S R2E**

SCALE - 1" = 400'

RECEIVED

AUG 14 2024

TALENT
IRRIGATION DISTRICT



NW 1/4 OF THE NW 1/4; SW 1/4 OF THE NW 1/4

T-10277

DIN-05-16

EXISTING RIGHTS
CERTIFICATE #:
NWNW
83727 (IR): 0.9 AC

SWNW
83727 (IR): 0.0 AC

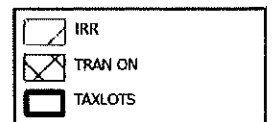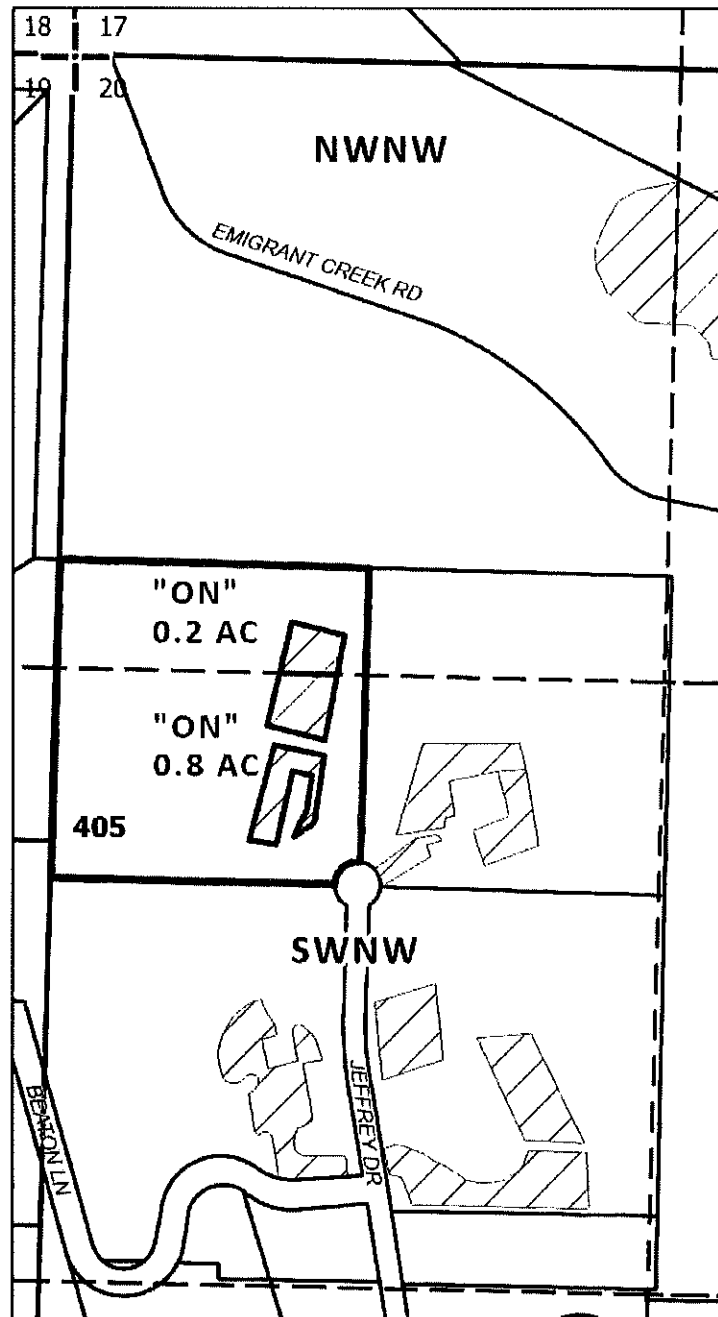

DATE: 08/04/2024

CLAIM OF BENEFICIAL USE MAP

NAME: GERRY & DYAN OSTERLAND
TAXLOT #: 405 1.0AC
NWNW: 0.2 AC
SWNW: 0.8 AC

ON LANDS
CERTIFICATE #:
83727 (IR): 1.0 AC

This map is not intended to provide legal dimensions
or locations of property ownership lines

CLAIM OF BENEFICIAL USE Site Report

Transfer Number: **T-10277**

District Internal Notice #: **05-19**

User Name: Charlene, Ben and Marie Davol
(Howard and Charlene Davol)

Phone: 541-488-0124
Certificate: 83727 (IR)

Property: 11500 Corp Ranch Rd. Ashland, OR 97520

Place of Use:

USE	POD #	TWP	RNG	SEC	QQ	DLC	GOV'T LOT	TAX LOT	ACRES
IR	ALL	39 S	2 E	19	NE SE			123	.20
IR	ALL	39 S	2 E	19	SE SE			123	1.80
TOTAL ACRES =									2.0

District Conveyance System:

Description of Delivery System: Private turn out in the Corp Ranch Road Water
Improvement District.

Headgate: None Canal: Ashland Main

Beneficial Use:

Description of Beneficial Use: Lawn and Landscaping

Method Used to Apply Water: Sprinkler irrigated. The water use is metered.

Method Used to Calculate Beneficial Use: Ariel map view verification comparing transfer map
to the actual place of use 6/21/2024 HH

User Interviewed: () Yes (X) No

Beneficial Use Made as Authorized: (X) Yes () No

Description of Beneficial Use if Less than Authorized:

None

Inspected By: Sharee Burns Date: 10/14/2024
Sharee Burns, Executive Assistant

Instructions: Attach and label the corresponding final proof map.

**JACKSON COUNTY
SEC. 19 T39S R2E**

SCALE - 1" = 400'

E-RECEIVED

1/21/2025

OWRD

RECEIVED

AUG 14 2024

TALENT
IRRIGATION DISTRICT




NE 1/4 OF THE SE 1/4; SE 1/4 OF THE SE 1/4

T-10277

DIN-05-19

EXISTING RIGHTS
CERTIFICATE #:
NESE
83727 (IR): 0.0 AC

SESE
83727 (IR): 3.7 AC

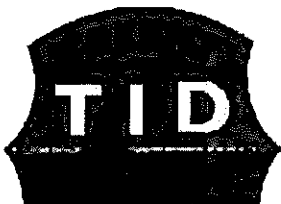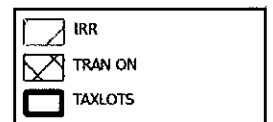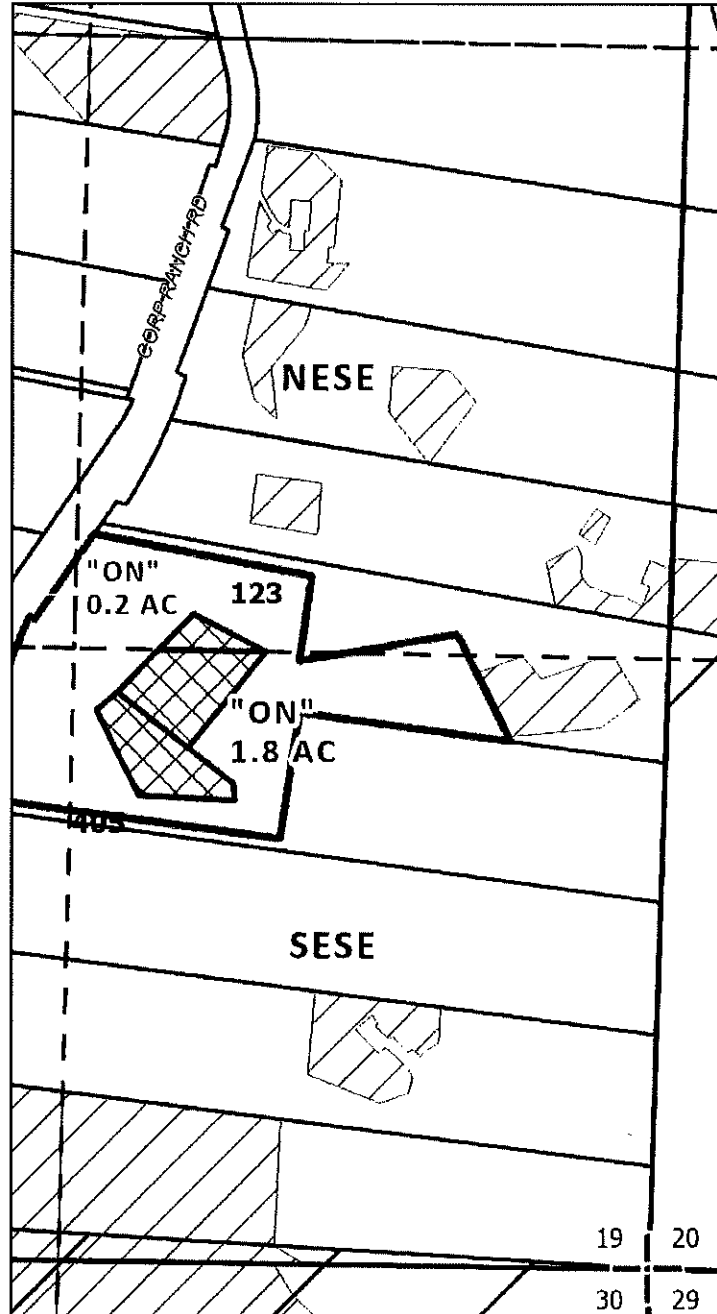

DATE: 08/04/2024

CLAIM OF BENEFICIAL USE MAP

NAME: CHARLENE/BEN/MARIE DAVOL
TAXLOT #: 123 2.0 AC
NESE: 0.2 AC
SESE: 1.8 AC

ON LANDS
CERTIFICATE #:
83727 (IR): 2.0 AC

This map is not intended to provide legal dimensions
or locations of property ownership lines

CLAIM OF BENEFICIAL USE Site Report

Transfer Number: **T-10277**

District Internal Notice #: **05-20**

User Name: Grupe' Family Trust
(Darryl and Laurie Grupe')

Phone: 541-482-0042
Certificate: 83727 (IR)

Property: 5325 Hwy. 66 Ashland, OR 97520

Place of Use:

USE	POD #	TWP	RNG	SEC	QQ	DLC	GOV'T LOT	TAX LOT	ACRES
IR	ALL	39 S	2 E	19	SW SE			2101	1.60
IR	ALL	39 S	2 E	30	NW NE			2101	.40
TOTAL ACRES =									2.0

District Conveyance System:

Description of Delivery System: Private turn out in Corp Ranch Road Water Improvement District.

Headgate: None Canal: Ashland Main

Beneficial Use:

Description of Beneficial Use: Lawn and Landscaping

Method Used to Apply Water: Sprinkler irrigated. The water use is metered.

Method Used to Calculate Beneficial Use: Ariel map view verification comparing transfer map to the actual place of use 6/21/2024 HH

User Interviewed: () Yes (X) No

Beneficial Use Made as Authorized: (X) Yes () No

Description of Beneficial Use if Less than Authorized:

None

Inspected By: Sharee Burns Date: 10/14/2024
Sharee Burns, Executive Assistant

Instructions: Attach and label the corresponding final proof map.

JACKSON COUNTY
SEC. 19, 30 T39S R2E

E-RECEIVED
1/21/2025
OWRD

RECEIVED

AUG 14 2024

TALENT
IRRIGATION DISTRICT

SCALE - 1" = 400'



SW 1/4 OF THE SE 1/4 (SEC 19); NW 1/4 OF THE NE 1/4 (SEC 30)


T-10277

DIN-05-20

SEC 19
SWSE


1/4
COR

SEC 30
NWNE

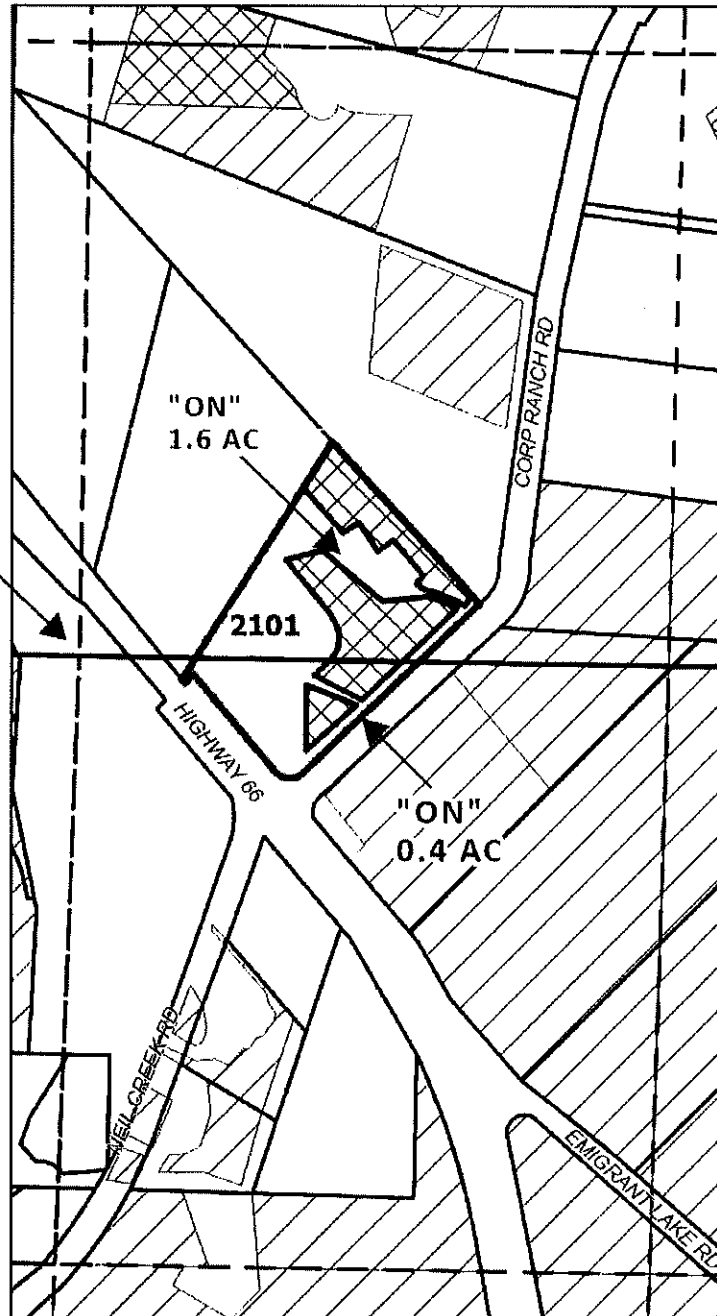

EXISTING RIGHTS
CERTIFICATE #:
SWSE (SEC 19)
83727 (IR): 3.0 AC

NWNE (SEC 30)
83727 (IR): 16.9 AC

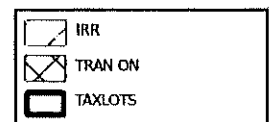

DATE: 08/04/2024

CLAIM OF BENEFICIAL USE MAP

NAME: GRUPE FAMILY TR
TAXLOT #: 2101 2.0 AC
SWSE (SEC 19): 1.6 AC
NWNE (SEC 30): 0.4 AC

ON LANDS
CERTIFICATE #:
83727 (IR): 2.0 AC

This map is not intended to provide legal dimensions
or locations of property ownership lines

CLAIM OF BENEFICIAL USE Site Report

Transfer Number: **T-10277**

District Internal Notice #: **05-23**

User Name: Elaine Henry Living Trust
(Eline Henry)

Phone: 541-840-1613

Certificate: 79212 (IR) Certificate: 83727 (IS) – 1.17
Certificate: 83727 (IR) Certificate: 79212 (IS) – 0.83

Property: 11275 Corp Ranch Rd. Ashland, OR 97520

Place of Use:

USE	POD #	TWP	RNG	SEC	QQ	DLC	GOV'T LOT	TAX LOT	ACRES
IR	ALL	39 S	2 E	19	NW SE			113	.83
IR	ALL	39 S	2 E	19	NW SE			113	1.17

TOTAL ACRES = 2.0

District Conveyance System:

Description of Delivery System: Private turn out in the Corp Ranch Road Water Improvement District.

Headgate: None Canal: Ashland Main

Beneficial Use:

Description of Beneficial Use: Agriculture

Method Used to Apply Water: Sprinkler irrigated. The water use is metered.

Method Used to Calculate Beneficial Use: Ariel map view verification comparing transfer map to the actual place of use 6/21/2024 HH

User Interviewed: () Yes (X) No

Beneficial Use Made as Authorized: (X) Yes () No

Description of Beneficial Use if Less than Authorized:

None

Inspected By: Sharee D. Burns Date: 10/14/2024
Sharee Burns, Executive Assistant


Instructions: Attach and label the corresponding final proof map.

**JACKSON COUNTY
SEC. 19 T39S R2E**

SCALE - 1" = 400'



NW 1/4 OF THE SE 1/4

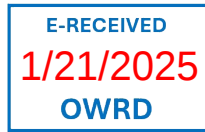

RECEIVED


AUG 14 2024

TALENT
IRRIGATION DISTRICT



T-10277

DIN-05-23

C 1/4
COR

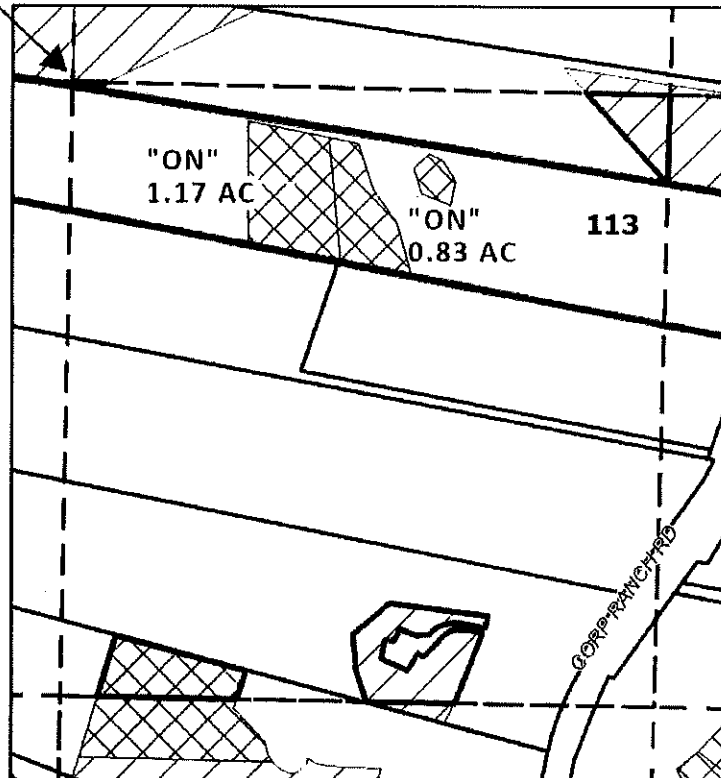

EXISTING RIGHTS
CERTIFICATE #:
79212 (IR): 0 AC
83727 (IS): 0 AC
83727 (IR): 0 AC

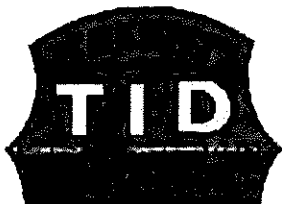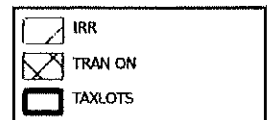

DATE: 08/11/2024

CLAIM OF BENEFICIAL USE MAP

NAME: ELAINE HENRY LIVING TRUST
TAXLOT #: 113 2.0 AC

ON LANDS
CERTIFICATE #:
79212 (IR): 1.17 AC
83727 (IS): 1.17 AC
83727 (IR): 0.83 AC

This map is not intended to provide legal dimensions
or locations of property ownership lines

CLAIM OF BENEFICIAL USE Site Report

Transfer Number: **T-10277**

District Internal Notice #: **05-25**

User Name: HEP Enterprises, LLC
(Scott and Susan Wood)

Phone: 415-250-4574
Certificate: 83727 (IR)

Property: 11340 Corp Ranch Rd. Ashland, OR 97520

Place of Use:

USE	POD #	TWP	RNG	SEC	QQ	DLC	GOV'T LOT	TAX LOT	ACRES
IR	ALL	39 S	2 E	19	NE SE			114	1.0
TOTAL ACRES =									1.0

District Conveyance System:

Description of Delivery System: Private turn out in the Corp Ranch Road Water
Improvement District.

Headgate: None Canal: Ashland Main

Beneficial Use:

Description of Beneficial Use: Lawn and Landscaping

Method Used to Apply Water: Sprinkler irrigated. The water use is metered.

Method Used to Calculate Beneficial Use: Ariel map view verification comparing transfer map
to the actual place of use 6/21/2024 HH

User Interviewed: () Yes (X) No

Beneficial Use Made as Authorized: (X) Yes () No

Description of Beneficial Use if Less than Authorized:

None

Inspected By: Sharee Burns Date: 11/22/2024
Sharee Burns, Executive Assistant

Instructions: Attach and label the corresponding final proof map.

**JACKSON COUNTY
SEC. 19 T39S R2E**

SCALE - 1" = 400'



NE 1/4 OF THE SE 1/4


E-RECEIVED

1/21/2025

OWRD



T-10277

DIN-05-25

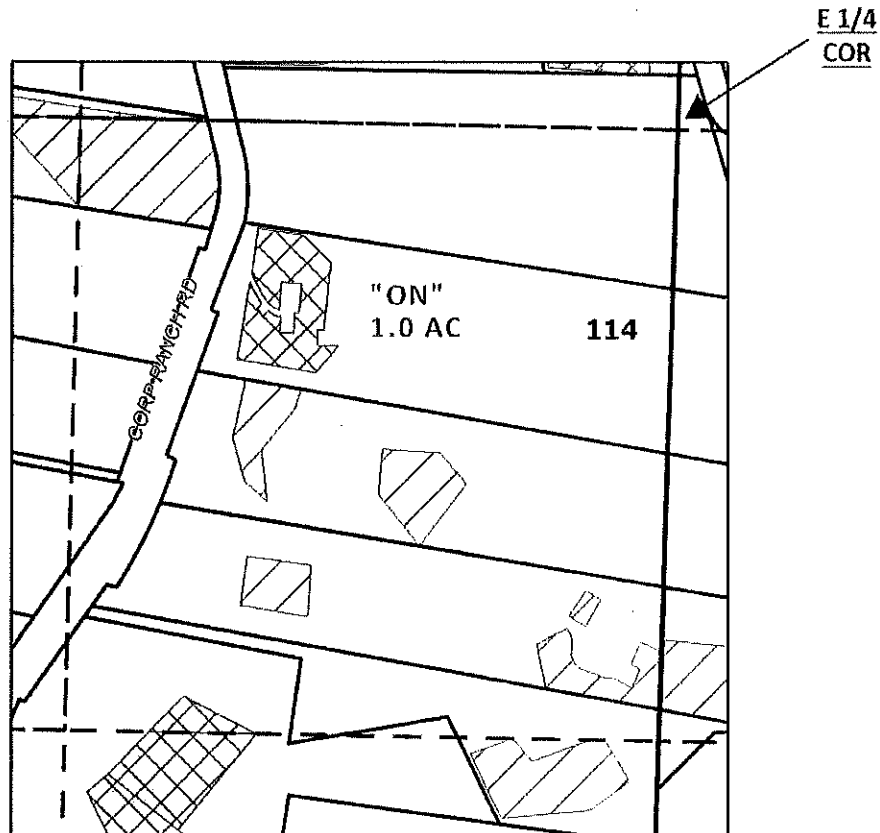

EXISTING RIGHTS
CERTIFICATE #:

83727 (IR): 0 AC

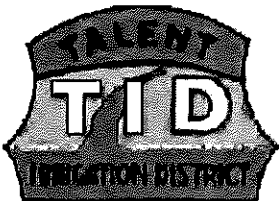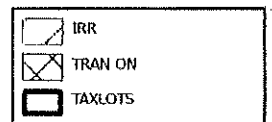

DATE: 11/04/2024

CLAIM OF BENEFICIAL USE MAP

NAME: HEP ENTERPRISES, LLC
TAXLOT #: 114 1.0 AC

ON LANDS
CERTIFICATE #:

83727 (IR): 1.0 AC

This map is not intended to provide legal dimensions
or locations of property ownership lines

CLAIM OF BENEFICIAL USE Site Report

Transfer Number: **T-10277**

District Internal Notice #: **05-26**

User Name: C.F. Stewart, Ltd.

Phone: 541-488-2950

Certificate: 79212 (IR) Certificate: 83727 (IS) – 2.30

Certificate: 83727 (IR) Certificate: 79212 (IS) – 1.10 & .60

Property: 11747 Corp Ranch Rd. Ashland, OR 97520

Place of Use:

USE	POD #	TWP	RNG	SEC	QQ	DLC	GOV'T LOT	TAX LOT	ACRES
IR	ALL	39 S	2 E	19	NW SE			117	.60
IR	ALL	39 S	2 E	19	SW SE			117	1.10
IR	ALL	39 S	2 E	19	SW SE			117	2.30
TOTAL ACRES =									4.0

District Conveyance System:

Description of Delivery System: Private turn out in the Corp Ranch Road Water

Improvement District.

Headgate: None

Canal: Ashland Main

Beneficial Use:

Description of Beneficial Use: Lawn and Landscaping

Method Used to Apply Water: Sprinkler irrigated. The water use is metered.

Method Used to Calculate Beneficial Use: Ariel map view verification comparing transfer map to the actual place of use 6/21/2024 HH

User Interviewed: () Yes (X) No

Beneficial Use Made as Authorized: (X) Yes () No

Description of Beneficial Use if Less than Authorized:

None

Inspected By: Sharee D. Burns Date: 11/22/2024
Sharee Burns, Executive Assistant

Instructions: Attach and label the corresponding final proof map.

**JACKSON COUNTY
SEC. 19 T39S R2E**

E-RECEIVED
1/21/2025
OWRD

SCALE - 1" = 400'




NW 1/4 OF THE SE 1/4; SW 1/4 OF THE SE 1/4


T-10277

DIN-05-26

EXISTING RIGHTS
CERTIFICATE #:
C79212 0.0 AC
C83727 0.0 AC

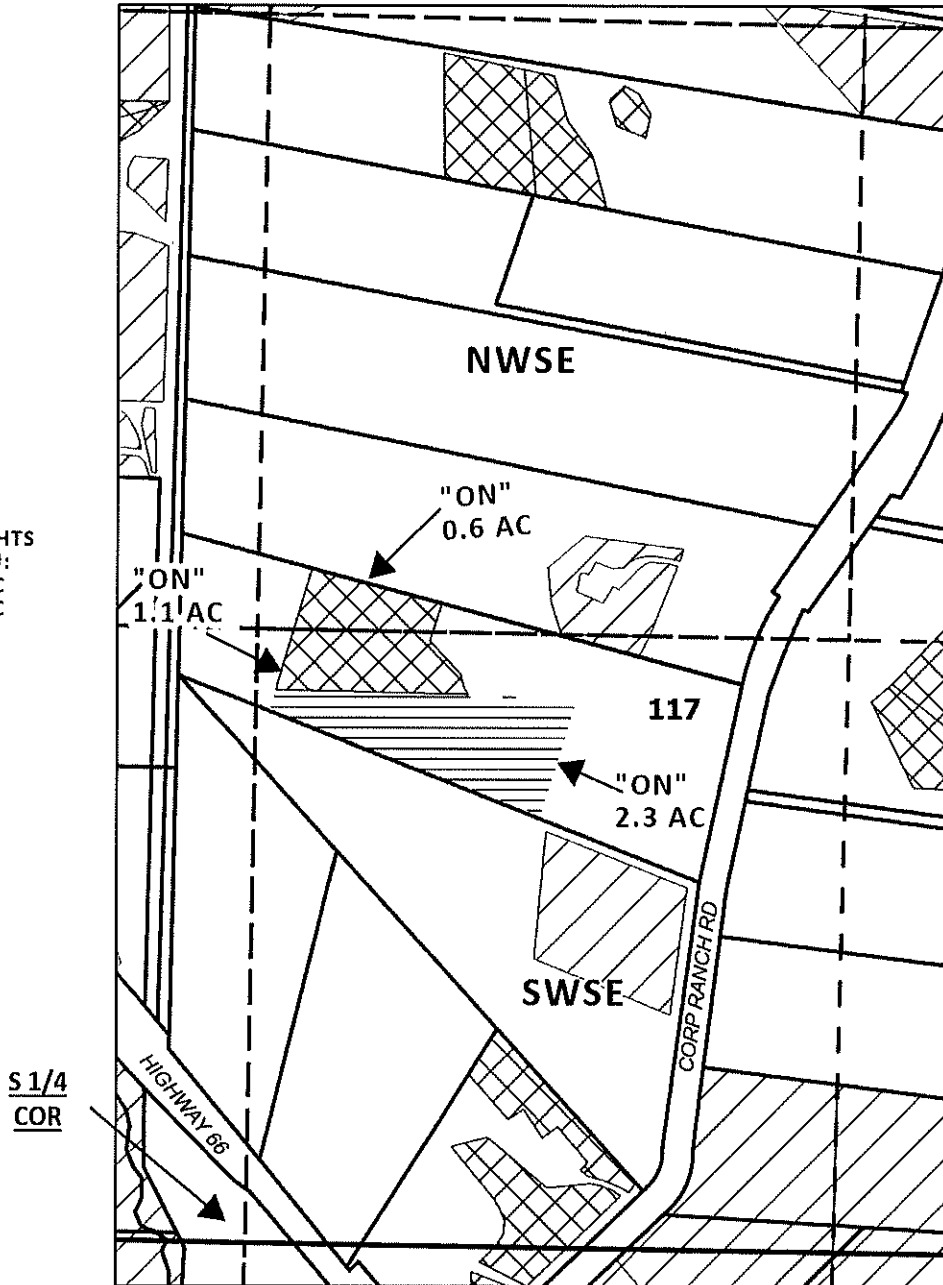

	IRR
	TRAN ON
	TRAN ON_79212
	TAXLOTS

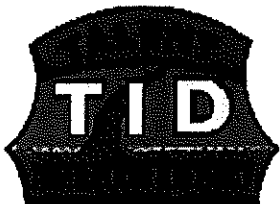

DATE: 12/19/2024

CLAIM OF BENEFICIAL USE MAP

NAME: C.F. STEWART, LTD
TAXLOT #: 117 4.0 AC
NWSE: 0.6 AC (C83727)
SWSE: 1.1 AC (C83727)
SWSE: 2.3 AC (C79212)

ON LANDS
CERTIFICATE #:
79212 (IR): 2.3 AC
83727 (IS): 2.3 AC
83727 (IR): 1.7 AC

This map is not intended to provide legal dimensions
or locations of property ownership lines

CLAIM OF BENEFICIAL USE Site Report

Transfer Number: **T-10277**

District Internal Notice #: **05-27**

User Name: Heaslip Rev. Living Trust
(Mark and Stacy Skillman)

Phone: 714-721-8050
Certificate: 83727 (IR)

Property: 5597 Hwy. 66 Ashland, OR 97520

Place of Use:

USE	POD #	TWP	RNG	SEC	QQ	DLC	GOV'T LOT	TAX LOT	ACRES
IR	ALL	39 S	2 E	30	SW NE			107	1.60
IR	ALL	39 S	2 E	30	SE NE			107	1.40
TOTAL ACRES =									3.0

District Conveyance System:

Description of Delivery System: Private turn out in the Corp Ranch Road Water Improvement District.

Headgate: None Canal: Ashland Main

Beneficial Use:

Description of Beneficial Use: Lawn and Landscaping

Method Used to Apply Water: Sprinkler irrigated. The water use is metered.

Method Used to Calculate Beneficial Use: Ariel map view verification comparing transfer map to the actual place of use 6/21/2024 HH

User Interviewed: () Yes (X) No

Beneficial Use Made as Authorized: (X) Yes () No

Description of Beneficial Use if Less than Authorized:

None

Inspected By: Sharee D. Burns Date: 10/14/2024
Sharee Burns, Executive Assistant

Instructions: Attach and label the corresponding final proof map.

**JACKSON COUNTY
SEC. 30 T39S R2E**

SCALE - 1" = 400'



SW 1/4 OF THE NE 1/4; SE 1/4 OF THE NE 1/4

E-RECEIVED
1/21/2025
OWRD


RECEIVED

AUG 14 2024

TALENT
IRRIGATION DISTRICT


T-10277

DIN-05-27

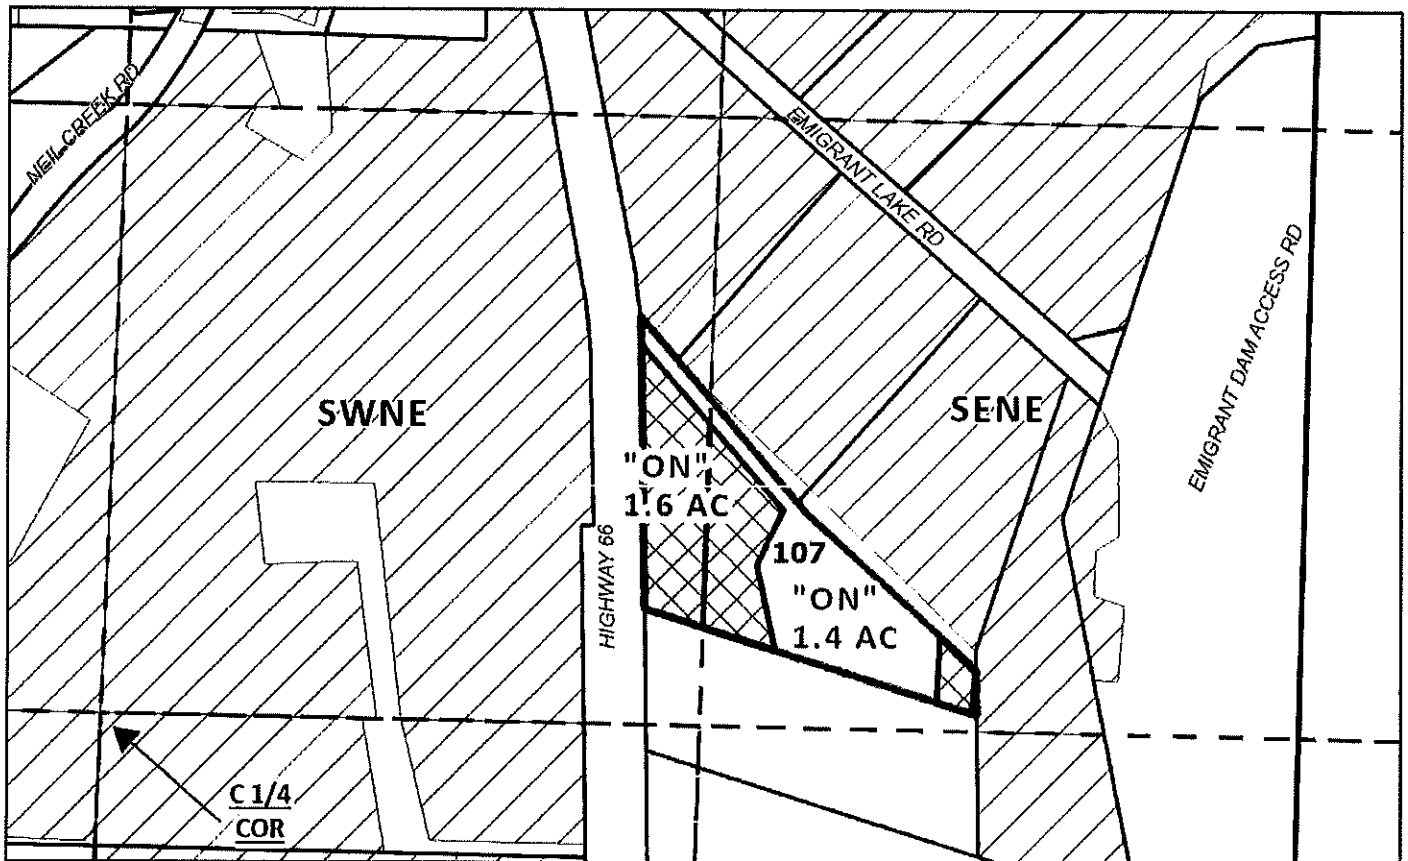

EXISTING RIGHTS
CERTIFICATE #:
SWNE
83727 (IR): 31.2 AC

SENE
83727 (IR): 20.2 AC

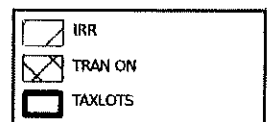

DATE: 07/22/2024

CLAIM OF BENEFICIAL USE MAP

NAME: HEASLIP REV LIV TR (SKILLMAN)
TAXLOT #: 107 3.0 AC
SWNE: 1.6 AC
SENE: 1.4 AC

ON LANDS
CERTIFICATE #:
83727 (IR): 3.0 AC

This map is not intended to provide legal dimensions
or locations of property ownership lines

CLAIM OF BENEFICIAL USE Site Report

Transfer Number: T-10277

District Internal Notice #: 05-35

User Name: John and Helen Gritsch

Phone: 541-535-6844

Certificate: 79212 (IR)

Certificate: 83727 (IS)

Property: 3100 Camp Baker Rd. Medford, OR 97501

Place of Use:

USE	POD #	TWP	RNG	SEC	QQ	DLC	GOV'T LOT	TAX LOT	ACRES
IR	ALL	38 S	1 W	17	SW NW			4403	1.25
TOTAL ACRES =									1.25

District Conveyance System:

Description of Delivery System: Private pump station

Headgate: None

Canal: Talent Main

Beneficial Use:

Description of Beneficial Use: Lawn and Landscaping

Method Used to Apply Water: Sprinkler irrigated. The water use is metered.

Method Used to Calculate Beneficial Use: Ariel map view verification comparing transfer map to the actual place of use 6/21/2024 HH

User Interviewed: () Yes (X) No

Beneficial Use Made as Authorized: (X) Yes () No

Description of Beneficial Use if Less than Authorized:

None

Inspected By: Sharee D. Burns

Sharee Burns, Executive Assistant

Date: 10/14/2024

Instructions: Attach and label the corresponding final proof map.

**JACKSON COUNTY
SEC. 17 T38S R1W**

SCALE - 1" = 400'



SW 1/4 OF THE NW 1/4

E-RECEIVED
1/21/2025
OWRD


RECEIVED

AUG 14 2024



TALENT
IRRIGATION DISTRICT

T-10277

DIN-05-35

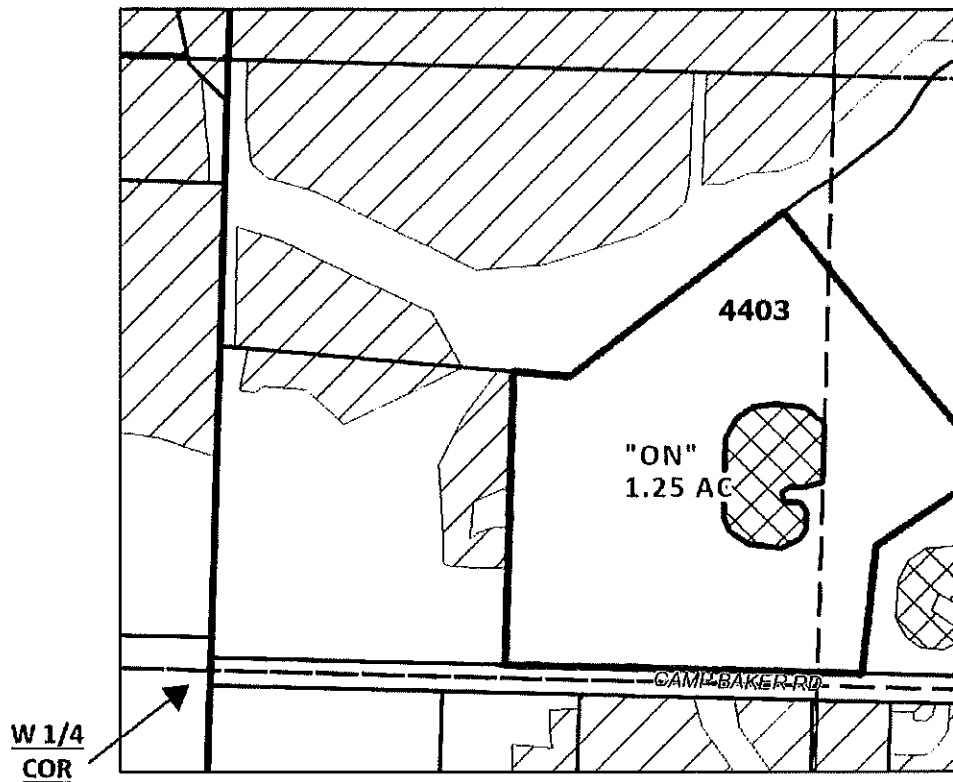

EXISTING RIGHTS
CERTIFICATE #:
79212 (IR): 11.0 AC
83727 (IS): 11.0 AC
83727 (IR): 2.0 AC

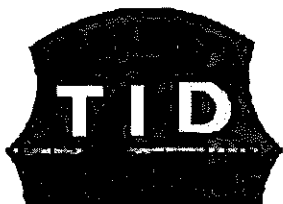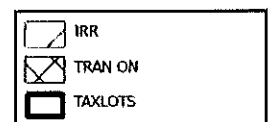

DATE: 07/28/2024

CLAIM OF BENEFICIAL USE MAP

NAME: JOHN AND HELEN GRITSCH
TAXLOT #: 4403 1.25 AC

ON LANDS
CERTIFICATE #:
79212 (IR): 1.25 AC
83727 (IS): 1.25 AC

This map is not intended to provide legal dimensions
or locations of property ownership lines

CLAIM OF BENEFICIAL USE Site Report

Transfer Number: T-10277

District Internal Notice #: 05-35

User Name: Gritsch Company, LLC

Phone: 541-941-4424

Certificate: 79212 (IR)

Certificate: 83727 (IS)

Property: 3028 Camp Baker Rd. Medford, OR 97501

Place of Use:

USE	POD #	TWP	RNG	SEC	QQ	DLC	GOV'T LOT	TAX LOT	ACRES
IR	ALL	38 S	1 W	17	SE NW			4404	.75
TOTAL ACRES =									.75

District Conveyance System:

Description of Delivery System: Private pump station

Headgate: None

Canal: West Main

Beneficial Use:

Description of Beneficial Use: Lawn and Landscaping

Method Used to Apply Water: Sprinkler irrigated. The water use is metered.

Method Used to Calculate Beneficial Use: Ariel map view verification comparing transfer map to the actual place of use 6/21/2024 HH

User Interviewed: () Yes (X) No

Beneficial Use Made as Authorized: (X) Yes () No

Description of Beneficial Use if Less than Authorized:

None

Inspected By: Sharee Q. Burns Date: 10/14/2024
Sharee Burns, Executive Assistant

Instructions: Attach and label the corresponding final proof map.

**JACKSON COUNTY
SEC. 17 T38S R1W**

SCALE - 1" = 400'



SE 1/4 OF THE NW 1/4

E-RECEIVED
1/21/2025
OWRD


RECEIVED

AUG 14 2024



TALENT
IRRIGATION DISTRICT

T-10277

DIN-05-35

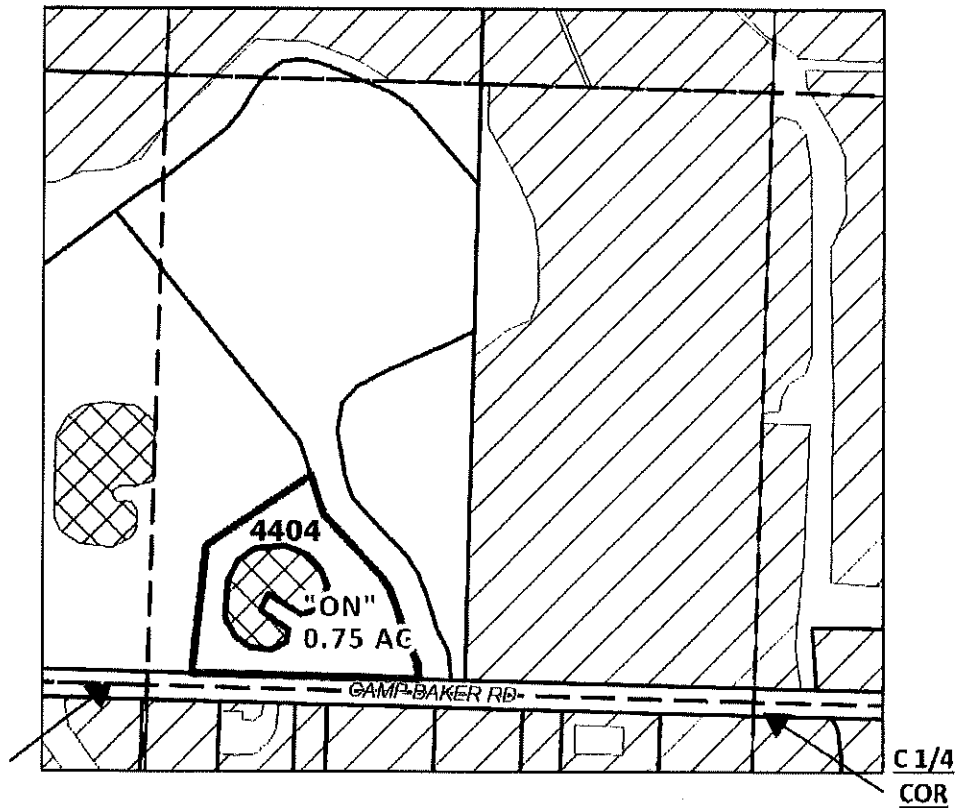

EXISTING RIGHTS
CERTIFICATE #:
79212 (IR): 17.7 AC
83727 (IS): 17.7 AC

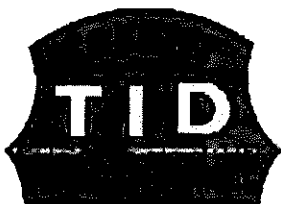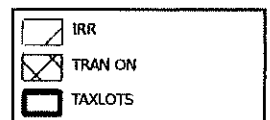

DATE: 07/28/2024

CLAIM OF BENEFICIAL USE MAP

NAME: GRITSCH COMPANY LLC
TAXLOT #: 4404 0.75 AC

ON LANDS
CERTIFICATE #:
79212 (IR): 0.75 AC
83727 (IS): 0.75 AC

This map is not intended to provide legal dimensions
or locations of property ownership lines

CLAIM OF BENEFICIAL USE Site Report

Transfer Number: T-10277

District Internal Notice #: 05-36

User Name: Lynda Marikos Trust

Phone: 541-482-9791

Certificate: 83727 (IR)

Property: 1192 Wilson Rd. Ashland, OR 97520

Place of Use:

USE	POD #	TWP	RNG	SEC	QQ	DLC	GOV'T LOT	TAX LOT	ACRES
IR	ALL	38 S	1 E	20	SW SE			901	2.0
TOTAL ACRES =									2.0

District Conveyance System:

Description of Delivery System: Private turn out and pump station

Headgate: None

Canal: East Main

Beneficial Use:

Description of Beneficial Use: Lawn and Landscaping

Method Used to Apply Water: Sprinkler irrigated. The water use is metered.

Method Used to Calculate Beneficial Use: Ariel map view verification comparing transfer map to the actual place of use 6/21/2024 HH

User Interviewed: () Yes (X) No

Beneficial Use Made as Authorized: (X) Yes () No

Description of Beneficial Use if Less than Authorized:

None

Inspected By: Sharee I. Burns Date: 11/22/2024
Sharee Burns, Executive Assistant

Instructions: Attach and label the corresponding final proof map.

**JACKSON COUNTY
SEC. 20 T38S R1E**

E-RECEIVED

1/21/2025

OWRD


SCALE - 1" = 400'





T-10277

SW 1/4 OF THE SE 1/4

DIN-05-36

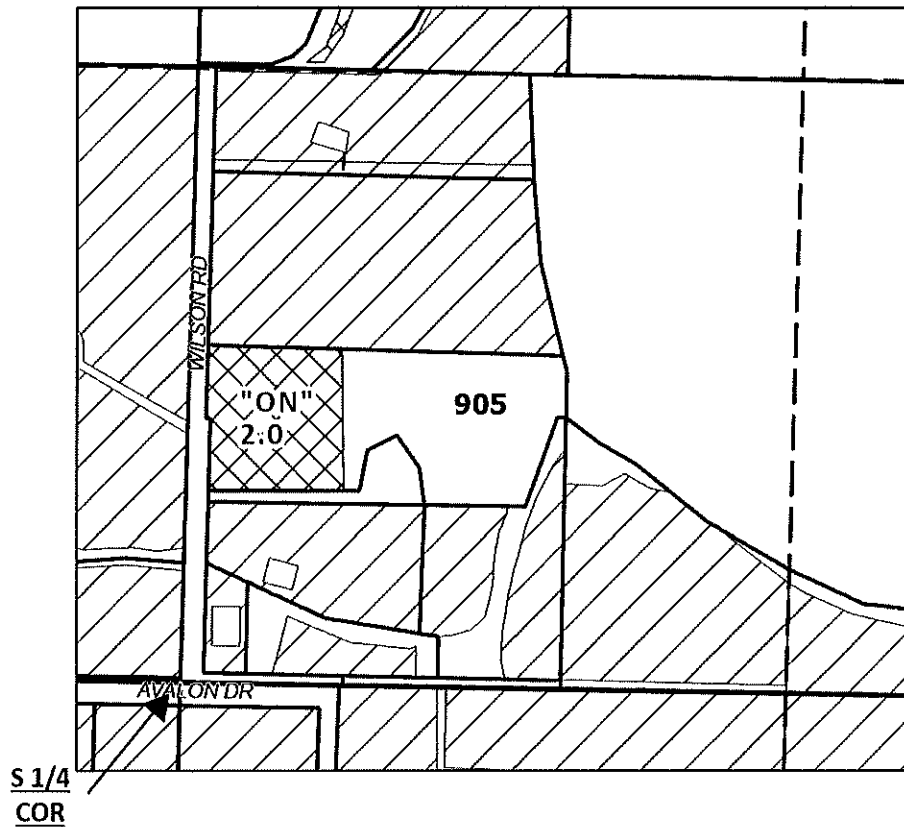

EXISTING RIGHTS
CERTIFICATE #:
79212 (IR): 16.1 AC
83727 (IS): 16.1 AC
83727 (IR): 7.85 AC

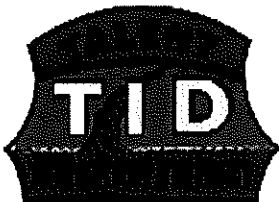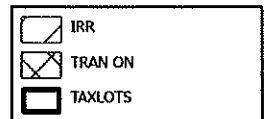

DATE: 12/20/2024

CLAIM OF BENEFICIAL USE MAP

NAME: LYNDA MARIKOS TRUST
TAXLOT #: 905 2.0 AC

ON LANDS
CERTIFICATE #:
83727 (IR): 2.0 AC

This map is not intended to provide legal dimensions
or locations of property ownership lines

CLAIM OF BENEFICIAL USE Site Report

Transfer Number: T-10277

District Internal Notice #: 05-39

User Name: Robinson Family Trust
(Jason and Christine Robinson)

Phone: 541-625-8069
Certificate: 79212 (IR)
Certificate: 83727 (IS)

Property: 2370 Houston Rd. Phoenix, OR 97535

Place of Use:

USE	POD #	TWP	RNG	SEC	QQ	DLC	GOV'T LOT	TAX LOT	ACRES
IR	ALL	38 S	1 W	09C	SW SW			700	2.0
TOTAL ACRES =									2.0

District Conveyance System:

Description of Delivery System: Private turn out and pump station on the T-16 Lateral

Headgate: None Canal: Talent Main

Beneficial Use:

Description of Beneficial Use: Lawn and Landscaping

Method Used to Apply Water: Sprinkler irrigated. The water use is metered.

Method Used to Calculate Beneficial Use: Ariel map view verification comparing transfer map to the actual place of use 6/21/2024 HH

User Interviewed: () Yes (X) No

Beneficial Use Made as Authorized: (X) Yes () No

Description of Beneficial Use if Less than Authorized:

None

Inspected By: Sharee Burns

Sharee Burns, Executive Assistant

Date: 10/14/2024

Instructions: Attach and label the corresponding final proof map.

**JACKSON COUNTY
SEC. 09 T38S R1W**

SCALE - 1" = 400'



SW 1/4 OF THE SW 1/4

E-RECEIVED
1/21/2025
OWRD


RECEIVED

AUG 14 2024


TALENT
IRRIGATION DISTRICT

T-10277

DIN-05-39

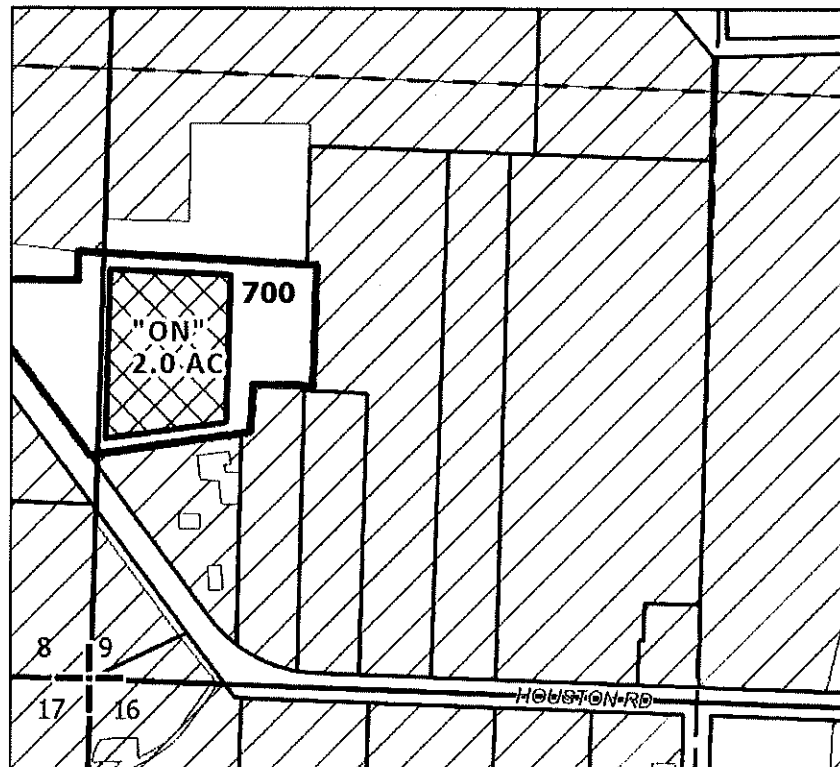

EXISTING RIGHTS
CERTIFICATE #:
79212 (IR): 32.2 AC
83727 (IS): 32.2 AC

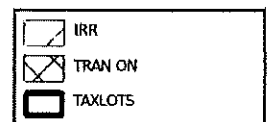

08/12/2024

CLAIM OF BENEFICIAL USE MAP

NAME: JASON & CHRISTINE ROBINSON
TAXLOT #: 700 2.0 AC

ON LANDS
CERTIFICATE #:
79212 (IR): 2.0 AC
83727 (IS): 2.0 AC

This map is not intended to provide legal dimensions
or locations of property ownership lines

CLAIM OF BENEFICIAL USE Site Report

Transfer Number: **T-10277**

District Internal Notice #: **05-42**

User Name: Deason Family Trust
(John and Virginia Deason)

Phone: 541-773-3511
Certificate: 83727 (IR)

Property: 4442 Griffin Creek Rd. Medford, OR 97501

Place of Use:

USE	POD #	TWP	RNG	SEC	QQ	DLC	GOV'T LOT	TAX LOT	ACRES
IR	ALL	38 S	2 W	15	NE NE			205	.90
IR	ALL	38 S	2 W	15	SE NE			205	.10
TOTAL ACRES =									1.0

District Conveyance System:

Description of Delivery System: Private turn out and pipeline

Headgate: None Canal: West Main

Beneficial Use:

Description of Beneficial Use: Lawn and Landscaping

Method Used to Apply Water: Sprinkler irrigated. The water use is metered.

Method Used to Calculate Beneficial Use: Ariel map view verification comparing transfer map to the actual place of use 6/21/2024 HH

User Interviewed: () Yes (X) No

Beneficial Use Made as Authorized: (X) Yes () No

Description of Beneficial Use if Less than Authorized:

None

Inspected By: Sharee D. Burns Date: 10/14/2024
Sharee Burns, Executive Assistant

Instructions: Attach and label the corresponding final proof map.

**JACKSON COUNTY
SEC. 15 T38S R2W**

E-RECEIVED
1/21/2025
OWRD

RECEIVED

AUG 14 2024

TALENT
IRRIGATION DISTRICT



SCALE - 1" = 400'



NE 1/4 OF THE NE 1/4; SE 1/4 OF THE NE 1/4

T-10277

DIN-05-42

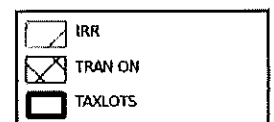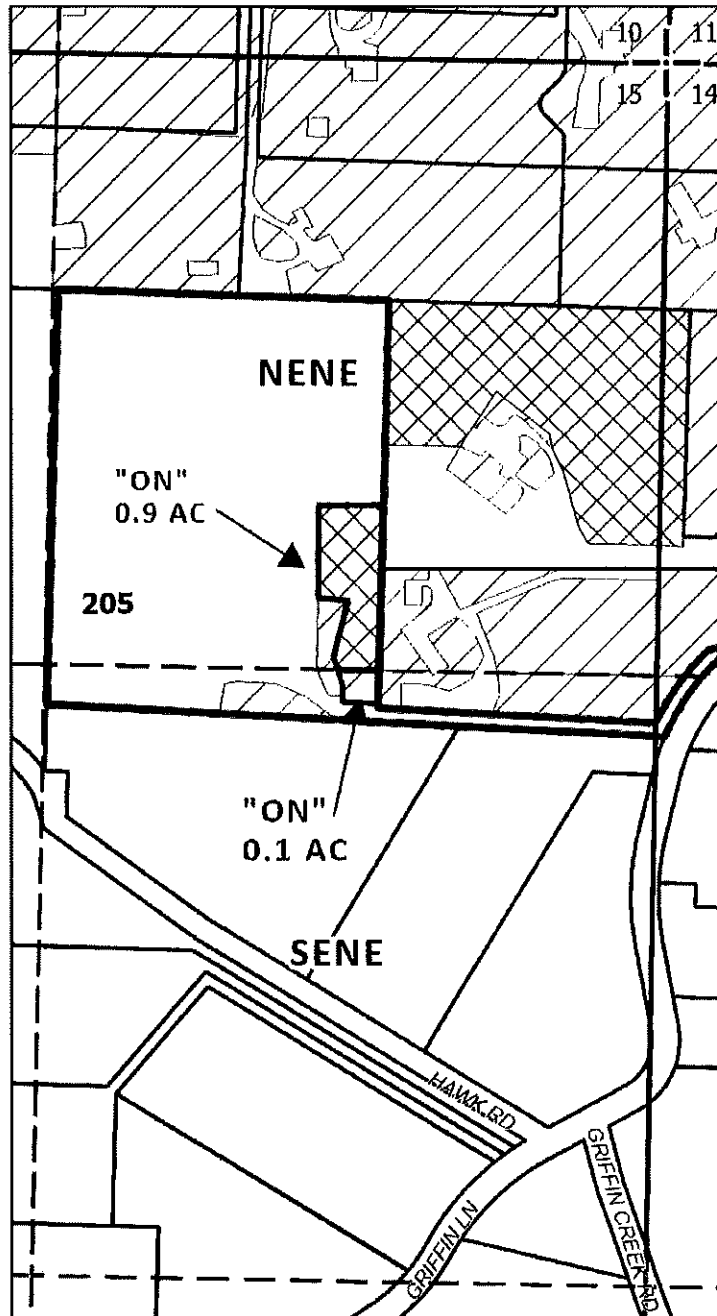

08/12/2024

CLAIM OF BENEFICIAL USE MAP

NAME: DEASON FAMILY TR
TAXLOT #: 205 1.0 AC
NENE: 0.9 AC
SENE: 0.1 AC

ON LANDS
CERTIFICATE #:
83727 (IR): 1.0 AC

This map is not intended to provide legal dimensions
or locations of property ownership lines

CLAIM OF BENEFICIAL USE Site Report

Transfer Number: **T-10277**

District Internal Notice #: **05-43**

User Name: Nancy/Reed Bentley and Bonnie Crimson
(Mack and Amy Ransom)

Phone: 503-975-8838
Certificate: 79212 (IR)
Certificate: 83727 (IS)

Property: 1550 Pinecrest Terrace Ashland, OR 97520

Place of Use:

USE	POD #	TWP	RNG	SEC	QQ	DLC	GOV'T LOT	TAX LOT	ACRES
IR	ALL	39 S	1 E	15CA	NW SE			122	.25
TOTAL ACRES =									.25

District Conveyance System:

Description of Delivery System: Private turn out off of the Harmony pipeline

Headgate: None Canal: Ashland Main

Beneficial Use:

Description of Beneficial Use: Lawn and Landscaping

Method Used to Apply Water: Sprinkler irrigated. The water use is metered.

Method Used to Calculate Beneficial Use: Ariel map view verification comparing transfer map to the actual place of use 6/21/2024 HH

User Interviewed: () Yes (X) No

Beneficial Use Made as Authorized: (X) Yes () No

Description of Beneficial Use if Less than Authorized:

None

Inspected By: Sharee D. Burns Date: 10/14/2024
Sharee Burns, Executive Assistant

Instructions: Attach and label the corresponding final proof map.

**JACKSON COUNTY
SEC. 15 T39S R1E**

E-RECEIVED
1/21/2025
OWRD

RECEIVED

AUG 14 2024

TALENT
IRRIGATION DISTRICT


SCALE - 1" = 400'




NW 1/4 OF THE SE 1/4

T-10277

DIN-05-43

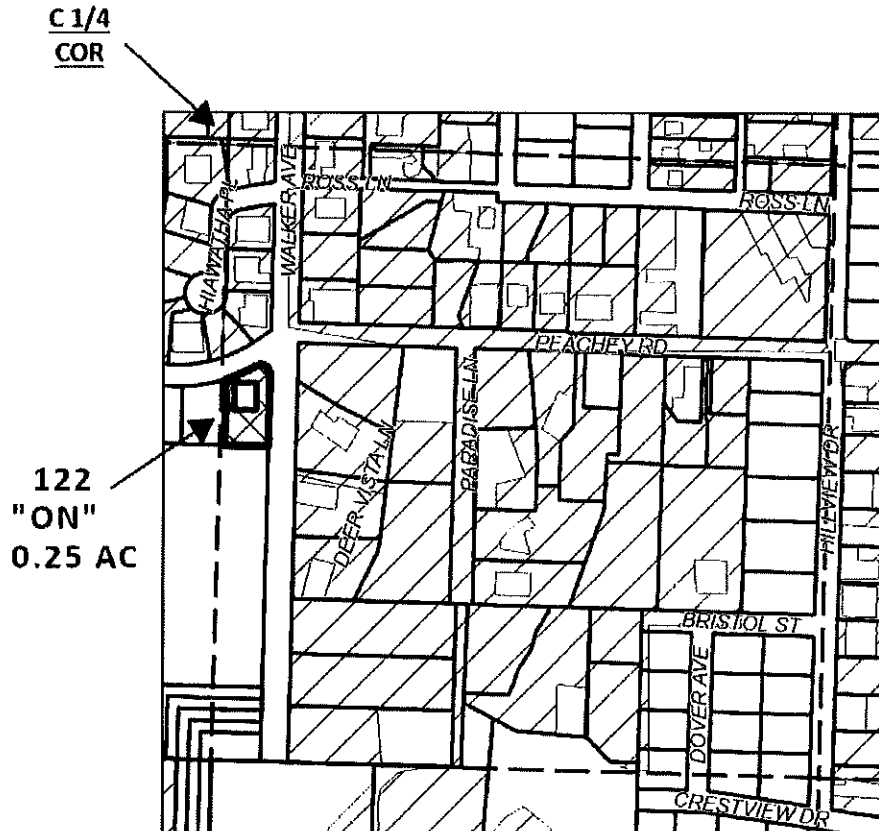

EXISTING RIGHTS
CERTIFICATE #:
79212 (IR): 22.1 AC
83727 (IS): 22.1 AC
83727 (IR): 6.3 AC

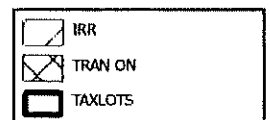

08/12/2024

CLAIM OF BENEFICIAL USE MAP

NAME: NANCY & REED BENTLEY,
BONNIE CRIMSON (RANSOM)
TAXLOT #: 122 0.25 AC

ON LANDS
CERTIFICATE #:
79212 (IR): 0.25 AC
83727 (IS): 0.25 AC

This map is not intended to provide legal dimensions
or locations of property ownership lines

CLAIM OF BENEFICIAL USE Site Report

Transfer Number: T-10277

District Internal Notice #: 05-44

User Name: Roger Rolfsness

Phone: 541-488-1130

Certificate: 83727 (IR)

Property: 5825 Hwy. 66 Ashland, OR 97520

Place of Use:

USE	POD #	TWP	RNG	SEC	QQ	DLC	GOV'T LOT	TAX LOT	ACRES
IR	ALL	39 S	2 E	30	SE SE			110	.20
IR	ALL	39 S	2 E	30	NE SE			110	2.80
TOTAL ACRES =									3.00

District Conveyance System:

Description of Delivery System: Private turn out in the Corp Ranch Road Water

Improvement District.

Headgate: None

Canal: Ashland Main

Beneficial Use:

Description of Beneficial Use: Lawn and Landscaping

Method Used to Apply Water: Sprinkler irrigated. The water use is metered.

Method Used to Calculate Beneficial Use: Ariel map view verification comparing transfer map to the actual place of use 6/21/2024 HH

User Interviewed: () Yes (X) No

Beneficial Use Made as Authorized: (X) Yes () No

Description of Beneficial Use if Less than Authorized:

None

Inspected By: Sharee D Burns Date: 10/14/2024
Sharee Burns, Executive Assistant

Instructions: Attach and label the corresponding final proof map.

**JACKSON COUNTY
SEC. 30 T39S R2E**

SCALE - 1" = 400'



NE 1/4 OF THE SE 1/4; SE 1/4 OF THE SE 1/4


OWRD E-RECEIVED

02/19/2025

AMENDED

T-10277

DIN-05-44

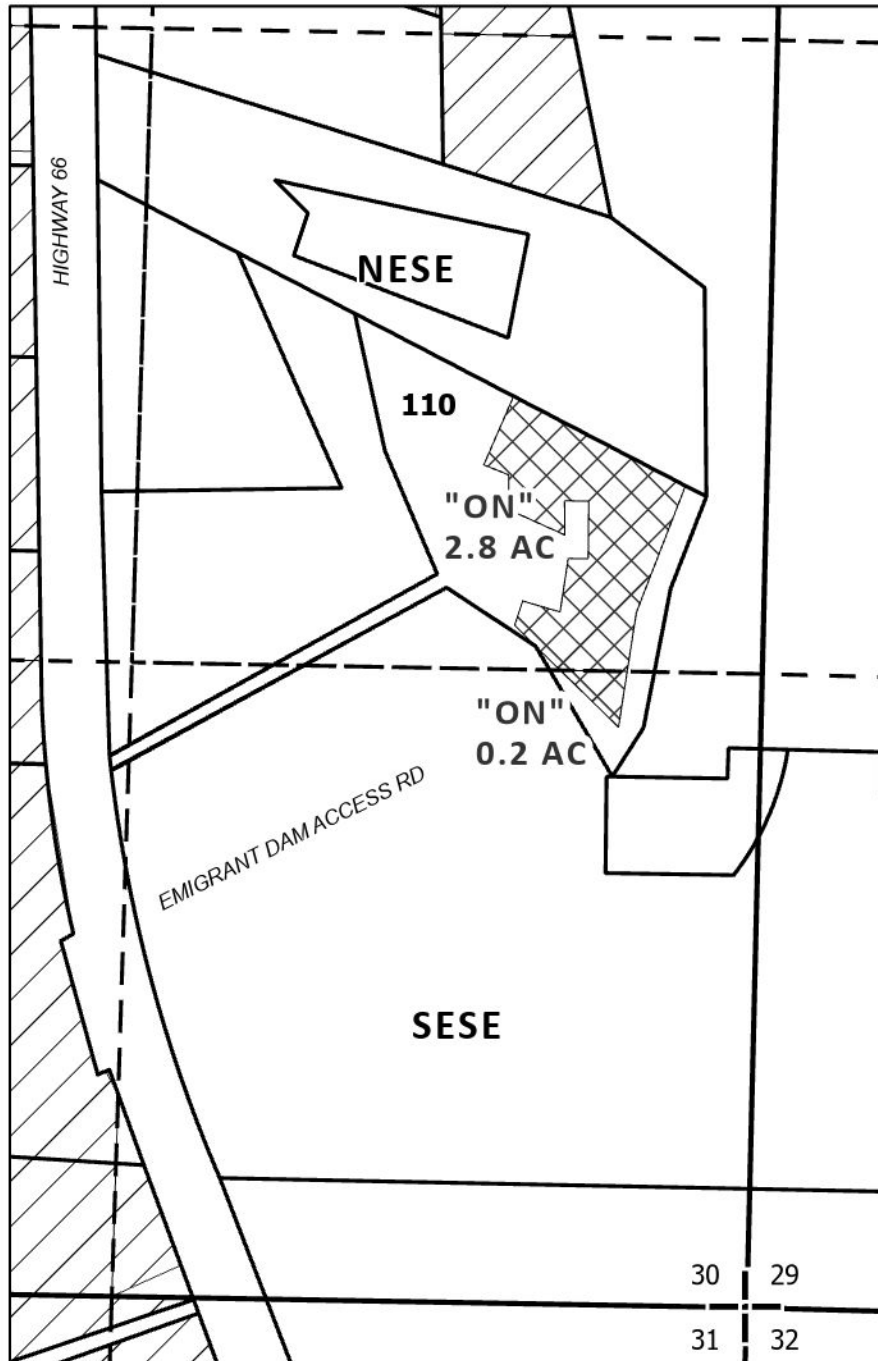

DATE: 02/19/25

CLAIM OF BENEFICIAL USE MAP

NAME: ROGER ROLFSNESSS

TAXLOT #: 110 3.0 AC

NESE: 2.8 AC

SESE: 0.2 AC

ON LANDS
CERTIFICATE #:
83727 (IR): 3.0 AC

This map is not intended to provide legal dimensions
or locations of property ownership lines

CLAIM OF BENEFICIAL USE Site Report

Transfer Number: **T-10277**

District Internal Notice #: **05-45**

User Name: Rasmussen Rev. Living Trust
(Cecil and Patricia Pierson)

Phone: none on file
Certificate: 79212 (IR)
Certificate: 83727 (IS)

Property: 5215 Dark Hollow Rd. Medford, OR 97501

Place of Use:

USE	POD #	TWP	RNG	SEC	QQ	DLC	GOV'T LOT	TAX LOT	ACRES
IR	ALL	38 S	2 W	13	NE SW			2619	1.50
TOTAL ACRES =									1.50

District Conveyance System:

Description of Delivery System: Private turn out and private pipeline

Headgate: None Canal: West Main

Beneficial Use:

Description of Beneficial Use: Lawn and Landscaping

Method Used to Apply Water: Sprinkler irrigated. The water use is metered.

Method Used to Calculate Beneficial Use: Ariel map view verification comparing transfer map to the actual place of use 6/21/2024 HH

User Interviewed: () Yes (X) No

Beneficial Use Made as Authorized: (X) Yes () No

Description of Beneficial Use if Less than Authorized:

None

Inspected By: Sharee Burns Date: 7/5/2024
Sharee Burns, Executive Assistant

Instructions: Attach and label the corresponding final proof map.

**JACKSON COUNTY
SEC. 13 T38S R2W**

SCALE - 1" = 400'



NE 1/4 OF THE SW 1/4


E-RECEIVED

1/21/2025



OWRD

T-10277

DIN-05-45

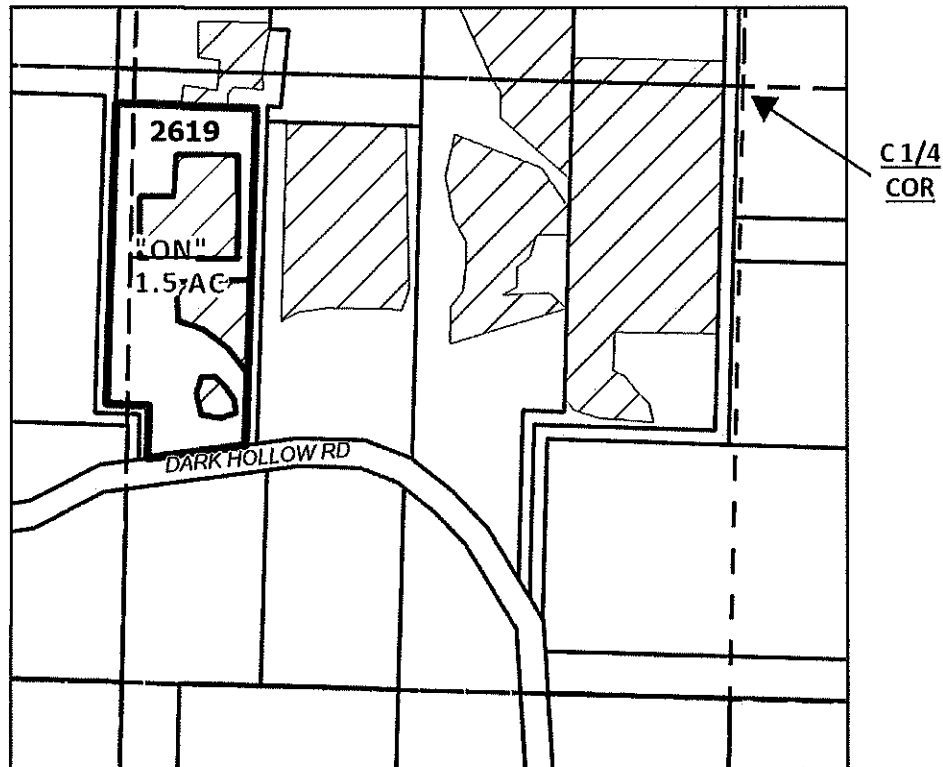

EXISTING RIGHTS
CERTIFICATE #:
79212 (IR): 0 AC
83727 (IR): 2.4 AC

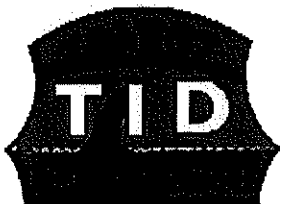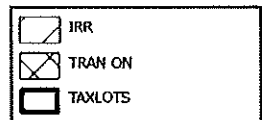

DATE: 08/21/2024

CLAIM OF BENEFICIAL USE MAP

NAME: RASMUSSEN REV. LIV. TR (PIERSON)
TAXLOT #: 2619 1.5 AC

ON LANDS
CERTIFICATE #:
79212 (IR): 1.5 AC
83727 (IS): 1.5 AC

This map is not intended to provide legal dimensions
or locations of property ownership lines

CLAIM OF BENEFICIAL USE Site Report

Transfer Number: T-10277

District Internal Notice #: 05-47

User Name: Stephen and Kathleen Foley

Phone: 541-488-7650

Certificate: 79212 (IR)

Certificate: 83727 (IS)

Property: 11180 Corp Ranch Rd. Ashland, OR 97520

Place of Use:

USE	POD #	TWP	RNG	SEC	QQ	DLC	GOV'T LOT	TAX LOT	ACRES
IR	ALL	39 S	2 E	19	SE NE			125	2.0
TOTAL ACRES =									2.0

District Conveyance System:

Description of Delivery System: Private turn out in the Corp Ranch Road Water

Improvement District.

Headgate: None

Canal: Ashland Main

Beneficial Use:

Description of Beneficial Use: Lawn and Landscaping

Method Used to Apply Water: Sprinkler irrigated. The water use is metered.

Method Used to Calculate Beneficial Use: Ariel map view verification comparing transfer map to the actual place of use 6/21/2024 HH

User Interviewed: () Yes (X) No

Beneficial Use Made as Authorized: (X) Yes () No

Description of Beneficial Use if Less than Authorized:

None

Inspected By: Sharee D. Burns Date: 7/5/2024
Sharee Burns, Executive Assistant

Instructions: Attach and label the corresponding final proof map.

**JACKSON COUNTY
SEC. 19 T39S R2E**

E-RECEIVED
1/21/2025
OWRD


SCALE - 1" = 400'



SE 1/4 OF THE NE 1/4

T-10277


DIN-05-47

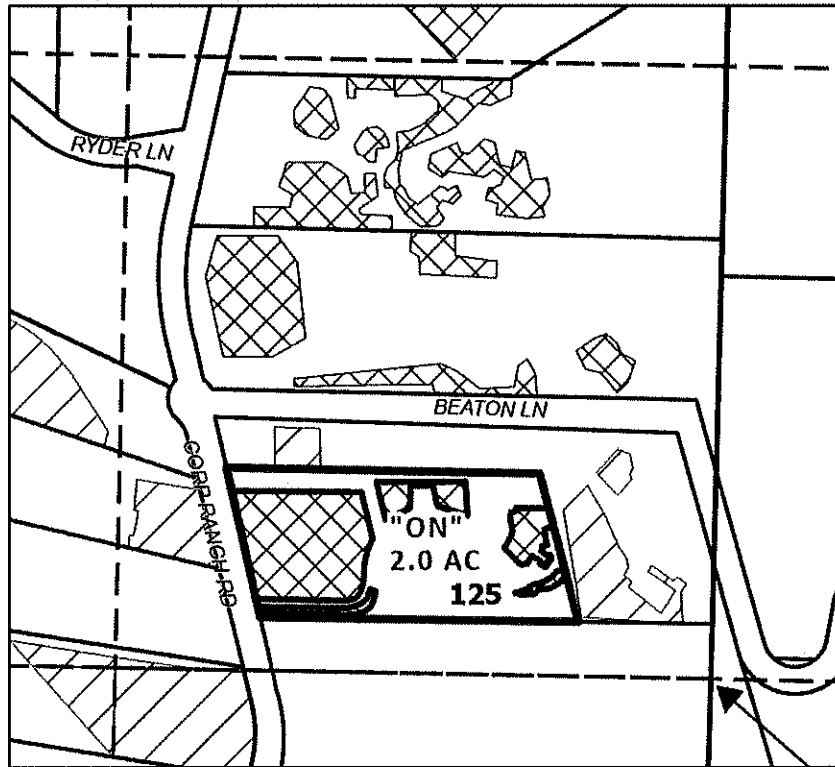

E 1/4
COR

EXISTING RIGHTS
CERTIFICATE #:
79212 (IR): 0 AC
83727 (IS): 0 AC

	IRR
	TRAN ON
	TAXLOTS

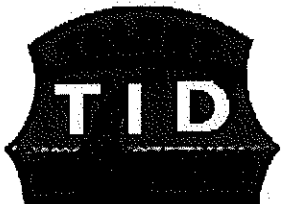

DATE: 08/21/2024

CLAIM OF BENEFICIAL USE MAP

NAME: STEPHEN AND KATHLEEN FOLEY
TAXLOT #: 125 2.0 AC

ON LANDS
CERTIFICATE #:
79212 (IR): 2.0 AC
83727 (IS): 2.0 AC

This map is not intended to provide legal dimensions
or locations of property ownership lines

CLAIM OF BENEFICIAL USE Site Report

Transfer Number: **T-10277**

District Internal Notice #: **06-1**

User Name: Mary Elizabeth Taylor
(Carolyn Kyzer)

Phone: 541-841-6673
Certificate: 79212 (IR)
Certificate: 83727 (IS)

Property: 4185 Charlotte Ln. Medford, OR 97501

Place of Use:

USE	POD #	TWP	RNG	SEC	QQ	DLC	GOV'T LOT	TAX LOT	ACRES
IR	ALL	38 S	1 W	16C	NW SW			2505	1.0
TOTAL ACRES =									1.0

District Conveyance System:

Description of Delivery System: Private turn out on the T-15 Lateral

Headgate: None Canal: Talent Main

Beneficial Use:

Description of Beneficial Use: Lawn and Landscaping

Method Used to Apply Water: Sprinkler irrigated. The water use is metered.

Method Used to Calculate Beneficial Use: Ariel map view verification comparing transfer map to the actual place of use 6/21/2024 HH

User Interviewed: () Yes (X) No

Beneficial Use Made as Authorized: (X) Yes () No

Description of Beneficial Use if Less than Authorized:

None

Inspected By: Sharee D. Burns Date: 7/5/2024
Sharee Burns, Executive Assistant

Instructions: Attach and label the corresponding final proof map.

**JACKSON COUNTY
SEC. 16 T38S R1W**

SCALE - 1" = 400'



NW 1/4 OF THE SW 1/4


E-RECEIVED

1/21/2025

OWRD


T-10277

DIN-06-1

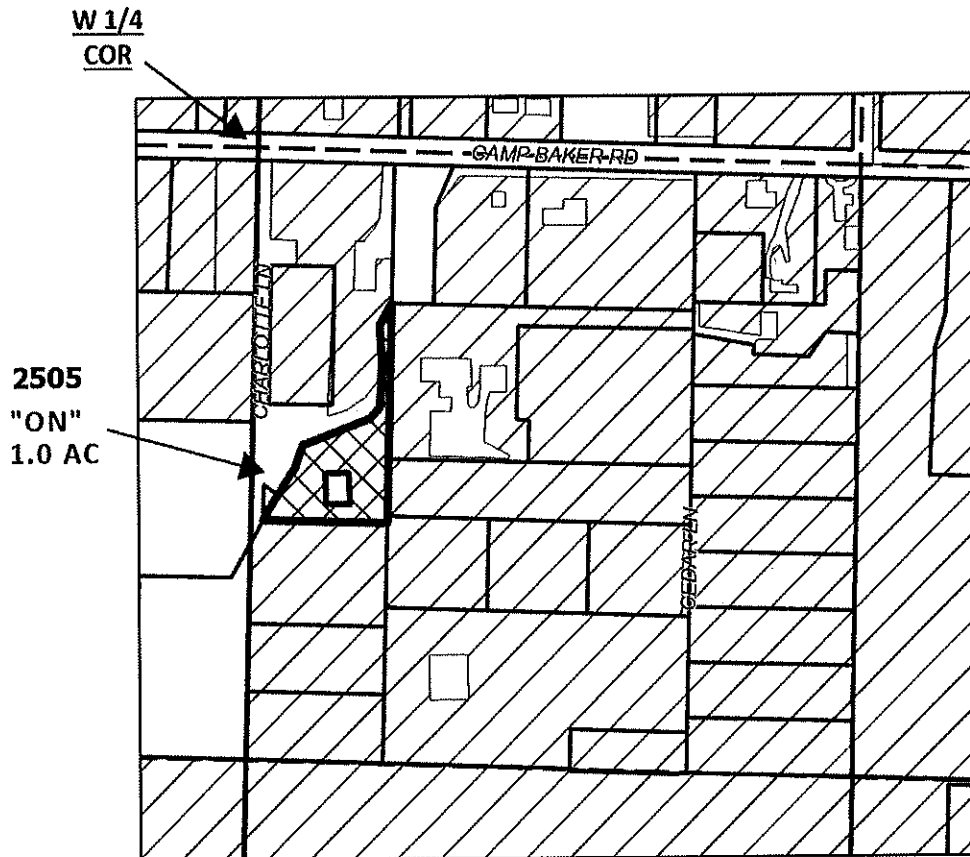

EXISTING RIGHTS
CERTIFICATE #:
79212 (IR): 35.4 AC
83727 (IS): 35.4 AC

	IRR
	TRAN ON
	TAXLOTS

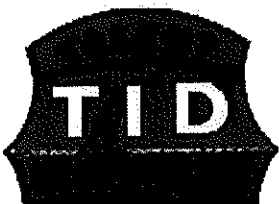

DATE: 08/21/2024

CLAIM OF BENEFICIAL USE MAP

NAME: MARY TAYLOR (KYZER)
TAXLOT #: 2505 1.0 AC

ON LANDS
CERTIFICATE #:
79212 (IR): 1.0 AC
83727 (IS): 1.0 AC

This map is not intended to provide legal dimensions
or locations of property ownership lines

CLAIM OF BENEFICIAL USE Site Report

Transfer Number: **T-10277**

District Internal Notice #: **06-4**

User Name: Gary and Gabriella Yamamura
(Larry and Jill Henderson)

Phone: 760-443-3967
Certificate: 83727 (IR)

Property: 135 Ryder Ln. Ashland, OR 97520

Place of Use:

USE	POD #	TWP	RNG	SEC	QQ	DLC	GOV'T LOT	TAX LOT	ACRES
IR	ALL	39 S	2 E	19	SW NE			135	.90
IR	ALL	39 S	2 E	19	NW NE			135	.10
TOTAL ACRES =									1.0

District Conveyance System:

Description of Delivery System: Private turn out in the Corp Ranch Road Water

Improvement District.

Headgate: None

Canal: Ashland Main

Beneficial Use:

Description of Beneficial Use: Lawn and Landscaping

Method Used to Apply Water: Sprinkler irrigated. The water use is metered.

Method Used to Calculate Beneficial Use: Ariel map view verification comparing transfer map to the actual place of use 6/21/2024 HH

User Interviewed: () Yes (X) No

Beneficial Use Made as Authorized: (X) Yes () No

Description of Beneficial Use if Less than Authorized:

None

Inspected By: Sharee Burns Date: 1/20/2025
Sharee Burns, Executive Assistant

Instructions: Attach and label the corresponding final proof map.

**JACKSON COUNTY
SEC. 19 T39S R2E**

SCALE - 1" = 400'



NW 1/4 OF THE NE 1/4; SW 1/4 OF THE NE 1/4


E-RECEIVED

1/21/2025

OWRD

T-10277

DIN-06-04


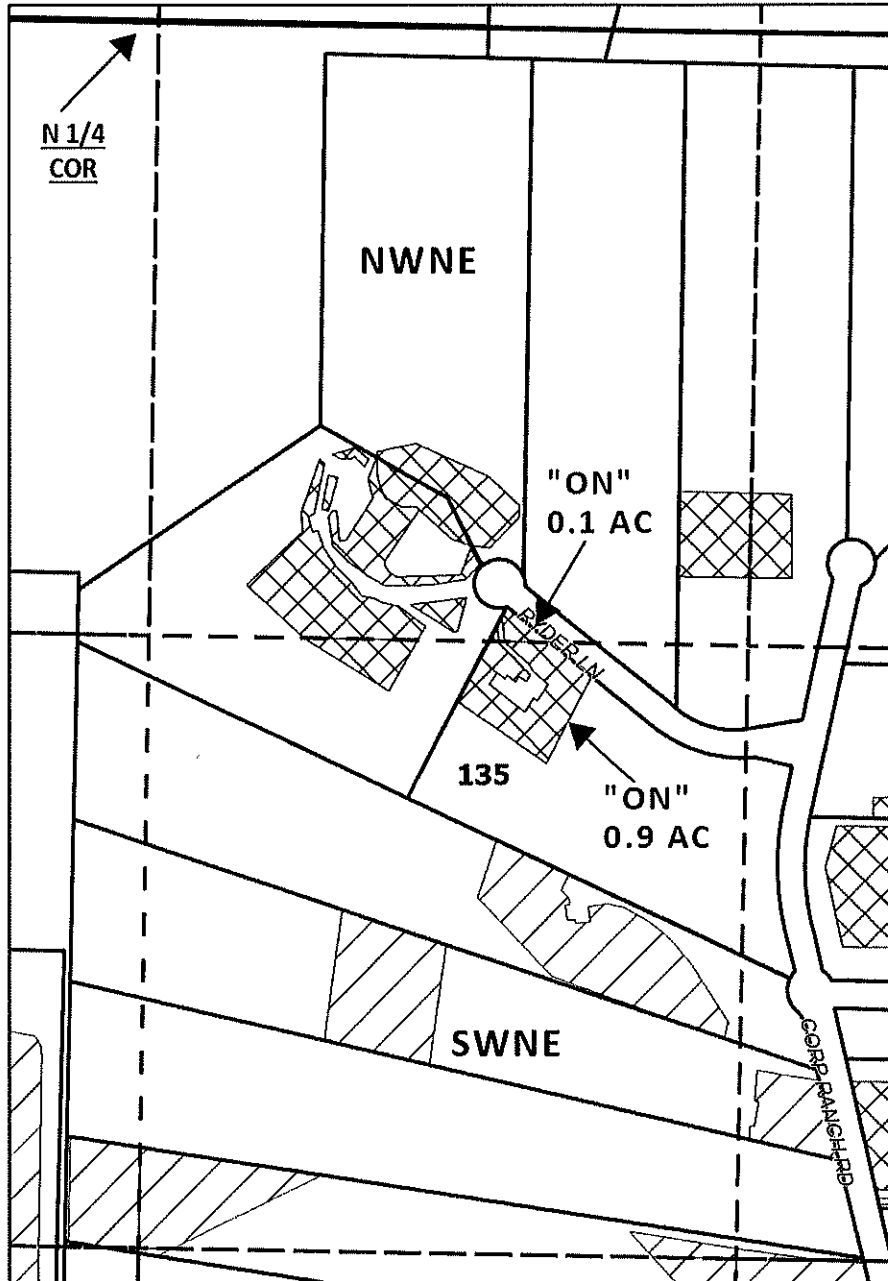


EXISTING
RIGHTS
CERTIFICATE #:
C83727: 0.0 AC

RECEIVED

JAN 20 2025

TALENT
IRRIGATION DISTRICT

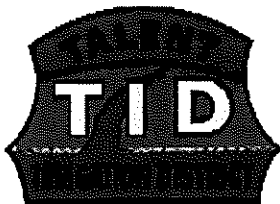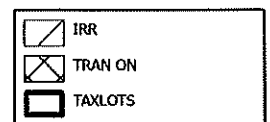

DATE: 1/16/2025

CLAIM OF BENEFICIAL USE MAP

NAME: LARRY AND JILL HENDERSON TRUST

TAXLOT #: 135 1.0 AC

NWNE: 0.1 AC

SWNE: 0.9 AC

ON LANDS
CERTIFICATE #:
83727 (IR): 1.0 AC

This map is not intended to provide legal dimensions
or locations of property ownership lines

SUPERSEDED

**JACKSON COUNTY
SEC. 35 T38S R1E**

E-RECEIVED
1/21/2025
OWRD

SCALE - 1" = 400'




T-10277

NW 1/4 OF THE SW 1/4

DIN-04-51

W 1/4
COR


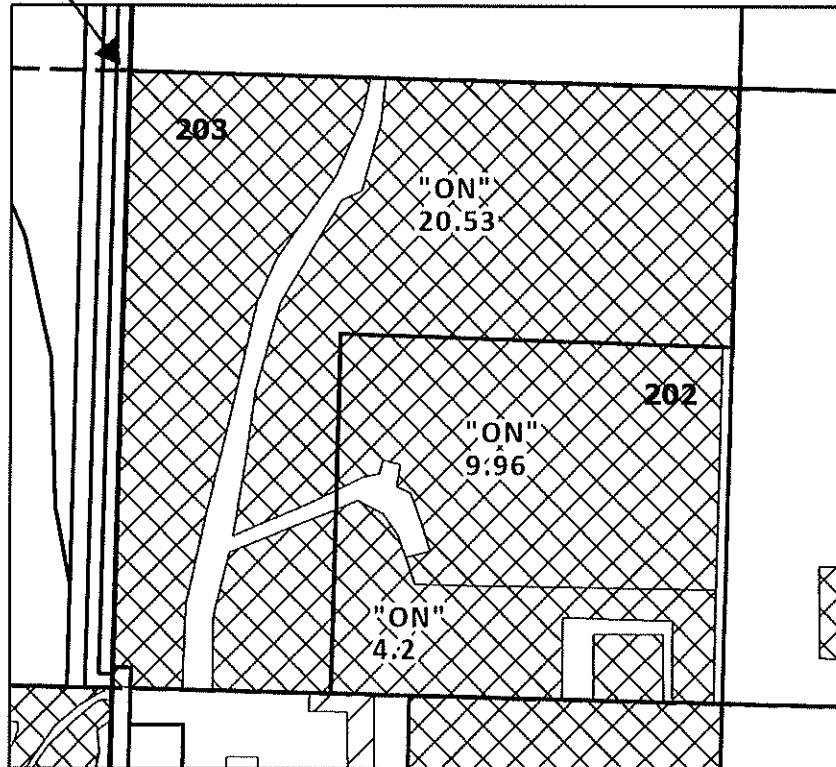


RECEIVED

JAN 20 2025

TALENT
IRRIGATION DISTRICT

EXISTING RIGHTS
CERTIFICATE #:
79212 (IR): 0 AC
83727 (IS): 0 AC
83727 (IR): 0 AC

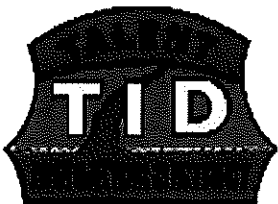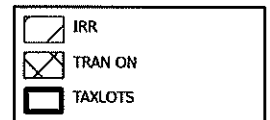

DATE: 1/16/2025

CLAIM OF BENEFICIAL USE MAP

NAME: SILBOWITZ FAMILY TRUST
(ALFRED/VIRGINIA SILBOWITZ)
TAXLOT #: 202 9.96 AC C79212
TAXLOT #: 202 4.2 AC C83727
TAXLOT #: 203 20.53 AC C79212

ON LANDS
CERTIFICATE #:
79212 (IR): 33.36 AC
83727 (IS): 33.36 AC
83727 (IR): 4.2 AC

This map is not intended to provide legal dimensions
or locations of property ownership lines

SUPERSEDED

JACKSON COUNTY
SEC. 34 T38S R1E, SEC. 03 T39S R1E

RECEIVED

SCALE - 1" = 400'

E-RECEIVED

1/21/2025

OWRD



AUG 14 2024

TALENT
IRRIGATION DISTRICT

SE 1/4 OF THE SE 1/4 (SEC 34); NE 1/4 OF THE NE 1/4 (SEC 03)

T-10277

DIN-05-03

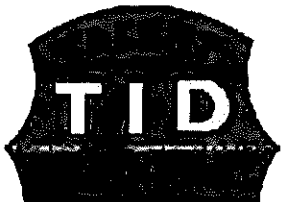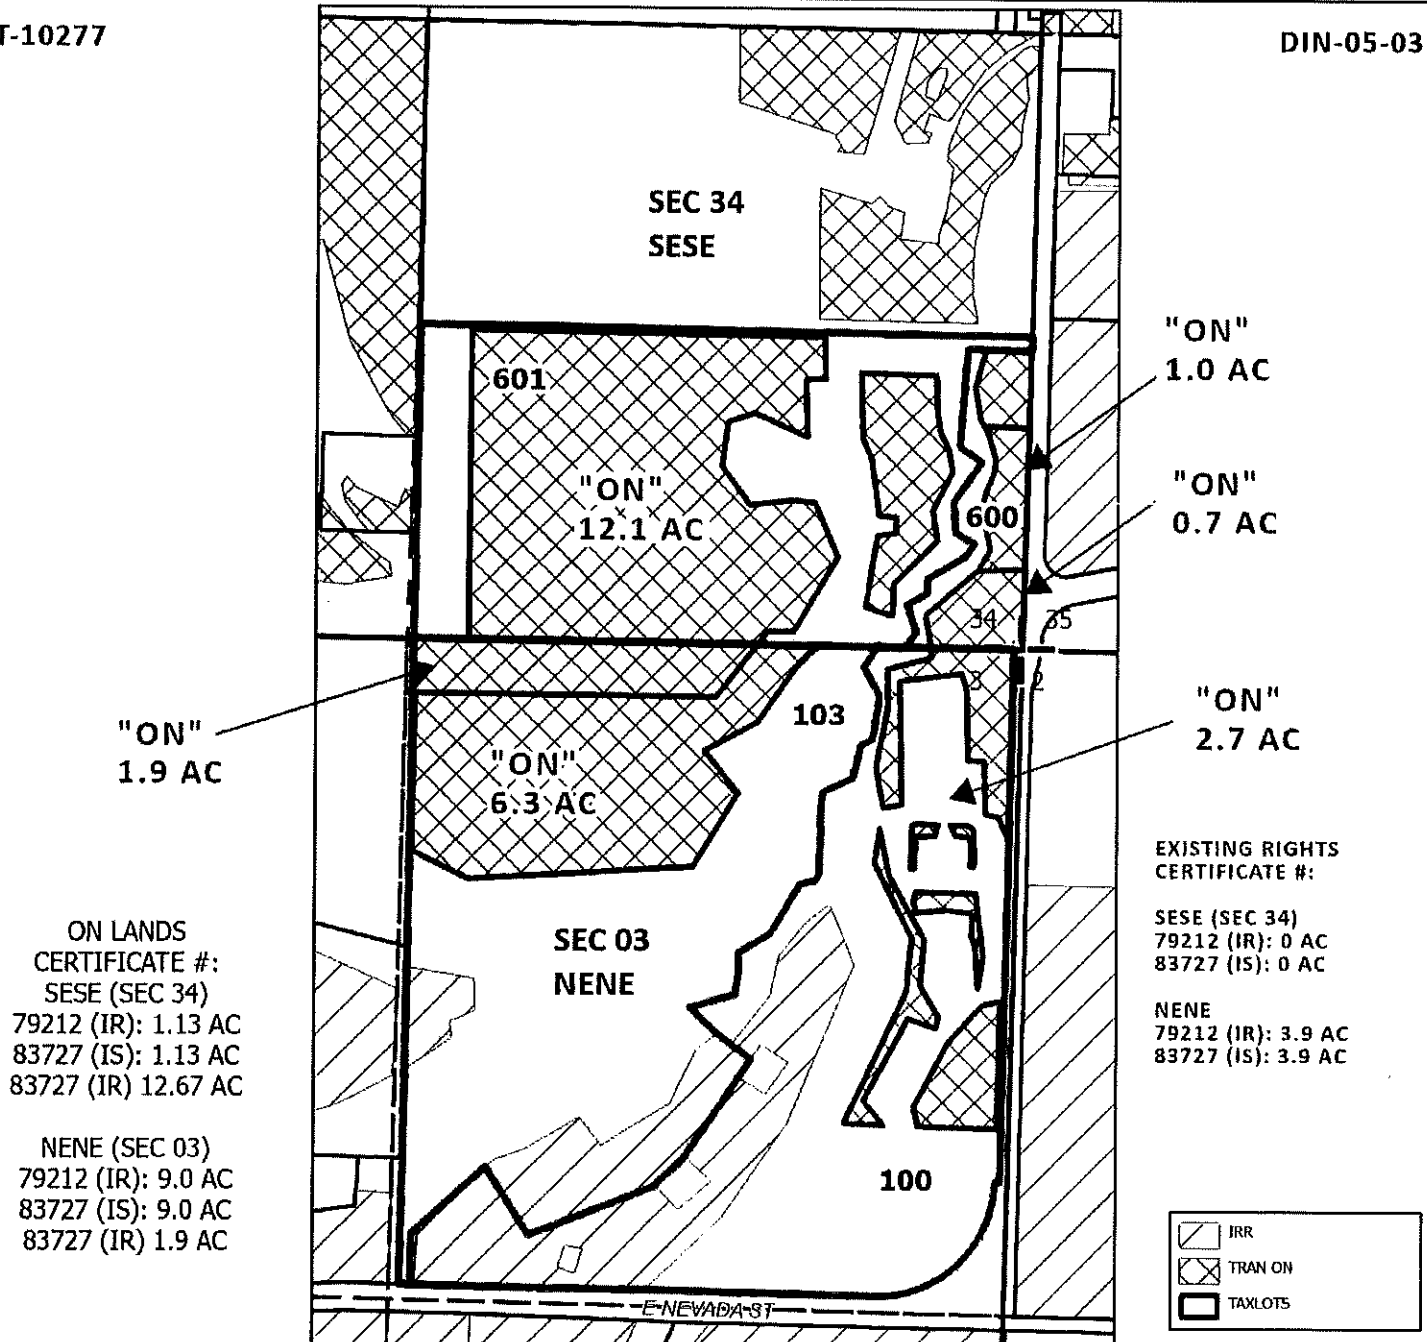

DATE: 08/2/2024

CLAIM OF BENEFICIAL USE MAP

NAME: LARA SCHLEINING (DBA SILVER SPRINGS RANCH)

TAXLOT #: 600

SESE (SEC 34): 1.7 AC

TAXLOT #100:

NENE (SEC 03): 2.7 AC

TAXLOT #: 601

SESE (SEC 34): 12.1 AC

TAXLOT #: 103

NENE *SEC 03): 8.2 AC

This map is not intended to provide legal dimensions
or locations of property ownership lines

SUPERSEDED

**JACKSON COUNTY
SEC. 30 T39S R2E**

E-RECEIVED

1/21/2025

OWRD

RECEIVED

SCALE - 1" = 400'

AUG 14 2024

TALENT
IRRIGATION DISTRICT



NE 1/4 OF THE SE 1/4; SE 1/4 OF THE SE 1/4

T-10277

DIN-05-44

EXISTING RIGHTS
CERTIFICATE #:
NESE
83727 (IR): 2.5 AC

SESE
83727 (IR): 0.6 AC

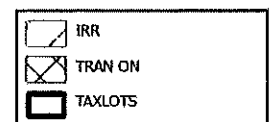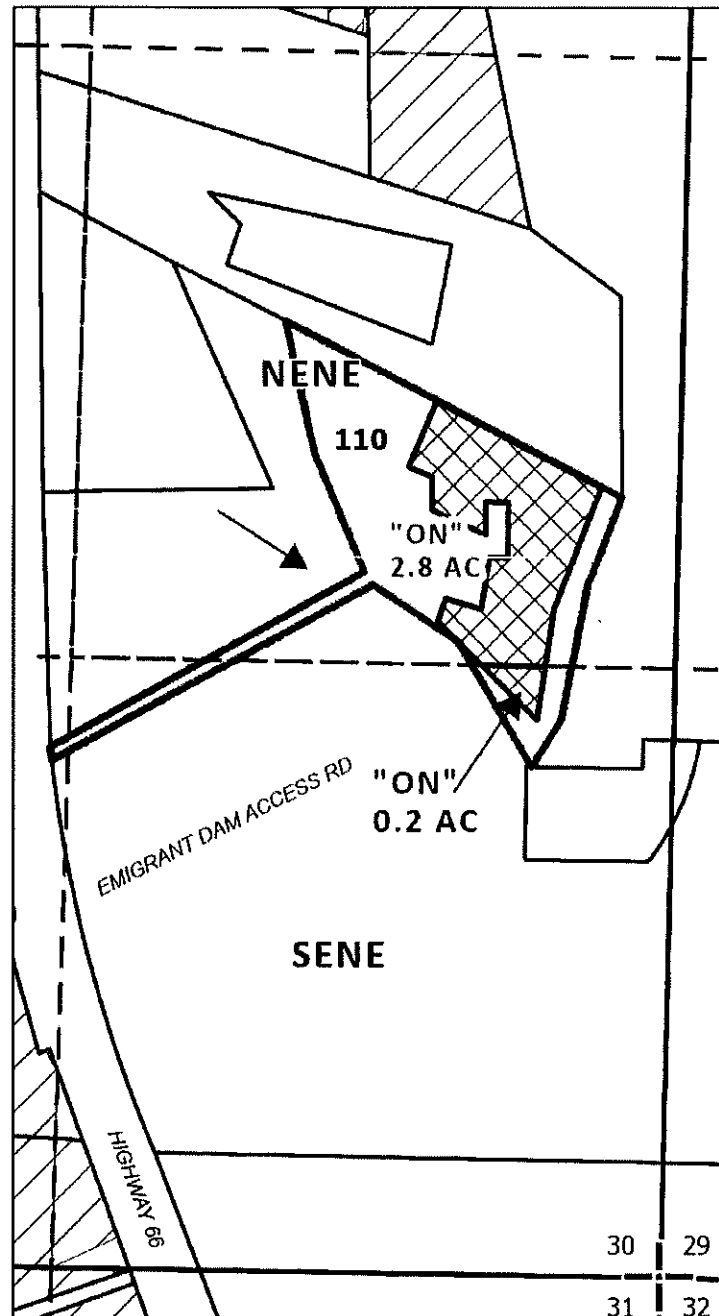

08/13/2024

CLAIM OF BENEFICIAL USE MAP

NAME: ROGER ROLFSNESS
TAXLOT #: 101 3.0 AC
NESE: 2.8 AC
SESE: 0.2 AC

ON LANDS
CERTIFICATE #:
83727 (IR): 3.0 AC

This map is not intended to provide legal dimensions
or locations of property ownership lines