



Oregon Water Resources Department
725 Summer Street NE, Suite A
Salem, Oregon 97301-1266
(503) 986-0900
www.wrd.state.or.us

District Permanent Water Right Transfer Claim of Beneficial Use

1. APPLICANT INFORMATION

District: Talent Irrigation District

District Transfer Year: 2008

Contact Person: Jim Pendleton, Manager

Phone: 541-535-1529

Mailing Address: PO Box 467

City: Talent State: OR Zip: 97540

E-Mail address: tid@talentid.org

Transfer Number: T - 10739

2. WATER RIGHT(S)

Pursuant to OAR Chapter 690, Division 385, the district is submitting to the Water Resources Department this claim of beneficial use for the following water right(s):

PERMIT NUMBER	CERTIFICATE NUMBER	DECREE (name, volume, and page)	PRIMARY (P) OR SUPP (S)
-	83727		☒ P ☒ S
-	79212		☒ P ☐ S
-			☐ P ☐ S
-			☐ P ☐ S

3. AUTHORIZED POINT(S) OF DIVERSION (POD) / APPROPRIATION (POA)

The authorized point(s) of diversion / appropriation for the water right modified by the transfer are as follows:

PERMIT NUMBER	DECREE or CERTIFICATE	POD / POA #	SOURCE	LOCATION – MEASURED DISTANCES
-	N/A			
-				
-				
-				

RECEIVED

NOV 18 2011

WATER RESOURCES DEPT
SALEM, OREGON

s/b Section 31. Cert

s/b section 31

0.91 revised COBU
map C 83727

s/b section 31,

4. AUTHORIZED PLACE OF USE

The summary of the perfected change in place of use authorized by the final order approving the water right transfer is listed in Table 1.

TABLE 1 – AUTHORIZED PLACE OF USE (POU)

CERTIFICATE DECREE or PERMIT	POD / POA #	PRIORITY DATE	USE	LEGAL DESCRIPTION							GOV'T LOT	TAX LOT	ACRES	USER NAME
				TWP	RNG	SEC	QQ	DLC						
79212	04-34	8-20-1950	IR	40S	2 E	05	SW NE				500	1.00	GREEK, JANET	
79212	04-35	8-20-1950	IR	38 S	2 W	12	SW NE				213	.50	JEWELLYN, GARY	
79212	04-35	8-20-1950	IR	38 S	2 W	12	SE NW				1002	.50	LEWELLYN, GARY	
79212	04-52	8-20-1950	IR	39 S	2 E	32	SE NE				1406	.27	BRAMSCHER, CRAIG	
79212	04-52	8-20-1950	IR	39 S	2 E	32	NE SE				1406	.64	BRAMSCHER, CRAIG	
79212	04-52	8-20-1950	IR	39 S	2 E	32	NE SE				1406	.31	BRAMSCHER, CRAIG	
79212	04-52	8-20-1950	IR	39 S	2 E	32	NW SW				1406	3.42	BRAMSCHER, CRAIG	
83727	05-11	9-6-1915	IR	39 S	2 E	20	NE SW				502	.50	PENNINO, JOSEPH	
83727	05-29	9-6-1915	IR	39 S	2 E	19	NE SE				119	1.00	ANTON, JOHN	
83727	05-32	9-6-1915	IR	39 S	2 E	19	NE SE				112	1.50	CORP, JANET	
83727	05-32	9-6-1915	IR	39 S	2 E	19	NW SE				112	.40	CORP, JANET	
83727	05-32	9-6-1915	IR	39 S	2 E	19	SW NE				112	1.30	CORP, JANET	
83727	05-32	9-6-1915	IR	39 S	2 E	19	SE NW				112	.80	CORP, JANET	
83727	05-33	9-6-1915	IR	39 S	2 E	19	SW SE				116	2.00	CORP, MARGARET	
79212	05-40	8-20-1950	IR	39 S	1 E	24	SW NE				100	.70	COTA, GEORGE	
79212	05-40	8-20-1950	IR	39 S	1 E	24	SE NE				100	.30	COTA, GEORGE	
79212	05-41	8-20-1950	IR	38 S	1 W	35A	SW NE				1700	3.00	BULLWINKEL, ROBERT	
83727	05-46	9-6-1915	IR	39 S	2 E	30	SW SW				2301	.70	WINE, CURTIS	
83727	05-46	9-6-1915	IR	39 S	2 E	30	SW SW				2900	.30	WINE, CURTIS	
79212	06-6	8-20-1950	IR	38 S	1 E	21	SW NE				100	.73	PADEN, PHILIP	
79212	06-6	8-20-1950	IR	38 S	1 E	21	SE NW				100	.08	PADEN, PHILIP	
79212	06-6	8-20-1950	IR	38 S	1 E	21	NE SW				100	.08	PADEN PHILIP	
79212	06-6	8-20-1950	IR	38 S	1 E	21	NW SE				100	1.11	PADEN, PHILIP	
79212	06-8	8-20-1950	IR	38 S	1 E	22	SE SW				200	1.10	JAMES, ROBIN	
79212	06-9	8-20-1950	IR	38 S	1 E	22	SW SW				200	.59	YOUNG, SCOTT	
79212	06-9	8-20-1950	IR	38 S	1 E	22	SE SW				200	1.83	YOUNG, SCOTT	
79212	06-9	8-20-1950	IR	38 S	1 E	27	NW NW				200	1.46	YOUNG, SCOTT	
79212	06-9	8-20-1950	IR	38 S	1 E	27	NE NW				200	.62	YOUNG, SCOTT	
79212	06-9	8-20-1950	IR	38 S	1 E	27	NW NE				200	2.00	YOUNG, SCOTT	

RECEIVED

4. AUTHORIZED PLACE OF USE

The summary of the perfected change in place of use authorized by the final order approving the water right transfer is listed in Table 1.

WATER RESOURCES DEPT.
SALEM, OREGON

SALEM, OREGON			LEGAL DESCRIPTION										ACRES	USER NAME
CERTIFICATE DECREE or PERMIT	POD / POA #	PRIORITY DATE	USE	TWP	RNG	SEC	QQ	DLC	GOV'T LOT	TAX LOT				
79212	07-01	8-20-1950	IR	38 S	2 W	02DD	SW SE				2300	.25	ASHPOLE, RONALD	
79212	07-01	8-20-1950	IR	38 S	2 W	02DD	SE SE				2300	.25	ASHPOLE, RONALD	
79212	07-05	8-20-1950	IR	38 S	2 W	13	SE NW				2627	4.70	HARRIS, STANLEY	
79212	07-05	8-20-1950	IR	38 S	2 W	13	NE SW				2627	.30	HARRIS, STANLEY	
79212	07-10	8-20-1950	IR	38 S	2 W	13	SE NW				2620	3.17	TUTLAND, GUY	
79212	07-10	8-20-1950	IR	38 S	2 W	13	NE SW				2620	1.83	TUTLAND, GUY	
83727	07-11	9-6-1915	IR	37 S	1 W	35	SW NW				305	.30	BUBB, VAL	
79212	07-12	8-20-1950	IR	37 S	1 W	36	SE SW				500	3.29	HALL, GARY	
79212	07-13	8-20-1950	IR	37 S	1 W	36	SW SW				501	.40	BRECKEL FAMILY TRUST	
79212	07-13	8-20-1950	IR	37 S	1 W	36	SW SW				501	.20	BRECKEL FAMILY TRUST	
79212	07-13	8-20-1950	IR	37 S	1 W	36	SW SW				501	1.07	BRECKEL FAMILY TRUST	
79212	07-13	8-20-1950	IR	37 S	1 W	36	SW SW				501	8.33	BRECKEL FAMILY TRUST	
83727	07-15	9-6-1915	IR	39 S	1 E	23	SW NW				1400	1.00	SCHEIN, STEVE	
83727	07-17	9-6-1915	IR	39 S	1 E	02	NW NE				210	1.80	PAWLOWSKI, FLOYD	
79212	07-17	8-20-1950	IR	39 S	1 E	02	NW NE				210	2.20	PAWLOWSKI, FLOYD	
83727	07-18	9-6-1915	IR	39 S	1 E	02	NW NE				211	2.00	COLLEY, WILLIAM	
83727	07-19	9-6-1915	IR	39 S	1 E	02	SW NE				213	2.30	CRATEN, JOSEPH	
83727	07-19	9-6-1915	IR	39 S	1 E	02	SE NE				213	1.70	CRATEN, JOSEPH	
83727	07-20	9-6-1915	IR	39 S	1 E	02	NW SE NW NE	WNE			234	.80	SWANSON, GARY	
83727	07-20	9-6-1915	IR	39 S	1 E	02	SW NE				234	1.20	SWANSON, GARY	
83727	07-21	9-6-1915	IR	39 S	1 E	02	SW NE				236	1.10	MCGREGOR, DANIEL	
83727	07-21	9-6-1915	IR	39 S	1 E	02	SW NE				236	.70	MCGREGOR, DANIEL	
79212	07-21	8-20-1950	IR	39 S	1 E	02	NW NE				236	.20	MCGREGOR, DANIEL	
79212	07-22	8-20-1950	IR	39 S	1 E	02	SW NE				214	1.50	NELSON, PAULA	
83727	07-22	9-6-1915	IR	39 S	1 E	02	SE NE				214	1.50	NELSON, PAULA	
83727	07-23	9-6-1915	IR	39 S	1 E	02	SE NE				226	3.20	CASSEL, PETER	
83727	07-23	9-6-1915	IR	39 S	1 E	02	SW NE				226	.80	CASSEL, PETER	
											TOTAL	75.87		

s/b 83727

District Permanent Transfer
Claim of Beneficial Use

s/b 79212

5. MAP AND SITE REPORT

- ☒ Attached is a map and site report for each water right listed in Table 1 that satisfies the requirements of OAR 690-385-7400.

RECEIVED


NOV 18 2011

WATER RESOURCES DEPT
SALEM, OREGON

District Permanent Transfer
Claim of Beneficial Use

6. SIGNATURES

The district certifies that it has inspected the place of use listed in Table I, and confirms the change in place of use has been completed consistent with the terms and conditions of the final order approving the transfer.

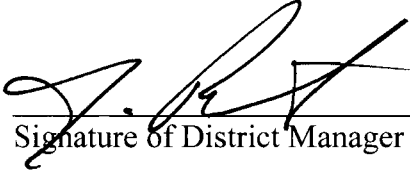

Signature of District Manager

November 16, 2011
Date

Jim Pendleton
Type or Print Name of District Manager

RECEIVED

NOV 18 2011

WATER RESOURCES DEPT
SALEM, OREGON

CLAIM OF BENEFICIAL USE
Site Report

Transfer Number: T - 10739

District Internal Notice #: 04-34

User Name: Janet Greek

541-488-5953

101 Meadow Oaks Drive

Ashland, OR 97520

Place of Use:

USE	POD #	TWP	RNG	SEC	QQ	DLC	GOV'T LOT	TAX LOT	ACRES
IR	04-34	40S	2E	05	SW NE			500	1.00

TOTAL ACRES = 1.00

District Conveyance System:

Description of Delivery System: Private pump station

Headgate: _____

Canal: Ashland Main Canal

Beneficial Use:

Description of Beneficial Use: Garden

Method Used to Apply Water: Sprinkler irrigated. The water use is metered.

Method Used to Calculate Beneficial Use: Did on-site visit of the property comparing transfer map to the actual place of use.

User Interviewed: (X) Yes () No

Beneficial Use Made as Authorized: (X) Yes () No

Description of Beneficial Use if Less than Authorized:

None

Inspected By: Mark Stitt

Mark Stitt, Ditch Rider

Date: 08-22-2011

Instructions: Attach and label the corresponding final proof map.


RECEIVED

SEP 18 2011

WATER RESOURCES DEPT
SALEM, OREGON

Transfer to
Janet Greek
101 Meadow Oaks Drive
TL 40-2E-05-500

Township 40
Range 2E
Section 05
Tax Lot 500
1.00 Acre

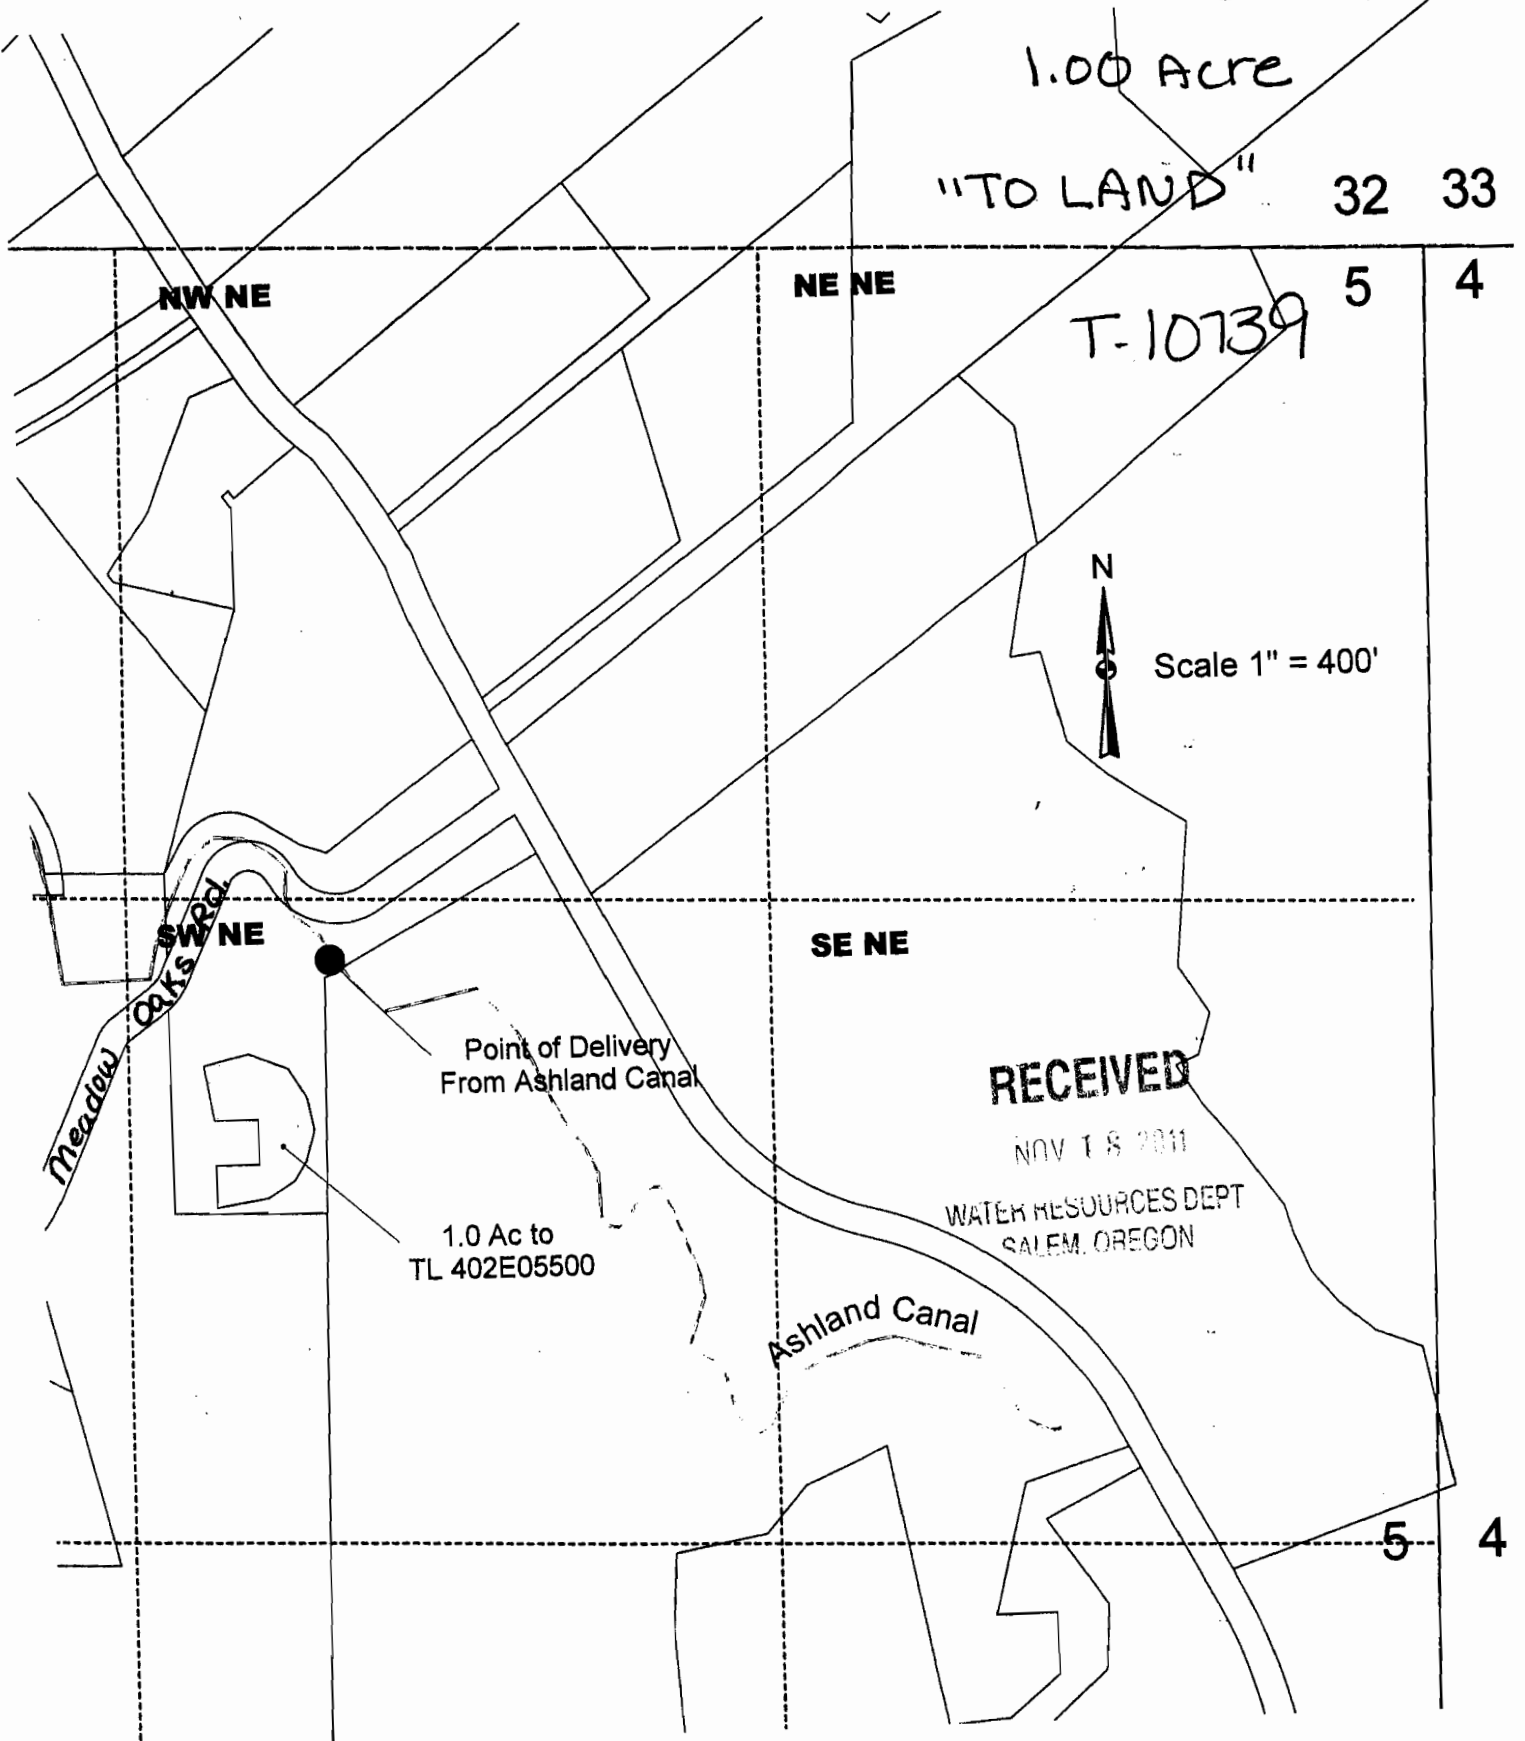

**CLAIM OF BENEFICIAL USE
Site Report**

Transfer Number: T – 10739

District Internal Notice #: 04-35

User Name: Gary and Yvonne Lewellyn 541-772-7210

3250 Darrell Driye Medford, OR 97501

Place of Use:

USE	POD #	TWP	RNG	SEC	QQ	DLC	GOV'T LOT	TAX LOT	ACRES
IR	04-35	38S	2W	12	SW NE			213	.50
IR	04-35	38S	2W	12	SE NW			1002	.50

TOTAL ACRES = 1.00

District Conveyance System:

Description of Delivery System: Private turn out off of the W-5 Lateral

Headgate: _____

Canal: West Main Canal

Beneficial Use:

Description of Beneficial Use: YARD & GARDEN

Method Used to Apply Water: Sprinkler irrigated. The water use is metered.

Method Used to Calculate Beneficial Use: Did on-site visit of the property comparing transfer map to the actual place of use.

User Interviewed: (X) Yes () No

Beneficial Use Made as Authorized: (X) Yes () No

Description of Beneficial Use if Less than Authorized:

None

Inspected By: Steven Essary
Steven Essary, Ditch Rider

Date: 06-29-11

Instructions: Attach and label the corresponding final proof map.


RECEIVED

NOV 18 2011

WATER RESOURCES DEPT
SALEM, OREGON

Water Right Transfer
From
Gregory Taylor
To
Gary & Yvonne Lewellyn
T 38 S, R 2 W, Sec. 12, W.M.

04-35
From Land
38-2W-12 1100
1.00 AC
TO Land
38-2W-12 213
.50 AC
38-2W-12 1002
.50 AC
T-10739

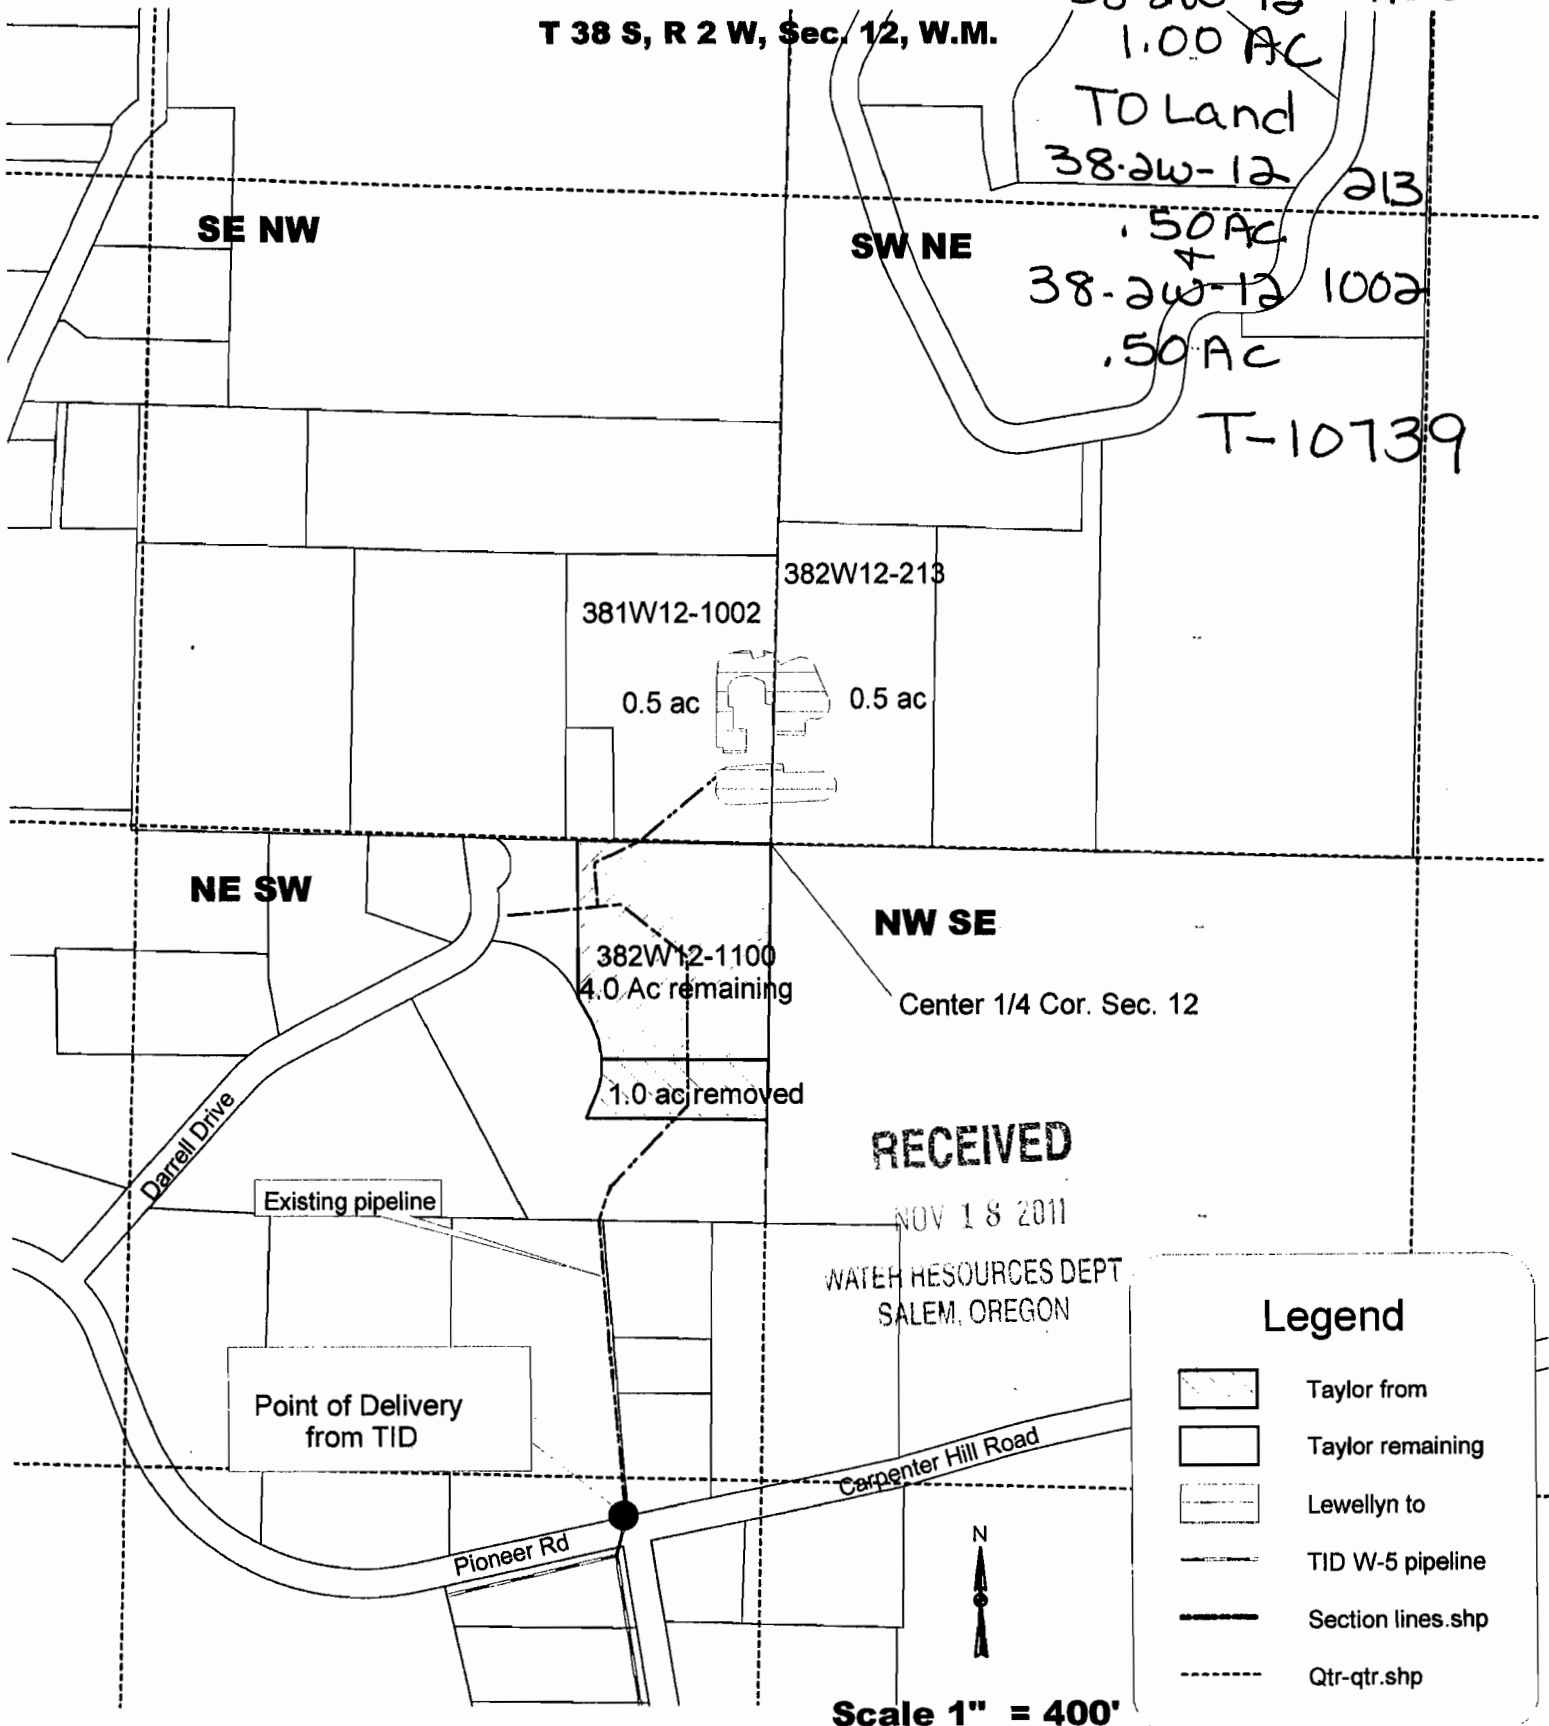

RECEIVED

NOV 18 2011

WATER RESOURCES DEPT.
SALEM, OREGON

Legend

- Taylor from
- Taylor remaining
- Lewellyn to
- TID W-5 pipeline
- Section lines.shp
- Qtr-qtr.shp

**CLAIM OF BENEFICIAL USE
Site Report**

Transfer Number: T - 10739

District Internal Notice #: 04-52

User Name: Craig and Jennifer Bramscher

7118 Hwy. 66

Ashland, OR 97520

Place of Use:

USE	POD #	TWP	RNG	SEC	QQ	DLC	GOV'T LOT	TAX LOT	ACRES
IR	04-52	39S	2E	32	SE NE			1406	.27
IR	04-52	39S	2E	32	NE SE			1406	.64
IR	04-52	39S	2E	32	NE SE			1406	.31
IR	04-52	39S	2E	32	NW SW			1406	3.42
IR	04-52	39S	2E	32	SW NW			1406	1.04

TOTAL ACRES = 5.68

District Conveyance System:

Description of Delivery System: Private turnout

Headgate: _____

Canal: Ashland Main Canal

Beneficial Use:


Method Used to Apply Water: Sprinkler irrigated. The water use is metered.

Method Used to Calculate Beneficial Use: Did on-site visit of the property comparing transfer map to the actual place of use.

User Interviewed: (X) Yes () No

Beneficial Use Made as Authorized: (X) Yes () No

Description of Beneficial Use if Less than Authorized:

None

Inspected By: Mark Stitt
Mark Stitt, Ditch Rider

Date: 9-23-2007


Instructions: Attach and label the corresponding final proof map.

S:\Wanda\Word\TRANSFERS\OWRD\2011 Claim of Beneficial Use Site Reports T-10739 2008.doc

RECEIVED


NOV 18 2011

WATER RESOURCES DEPT
SALEM, OREGON

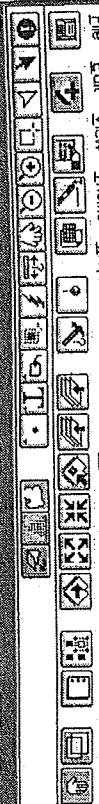

Jackson County

- ☐ Section Numbers
- ☐ From_Lands_03_2010.shp
- ☐ To_Lands_03_2010.shp
- ☐ Section Lines
- ☐ Townships
- ☐ Poly25015.shp
- ☐ 25015
- ☐ Buffer_10.shp
- ☒ Major Road Names
- ☒ All Streets
- ☐ 25015_Intersect2.shp
- ☒ Tax Lots
- ☐ Urban Growth Boundary
- ☐ 70212
- ☐ 1382
- ☐ 4637
- ☐ 25015
- ☐ Major Roads
- ☐ All Soils
- ☐ Urban Containment Bound
- ☒ Laterals_2011.shp
- ☐ TID
- ☐ ABANDONED
- ☐ PRIVATE
- ☐ TID25015_8_07.shp
- ☐ proc12003
- ☒ Streams & Ditches
- ☐ Laterals 1-20-00
- ☒ Laterals
- ☒ Canals.shp
- ☐ Laterals.shp
- ☒ Rivers & Lakes
- ☐ Tidusets.shp
- ☒ Other.shp

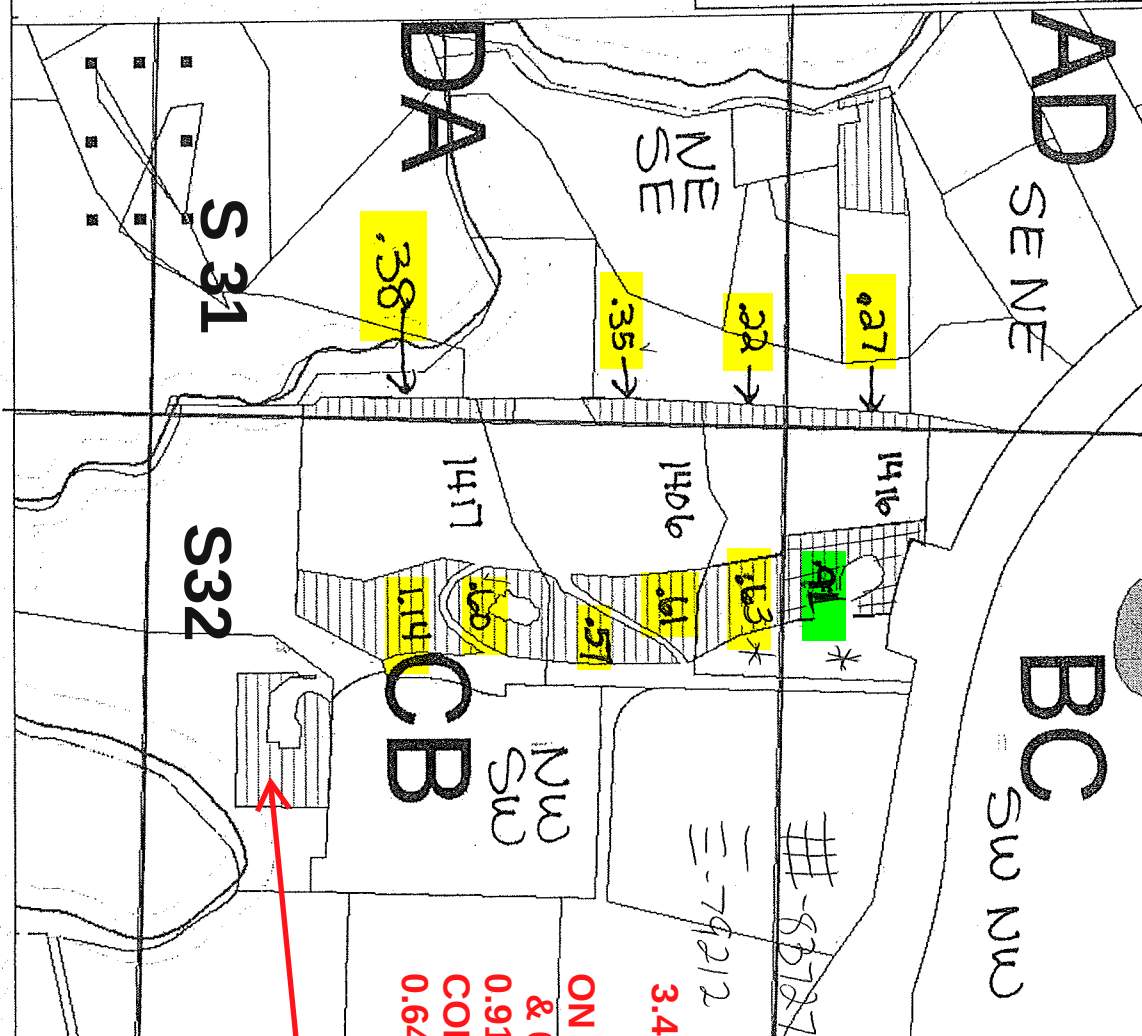

AMENDED COBU MAP

39S 2E, 31, 32

C. 79212 = 4.77 OFF 39S 1E 11 NWSW TL 1000

C. 83727 = 0.91 OFF 29 S 2E 32 NWSW TL 1406

3.42 + 1.04 (FO) = 0.91+3.55 (COBU)

ON FO C83791 FO = .91 = .27 SENE & 0.64 NESE, but on COBU 0.91 (was 1.04 on FO) in SWNW; and COBU 0.91 ON C.79212 = .27 SENE & 0.64 NESE

**1.0 ACRE on T-10485
DINN 07-03**

SE NE

SW NW

SUPERSEDED

Branscher Water Right Transfer

T39S, R2E, Sec 31 & 32

Township 39
Range 2E
Section 31 &
32

Tax Lot 1406

"From &
To Land"
T.10739

NE SE

NW SW

SW SW

SE SE

0.27

1.28

1.04

0.09

0.51

0.82

0.19

0.13

0.31

3.42

5.61

TL 39-2E-32-1406



Scale 1" = 400'

RECEIVED

NOV 18 2011

WATER RESOURCES DEPT
SALEM, OREGON

31

32

6

5

Legend



No change



From Branscher



Branscher to Branscher



Bud's Dairy to



Section lines.shp



Qtr-qtr.shp



Robert and Robyn Cockell

Transfer to
39-2E-20-502

05-11
"To Land"

39-2E-20
502

T-10739

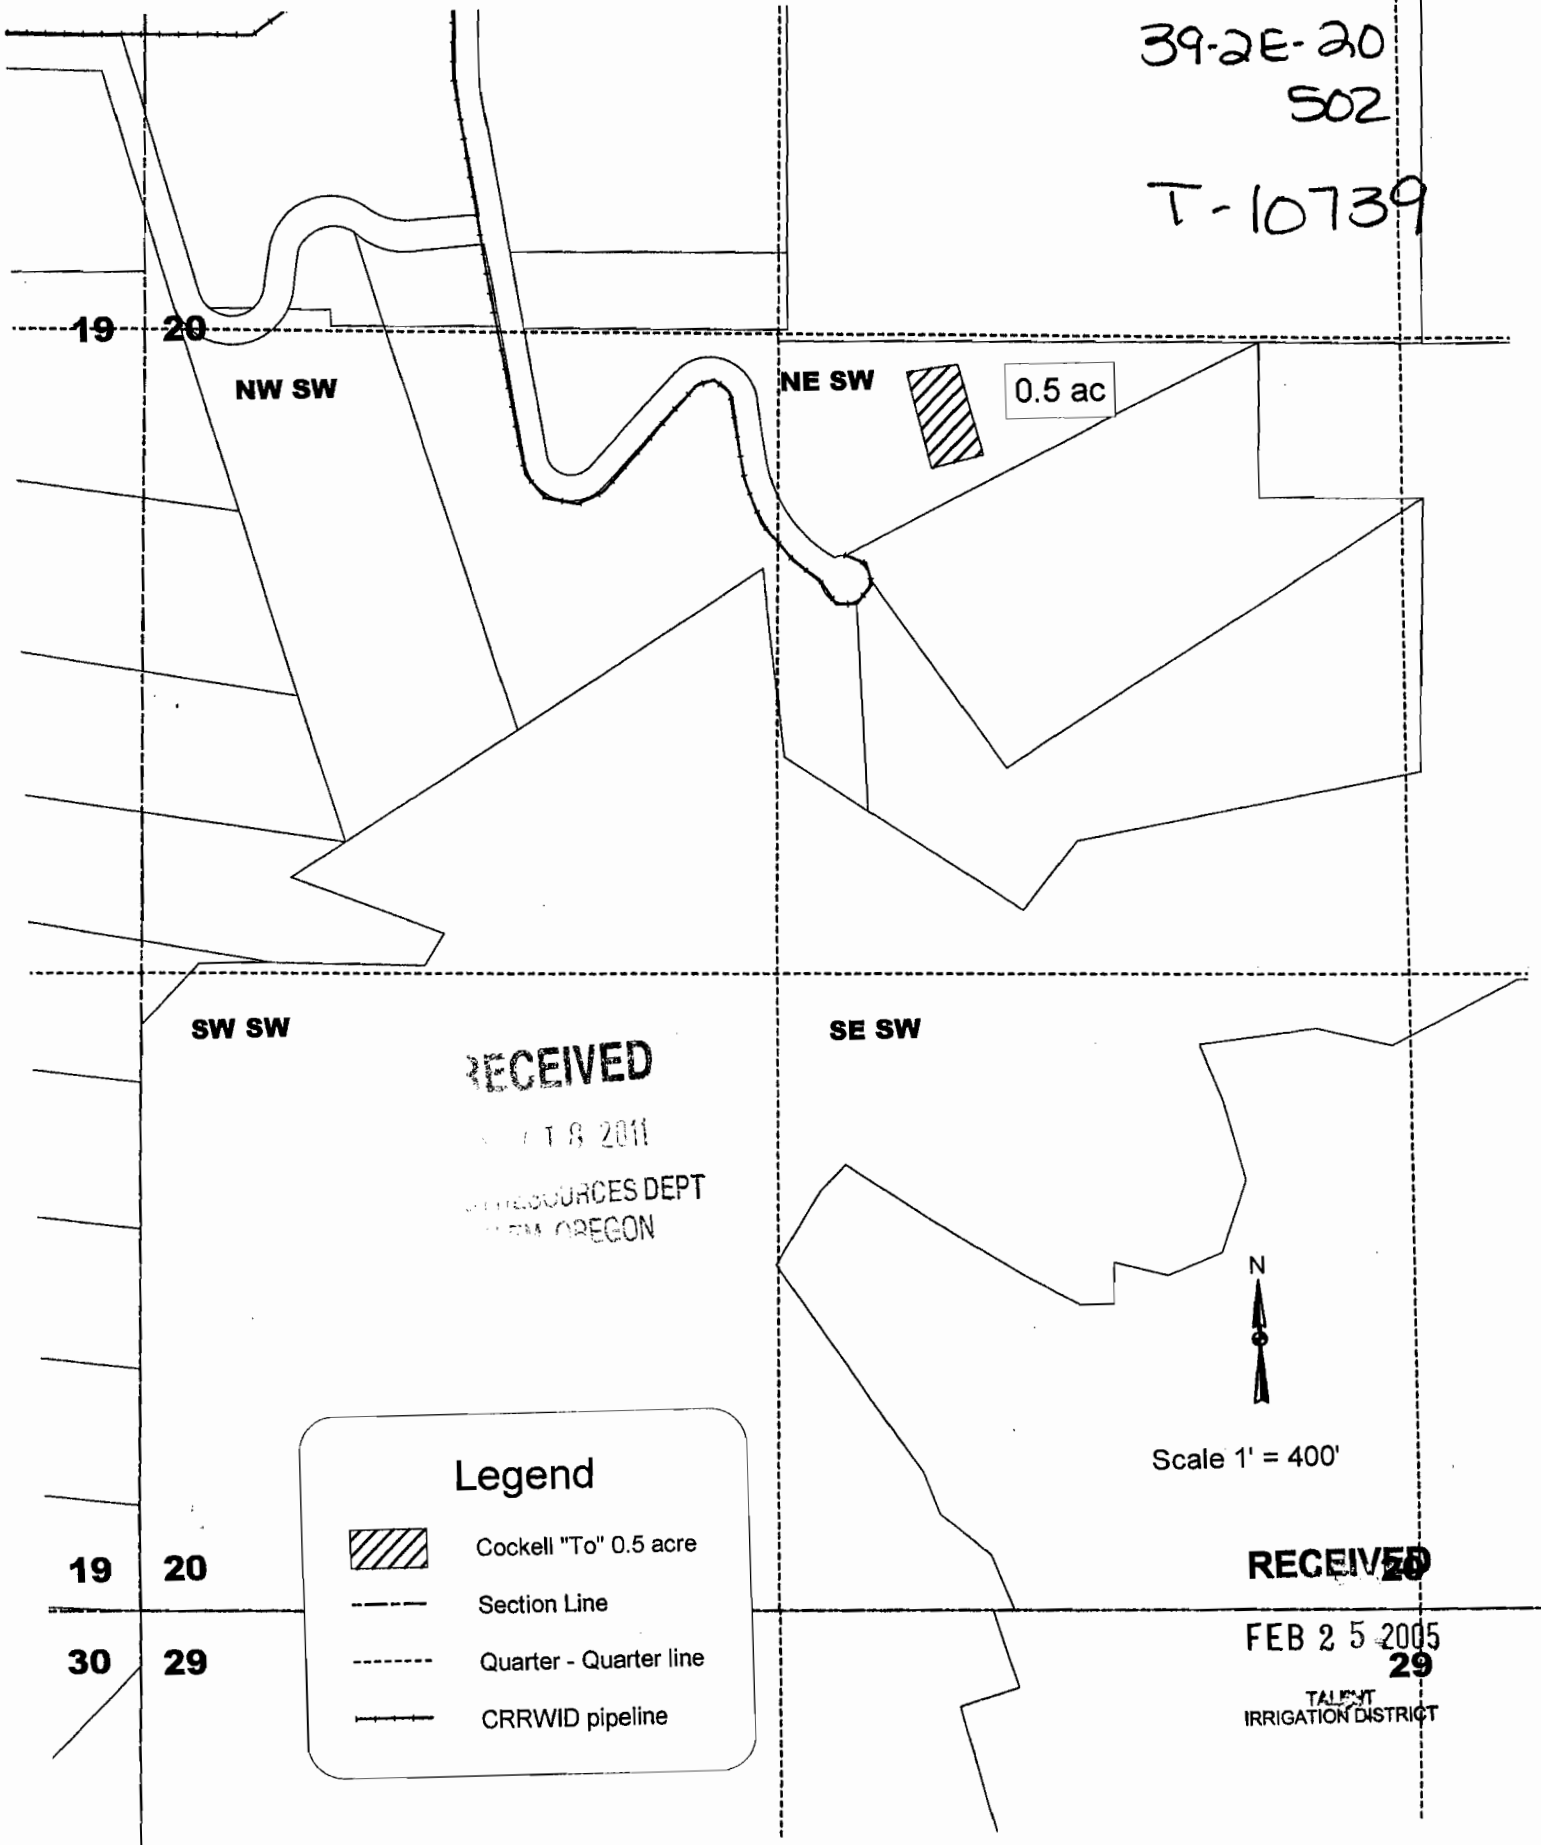

**CLAIM OF BENEFICIAL USE
Site Report**

Transfer Number: **T – 10739**

District Internal Notice #: **05-29**

User Name: John and Nell Anton

11444 Corp Ranch Road Ashland, OR 97520

Place of Use:

USE	POD #	TWP	RNG	SEC	QQ	DLC	GOV'T LOT	TAX LOT	ACRES
IR	05-29	39S	2E	19	NE SE			119	1.00
TOTAL ACRES =									1.00

District Conveyance System:

Description of Delivery System: Private pipeline in the Corp Ranch Road Water Improvement District

Headgate: None

Canal: Ashland Main Canal

Beneficial Use:

Description of Beneficial Use: Garden

Method Used to Apply Water: Sprinkler irrigated. The water use is metered.

Method Used to Calculate Beneficial Use: Did on-site visit of the property comparing transfer map to the actual place of use.

User Interviewed: (X) Yes () No

Beneficial Use Made as Authorized: (X) Yes () No

Description of Beneficial Use if Less than Authorized:

None

Inspected By: Mark Stitt Date: 8-10-2011
Mark Stitt, Ditch Rider


Instructions: Attach and label the corresponding final proof map.

RECEIVED

**Transfer of Water Right
to
John & Nell Anton
39-2E-19-119**

05-29
TO
39-2E-19-119

T-10739

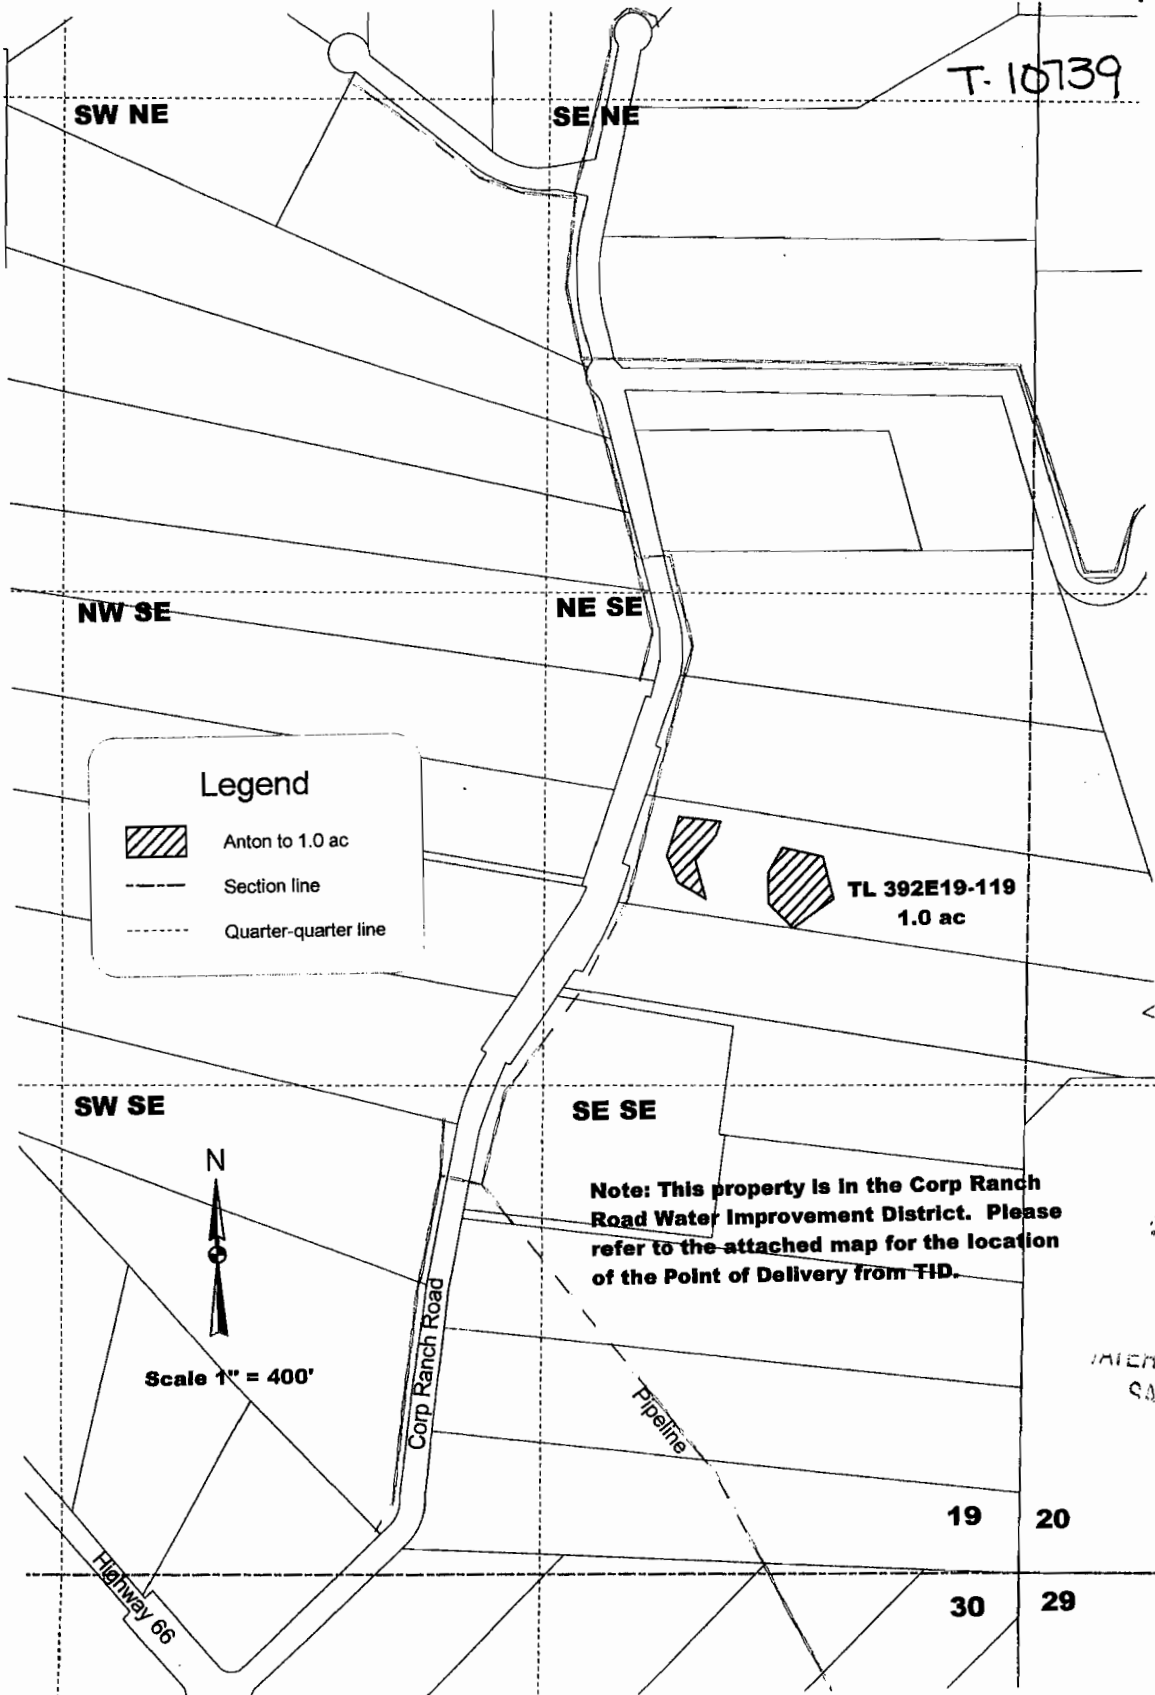

RECEIVED

MAY 18 2011

WATER RESOURCES DEPT
SALEM, OREGON

**CLAIM OF BENEFICIAL USE
Site Report**

Transfer Number: T - 10739

District Internal Notice #: 05-32

User Name: Janet Corp

Corp Ranch Road Ashland, OR 97520

Place of Use:

USE	POD #	TWP	RNG	SEC	QQ	DLC	GOV'T LOT	TAX LOT	ACRES
IR	05-32	39S	2E	19	NE SE			112	1.50
IR	05-32	39S	2E	19	NW SE			112	.40
IR	05-32	39S	2E	19	SW NE			11	1.30
IR	05-32	39S	2E	19	SE NW			112	.80

TOTAL ACRES = 3.00

District Conveyance System:

Description of Delivery System: Private pipeline in the Corp Ranch Road Water Improvement District

Headgate: None

Canal: Ashland Main Canal

Beneficial Use:

Description of Beneficial Use: Pasture Land

Method Used to Apply Water: Sprinkler irrigated. The water use is metered.

Method Used to Calculate Beneficial Use: Did on-site visit of the property comparing transfer map to the actual place of use.

User Interviewed: (X) Yes () No

Beneficial Use Made as Authorized: (X) Yes () No

Description of Beneficial Use if Less than Authorized:

None

Inspected By: Mark Stitt

Mark Stitt, Ditch Rider

Date: 9-21-2011

RECEIVED

NOV 18 2011

WATER RESOURCES DEPT
SALEM, OREGON

Instructions: Attach and label the corresponding final proof map.


S:\Wanda\Word\TRANSFERS\OWRD\2011 Claim of Beneficial Use Site Reports T-10739 2008.doc

Transfer of Water Right
to
Janet Elaine Corp
39-2E-19-112

05-32
"To Land"

39-2E-19
112

T-10739

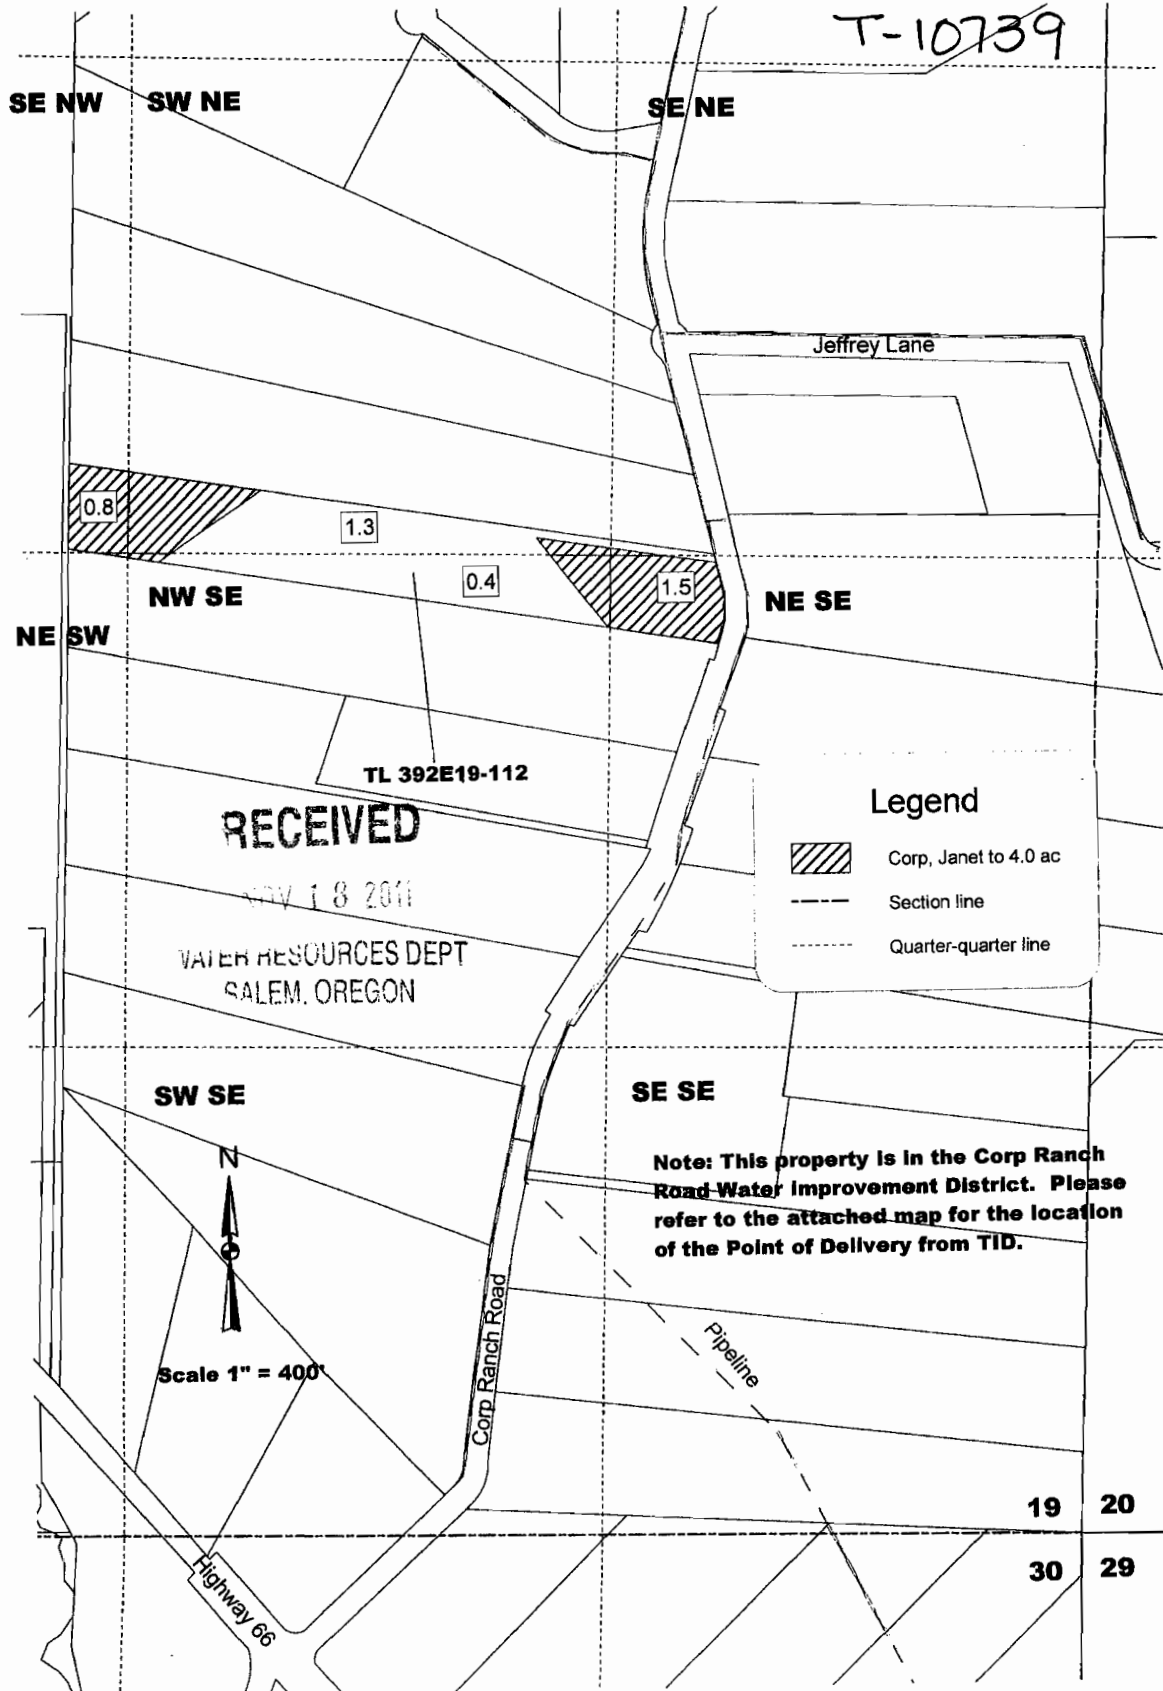

**CLAIM OF BENEFICIAL USE
Site Report**

Transfer Number: T - 10739

District Internal Notice #: 05-33

User Name: Margaret Corp

Corp Ranch Road Ashland, OR 97520

Place of Use:

USE	POD #	TWP	RNG	SEC	QQ	DLC	GOV'T LOT	TAX LOT	ACRES
IR	05-33	39S	2E	19	SW SE			116	2.00
TOTAL ACRES =									2.00

District Conveyance System:

Description of Delivery System: Private pipeline in the Corp Ranch Road Water Improvement District

Headgate: None

Canal: Ashland Main Canal

Beneficial Use:

Description of Beneficial Use: Pasture, Hay

Method Used to Apply Water: Sprinkler irrigated. The water use is metered.

Method Used to Calculate Beneficial Use: Did on-site visit of the property comparing transfer map to the actual place of use.

User Interviewed: (X) Yes () No

Beneficial Use Made as Authorized: (X) Yes () No

Description of Beneficial Use if Less than Authorized:

None

Inspected By: Mark Stitt

Mark Stitt, Ditch Rider

Date: 9-21-2011

Instructions: Attach and label the corresponding final proof map.


RECEIVED

NOV 16 2011

**Transfer of Water Right
to
Margaret E. Corp
39-2E-19-116**

05-33
"To Land"

39-2E-19 116
T-10739

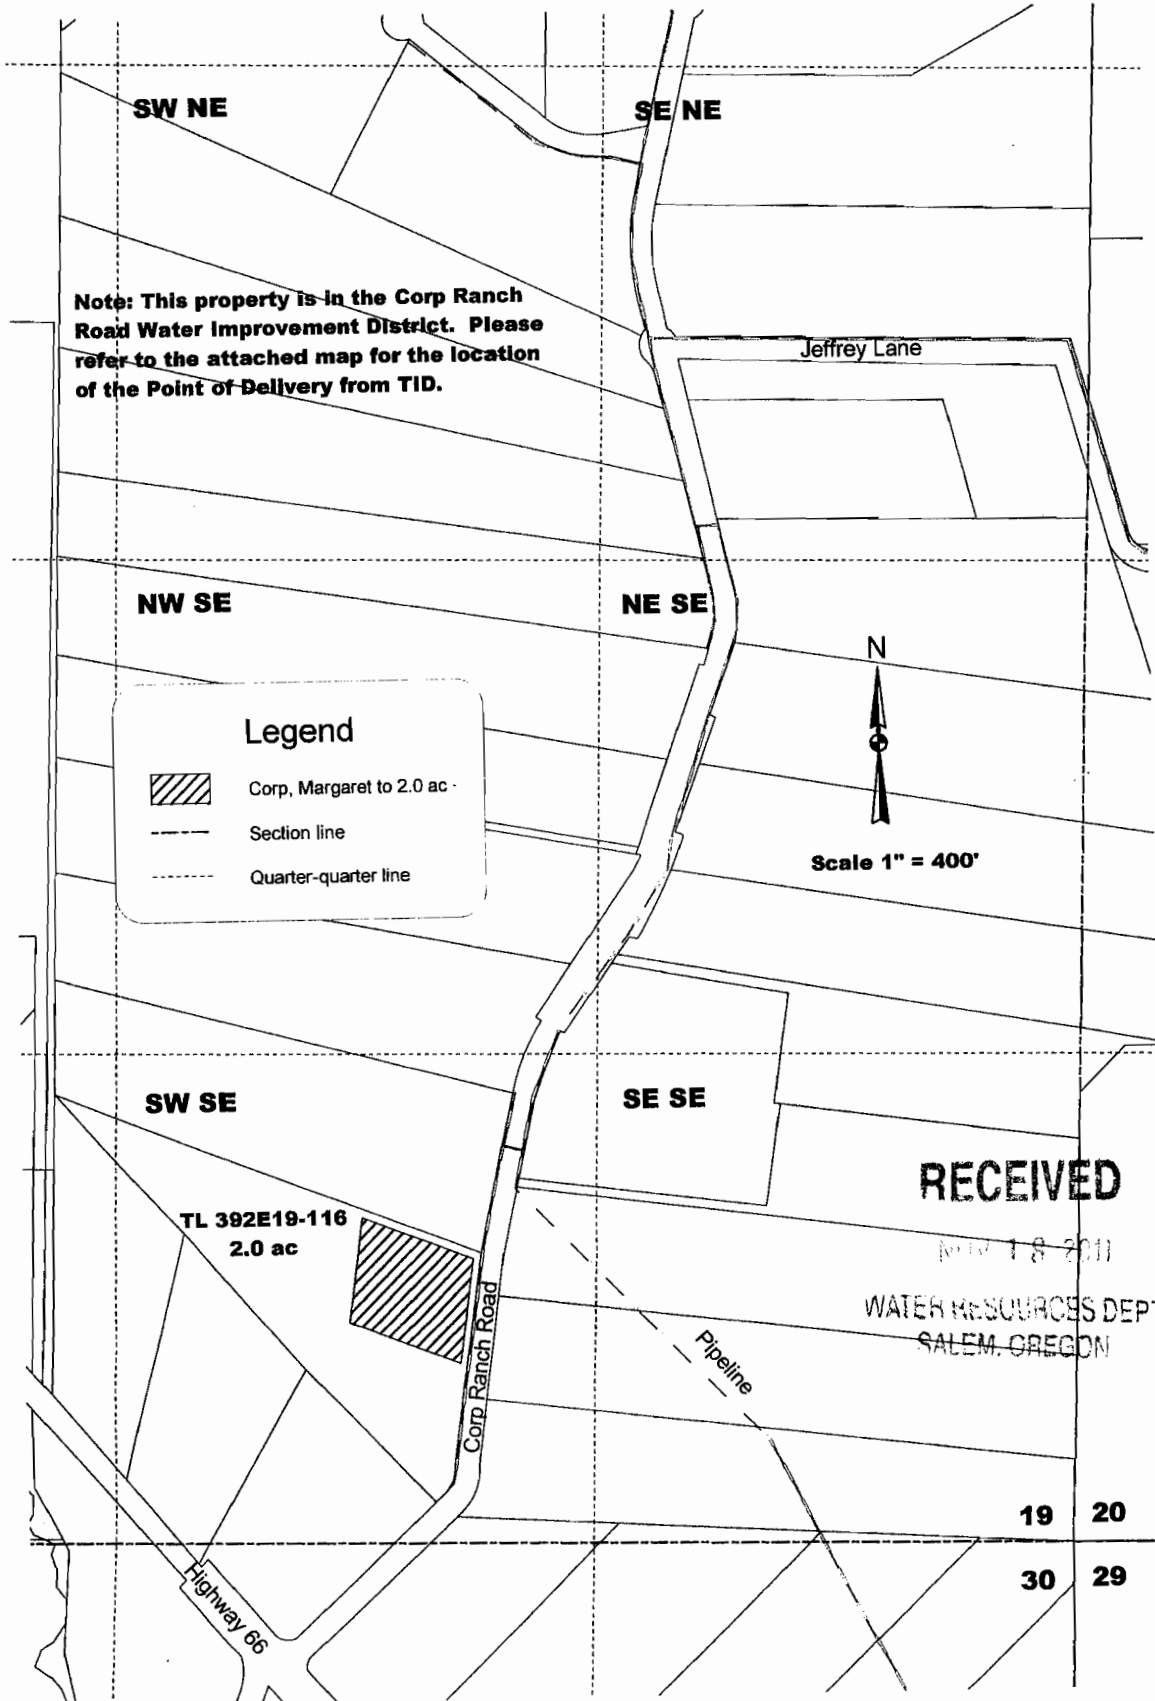

CLAIM OF BENEFICIAL USE
Site Report

Transfer Number: T - 10739

District Internal Notice #: 05-40

User Name: George and Barbara Cota 541-944-1397

4300 Hwy. 66 Ashland, OR 97520

Place of Use:

USE	POD #	TWP	RNG	SEC	QQ	DLC	GOV'T LOT	TAX LOT	ACRES
IR	05-40	39S	1E	24	SW NE			100	.70
IR	05-40	39S	1E	24	SE NE			100	.30

TOTAL ACRES = 1.00

District Conveyance System:

Description of Delivery System: Private pump station in Clayton Creek

Headgate: None

Canal: Ashland Main Canal

Beneficial Use:

Description of Beneficial Use: Garden ponds

Method Used to Apply Water: Sprinkler irrigated. The water use is metered.

Method Used to Calculate Beneficial Use: Did on-site visit of the property comparing transfer map to the actual place of use.

User Interviewed: (X) Yes () No

Beneficial Use Made as Authorized: (X) Yes () No

Description of Beneficial Use if Less than Authorized:

None

Inspected By: Mark Stitt

Mark Stitt, Ditch Rider

Date: 8-25-2011

RECEIVED

NOV 18 2011

WATER RESOURCES DEPT
SALEM, OREGON

Water Right Transfer

To

George & Barbara Cota

T 39 S, R 1 E, Sec 24, Tax Lot 100

05-40


39-1E-24

TL 100

1.00 Ac.

To Land

T-10739

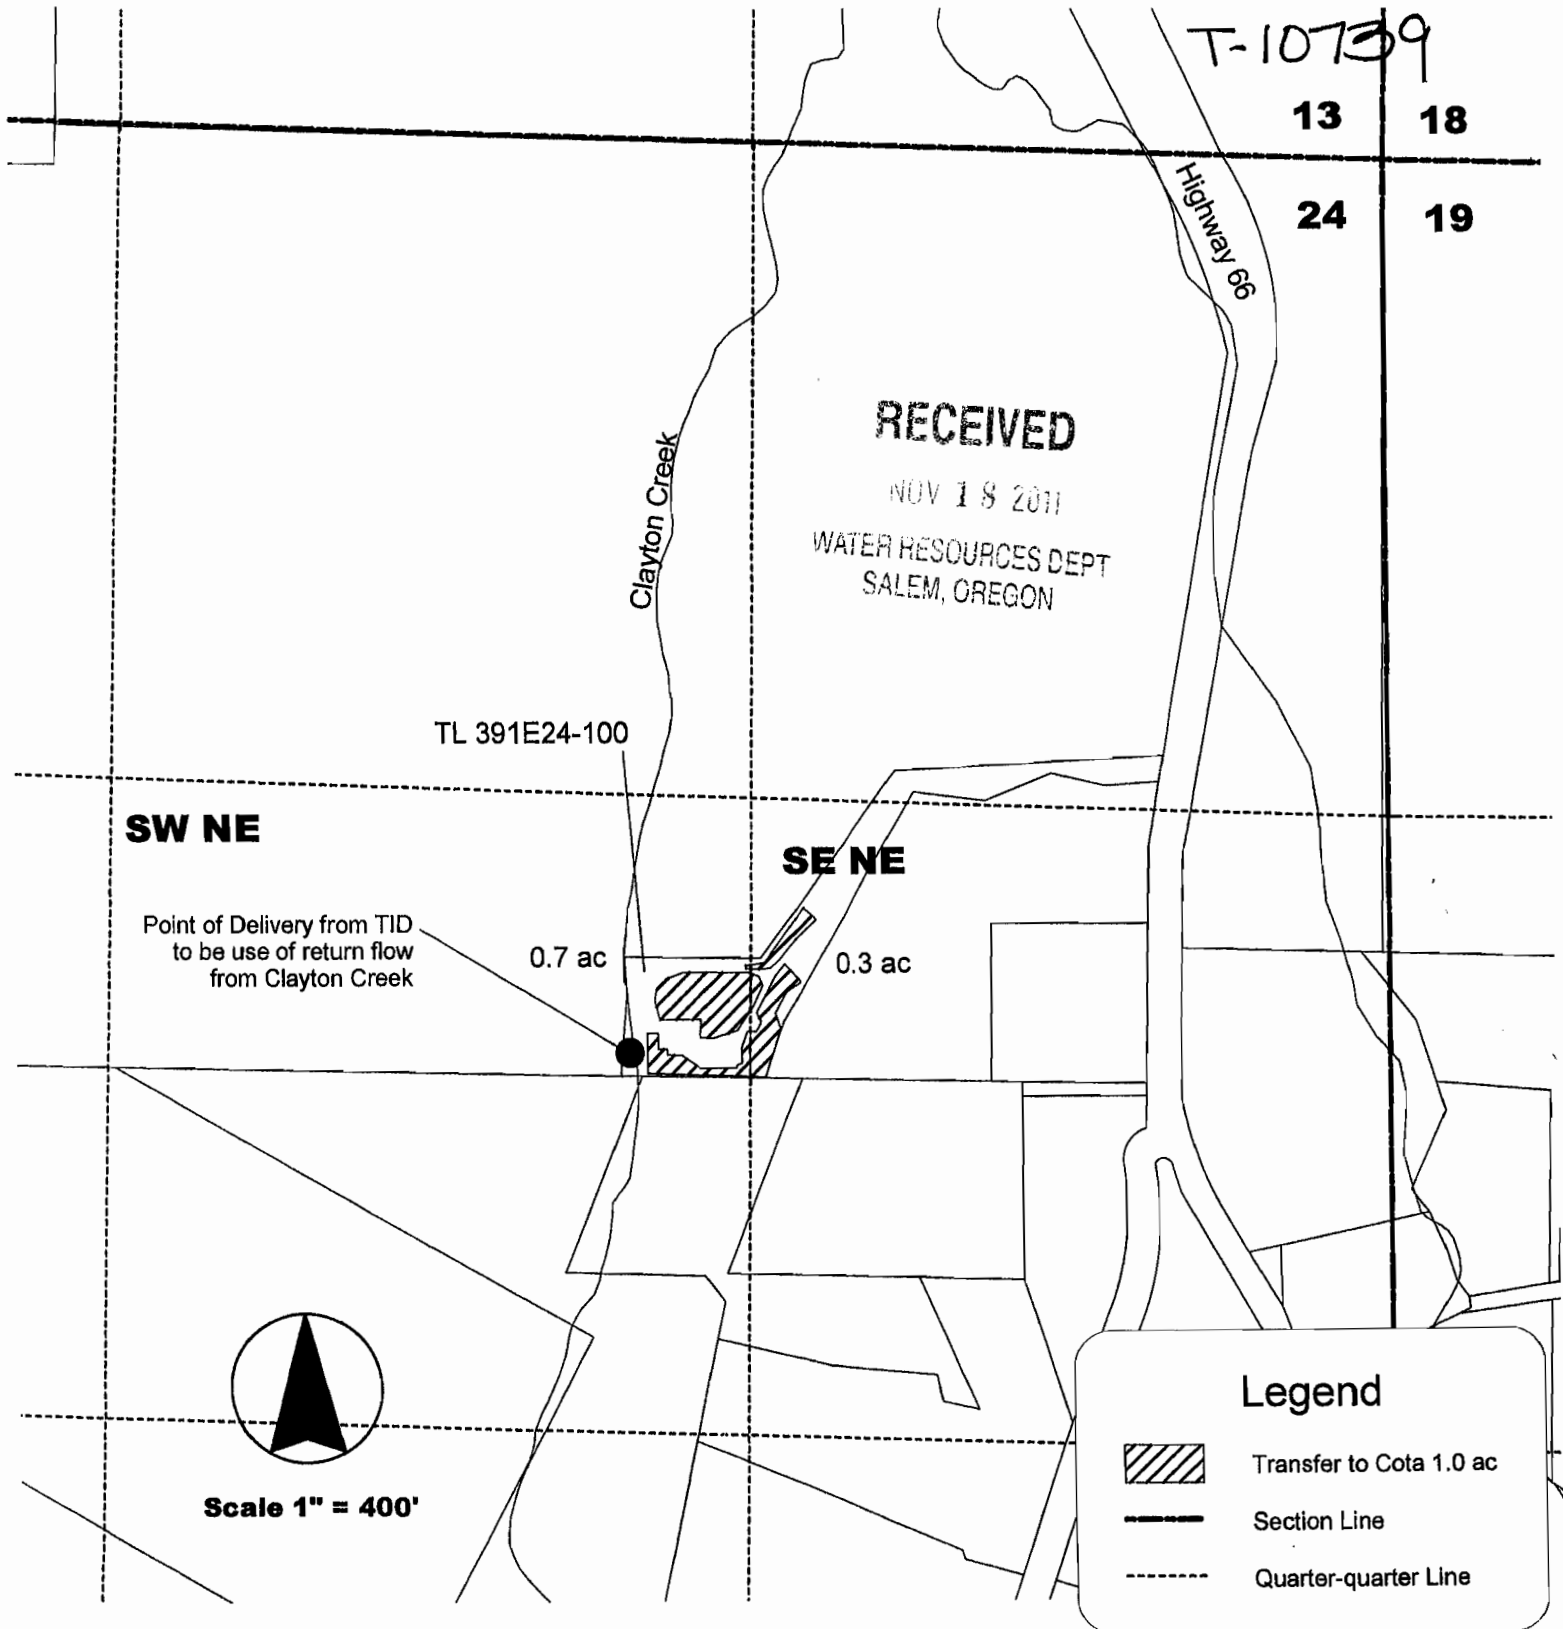

**CLAIM OF BENEFICIAL USE
Site Report**

Transfer Number: T - 10739

District Internal Notice #: 05-41

User Name: Robert Bullwinkel

541-535-3678

7469 Rapp Lane

Talent, OR 97540

Place of Use:

USE	POD #	TWP	RNG	SEC	QQ	DLC	GOV'T LOT	TAX LOT	ACRES
IR	05-41	38S	1W	35A	SW NE			1700	3.00

TOTAL ACRES = 3.00

District Conveyance System:

Description of Delivery System: Private pipeline and turnout

Headgate: None

Canal: West Main Canal

Beneficial Use:

Description of Beneficial Use: YARD & GARAGE

Method Used to Apply Water: Sprinkler irrigated. The water use is metered.

Method Used to Calculate Beneficial Use: Did on-site visit of the property comparing transfer map to the actual place of use.

User Interviewed: (X) Yes () No

Beneficial Use Made as Authorized: (X) Yes () No

Description of Beneficial Use if Less than Authorized:

None

Inspected By: Steven Essary

Steven Essary, Ditch Rider

Date: 8-25-11

Instructions: Attach and label the corresponding final proof map.

RECEIVED


NOV 18 2011

WATER RESOURCES DEPT
SALEM, OREGON


MAP OF WATER RIGHT TRANSFER PLACE OF USE

SW1/4NE1/4 and SE1/4NW1/4 Section 35
Township 38 South, Range 1 West
Willamette Meridian, Jackson County, OR.

For
Robert C. Bullwinkel
7469 Rapp Lane
Talent, OR. 97540
April 11, 2005

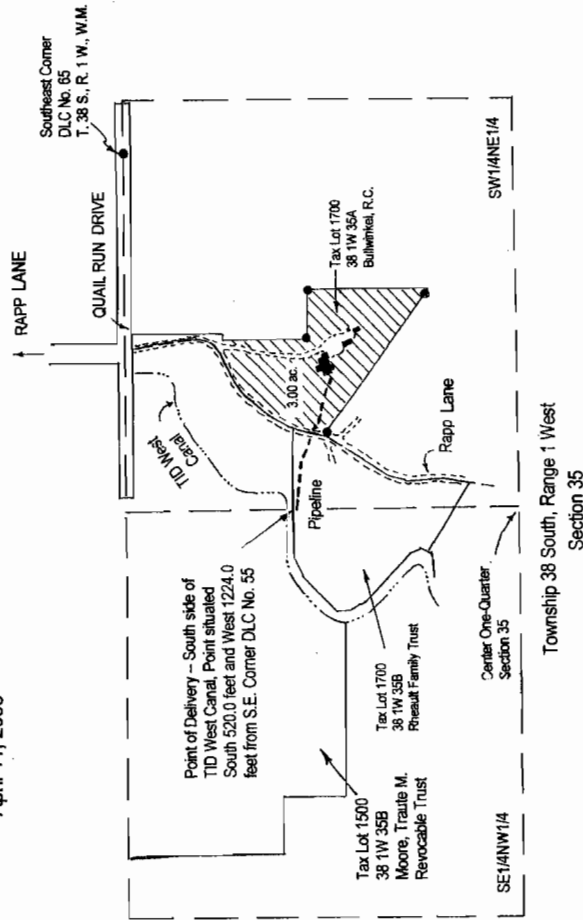

05-41
38-1W-35A
TL 1700
3.00 Acres
"To Land"
T-10739

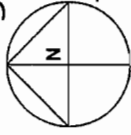

LEGEND

Scale 1" = 400'

- Denotes found survey monument

Denotes area Transfer Place of Use
To T. 38 S., R. 1 W., Sec. 35
Tax Lot 1700, 38 1W 35A
(Bullwinkel, R. C.)

RECEIVED

NOV 18 2011

WATER RESOURCES DEPT
SALEM, OREGON



This map was prepared for the purpose of identifying the location of a water right only and is not intended to provide legal dimensions or locations of property ownership lines.

CERTIFIED WATER RIGHT EXAMINER

HAROLD L. CENTER
2604 David Lane
Medford, OR. 97504
Phone 541-535-8108
Oregon Certificate No. 152
Certificate Renewal Date: 12/31/05

CLAIM OF BENEFICIAL USE

Site Report

Transfer Number: **T – 10739**

District Internal Notice #: **05-46**

User Name: Curtis and April Wine 541-482-2082

895 Neil Creek Road Ashland, OR 97520

Place of Use:

USE	POD #	TWP	RNG	SEC	QQ	DLC	GOV'T LOT	TAX LOT	ACRES
IR	05-46	39S	2E	30	SW SW			2301	.70
IR	05-46	39S	2E	30	SW SW			2900	.30

TOTAL ACRES = 1.00

District Conveyance System:

Description of Delivery System: Existing turnout and private pipelineHeadgate: None

Canal: Ashland Main Canal

Beneficial Use:

Description of Beneficial Use: Cracker

Method Used to Apply Water: Sprinkler irrigated. The water use is metered.

Method Used to Calculate Beneficial Use: Did on-site visit of the property comparing transfer map to the actual place of use.

User Interviewed: (X) Yes () No

Beneficial Use Made as Authorized: (X) Yes () No

Description of Beneficial Use if Less than Authorized:

None

Inspected By: Max Stitt

Mark Stitt, Ditch Rider

Date: 8-10-2017

Instructions: Attach and label the corresponding final proof map.


RECEIVED

APR 18 2014

Water Right Transfer
To 39-2E-30
39-2E-30-2301 & 2900 2301 .70
Curtis P. & April M. Wine 2900 .30

05-46
RECEIVED
OCT 24 2008

1.00 AC. IRRIGATION DISTRICT
Total "To Land" T-10739

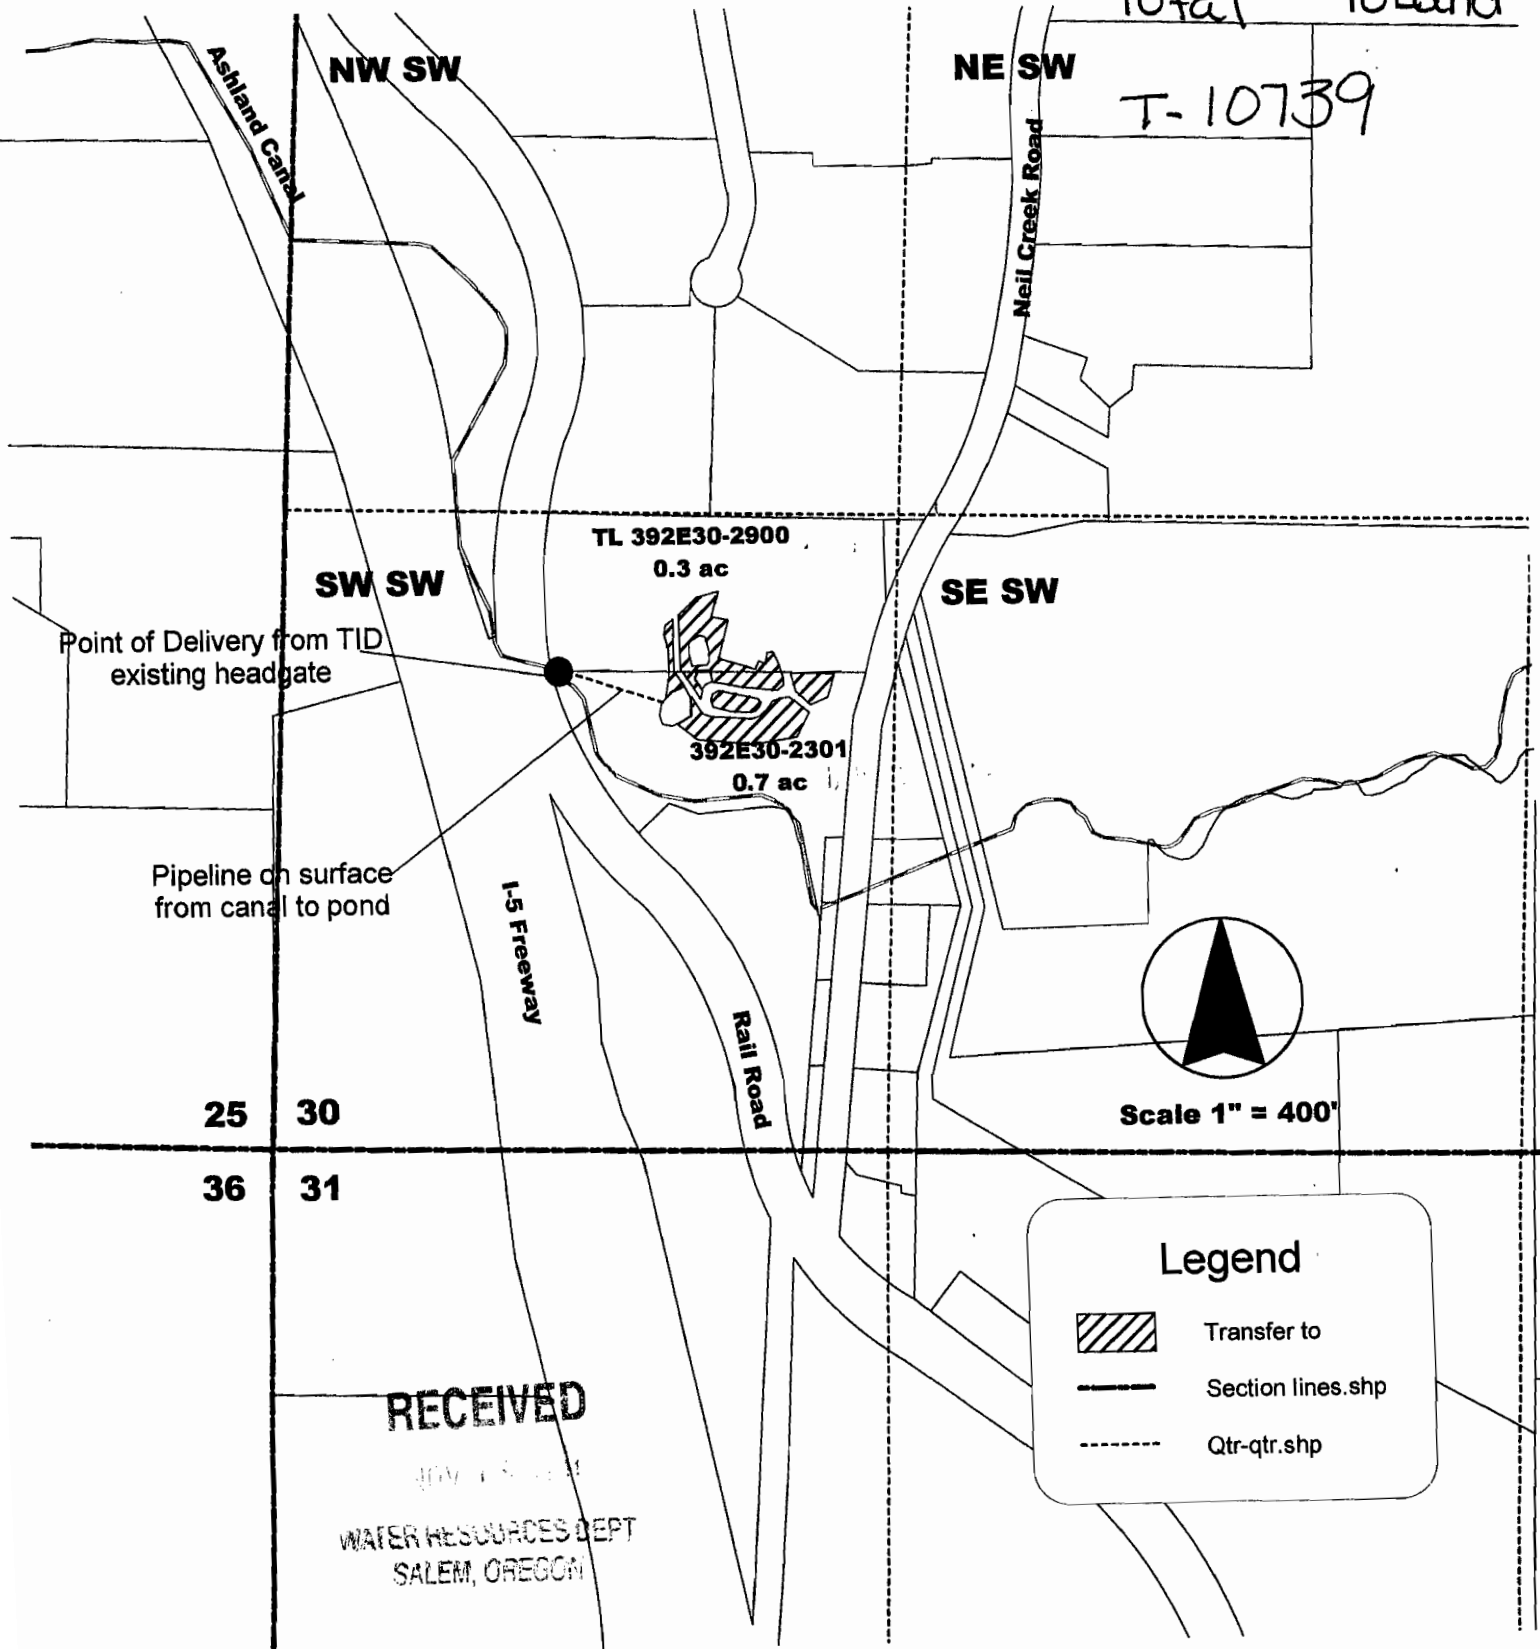

Legend

- Transfer to
- Section lines.shp
- Qtr-qtr.shp

RECEIVED
JUN 15 2008
WATER RESOURCES DEPT
SALEM, OREGON

CLAIM OF BENEFICIAL USE

Site Report

Transfer Number: T – 10739

District Internal Notice #: 06-6

User Name: Philip Paden 541-941-5363

2000 Butler Creek Road Ashland, OR 97520

Place of Use:

USE	POD #	TWP	RNG	SEC	QQ	DLC	GOV'T LOT	TAX LOT	ACRES
IR	06-6	38S	1E	21	SW NE			100	.73
IR	06-6	38S	1E	21	SE NW			100	.08
IR	06-6	38S	1E	21	NE SW			100	.08
IR	06-6	38S	1E	21	NW SE			100	1.11

TOTAL ACRES = 2.00

District Conveyance System:

Description of Delivery System: Private turnout and private pipeline

Headgate: None

Canal: East Main Canal

Beneficial Use:

Description of Beneficial Use: YARDS LAWNS

Method Used to Apply Water: Sprinkler irrigated. The water use is metered.

Method Used to Calculate Beneficial Use: Did on-site visit of the property comparing transfer map to the actual place of use.

User Interviewed: (X) Yes () No

Beneficial Use Made as Authorized: (X) Yes () No

Description of Beneficial Use if Less than Authorized:

None

Inspected By: Robert Derry
Robert Derry, Ditch Rider

Date: 8-8-11

Instructions: Attach and label the corresponding final proof map.

S:\Wanda\Word\TRANSFERS\OWRD\2011 Claim of Beneficial Use Site Reports T-10739 2008.doc

RECEIVED

NOV 18 2011

WATER RESOURCES DEPT
SALEM, OREGON

Point of Diversion and Pipeline

06-6

Phillip York Paden

Whitley to Paden Transfer

Township 38S Range 1E Section 21, W.M.

38-1E-21 100

2.00 Ac.

To Land

Philip
PYP

Tax Lot 100
538.80 acres

T.10739

SE/NW

SW/NE

Center
Section 21

0.08 ac.

0.73 ac.

0.08 ac.

1.11 ac.

NE/SW

NW/SE

21

21

22

28

28

27

RECEIVED

NOV 18 2011

WATER RESOURCES DEPT
SALEM, OREGON

East Canal

POD

Legend



Whitley to Paden, Total 2.0 acres



Quarter-Quarter Line



Section Line




Road



Pipeline



Ditches / Canals

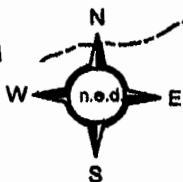

Scale 1" = 800'

1/24/2006

**CLAIM OF BENEFICIAL USE
Site Report**

Transfer Number: T - 10739

District Internal Notice #: 06-8

User Name: Robin James 541-488-2213

3640 Butler Creek Road Ashland, OR 97520

Place of Use:

USE	POD #	TWP	RNG	SEC	QQ	DLC	GOV'T LOT	TAX LOT	ACRES
IR	06-8	38S	1E	22	SE SW			200	1.10

TOTAL ACRES = 1.10

District Conveyance System:

Description of Delivery System: Private turnout and private pipeline

Headgate: None

Canal: East Main Canal

Beneficial Use:

Description of Beneficial Use: Lawn

Method Used to Apply Water: Sprinkler irrigated. The water use is metered.

Method Used to Calculate Beneficial Use: Did on-site visit of the property comparing transfer map to the actual place of use.

User Interviewed: (X) Yes () No

Beneficial Use Made as Authorized: (X) Yes () No

Description of Beneficial Use if Less than Authorized:

None

Inspected By: Robert Derry

Robert Derry, Ditch Rider

Date: 8-8-11

Instructions: Attach and label the corresponding final proof map.

RECEIVED

NOV 18 2011

Water Right Transfer
Robin James
Whitley to James

06-8
38-1E-22 200
1.10 AC.
To Land
4-10939

RECEIVED

FEB 21 2003

TALENT
IRRIGATION DISTRICT

TL-200
584.40 ac.

RECEIVED
WATER RESOURCES DEPT
SALEM, OREGON

SE/SW


SW/SW

1.1 ac.

Legend

-  Whitley to James, 1.1 ac.
-  Tax Lot 200
-  Taxlots.
-  Section lines.
-  Quarter Quarter Lines
-  Streams
-  Road
-  Pipeline

Scale 1" = 400'

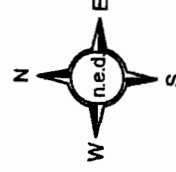

CLAIM OF BENEFICIAL USE

Site Report

Transfer Number: T - 10739

District Internal Notice #: 06-9

User Name: Scott C. Young 541-488-2213

3300 Butler Creek Road Ashland, OR 97520

Place of Use:

USE	POD #	TWP	RNG	SEC	QQ	DLC	GOV'T LOT	TAX LOT	ACRES
IR	06-9	38S	1E	22	SW SW			200	.59
IR	06-9	38S	1E	22	SE SW			200	1.83
IR	06-9	38S	1E	27	NW NW			200	1.46
IR	06-9	38S	1E	27	NE NW			200	.62
IR	06-9	38S	1E	27	NW NE			200	2.00

TOTAL ACRES = 6.50

District Conveyance System:

Description of Delivery System: Private turnout and private pipeline

Headgate: None

Canal: East Main Canal

Beneficial Use:

Description of Beneficial Use: Cowg Pond & PAS.

Method Used to Apply Water: Sprinkler irrigated. The water use is metered.

Method Used to Calculate Beneficial Use: Did on-site visit of the property comparing transfer map to the actual place of use.

User Interviewed: (X) Yes () No

Beneficial Use Made as Authorized: (X) Yes () No

Description of Beneficial Use if Less than Authorized:

None

Inspected By: Robert Derry
Robert Derry, Ditch Rider

Date: 8-8-11

RECEIVED

NOV 18 2011

WATER RESOURCES DEPT
SALEM, OREGON

Instructions: Attach and label the corresponding final proof map.

Water Right Transfer
Scott C. Young
 Whitley to Young

RECEIVED
 FEB 21 2003


Section 22 & 27
Township 38S Range 1E, W.M.

TALENT
 IRRIGATION DISTRICT

RECEIVED

NOV 18 2011


WATER RESOURCES DEPT
 SALEM, OREGON

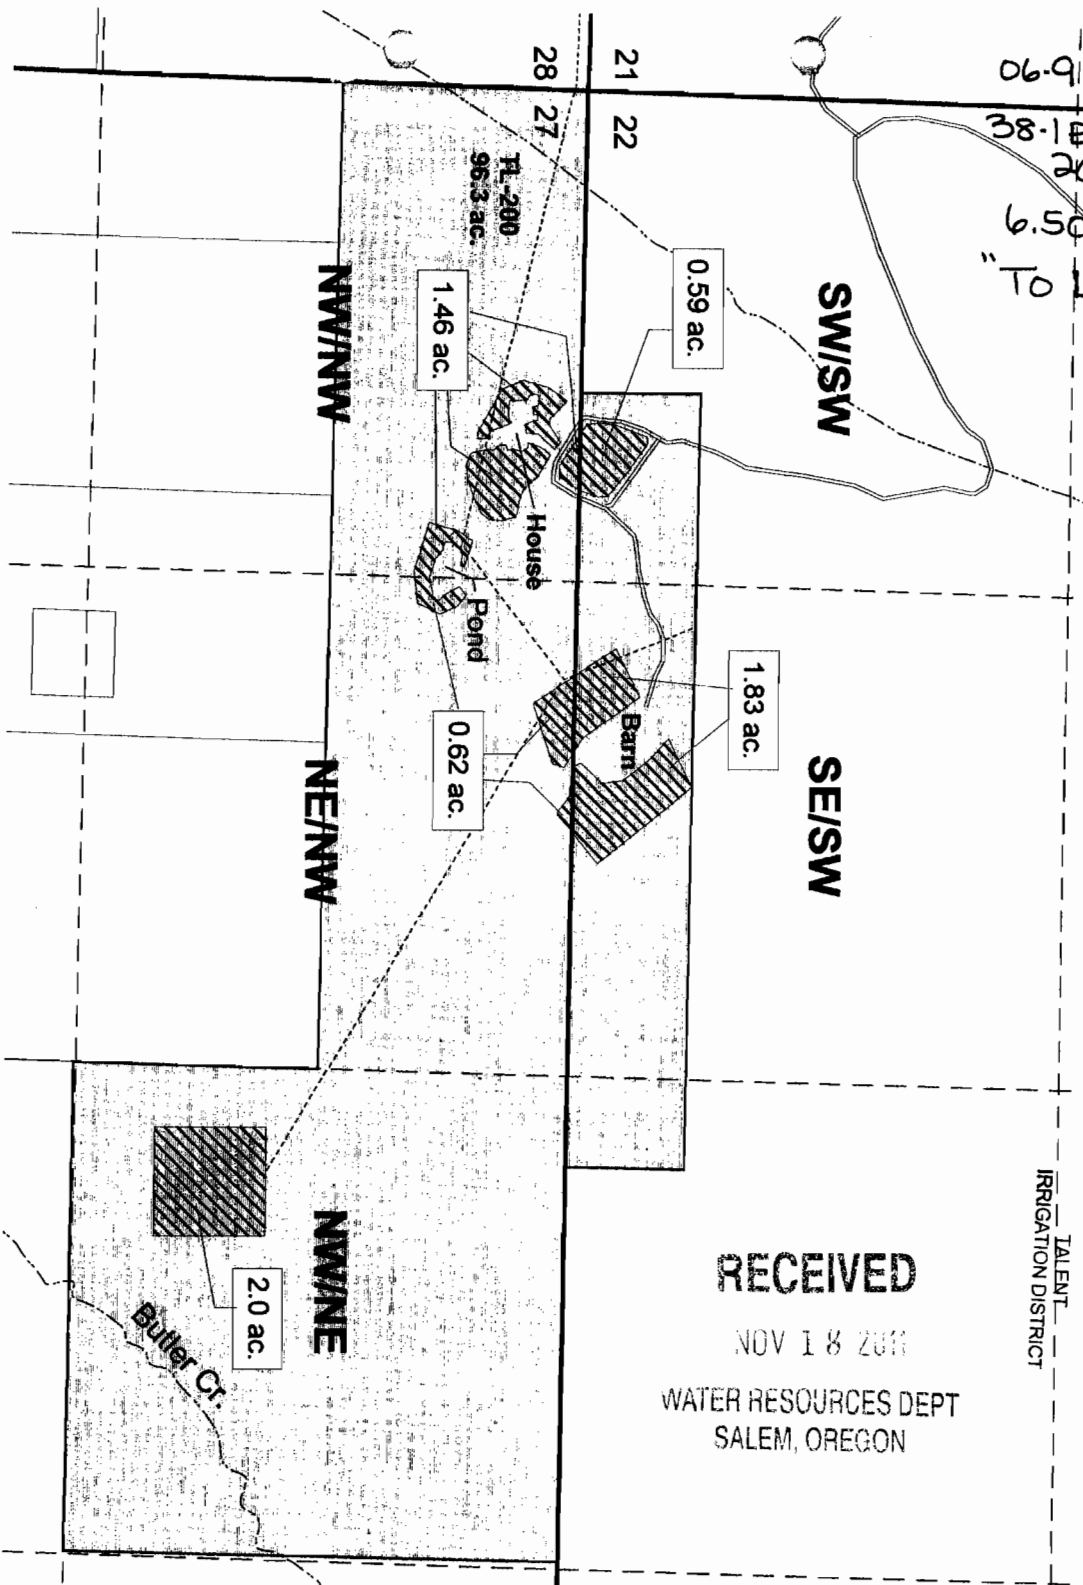

Legend

- Whitley to Young, 6.50 ac.
- Tax Lot 200
- Taxlots.
- Section lines.
- Quarter Quarter Lines
- Streams
- Road
- Pipeline

Scale 1" = 400'

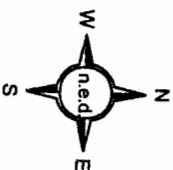


Map of Water Right Transfer
Place of Use
38-2W-02DD 2300
Jackson Co. Oregon
For
Ronald J. Ashpole
2064 Andover Way
Medford, Or. 97501

07-1
To Land
38-2W-02 DD
2300
.50 Acres
T-10739

SW1/4 SE1/4
.25 acres irrigated

SE1/4 SE1/4
.25 acres irrigated

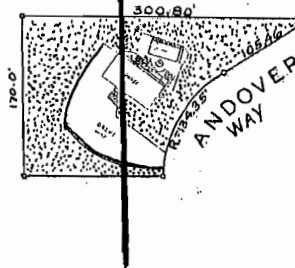

Scale: 1" = 200'
Date: Jan. 12, 2007

Legend



Denotes Place of
Irrigation Use
.5 Acres total

Property = .88 Acres

RECEIVED

JAN 16 2007

WATER RESOURCES DEPT
SALEM, OREGON

RECEIVED

JAN 18 2007

TALENT
IRRIGATION DISTRICT

**CLAIM OF BENEFICIAL USE
Site Report**

Transfer Number: T - 10739

District Internal Notice #: 07-5

User Name: Stanley Harris 541-734-9090

5295 Dark Hollow Road Medford, OR 97501

Place of Use:

USE	POD #	TWP	RNG	SEC	QQ	DLC	GOV'T LOT	TAX LOT	ACRES
IR	07-5	38S	2W	13	SE NW			2627	4.70
IR	07-5	38S	2W	13	NE SW			2627	.30

TOTAL ACRES = 5.00

District Conveyance System:

Description of Delivery System: Private pump station

Headgate: None

Canal: West Main Canal

Beneficial Use:

Description of Beneficial Use: YARD & GARDEN & HAY Field

Method Used to Apply Water: Sprinkler irrigated. The water use is metered.

Method Used to Calculate Beneficial Use: Did on-site visit of the property comparing transfer map to the actual place of use.

User Interviewed: (X) Yes () No

Beneficial Use Made as Authorized: (X) Yes () No

Description of Beneficial Use if Less than Authorized:

None

Inspected By: Steven Essary
Steven Essary, Ditch Rider


Date: 8-30-11

Instructions: Attach and label the corresponding final proof map.

RECEIVED
NOV 18 2011
WATER RESOURCES DEPT
SALEM, OREGON

Transfer from
City of Talent
to
Stanley J. Harris
T 38 S, R 2 W, Sec 13
Tax Lot 382W13-7627

07-5
To Land
38-2W-13 2627
5.00 Acres
H0739

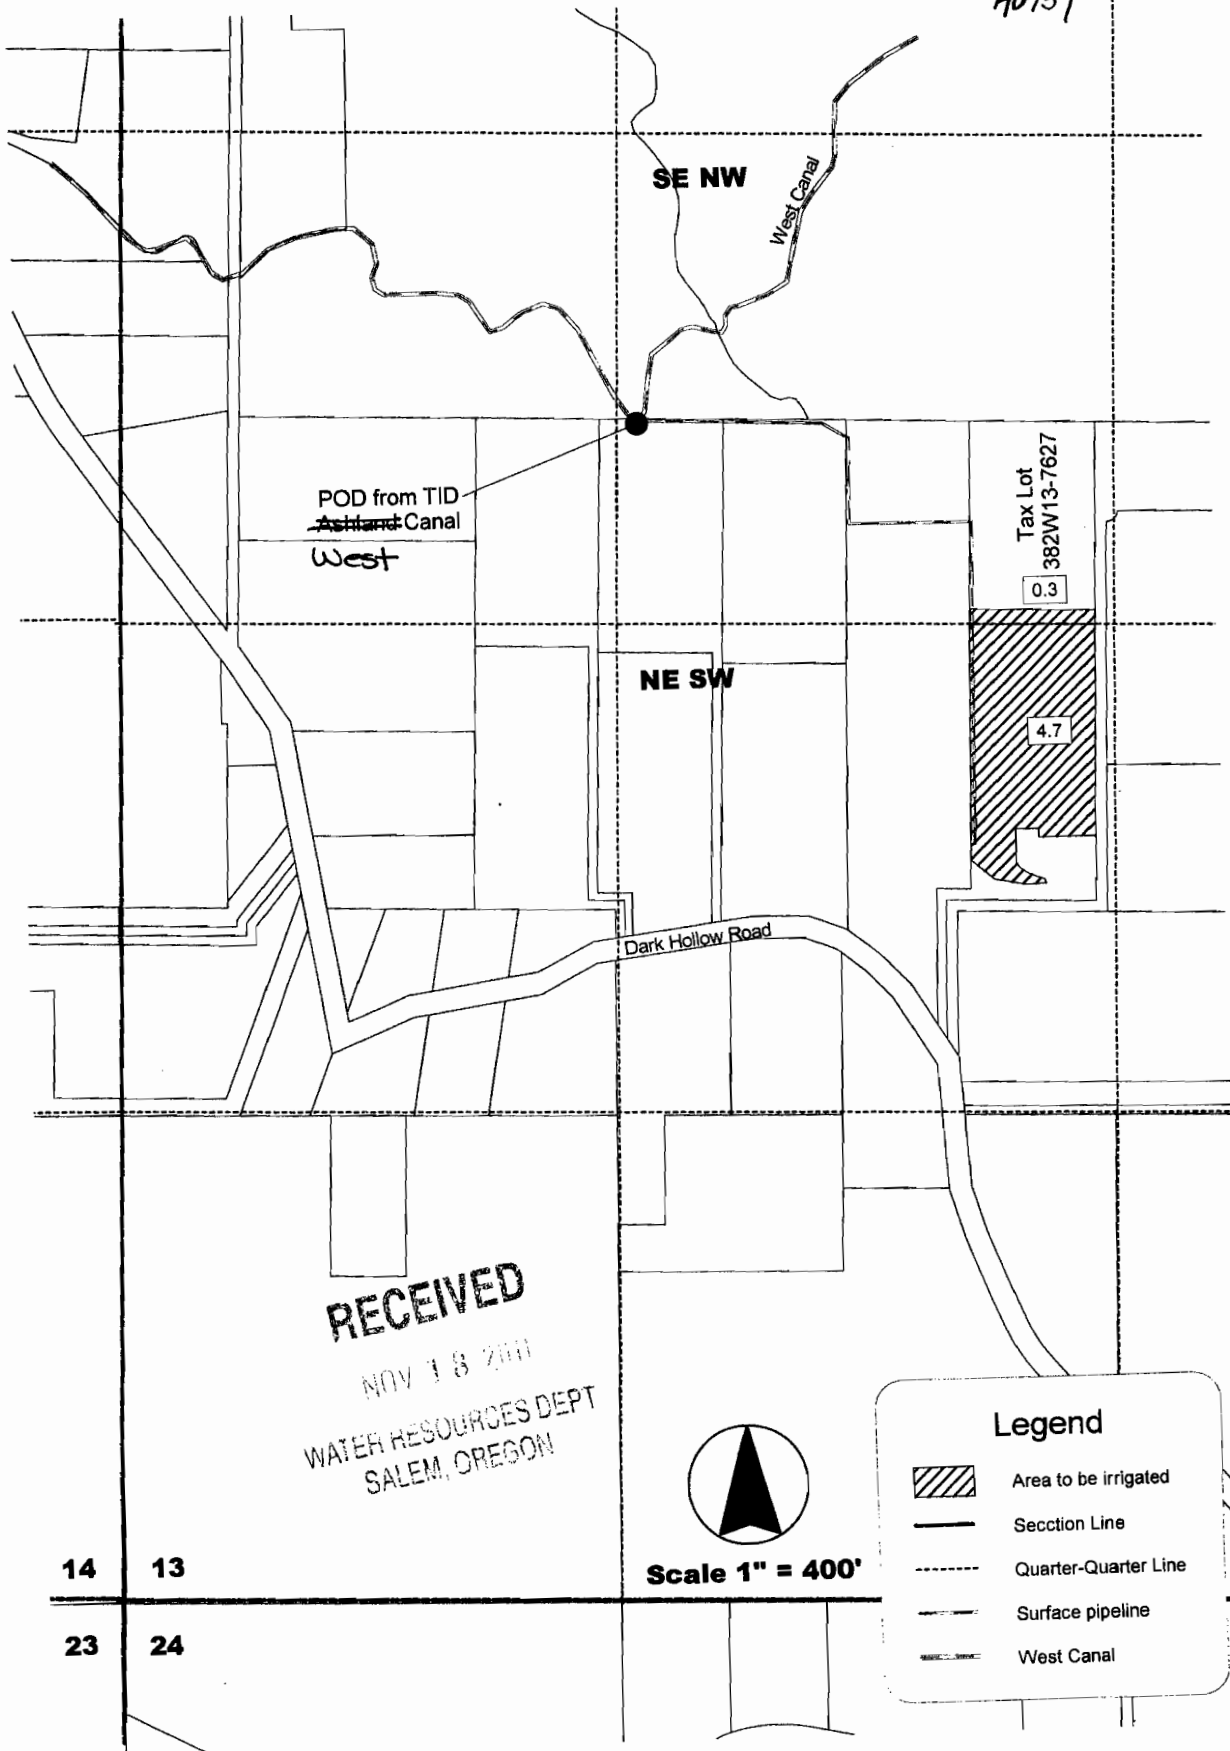

**CLAIM OF BENEFICIAL USE
Site Report**

Transfer Number: **T – 10739**

District Internal Notice #: **07-10**

User Name: Guy Tutland 541-773-9573

5201 Dark Hollow Road Medford, OR 97501

Place of Use:

USE	POD #	TWP	RNG	SEC	QQ	DLC	GOV'T LOT	TAX LOT	ACRES
IR	07-10	38S	2W	13	SE NW			2620	3.17
IR	07-10	38S	2W	13	NE SW			2620	1.83

TOTAL ACRES = 5.00

District Conveyance System:

Description of Delivery System: Private turnout and pipeline

Headgate: None

Canal: West Main Canal

Beneficial Use:

Description of Beneficial Use: HAY FIELD

Method Used to Apply Water: Sprinkler irrigated. The water use is metered.

Method Used to Calculate Beneficial Use: Did on-site visit of the property comparing transfer map to the actual place of use.

User Interviewed: (X) Yes () No

Beneficial Use Made as Authorized: (X) Yes () No

Description of Beneficial Use if Less than Authorized:

None

Inspected By: Steven Essary
Steven Essary, Ditch Rider

Date: 06-25-11

Instructions: Attach and label the corresponding final proof map.

RECEIVED
NOV 13 2011
WATER RESOURCES DEPT
SALEM, OREGON



5.0 acres water rights
to
38-2W-13-2620

RECEIVED

NOV 18 2011

WATER RESOURCES DEPT
SALEM, OREGON


- Streams & Ditches
 - Applegate, Rogue & Bear Creek
 - Major Rivers & Streams
 - Named Streams
 - Minor Streams
 - Intermittent Streams
 - Underground Streams
 - Ditches
 - Ditches - Tunnels / Siphons
 - Minor Ditch - Underground
 - Rivers & Lakes

0 100 200 Feet
1" = 200 feet



This map is based on a digital database compiled by Jackson County from a variety of sources. Jackson County cannot accept responsibility for errors, omissions or positional accuracy. There are no warranties, expressed or implied.

Print date: Apr 17, 2007; C:\GIS\PLANNING\CAPR

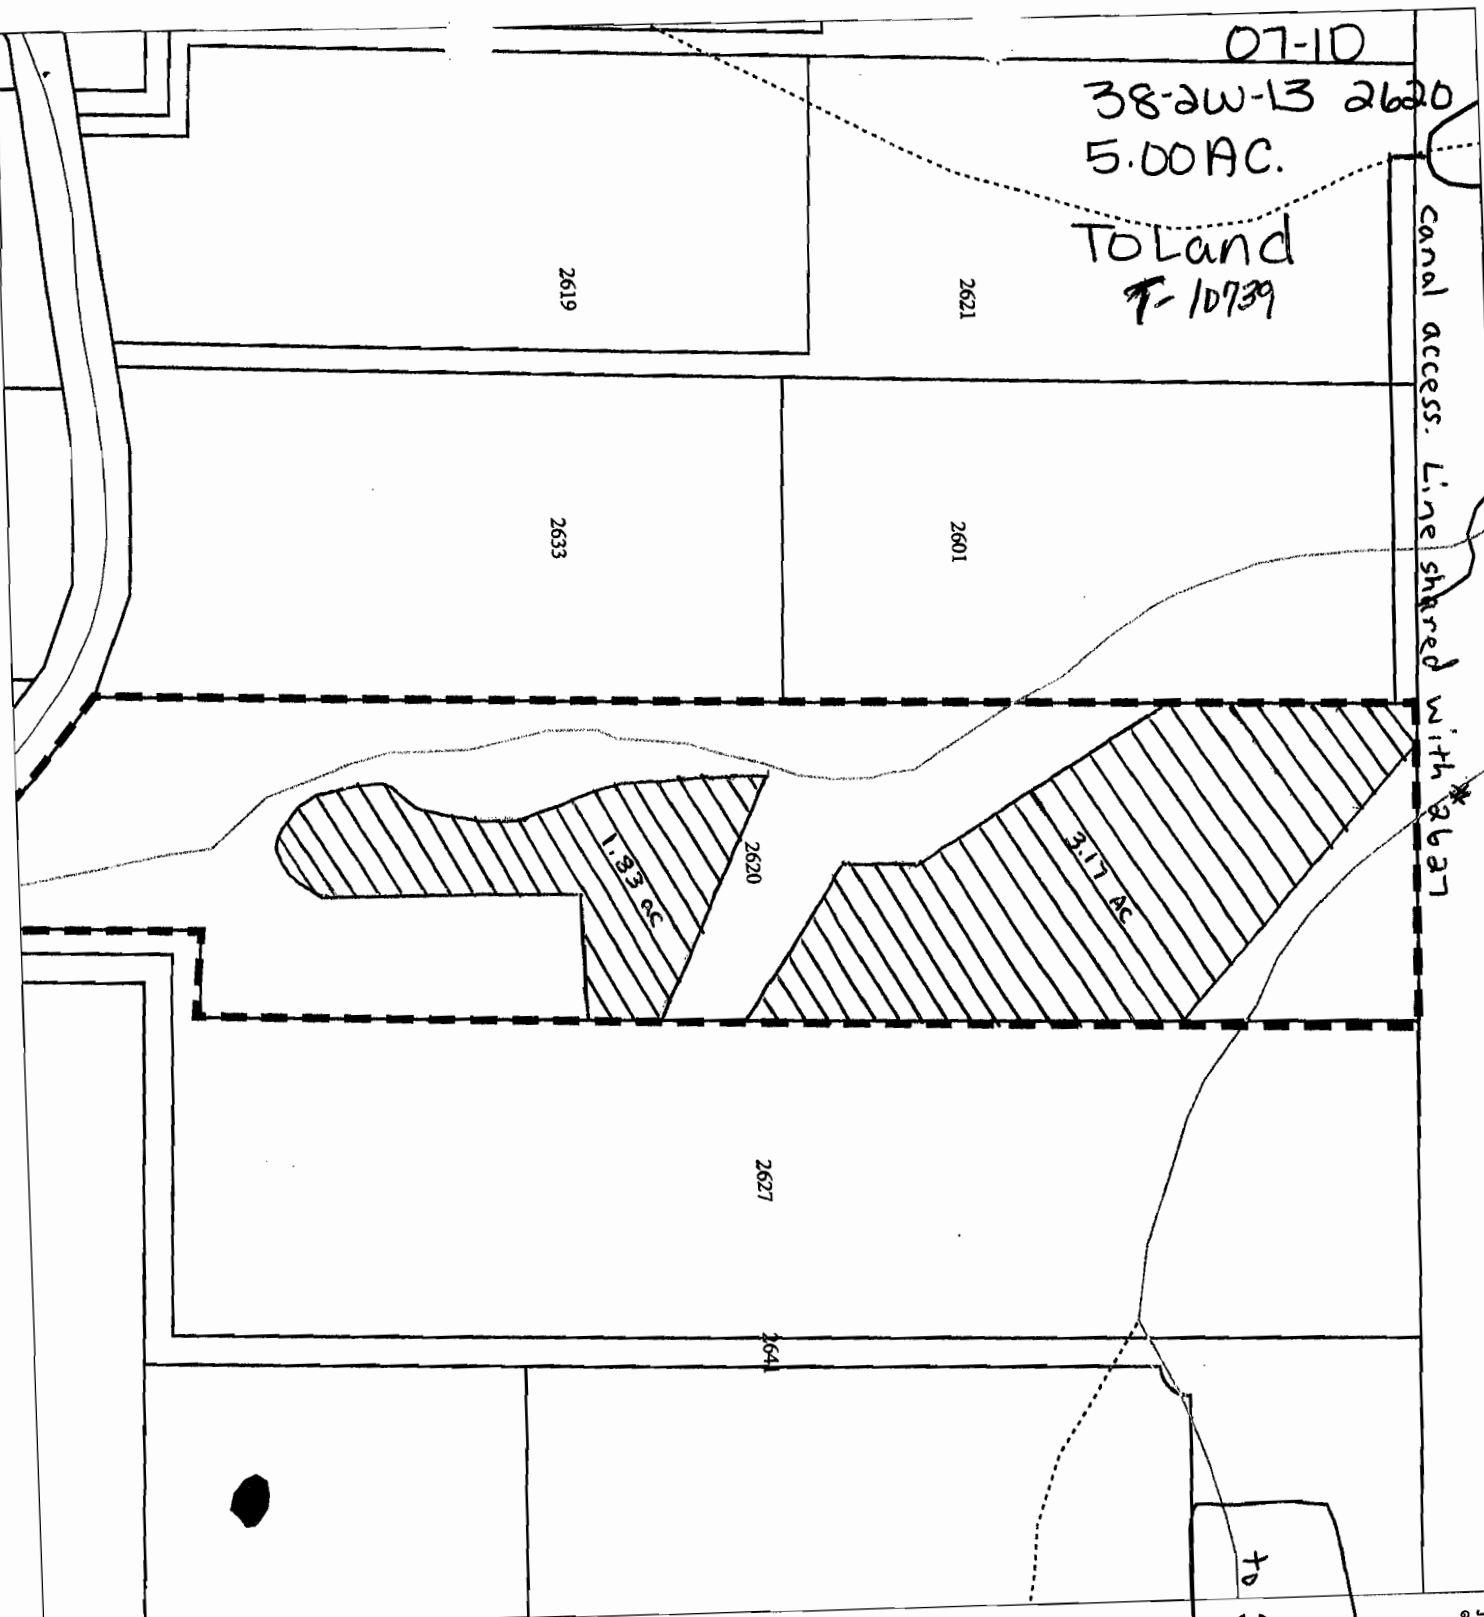

CLAIM OF BENEFICIAL USE
Site Report

Transfer Number: T - 10739

District Internal Notice #: 07-11

User Name: Val and Katie Bubb (Charlotte Quint and Steve Lerner) 541-245-6228

4745 Santa Barbara Drive Medford, OR 97504

Place of Use:

USE	POD #	TWP	RNG	SEC	QQ	DLC	GOV'T LOT	TAX LOT	ACRES
IR	07-11	37S	1W	35	SW NW			305	.30
TOTAL ACRES =									.30

District Conveyance System:

Description of Delivery System: Private turnout and pipeline

Headgate: None

Canal: East Main Canal

Beneficial Use:

Description of Beneficial Use: YARD, GARDEN

Method Used to Apply Water: Sprinkler irrigated. The water use is metered.

Method Used to Calculate Beneficial Use: Did on-site visit of the property comparing transfer map to the actual place of use.

User Interviewed: (X) Yes () No

Beneficial Use Made as Authorized: (X) Yes () No

Description of Beneficial Use if Less than Authorized:

None

Inspected By: Tracy Glenn
Tracy Glenn, Ditch Rider

Date: 8-5-11

Instructions: Attach and label the corresponding final proof map.

RECEIVED

NOV 13 2011

WATER RESOURCES DEPT
SALEM, OREGON

MAP OF WATER RIGHT TRANSFER
PLACE OF USE

07-11

SW1/4NW1/4, SEC. 35, T.37S., R.1W., W.M.

JACKSON COUNTY, OREGON

FOR

VAL A. AND KATIE F. BUBB
4745 SANTA BARBARA DRIVE
MEDFORD, OR 97504

37-1W-35
TL 305
.30 AC.

From + To
Land
T-10739




Scale: 1"=400'

Date: March 30, 2007

LEGEND

- Found Survey Monument
- Denotes Building
- Denotes Driveway
- ▨ Denotes Place of Use Remaining Right - No Change In Place Of Use
- ▧ Denotes Place of Use 'To' Transfer - Tax Lot 305
- ▩ Denotes Place of Use 'From' Transfer - Tax Lot 305

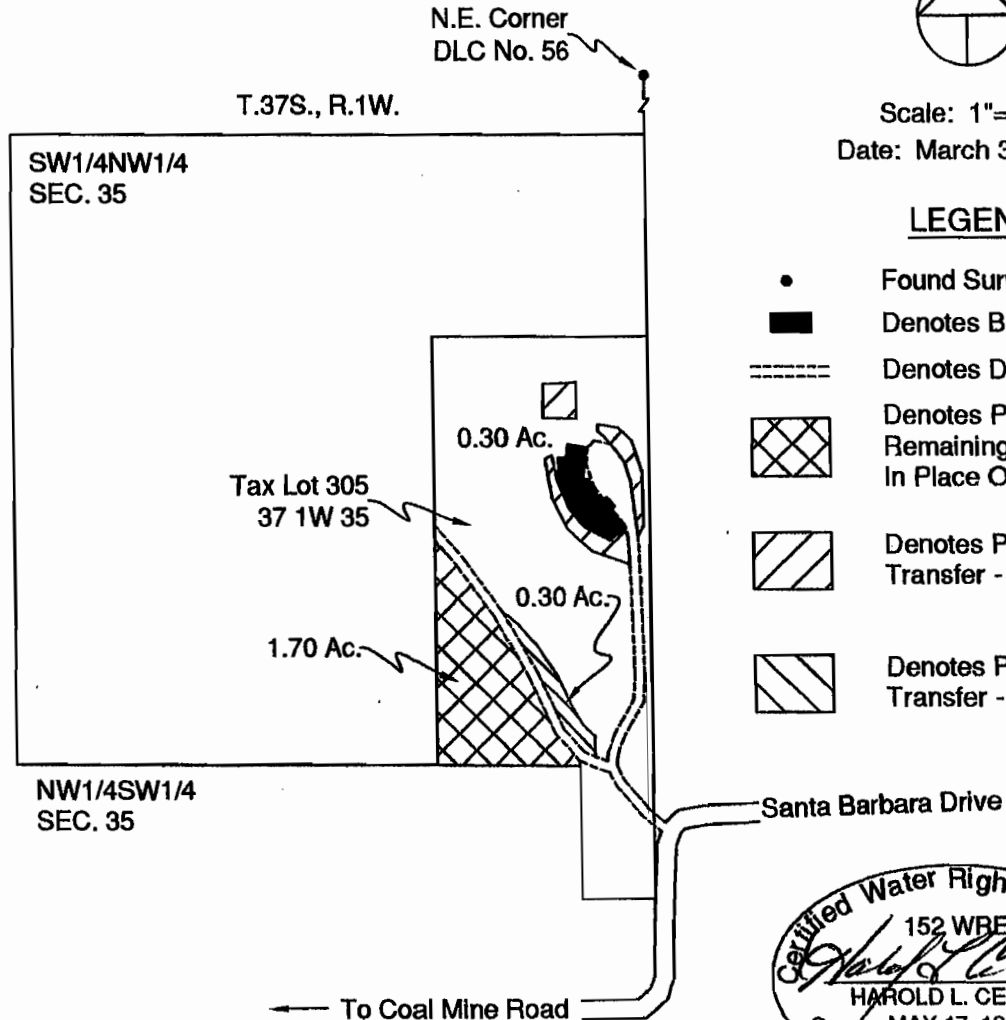

This map was prepared for the purpose of identifying the location of a water right only and is not intended to provide legal dimensions or location of property ownership.

RECEIVED

NOV 13 2007
WATER RESOURCES DEPT
SALEM, OREGON

HAROLD L. CENTER
2604 David Lane
Medford, OR. 97504
Phone 541-535-6108
Oregon Certificate No. 152
Certificate Renewal Date: 12/31/2007

RECEIVED

APR 19 2007

TALENT
IRRIGATION DISTRICT

**CLAIM OF BENEFICIAL USE
Site Report**

Transfer Number: T - 10739

District Internal Notice #: 07-12

User Name: Gary and Linda Hall

541-944-6341

2391 Terri Drive

Medford, OR 97504

Place of Use:

USE	POD #	TWP	RNG	SEC	QQ	DLC	GOV'T LOT	TAX LOT	ACRES
IR	07-12	37S	1W	36	SE SW			500	3.29

TOTAL ACRES = 3.29

District Conveyance System:

Description of Delivery System: Private turnout/pump station and private pipeline

Headgate: None

Canal: East Main Canal

Beneficial Use:

Description of Beneficial Use: PASTURE

Method Used to Apply Water: Sprinkler irrigated. The water use is metered.

Method Used to Calculate Beneficial Use: Did on-site visit of the property comparing transfer map to the actual place of use.

User Interviewed: (X) Yes () No

Beneficial Use Made as Authorized: (X) Yes () No

Description of Beneficial Use if Less than Authorized:

None

Inspected By: Tracy Glenn

Tracy Glenn, Ditch Rider

Date: 8-8-11

Instructions: Attach and label the corresponding final proof map.

RECEIVED

NOV 18 2011


WATER RESOURCES DEPT
SALEM, OREGON

MAP OF WATER RIGHT TRANSFER
PLACE OF USE
SW1/4, SEC. 36, T.37S., R.1W., W.M.
JACKSON COUNTY, OREGON

FOR
GARY AND LINDA HALL
2391 TERRI DRIVE
MEDFORD, OR 97504


07-12
37.1W-36 500
3.29 Ac.

Toland
7-10739

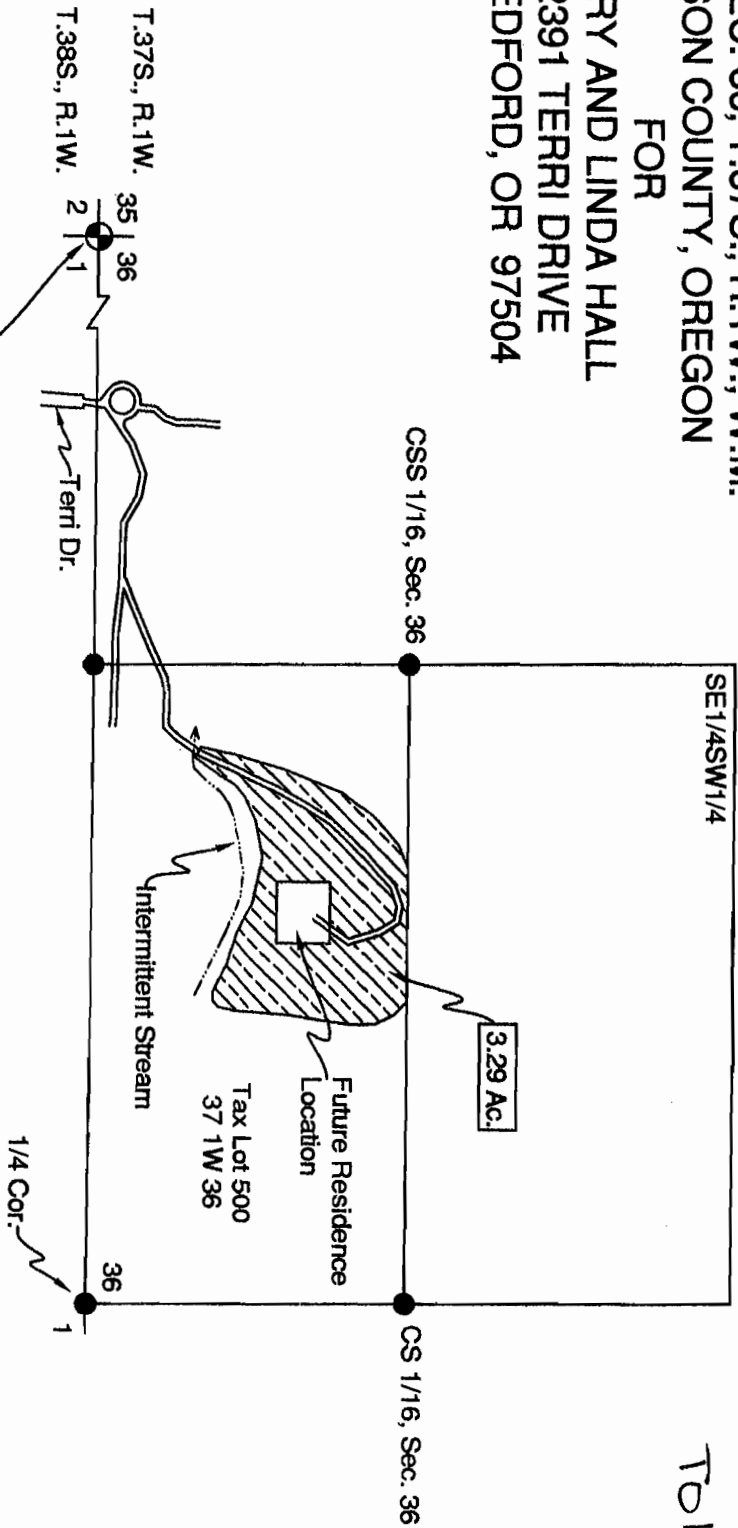


Note: Point of Delivery - Irrigation pump site is situated 2985' South and 188' East from section corner.

Scale: 1"=400'
Date: May 26, 2007

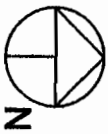

LEGEND

- Found Survey Monument
- Denotes Approved Home Site
- Denotes Future Residence
- ▬ Denotes Driveway
- ▨ Denotes Place of Use to Tax Lot 500, 37 1W 36, From Tax Lot 1000, 38 1W 23A

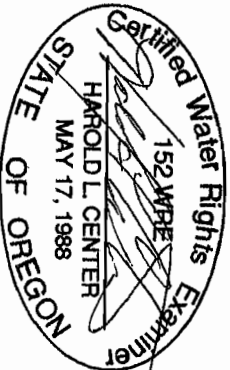

HAROLD L. CENTER
2604 David Lane
Medford, OR. 97504
Phone 541-535-6108
Oregon Certificate No. 152
Certificate Renewal Date: 12/31/2007

RECEIVED
NOV 18 2011
WATER RESOURCES DEPT
SALEM, OREGON

**CLAIM OF BENEFICIAL USE
Site Report**

Transfer Number: T – 10739

District Internal Notice #: 07-13

User Name: Breckel Family Trust 541-944-5368

2399 Terri Drive Medford, OR 97504

Place of Use:

USE	POD #	TWP	RNG	SEC	QQ	DLC	GOV'T LOT	TAX LOT	ACRES
IR	07-13	37S	1W	36	SW SW			501	.40
IR	07-13	37S	1W	36	SW SW			501	.20
IR	07-13	37S	1W	36	SW SW			501	1.07
IR	07-13	37S	1W	36	SW SW			501	8.33

TOTAL ACRES = 10.00

District Conveyance System:

Description of Delivery System: Private turnout/pump station and private pipeline

Headgate: None

Canal: East Main Canal

Beneficial Use:

Description of Beneficial Use: PASTURE

Method Used to Apply Water: Sprinkler irrigated. The water use is metered.

Method Used to Calculate Beneficial Use: Did on-site visit of the property comparing transfer map to the actual place of use.

User Interviewed: (X) Yes () No

Beneficial Use Made as Authorized: (X) Yes () No

Description of Beneficial Use if Less than Authorized:

None

Inspected By: Tracy Glenn
Tracy Glenn, Ditch Rider

Date: 8-8-11


Instructions: Attach and label the corresponding final proof map.

07-13
37-1W-36 501
TO Land
10.00 AC.
T-10739

MAP OF WATER RIGHT TRANSFER
PLACE OF USE
SW1/4SW1/4, SEC. 36, T.37S., R.1W., W.M.
JACKSON COUNTY, OREGON

FOR
BRECKEL FAMILY TRUST
DARELL L. BRECKEL AND CHRISTINE L. BRECKEL, TRUSTEES
2399 TERRI DRIVE
MEDFORD, OR 97504

Scale: 1"=400'
Date: April 23, 2007

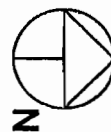

LEGEND

- Found Survey Monument
- Denotes Building
- ▬ Denotes Driveway


▨ Denotes Place of Use to Tax
Lot 501, 37 1W 36, From Tax
Lots 2401, 2402, 2403 and
2404, 38 1W 25CA Boermans + Harney

▩ Denotes Place of Use to Tax
Lot 501, 37 1W 36, From Tax
Lot 301, 38 1W 23D City of Talent


▧ Denotes Place of Use to Tax
Lot 501, 37 1W 36, From Lithia
Way and Pedestrian Access,
38 1W 25CA City of Talent

▦ Denotes Place of Use to Tax
Lot 501, 37 1W 36, From Tax
Lot 200, 38 1W 23A Lane
1000

▤ Denotes Place of Use to Tax
Lot 501, 37 1W 36, From Tax
Lot 200, 38 1W 24C Lane

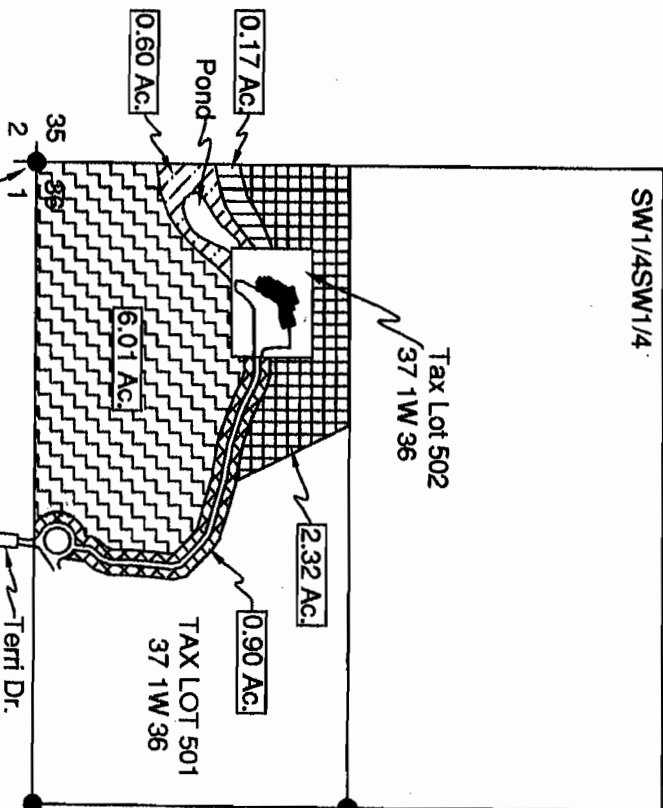

This map was prepared for the purpose of identifying the location of a water right only and is not intended to provide legal dimensions or location of property ownership.

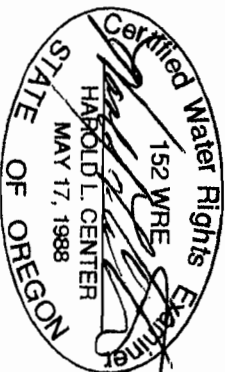

HAROLD L. CENTER
2604 David Lane
Medford, OR. 97504
Phone 541-535-6108
Oregon Certificate No. 152
Certificate Renewal Date: 12/31/2007

RECEIVED
MAY 18 2007
WATER RESOURCES DEPT
SALEM, OREGON

CLAIM OF BENEFICIAL USE

Site Report

Transfer Number: T - 10739

District Internal Notice #: **07-15**

User Name: Steve and Patricia Schein 541-944-0526

2208 Lupine Drive Ashland, OR 97504

Place of Use:

USE	POD #	TWP	RNG	SEC	QQ	DLC	GOV'T LOT	TAX LOT	ACRES
IR	07-15	39S	1E	23	SW NW			1400	1.00
TOTAL ACRES =									1.00

District Conveyance System:

Description of Delivery System: Private turnout/pump station and private pipelineHeadgate: NoneCanal: Ashland Main Canal

Beneficial Use:


Method Used to Apply Water: Sprinkler irrigated. The water use is metered.

Method Used to Calculate Beneficial Use: Did on-site visit of the property comparing transfer map to the actual place of use.

User Interviewed: (X) Yes () No

Beneficial Use Made as Authorized: (X) Yes () No

Description of Beneficial Use if Less than Authorized:

None

Inspected By: [Signature]

Mark Stitt, Ditch Rider

Date: 7-21-2011

Instructions: Attach and label the corresponding final proof map.

RECEIVED


NEW 18 Zettl

WATER RESOURCES DEPT
SALEM, OREGON

Water Right Transfer
To

Steven A. Schein & Patricia A. Schein Trustees
T39S, R1E, Section 23, W.M.
Tax lot 391E23-1400

07-15
391E-23
1400
1.00 AC
To Land
T-10739

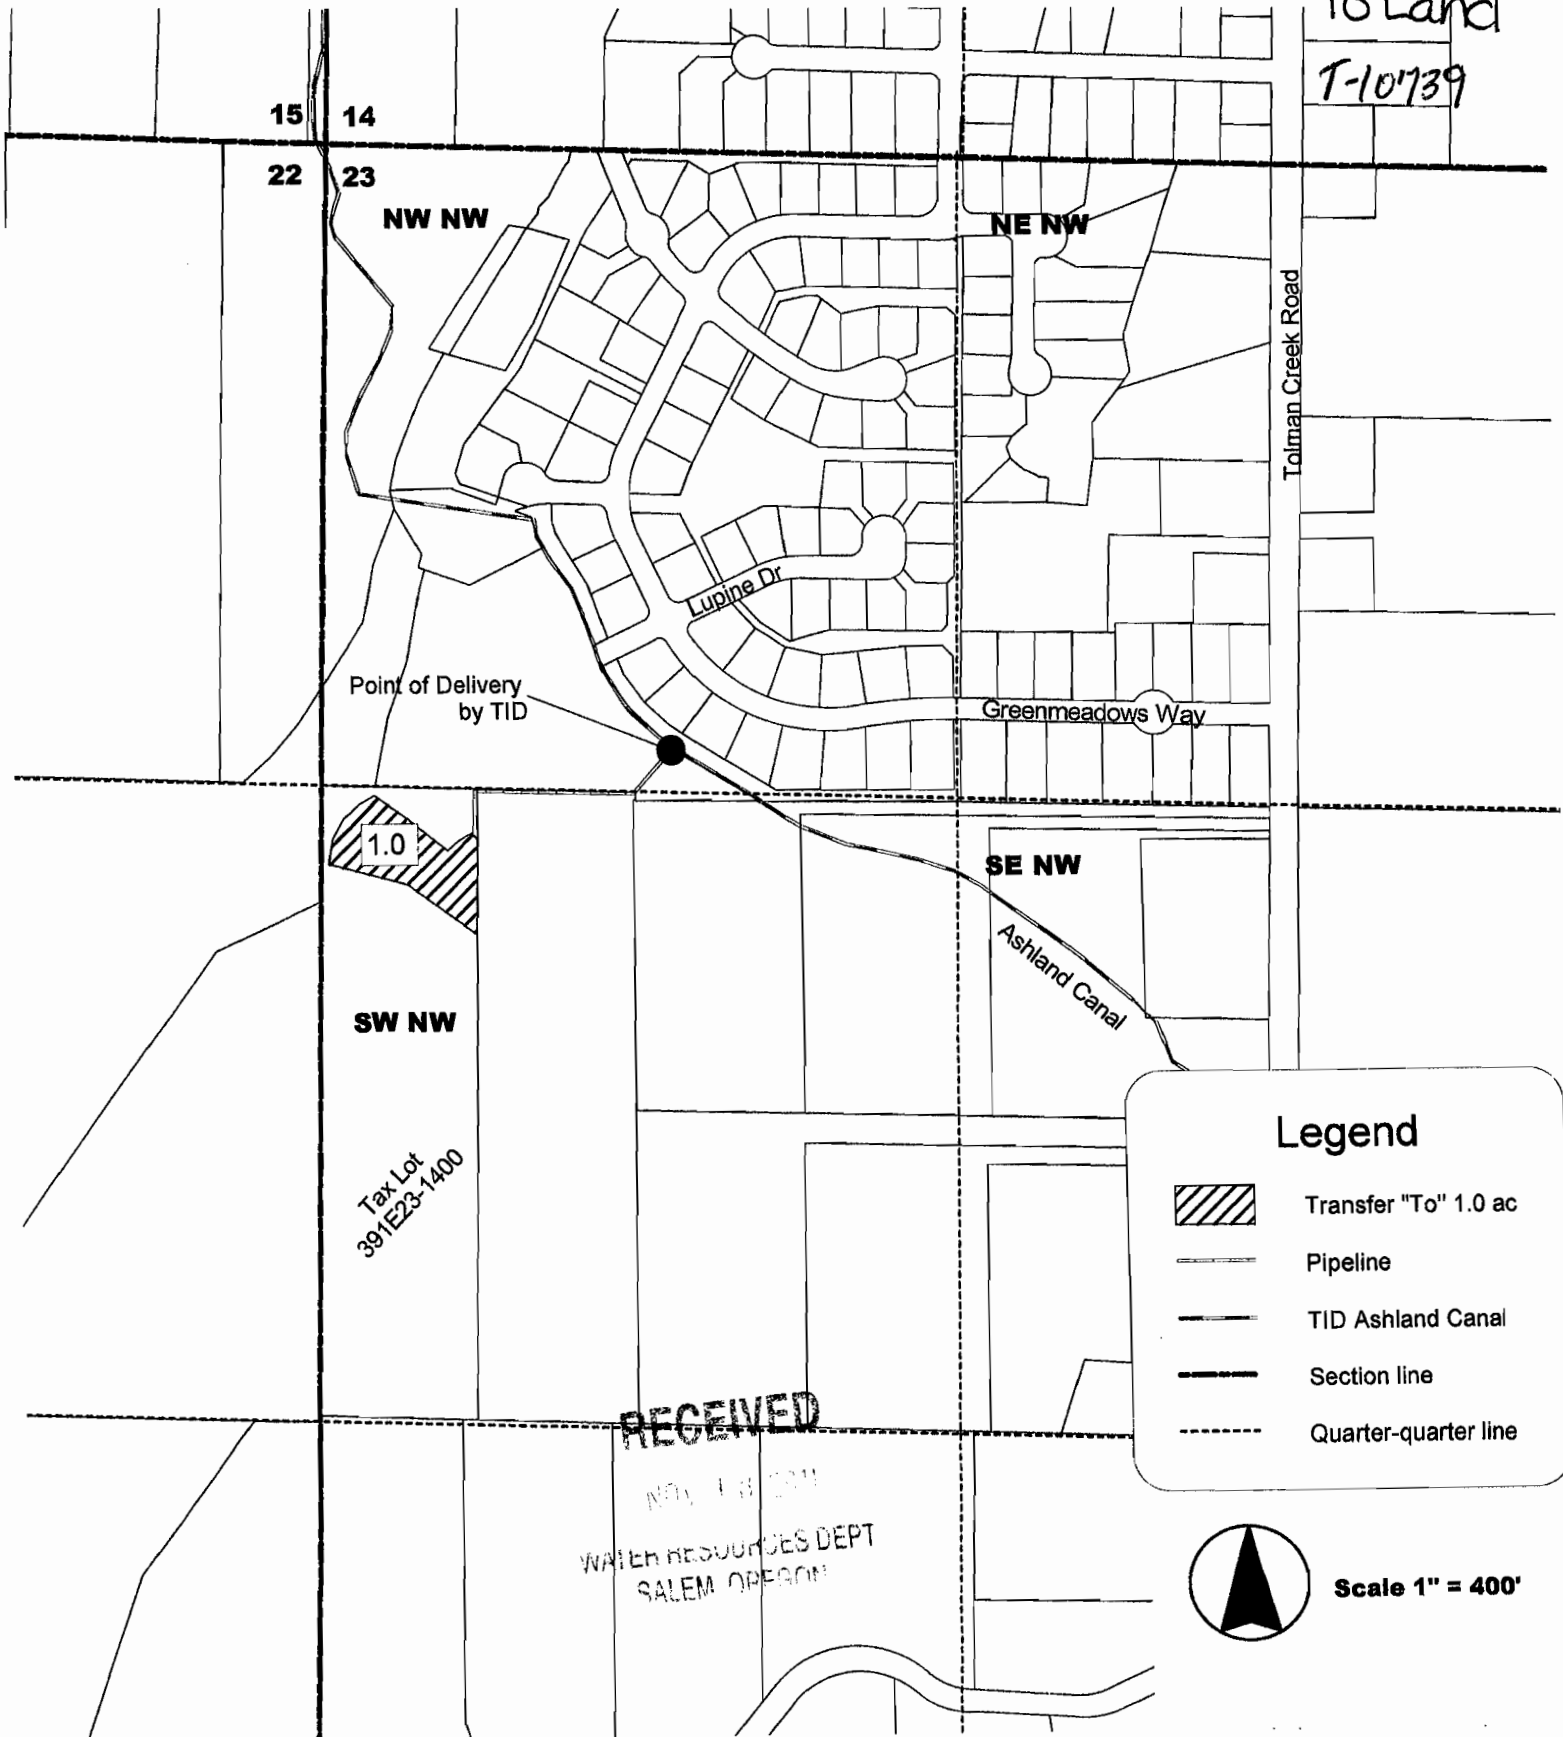

CLAIM OF BENEFICIAL USE
Site Report

Transfer Number: T - 10739

District Internal Notice #: 07-17

User Name: Floyd and Marilyn Pawlowski 541-821-2103

415 Pompadour Drive Ashland, OR 97520

Place of Use:

USE	POD #	TWP	RNG	SEC	QQ	DLC	GOV'T LOT	TAX LOT	ACRES
IR	07-17	39S	1E	02	NW NE			210	1.80
IR	07-17	39S	1E	02	NW NE			210	2.20

TOTAL ACRES = 4.00

District Conveyance System:

Description of Delivery System: Private turnout/pump station and private pipeline in the Pompadour Water Improvement District

Headgate: None

Canal: East Main Canal

Beneficial Use:

Description of Beneficial Use: YARD

Method Used to Apply Water: Sprinkler and drip irrigated. The water use is metered.

Method Used to Calculate Beneficial Use: Did on-site visit of the property comparing transfer map to the actual place of use.

User Interviewed: (X) Yes () No

Beneficial Use Made as Authorized: (X) Yes () No

Description of Beneficial Use if Less than Authorized:

None

Inspected By: Robert Derry
Robert Derry, Ditch Rider

Date: 8-9-11

Instructions: Attach and label the corresponding final proof map.

S:\Wanda\Word\TRANSFERS\OWRD\2011 Claim of Beneficial Use Site Reports T-10739 2008.doc

RECEIVED

NOV 18 2011

WATER RESOURCES DEPT
SALEM OREGON

39-1E-02 210

4.00 AC. 35 36


TO Land 2 1
Out of Bound
T-10739

Water Right Transfer
To

T 39 S, R 1 E, Sec 02
TL 391E02-210

Floyd Jr. & Marilyn Pawlowski

1 inch equals 400 feet

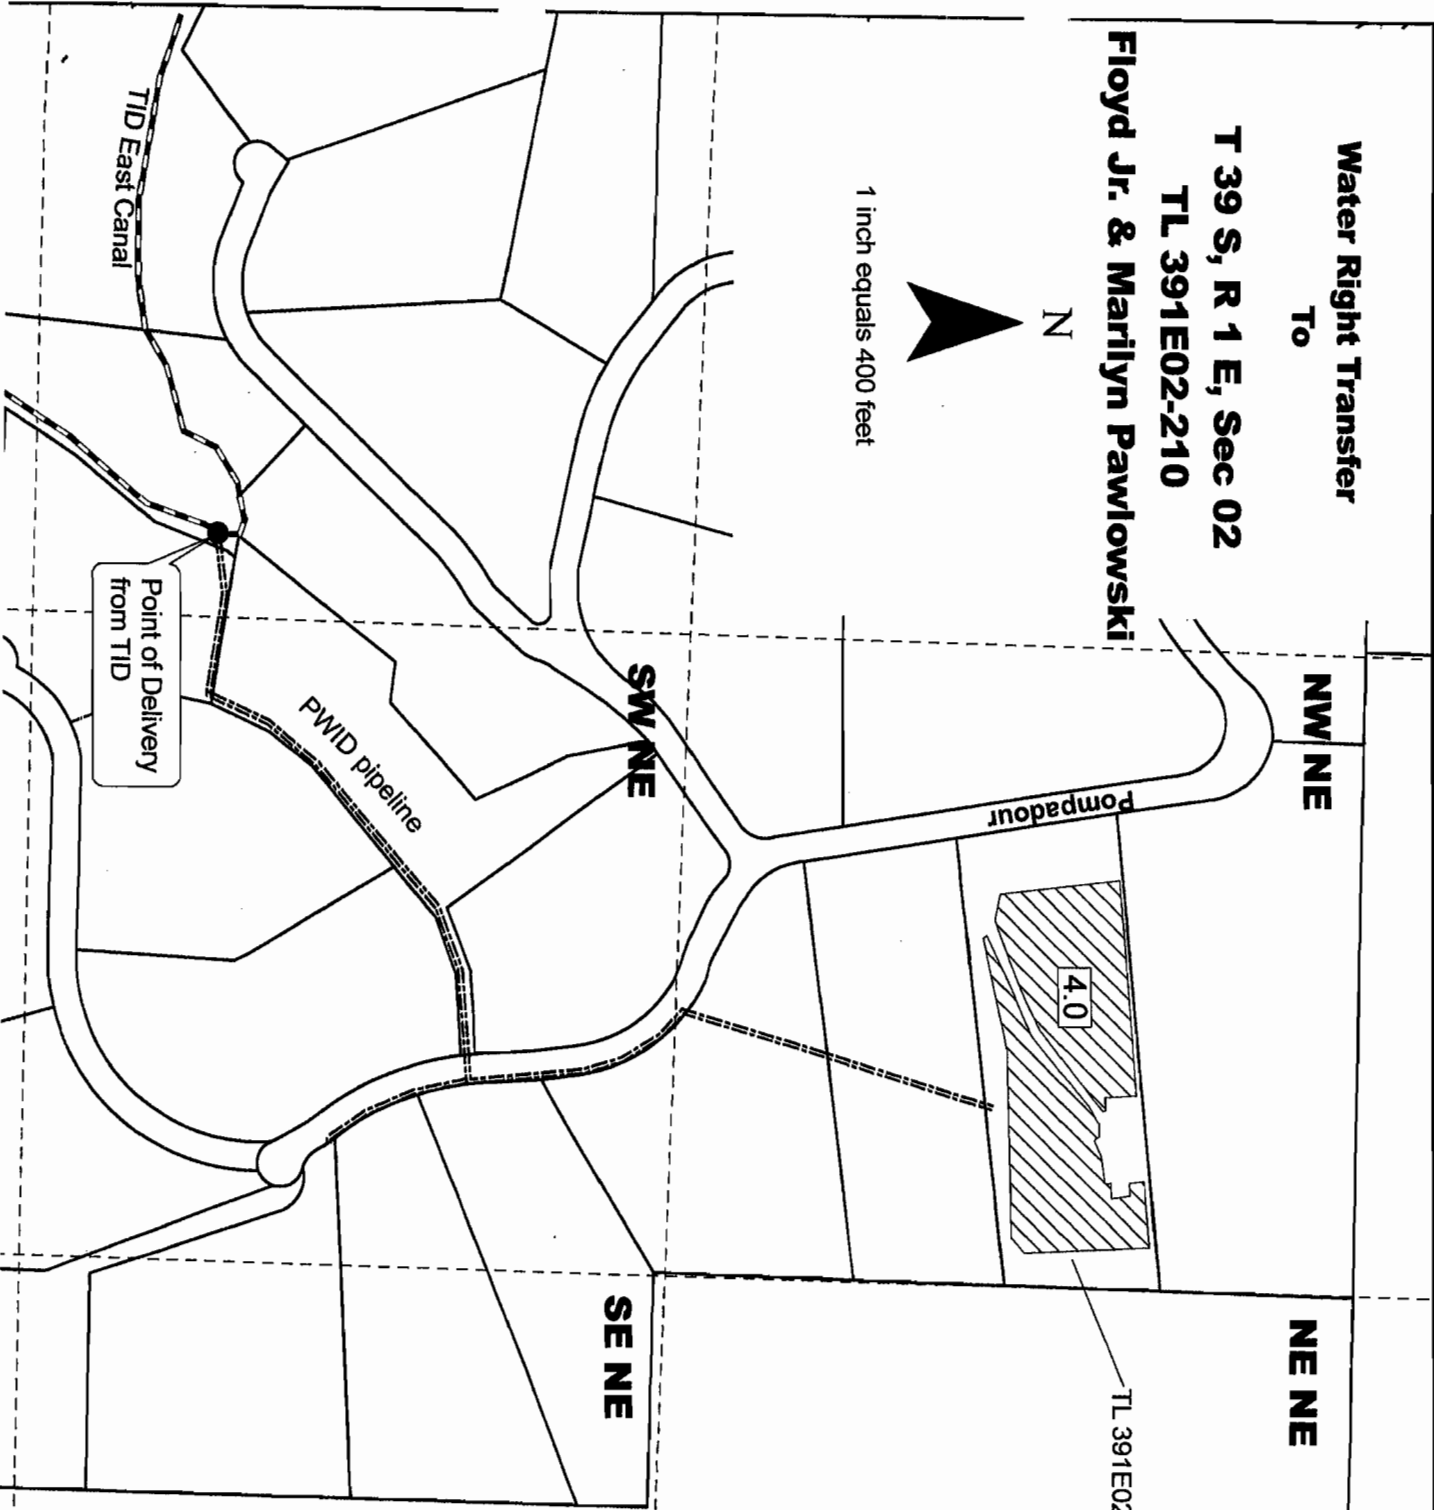

RECEIVED

WATER RESOURCES DEPT
SALEM OREGON

Note: This property is in the Pompadour Water Improvement District and will receive delivery from PWID at the property line.

Legend

-  Area to be irrigated
-  PWID pipeline
-  Section Line
-  Quarter-quarter Line

WATER RESOURCES DEPT
SALEM, OREGON

07-18

Water Right Transfer
To

T 39 S, R 1 E, Sec 02
TL 391E02-211
William Clay Colley

N



1 inch equals 400 feet

36

35

NE NE

39-1E-02 2 1

TL 211

2.00 Acres

TO Land

out of boundary

7-10739

Pompadour

TL 391E02-211

2.0

SW NE

SE NE

Note: This property is in the Pompadour Water Improvement District and will receive delivery from PWID at the property line.

Legend

Area to be irrigated

PWID pipeline

Section Line

Quarter-quarter Line

Point of Delivery
from TID

TID East Canal

RECEIVED

WATER RESOURCES DEPT
SALEM, OREGON

**CLAIM OF BENEFICIAL USE
Site Report**

Transfer Number: T – 10739

District Internal Notice #: 07-19

User Name: Joseph and Joyce Craten 410-592-3082

605 Pompadour Drive Ashland, OR 97520

Place of Use:

USE	POD #	TWP	RNG	SEC	QQ	DLC	GOV'T LOT	TAX LOT	ACRES
IR	07-19	39S	1E	02	SW NE			213	2.30
IR	07-19	39S	1E	02	SE NE			213	1.70

TOTAL ACRES = 4.00

District Conveyance System:

Description of Delivery System: Private turnout/pump station and private pipeline in the
Pompadour Water Improvement District

Headgate: None

Canal: East Main Canal

Beneficial Use:

Description of Beneficial Use: YARD GARDEN

Method Used to Apply Water: Sprinkler and drip irrigated. The water use is metered.

Method Used to Calculate Beneficial Use: Did on-site visit of the property comparing transfer
map to the actual place of use.

User Interviewed: (X) Yes () No

Beneficial Use Made as Authorized: (X) Yes () No

Description of Beneficial Use if Less than Authorized:

None

Inspected By: Robert Derry
Robert Derry, Ditch Rider

Date: 8-9-11

Instructions: Attach and label the corresponding final proof map.

S:\Wanda\Word\TRANSFERS\OWRD\2011 Claim of Beneficial Use Site Reports T-10739 2008.doc

RECEIVED

NOV 18 2011

WATER RESOURCES DEPT
SALEM OREGON


07-19

Water Right Transfer
To

T 39 S, R 1 E, Sec 02
TL 391E02-213
Joseph & Joyce Craten



1 inch equals 400 feet

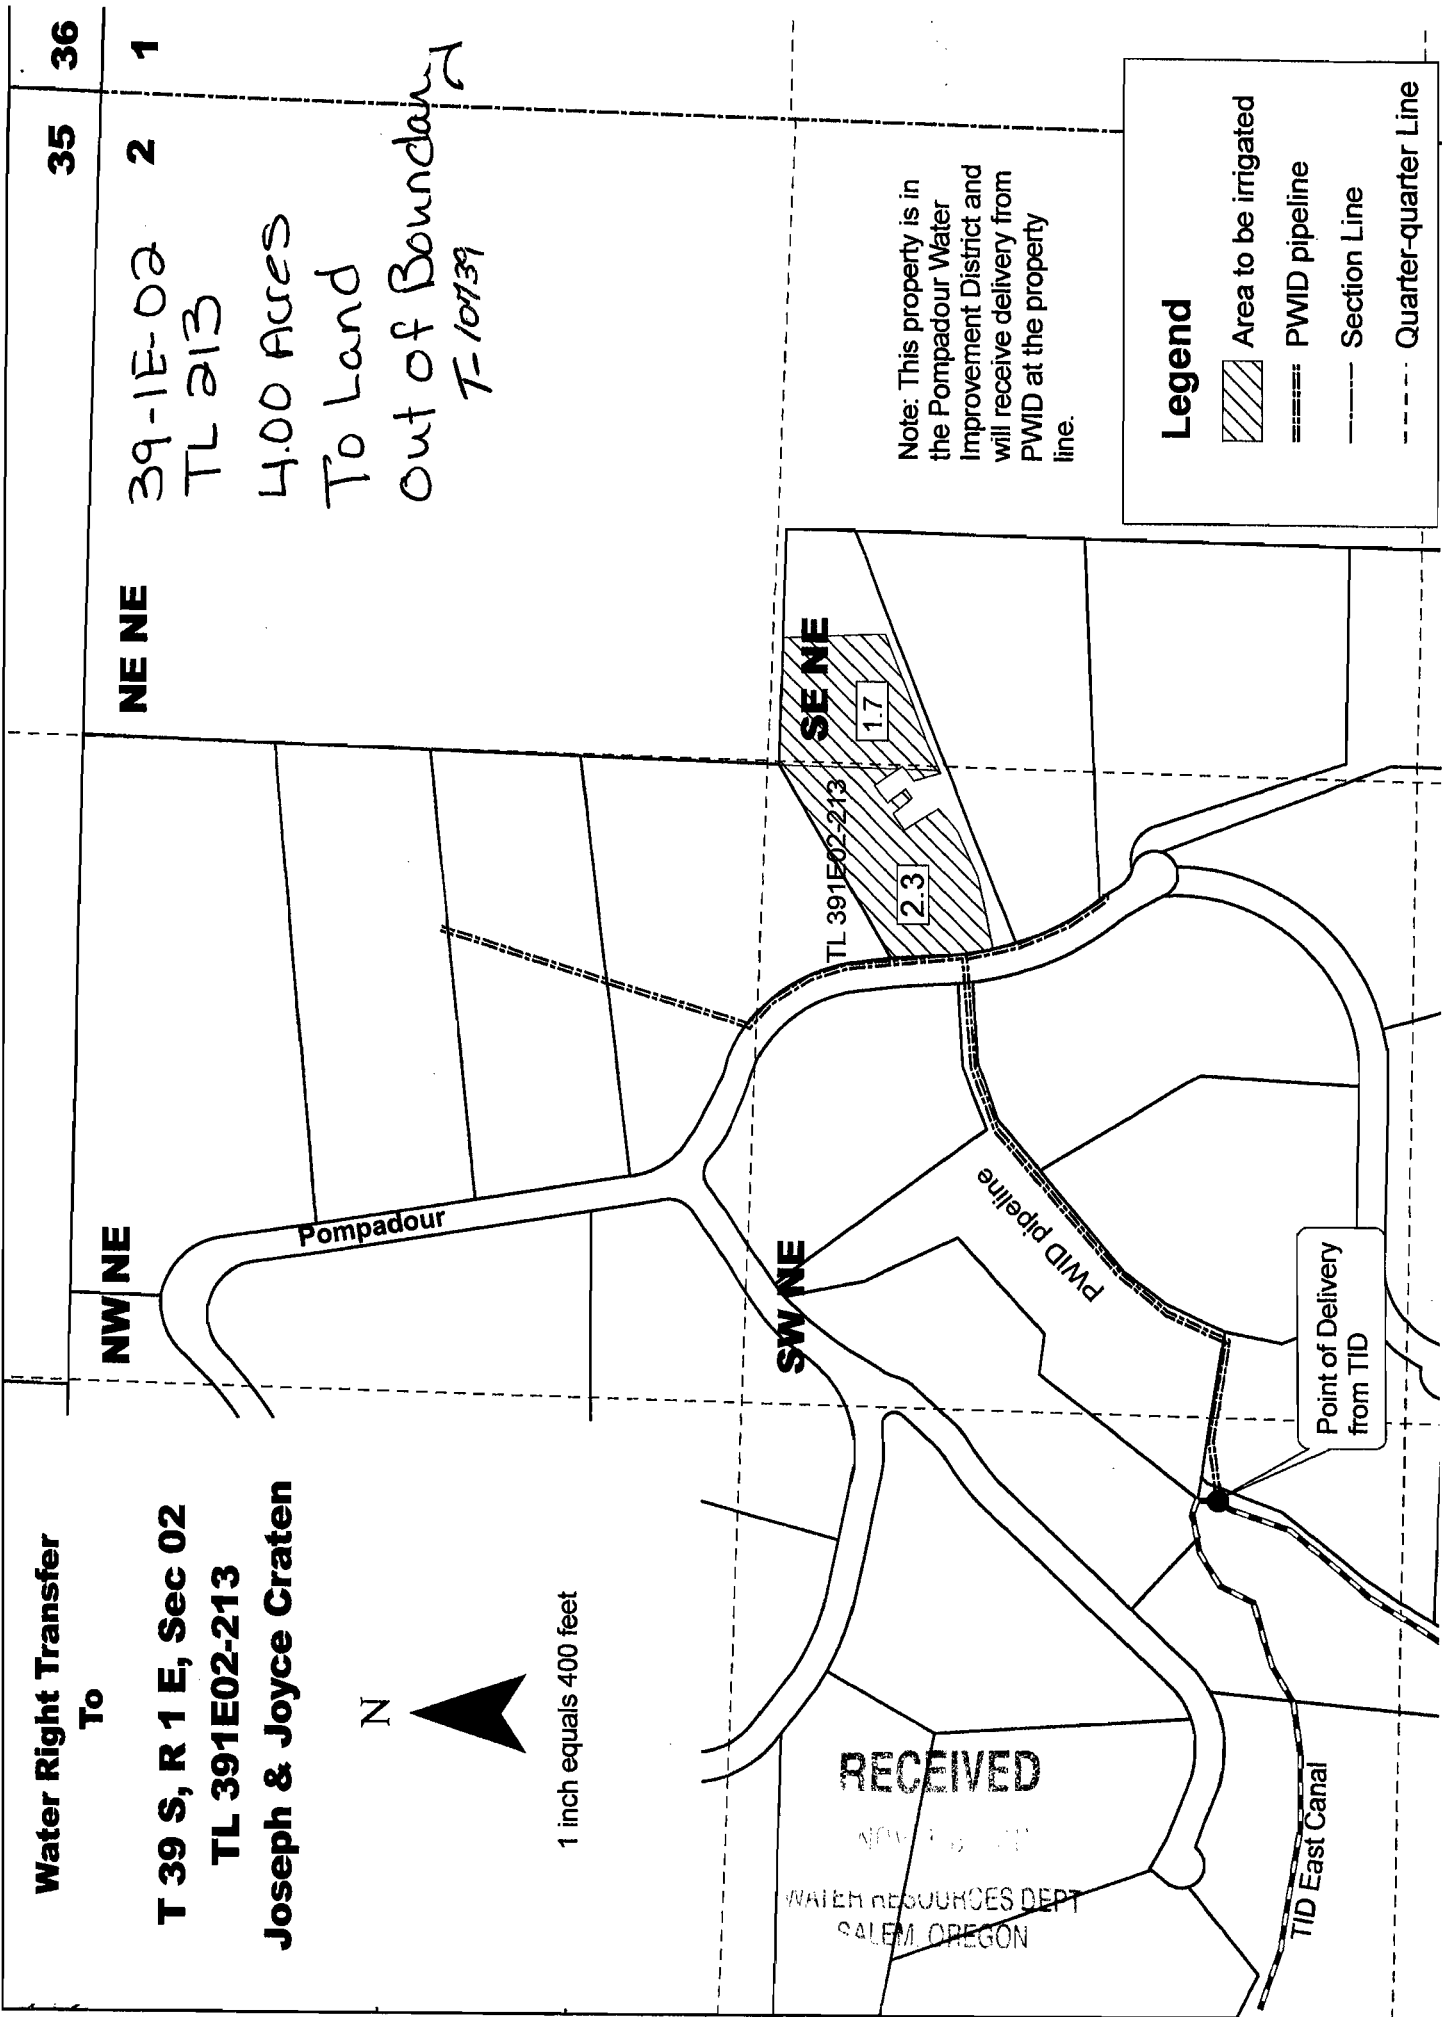

NE NE

35 36

2 1

39-1E-02
TL 213
4.00 ACRES
To Land
out of Boundary
T-10739

Note: This property is in the Pompadour Water Improvement District and will receive delivery from PWID at the property line.

Legend

- Area to be irrigated
- PWID pipeline
- Section Line
- Quarter-quarter Line

SW NE

SE NE

TL 391E02-213

2.3

1.7

PWID pipeline

Point of Delivery
from TID

TID East Canal

RECEIVED

WATER RESOURCES DEPT
SALEM OREGON

CLAIM OF BENEFICIAL USE

Site Report

Transfer Number: T - 10739

District Internal Notice #: 07-20

User Name: Gary and Carol Swanson 541-840-4203

501 Pompadour Drive Ashland, OR 97520

Place of Use:

USE	POD #	TWP	RNG	SEC	QQ	DLC	GOV'T LOT	TAX LOT	ACRES
IR	07-20	39S	1E	02	NW NE			234	.80
IR	07-20	39S	1E	02	SW NE			234	1.20

TOTAL ACRES = 2.00

District Conveyance System:

Description of Delivery System: Private turnout/pump station and private pipeline in the Pompadour Water Improvement District

Headgate: None

Canal: East Main Canal

Beneficial Use:

Description of Beneficial Use: YARD & FRUIT TREES

Method Used to Apply Water: Sprinkler and drip irrigated. The water use is metered.

Method Used to Calculate Beneficial Use: Did on-site visit of the property comparing transfer map to the actual place of use.

User Interviewed: (X) Yes () No

Beneficial Use Made as Authorized: (X) Yes () No

Description of Beneficial Use if Less than Authorized:

None

Inspected By: Robert Derry
Robert Derry, Ditch Rider

Date: 8-9-11

Instructions: Attach and label the corresponding final proof map.

S:\Wanda\Word\TRANSFERS\OWRD\2011 Claim of Beneficial Use Site Reports T-10739 2008.doc

RECEIVED

NOV 16 2011

WATER RESOURCES DEPT
SALEM, OREGON

**T 39 S, R 1 E, Sec 02
TL 391E02-234
Swanson Revocable Trust**

1 inch equals 400 feet

RECEIVED

NOV 18 2011

~~WATER RESOURCES DEPT
SALEM, OREGON~~

Point of Delivery from TID

TID East Canal

1.2

0.8



391E02-234

Pompadour


NE NE

39-1E-02 234 2 1

2.00 acres

To Land

Out of Boundary
T-10739

Note: This property is in the Pompadour Water Improvement District and will receive delivery from PWID at the property line.

Legend

Area to be irrigated

PWD pipeline

Section Line

Quarter-quarter Line

**CLAIM OF BENEFICIAL USE
Site Report**

Transfer Number: T – 10739

District Internal Notice #: 07-21

User Name: Daniel and Virginia McGregor 714-847-8872

500 Pompadour Drive Ashland, OR 97520

Place of Use:

USE	POD #	TWP	RNG	SEC	QQ	DLC	GOV'T LOT	TAX LOT	ACRES
IR	07-21	39S	1E	02	SW NE			236	1.10
IR	07-21	39S	1E	02	SW NE			236	.70
IR	07-21	39S	1E	02	NW NE			236	.20

TOTAL ACRES = 2.00

District Conveyance System:

Description of Delivery System: Private turnout/pump station and private pipeline in the
Pompadour Water Improvement District

Headgate: None

Canal: East Main Canal

Beneficial Use:

Description of Beneficial Use: YARD

Method Used to Apply Water: Sprinkler and drip irrigated. The water use is metered.

Method Used to Calculate Beneficial Use: Did on-site visit of the property comparing transfer
map to the actual place of use.

User Interviewed: (X) Yes () No

Beneficial Use Made as Authorized: (X) Yes () No

Description of Beneficial Use if Less than Authorized:

None

Inspected By: Robert Derry
Robert Derry, Ditch Rider

Date: 8-9-11

RECEIVED

Instructions: Attach and label the corresponding final proof map.

S:\Wanda\Word\TRANSFERS\OWRD\2011 Claim of Beneficial Use Site Reports T-10739 2008.doc

NOV 18 2011

WATER RESOURCES DEPT
SALEM, OREGON

07-21 35 36

391E-02 2 1
TL 236
2.00 acres
To Land
T-10139

RECEIVED
NOV 18 2011
WATER RESOURCES DEPT
SALEM, OREGON

Water Right Transfer

To

T 39 S, R 1 E, Sec 02
TL 391E02-236
Daniel L. McGregor



1 inch equals 400 feet

NW NE

NE NE

Pompadour

SW NE

SE NE

PWID pipeline

TL 391E02-236

1.8

0.2

TID East Canal

Point of Delivery
from TID

Legend

- Area to be irrigated
- PWID pipeline
- Section Line
- Quarter-quarter Line

Note: This property is in the Pompadour Water Improvement District and will receive delivery from PWID at the property line.

**CLAIM OF BENEFICIAL USE
Site Report**

Transfer Number: T - 10739

District Internal Notice #: 07-22

User Name: Paula Nelson 541-821-8023

747 Pompadour Drive Ashland, OR 97520

Place of Use:

USE	POD #	TWP	RNG	SEC	QQ	DLC	GOV'T LOT	TAX LOT	ACRES
IR	07-22	39S	1E	02	SW NE			214	1.50
IR	07-22	39S	1E	02	SE NE			214	1.50

TOTAL ACRES = 3.00

District Conveyance System:

Description of Delivery System: Private turnout/pump station and private pipeline in the
Pompadour Water Improvement District

Headgate: None

Canal: East Main Canal

Beneficial Use:

Description of Beneficial Use: YAKD

Method Used to Apply Water: Sprinkler and drip irrigated. The water use is metered.

Method Used to Calculate Beneficial Use: Did on-site visit of the property comparing transfer
map to the actual place of use.

User Interviewed: (X) Yes () No

Beneficial Use Made as Authorized: (X) Yes () No

Description of Beneficial Use if Less than Authorized:

None

Inspected By: Robert Derry
Robert Derry, Ditch Rider

Date: 8-9-11

Instructions: Attach and label the corresponding final proof map.

RECEIVED


JUL 18 2011

WATER RESOURCES DEPT
SALEM, OREGON

01-22
 39-1E-02 214
 3.00 AC
 To and
 T-10/39

Water Right Transfer
To
T 39 S, R 1 E, Sec 02
TL 391E02-214
Scott & Paula Nelson

N
 1 inch equals 400 feet

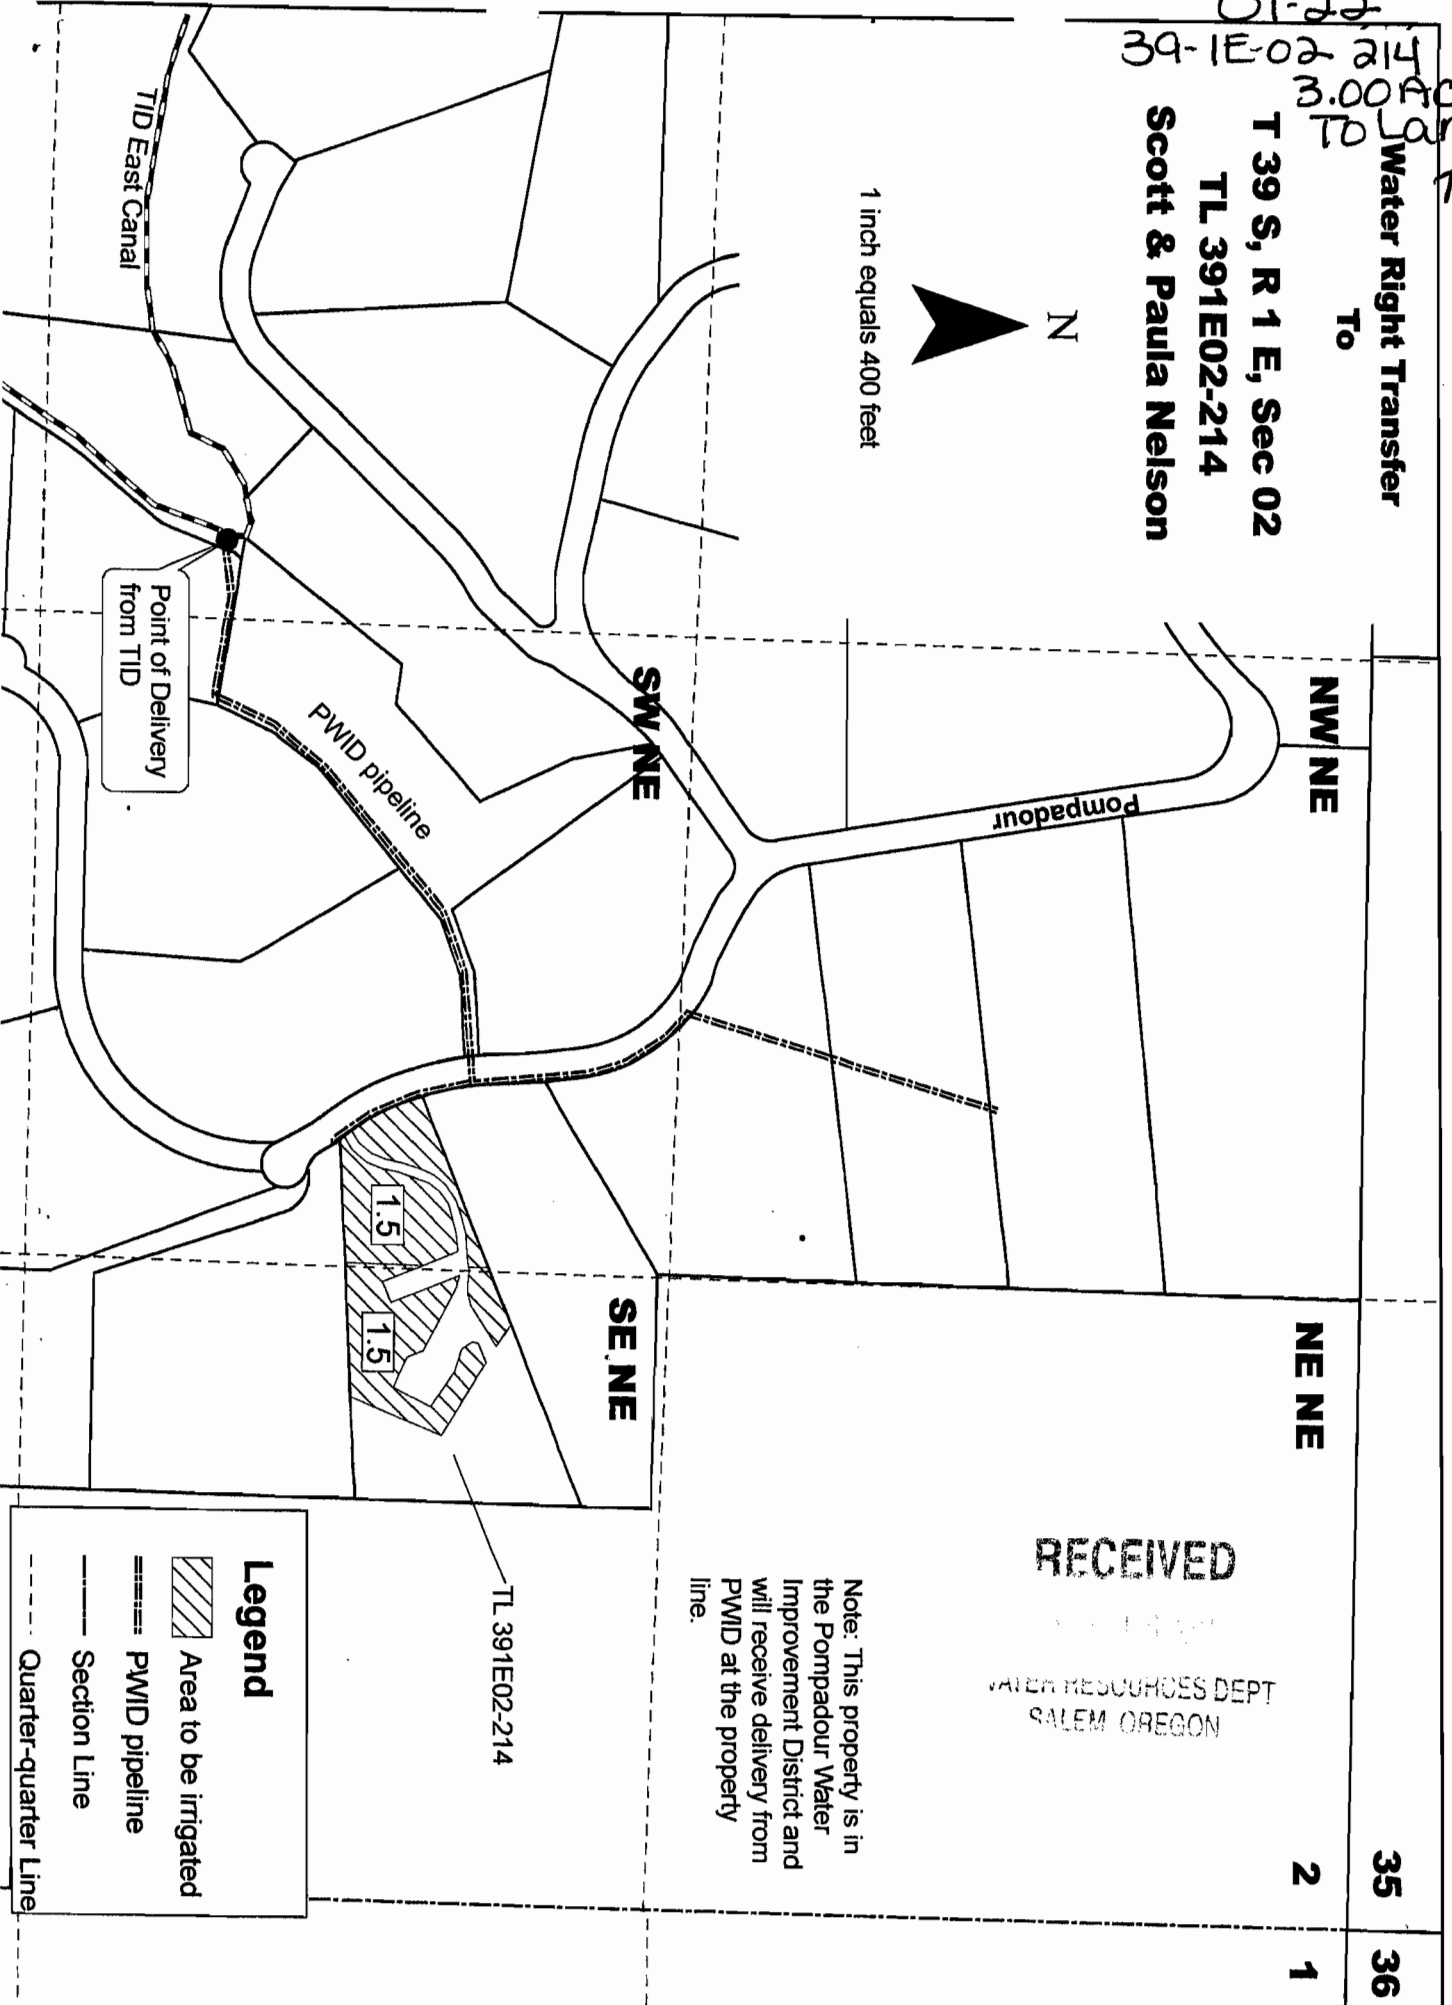

Note: This property is in the Pompadour Water Improvement District and will receive delivery from PWID at the property line.

RECEIVED

WATER RESOURCES DEPT
 SALEM OREGON

TL 391E02-214

Legend

 Area to be irrigated

 PWID pipeline

 Section Line

 Quarter-quarter Line

**CLAIM OF BENEFICIAL USE
Site Report**

Transfer Number: T - 10739

District Internal Notice #: 07-23

User Name: Peter and Bonita Cassel 209-727-3920

Pompadour Drive Ashland, OR 97520

Place of Use:

USE	POD #	TWP	RNG	SEC	QQ	DLC	GOV'T LOT	TAX LOT	ACRES
IR	07-23	39S	1E	02	SE NE			226	3.20
IR	07-23	39S	1E	02	SW NE			226	.80

TOTAL ACRES = 4.00

District Conveyance System:

Description of Delivery System: Private turnout/pump station and private pipeline in the
Pompadour Water Improvement District

Headgate: None

Canal: East Main Canal

Beneficial Use:

Description of Beneficial Use: Garden PASTURE YARD

Method Used to Apply Water: Sprinkler and drip irrigated. The water use is metered.

Method Used to Calculate Beneficial Use: Did on-site visit of the property comparing transfer
map to the actual place of use.

User Interviewed: (X) Yes () No

Beneficial Use Made as Authorized: (X) Yes () No

Description of Beneficial Use if Less than Authorized:

None

Inspected By: Robert Derry

Robert Derry, Ditch Rider

Date: 8-10-11

RECEIVED

2011 10 13

Instructions: Attach and label the corresponding final proof map.

35 36

Water Right Transfer
To

07-23

T 39 S, R 1 E, Sec 02

TL 391E02-226

Peter & Bonita Cassel

39-1E-02-226
4.00 ACRES

To Land
T-10139

1 inch equals 400 feet



NW NE

NE NE

2 1

Pompadour

SW NE

SE NE

TL 391E02-226

PWID pipeline

TID East Canal

Point of Delivery
from TID

0.8

3.2

RECEIVED

NOV 18 2011
WATER RESOURCES DEPT
SALEM, OREGON

Note: This property is in
the Pompadour Water
Improvement District and
will receive delivery from
PWID at the property
line.

Legend

Area to be irrigated

PWID pipeline

Section Line

Quarter-quarter Line