

2402 R.L. & R.L. Carter
Parrell Rd. (COI)
Bend, Ore 97701

2402

STATUS OF APPLICATION

Change in Place of Use
 Date filed June 10, 1970
 Date of hearing _____
 Place of hearing _____
 Date of order July 3, 1970 Vol. 19, page 471
 Date for application of water 10-1-71
 Proof mailed JAN 12 1987
 Proof received Feb 3, 1987
 Certificate issued _____ Vol. _____, page _____

DESCRIPTION OF WATER RIGHT

Name of stream Deschutes River
 Trib. of - County of Deschutes
 Use Irrigation
 Quantity of water - No. of acres 90
 Name of ditch Central Oregon Canal
 Date of priority 10-31-00 & 12-2-07
 In name of Leah E Barnes
Deschutes Riv Adjudication, Vol. 16, page 62
 App. No. _____ Per. No. _____ Cert. No. 29052
 Certificate cancelled _____
 Notation made on record by slu

FEES PAID

Date	Amount	Receipt No.
<u>6/10/70</u>	<u>20.00</u>	<u>19182</u>
TOTAL		
	\$1 Cert. Fee	

FEES REFUNDED

Date	Amount	Check No.



REMARKS

Surveyed 5/16/84 (Brown, Harper)
Proof not necessary on DVA 50 acres - finis

2-13-87 BE

TO BE ENTERED WHERE CHECKED	INDEX CARDS:	Entered	Checked
	<input checked="" type="checkbox"/>	Name	<u>slu</u>
<input checked="" type="checkbox"/>	Stream	<u>slu</u>	___
<input checked="" type="checkbox"/>	Pt. of Div.	<u>slu</u>	___
<input checked="" type="checkbox"/>	Calendar	<u>slu</u>	___
<input checked="" type="checkbox"/>	CHECKED TO RECORDS:		
<input checked="" type="checkbox"/>	Twp. & Rge.	<u>slu</u>	___
<input checked="" type="checkbox"/>	Decree-vault	<u>slu</u>	___
<input checked="" type="checkbox"/>	Decree-safe	<u>slu</u>	___
<input checked="" type="checkbox"/>	Cert. of W/R	<u>slu</u>	___
<input type="checkbox"/>	Per. Folder	___	___
<input type="checkbox"/>	Chaindex	___	___
<input type="checkbox"/>	Cross Ref.	___	___
<input type="checkbox"/>	Power Claim	___	___
<input type="checkbox"/>	Abstracts	___	___

T.17S., R.14E., W.M.

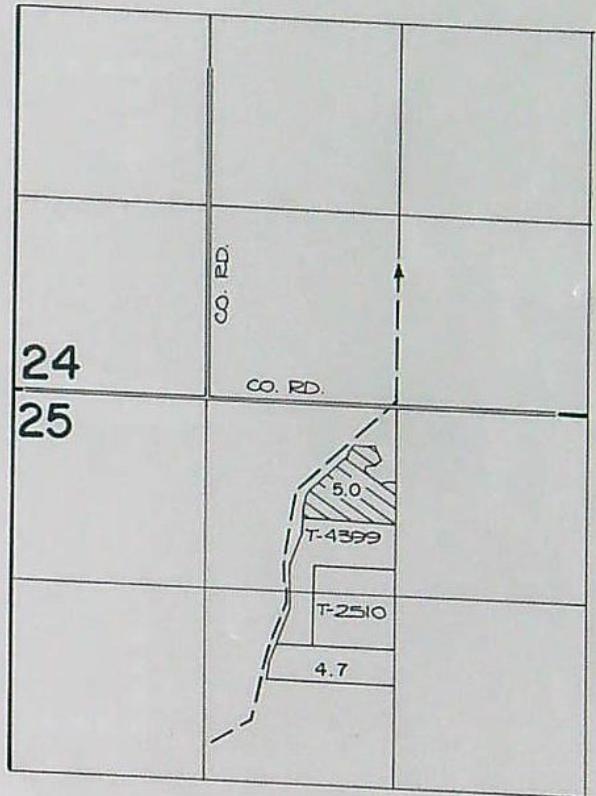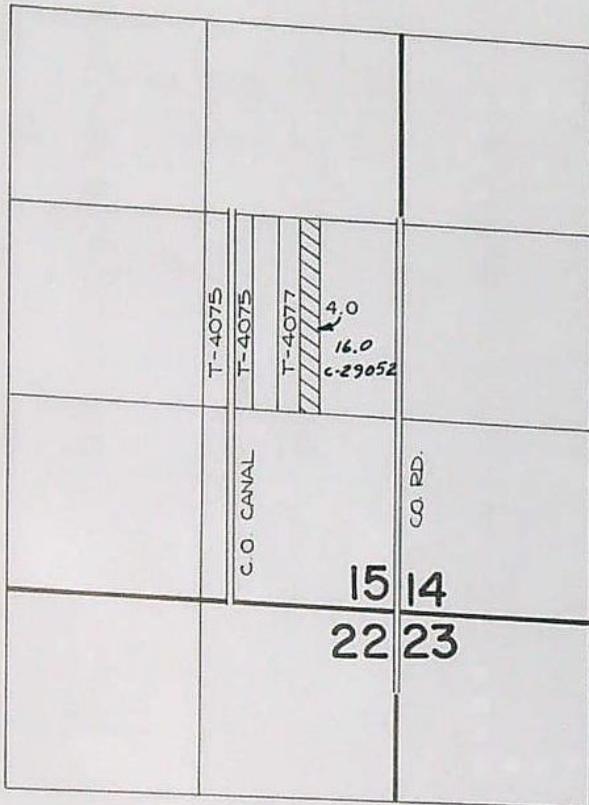

FINAL PROOF SURVEY UNDER

TRANSFER NO. 2402

IN NAME OF

HARPER BROWN, D.V.A.

Surveyed MAY 16, 1984, by L. OLSON
MAY 22, 1984, by L. OLSON



SCALE: 4" = 1 MILE

BEFORE THE STATE ENGINEER OF OREGON

Deschutes County

IN THE MATTER OF THE APPLICATION)
OF ROBERT L. AND RUTH L. CARTER)
(CENTRAL OREGON IRRIGATION DIS-)
TRICT) FOR THE APPROVAL OF A)
CHANGE IN PLACE OF USE OF WATER)
FROM DESCHUTES RIVER)

ORDER APPROVING
TRANSFER NO. 2402

On June 10, 1970, Robert L. and Ruth L. Carter filed an application in the office of the State Engineer for the approval of a change in place of use of water from Deschutes River, pursuant to the provisions of ORS 540.510 to 540.530.

By Decree of the Circuit Court for Deschutes County, Oregon, entered September 30, 1958, In the Matter of the Determination of the Relative Rights to the Use of the Waters of the Deschutes River and its Tributaries, a water right was established in the name of Central Oregon Irrigation District for the use of the waters of Deschutes River for the irrigation of, among other lands, 9.0 acres in SE $\frac{1}{4}$ SE $\frac{1}{4}$, Section 15, Township 17 South, Range 14 East, W.M., with dates of priority of October 31, 1900, and December 2, 1907, being tabulated in the name of Leah E. Barnes as evidenced by certificate of water right recorded at page 29052, Volume 21, State Record of Water Right Certificates. These lands also have a supplemental right under permit No. 23256 to the use of the water stored in Crane Prairie Reservoir with a date of priority of February 28, 1913.

The applicant herein, owner of the lands above described, proposes to transfer the water right therefrom, without loss of priority, to 4.0 acres in NE $\frac{1}{4}$ SE $\frac{1}{4}$, Section 15, and 5.0 acres in NE $\frac{1}{4}$ NW $\frac{1}{4}$, Section 25, Township 17 South, Range 14 East, W.M.

Notice by publication as provided by ORS 540.520 was not

given in connection with this application for the reason that said section provides notice is not required on an application for a change in place of use of water.

The lands involved herein are within the boundaries of the Central Oregon Irrigation District and the Board of Directors of said District approved the proposed change in place of use of water at a regular meeting held June 3, 1970.

No objections having been filed and it appearing that the proposed change in place of use of water may be made without injury to existing rights, the application should be approved.

NOW, THEREFORE, it hereby is ORDERED that the proposed change in place of use of water is approved and the water right hereinbefore described as appurtenant to 9.0 acres in SE $\frac{1}{4}$ SE $\frac{1}{4}$, Section 15, Township 17 South, Range 14 East, W.M., with dates of priority of October 31, 1900, and December 2, 1907, be severed therefrom and simultaneously and without loss of priority transferred to 4.0 acres in NE $\frac{1}{4}$ SE $\frac{1}{4}$, Section 15, and 5.0 acres in NE $\frac{1}{4}$ NW $\frac{1}{4}$, Section 25, Township 17 South, Range 14 East, W.M.

It is FURTHER ORDERED that said water so transferred shall be applied to beneficial use on or before October 1, 1971.

It is FURTHER ORDERED that upon receipt of proof satisfactory to the State Engineer of complete application of water to beneficial use on the lands to which the water is transferred hereby, certificate of water right shall be issued to Central Oregon Irrigation District at the time certificate is issued to the District confirming other transfers within the District.

Dated at Salem, Oregon, this 3rd day of July, 1970.

/s/ CHRIS L. WHEELER
State Engineer