

# STATUS OF APPLICATION

Change in Point of Diversion  
 Date filed August 25, 1972  
 Date of hearing \_\_\_\_\_  
 Place of hearing \_\_\_\_\_  
 Date of order 1-30-73 Vol. 22, page 468  
 Date for application of water October 1, 1973  
 Proof mailed \_\_\_\_\_  
 Proof received \_\_\_\_\_  
 Certificate issued MAY 24 1974 Vol. 32, page 40389  
40390

# DESCRIPTION OF WATER RIGHT

Name of stream Unnamed Stream No. 2  
 Trib. of Langton River County of Lane  
 Use Irrigation  
 Quantity of water \_\_\_\_\_ No. of acres 3 1/2  
 Name of ditch \_\_\_\_\_  
 Date of priority November 20, 1961  
 In name of Samuel Emery Watson  
 \_\_\_\_\_ Adjudication, Vol. \_\_\_\_\_, page \_\_\_\_\_  
 App. No. 37204 Per. No. 27725 Cert. No. 33944  
 Certificate cancelled \_\_\_\_\_  
 Notation made on record by \_\_\_\_\_

# FEES PAID

| Date            | Amount                   | Receipt No.  |
|-----------------|--------------------------|--------------|
| <u>8-25-72</u>  | <u>25.00</u>             | <u>30382</u> |
| TOTAL . . .     |                          |              |
| <u>11-21-72</u> | <u>3.00</u><br>Cert. Fee | <u>31506</u> |


# FEES REFUNDED

| Date | Amount | Check No. |
|------|--------|-----------|
|      |        |           |

# REMARKS

| TO BE ENTERED WHERE CHECKED         | INDEX CARDS: |  | Entered   | Checked |
|-------------------------------------|--------------|--|-----------|---------|
|                                     |              |  |           |         |
| <input checked="" type="checkbox"/> | Name         |  | <u>st</u> |         |
| <input type="checkbox"/>            | Stream       |  |           |         |
| <input type="checkbox"/>            | Pt. of Div.  |  |           |         |
| <input type="checkbox"/>            | Calendar     |  |           |         |
| CHECKED TO RECORDS:                 |              |  |           |         |
| <input checked="" type="checkbox"/> | Twp. & Rge.  |  | <u>do</u> |         |
| <input type="checkbox"/>            | Decree-vault |  |           |         |
| <input type="checkbox"/>            | Decree-safe  |  |           |         |
| <input checked="" type="checkbox"/> | Cert. of W/R |  | <u>st</u> |         |
| <input checked="" type="checkbox"/> | Per. Folder  |  | <u>st</u> |         |
| <input type="checkbox"/>            | Chainindex   |  |           |         |
| <input type="checkbox"/>            | Cross Ref.   |  |           |         |
| <input type="checkbox"/>            | Power Claim  |  |           |         |
| <input type="checkbox"/>            | Abstracts    |  |           |         |

T.16S.R.6W.W.M.

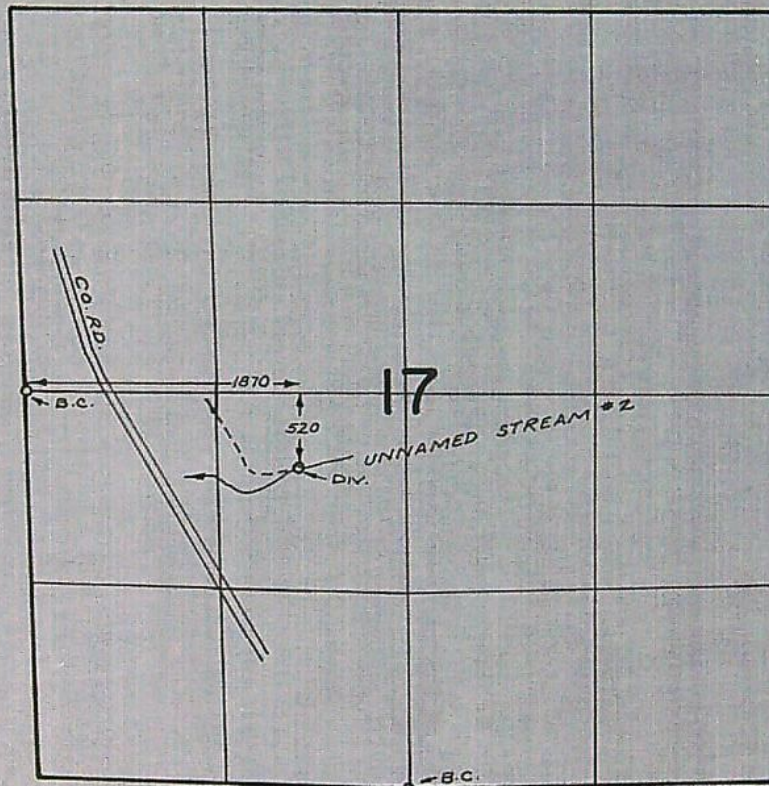

**FINAL PROOF SURVEY**  
UNDER

TRANSFER No. 2692  
Application No. .... Permit No. ....  
IN NAME OF

.....ROGER.....HENRY.....DINGEMAN.....

Surveyed QRT. 4, 1973, by R. MUCKEN

## STATE OF OREGON

COUNTY OF IANE

## CERTIFICATE OF WATER RIGHT

This Is to Certify, That SAMUEL EMERY WATSON

of 4245 Hilyard Street, Eugene, State of Oregon, has made proof to the satisfaction of the STATE ENGINEER of Oregon, of a right to the use of the waters of Long Tom Creek, Unnamed Creek No. 1, and Unnamed Creek No. 2

a tributary of Willamette River for the purpose of irrigation of ~~10.0~~ <sup>6.3</sup> acres and domestic use of one family

under Permit No. 27725 of the State Engineer, and that said right to the use of said waters has been perfected in accordance with the laws of Oregon; that the priority of the right hereby confirmed dates from November 20, 1961

that the amount of water to which such right is entitled and hereby confirmed, for the purposes aforesaid, is limited to an amount actually beneficially used for said purposes, and shall not exceed 0.089 ~~0.135~~ cubic foot per second; being 0.02 c.f.s. from Long Tom Creek, 0.02 c.f.s. from Unnamed Creek No. 1, and ~~0.09~~ <sup>0.044</sup> c.f.s. from Unnamed Creek No. 2 for irrigation and 0.005 c.f.s. from Unnamed Creek No. 1 for domestic;

or its equivalent in case of rotation, measured at the point of diversion from the stream.

The point of diversion is located in the SW $\frac{1}{4}$  NW $\frac{1}{4}$ , NW $\frac{1}{4}$  SW $\frac{1}{4}$ , Section 17, T. 16 S., R. 6 W., W. M. Diversion points located: 1075 feet North and 800 feet West; 1150 feet North and 350 feet West; 810 feet North and 200 feet West; 1375 feet North and \*

The amount of water used for irrigation, together with the amount secured under any other right existing for the same lands, shall be limited to one-eightieth of one cubic foot per second per acre, or its equivalent for each acre irrigated and shall be further limited to a diversion of not to exceed 2 $\frac{1}{2}$  acre feet per acre for each acre irrigated during the irrigation season of each year, and shall be further limited to the appropriation of water during the period when the flow of the Long Tom River is more than 25 c.f.s. measured at USGS Gage No. 1700;

and shall conform to such reasonable rotation system as may be ordered by the proper state officer.

A description of the place of use under the right hereby confirmed, and to which such right is appurtenant, is as follows:

| Stream No. 1         | Stream No. 2             | Long Tom   |
|----------------------|--------------------------|---|
|                      | 1.6 <del>2.4</del> acres |   |
| Domestic & 1.6 acres | 1.9 <del>4.8</del> acres | 1.2 acres   |
|                      |                          | NE $\frac{1}{4}$ SW $\frac{1}{4}$<br>NW $\frac{1}{4}$ SW $\frac{1}{4}$<br>Section 17<br>T. 16 S., R. 6 W., W. M. |

\* 50 feet West, all from the SE Corner, NW $\frac{1}{4}$  SW $\frac{1}{4}$ , Section 17.

An order of the State Engineer entered Jan 30 19 73, approves a change in pt of Div. for the irrigation of 3.7 acres. This certificate is issued to confirm the remaining right and supersedes the certificate heretofore issued to Samuel Emery Watson and recorded at page 33944, State Record of Water Right Certificates.

A

45387

## STATE OF OREGON

COUNTY OF LANE

## CERTIFICATE OF WATER RIGHT

This Is to Certify, That

Roger Henry Drigeman  
SAMUEL EMERY WATSON

Star Rt. Box 99 Cheshire 97419  
of 4215 Hilyard Street, Eugene, State of Oregon, has made proof  
to the satisfaction of the STATE ENGINEER of Oregon, of a right to the use of the waters of  
~~Long Tom Creek, Unnamed Creek No. 1, and Unnamed Creek No. 2~~

a tributary of ~~Willamette River~~ Long Tom River for the purpose of  
irrigation of ~~10.0~~ 3.7 acres and domestic use of one family

under Permit No. 27725 of the State Engineer, and that said right to the use of said waters  
has been perfected in accordance with the laws of Oregon; that the priority of the right hereby  
confirmed dates from November 20, 1961

that the amount of water to which such right is entitled and hereby confirmed, for the purposes  
aforesaid, is limited to an amount actually beneficially used for said purposes, and shall not exceed  
0.046 ~~0.135~~ cubic foot per second; being 0.02 c.f.s. from Long Tom Creek, 0.02 c.f.s.  
from Unnamed Creek No. 1, and 0.09 c.f.s. from Unnamed Creek No. 2 for  
irrigation and 0.005 c.f.s. from Unnamed Creek No. 1 for domestic;

or its equivalent in case of rotation, measured at the point of diversion from the stream.

The point of diversion is located in the ~~SW 1/4 NW 1/4, NW 1/4 SW 1/4, Section 17, T. 16 S., R. 6 W.,~~  
W. M. Diversion points located: 1075 feet North and 800 feet West; 1150 feet  
North and 350 feet West; 810 feet North and 200 feet West; 1375 feet North and \*  
The amount of water used for irrigation, together with the amount secured under any other  
right existing for the same lands, shall be limited to one-eightieth of one cubic foot per second  
per acre, or its equivalent for each acre irrigated and shall be further limited  
to a diversion of not to exceed 2 1/2 acre feet per acre for each acre irrigated  
during the irrigation season of each year, and shall be further limited to the  
appropriation of water during the period when the flow of the Long Tom River is  
more than 25 c.f.s. measured at USGS Gage No. 1700;

and shall

conform to such reasonable rotation system as may be ordered by the proper state officer.

A description of the place of use under the right hereby confirmed, and to which such right is  
appurtenant, is as follows:

0.8 acres NE 1/4 SW 1/4  
2.9 acres NW 1/4 SW 1/4  
See 17

T16S R6W WM

Stream No. 1

Stream No. 2

Long Tom

Domestic &amp; 1.6 acres

2.4 acres  
4.8 acres

1.2 acres

NE 1/4 SW 1/4  
NW 1/4 SW 1/4

Section 17

T. 16 S., R. 6 W., W. M.

This certificate is issued to confirm a change in Pt. of Div. approved by an order  
of the State Engineer entered Jan 30, 1973, Together with the cert rec at page (A) vol 32  
heretofore issued to Samuel Emery Watson and recorded at page 33944, Volume 25,  
State Record of Water Right Certificates.

this date.

May 24, 1967

CHRIS L. WHEELER

State Engineer

Recorded in State Record of Water Right Certificates, Volume 25, page 33944

40390

BEFORE THE STATE ENGINEER OF OREGON

Lane County

IN THE MATTER OF THE APPLICATION )  
OF ROGER HENRY DINGEMAN FOR THE )  
APPROVAL OF A CHANGE IN POINT OF )  
DIVERSION OF WATER FROM UNNAMED )  
CREEK NO. 2 )  
-----

ORDER APPROVING  
TRANSFER NO. 2692

On August 25, 1972, Roger Henry Dingeman filed an application in the office of the State Engineer for the approval of a change in point of diversion of water from Unnamed Creek No. 2, pursuant to the provisions of ORS 540.510 to 540.530.

Certificate of water right issued to Samuel Emery Watson and recorded at page 33944, Volume 25, State Record of Water Right Certificates, confirms a right to the use of not to exceed 0.09 cubic foot per second of water from, among other sources, Unnamed Creek No. 2 for the irrigation of, among other lands, 0.8 acre in NE $\frac{1}{4}$  SW $\frac{1}{4}$  and 2.9 acres in NW $\frac{1}{4}$  SW $\frac{1}{4}$ , Section 17, Township 16 South, Range 6 West, W.M., with a date of priority of November 20, 1961. These lands are irrigated from a point of diversion located 840 feet North and 200 feet West from the SE corner of the NW $\frac{1}{4}$  SW $\frac{1}{4}$  of Section 17 being within the NW $\frac{1}{4}$  SW $\frac{1}{4}$  of Section 17, Township 16 South, Range 6 West, W.M.

The applicant herein, owner of the lands above described, proposes to irrigate these lands from a point of diversion to be located 720 feet West and 490 feet South from the NE corner of the SW $\frac{1}{4}$  being within the NE $\frac{1}{4}$  SW $\frac{1}{4}$  of Section 17, Township 16 South, Range 6 West, W.M.

Notice by publication as provided by ORS 540.520 was not given in connection with this application for the reason said section provides notice is not required on an application for a change in point of diversion of water of less than one-fourth mile where there are no intervening diversions.

Mr. Gene McGinnis, Watermaster of District No. 2, has filed a report to the effect that the proposed change in point of diversion may be made without

injury to existing rights.

No objections having been filed and it appearing that the proposed change in point of diversion may be made without injury to existing rights, the application should be approved.

NOW, THEREFORE, it hereby is ORDERED that the proposed change in point of diversion of water from Unnamed Creek No. 2, to-wit:

From a point located 840 feet North and 200 feet West from the SE corner of the NW $\frac{1}{4}$  SW $\frac{1}{4}$  of Section 17 being within the NW $\frac{1}{4}$  SW $\frac{1}{4}$  of Section 17, Township 16 South, Range 6 West, W.M.

To a point to be located 720 feet West and 490 feet South from the NE corner of the SW $\frac{1}{4}$  being within the NE $\frac{1}{4}$  SW $\frac{1}{4}$  of Section 17, Township 16 South, Range 6 West, W.M.

for the irrigation of 0.8 acre in NE $\frac{1}{4}$  SW $\frac{1}{4}$  and 2.9 acres in NW $\frac{1}{4}$  SW $\frac{1}{4}$ , Section 17, Township 16 South, Range 6 West, W.M., with a date of priority of November 20, 1961, is approved.

It is FURTHER ORDERED that the construction work shall be completed and the change in point of diversion of water made on or before October 1, 1973.

It is FURTHER ORDERED that the quantity of water diverted at the new point of diversion shall not exceed the quantity of water available at the old point of diversion and shall not exceed 0.046 cubic foot per second.

It is FURTHER ORDERED that the following provisions shall be effective when in the judgement of the watermaster it becomes necessary to install headgates and measuring devices.

That the diversion works shall include an in-line flow meter, a weir, or other suitable device for measuring the water to which the applicant is entitled.

That the type and plans of the measuring device be approved by the watermaster before the beginning of construction work and that the weir or measuring device be installed under the general supervision of said watermaster.

It is FURTHER ORDERED that certificate of water right heretofore issued to Samuel Emery Watson and recorded at page 33944, Volume 25, State

Record of Water Right Certificates, is canceled and in lieu thereof a new certificate be issued covering the balance of the lands not involved in this proceeding and upon receipt of proof satisfactory to the State Engineer of completion of the authorized change in point of diversion, a certificate of water right shall be issued to Roger Henry Dingeman confirming the change in point of diversion.

Dated at Salem, Oregon, this 30th day of January, 1973.

CHRIS L. WHEELER  
State Engineer