

2599 Henry W. Knache
(COI)
Powell Butte, Ore

2599

STATUS OF APPLICATION

Change in Place of Use
 Date filed Jan 25, 1972
 Date of hearing _____
 Place of hearing _____
 Date of order Jan 31, 1972 Vol. 21, page 401
 Date for application of water 10-1-72
 Proof mailed not necessary
 Proof received _____
 Certificate issued _____ Vol. _____, page _____

DESCRIPTION OF WATER RIGHT

Name of stream Deschutes River
 Trib. of _____ County of Crook
 Use Irrigation
 Quantity of water _____ No. of acres 10.0
 Name of ditch _____
 Date of priority Oct 31, 1900
 In name of _____
 _____ Adjudication, Vol. _____, page _____
 App. No. _____ Per. No. _____ Cert. No. 29052
 Certificate cancelled _____
 Notation made on record by _____

FEES PAID

Date	Amount	Receipt No.
<u>1-25-72</u>	<u>20.00</u>	<u>26966</u>
TOTAL . . .		
	\$1 Cert. Fee	

FEES REFUNDED


Date	Amount	Check No.

REMARKS

— finis —

TO BE ENTERED WHERE CHECKED	INDEX CARDS:	
	Entered	Checked
<input checked="" type="checkbox"/> Name	<u>st</u>	
<input checked="" type="checkbox"/> Stream	<u>st</u>	
<input checked="" type="checkbox"/> Pt. of Div.		
<input checked="" type="checkbox"/> Calendar	<u>st</u>	
CHECKED TO RECORDS:		
<input checked="" type="checkbox"/> Twp. & Rge.	<u>st</u>	
<input checked="" type="checkbox"/> Decree-vault	<u>st</u>	
<input checked="" type="checkbox"/> Decree-safe	<u>st</u>	
<input checked="" type="checkbox"/> Cert. of W/R	<u>st</u>	
<input type="checkbox"/> Per. Folder		
<input type="checkbox"/> Chainindex		
<input type="checkbox"/> Cross Ref.		
<input type="checkbox"/> Power Claim		
<input type="checkbox"/> Abstracts		

T.14S., R.14E., W.M.

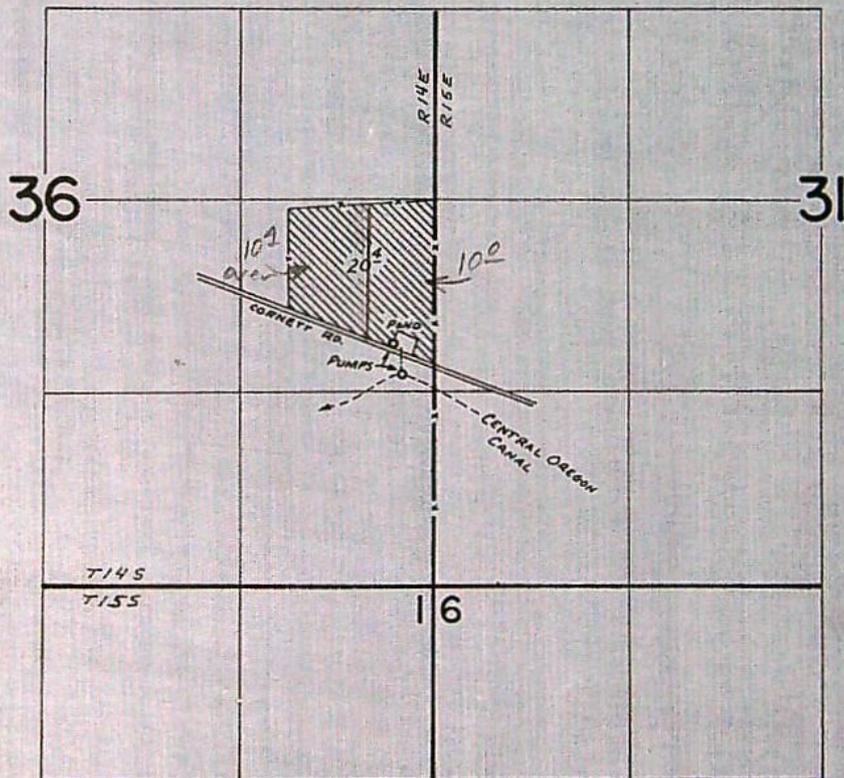

FINAL PROOF SURVEY
UNDER

Transfer No. 2599
Application No. _____ Permi No. _____
IN NAME OF

.....
HENRY W. KNOCHE
.....

Surveyed May 12 1975, by D. Norby

BEFORE THE STATE ENGINEER OF OREGON

Crook County

IN THE MATTER OF THE APPLICATION)
OF HENRY W. KNOCHE (CENTRAL OREGON)
IRRIGATION DISTRICT) FOR THE APPROVAL)
OF A CHANGE IN PLACE OF USE OF WATER)
FROM DESCHUTES RIVER)

ORDER APPROVING
TRANSFER NO. 2599

On January 25, 1972, Henry W. Knoche filed an application in the office of the State Engineer for the approval of a change in place of use of water from Deschutes River, pursuant to the provisions of ORS 540.510 to 540.530.

By Decree of the Circuit Court for Deschutes County, Oregon, entered September 30, 1958, In the Matter of the Determination of the Relative Rights to the Use of the Waters of the Deschutes River and its Tributaries, a water right was established in the name of Central Oregon Irrigation District for the use of the waters of Deschutes River for the irrigation of, among other lands, 10.0 acres in SE¼ SE¼, Section 36, Township 14 South, Range 14 East, W.M., with dates of priority of October 31, 1900 and December 2, 1907, being tabulated in the name of George Boak as evidenced by certificate of water right recorded at page 29052, Volume 21, State Record of Water Right Certificates. These lands also have a supplemental right under permit no. 23256 to the use of the water stored in Crane Prairie Reservoir with a date of priority of February 28, 1913.

The applicant herein, owner of the lands above described, proposes to transfer the water right therefrom, without loss of priority, to 10.0 acres in NE¼ SE¼, Section 36, Township 14 South, Range 14 East, W.M.

Notice by publication as provided by ORS 540.520 was not given in connection with this application for the reason that said

section provides notice is not required on an application for a change in place of use of water.

The lands involved herein are within the boundaries of the Central Oregon Irrigation District and the Board of Directors of said District approved the proposed change in place of use of water at a regular meeting held May 5, 1971.

No objections having been filed and it appearing that the proposed change in place of use of water may be made without injury to existing rights, the application should be approved.

NOW, THEREFORE, it hereby is ORDERED that the proposed change in place of use of water is approved and the water right hereinbefore described as appurtenant to 10.0 acres in SE $\frac{1}{4}$ SE $\frac{1}{4}$, Section 36, Township 14 South, Range 14 East, W.M., with dates of priority of October 31, 1900 and December 2, 1907, be severed therefrom and simultaneously and without loss of priority transferred to 10.0 acres in NE $\frac{1}{4}$ SE $\frac{1}{4}$, Section 36, Township 14 South, Range 14 East, W.M.

It is FURTHER ORDERED that said water so transferred shall be applied to beneficial use on or before October 1, 1972.

It is FURTHER ORDERED that upon receipt of proof satisfactory to the State Engineer of complete application of water to beneficial use on the lands to which the water is transferred hereby, certificate of water right shall be issued to Central Oregon Irrigation District at the time certificate is issued to the District confirming other transfers within the District.

Dated at Salem, Oregon, this 31st day of January, 1972.

/s/ CHRIS L. WHEELER
State Engineer