





## STATE OF OREGON

COUNTY OF JACKSON

## CERTIFICATE OF WATER RIGHT

This Is to Certify, That FREDERICK H. ALBRECHTSEN

of 5288 Little Applegate Road, Jacksonville, State of Oregon 97530, has a right  
to the use of the waters of  
Little Applegate River

a tributary of Applegate River for the purpose of  
irrigation of 2.5 acres

and that said right has been confirmed by decree of the Circuit Court of the State of Oregon for  
Jackson County, and the said decree entered of record at Salem, in the Order Record of  
the STATE ENGINEER, in Volume 4, at page 1; that the priority of the right thereby  
confirmed dates from September 1, 1857

that the amount of water to which such right is entitled, for the purposes aforesaid, is limited to an  
amount actually beneficially used for said purposes, and shall not exceed 0.06 cubic foot per  
second

The point of diversion is located in the NE $\frac{1}{4}$  NW $\frac{1}{4}$ , Section 29, T. 39 S., R. 2 W., W. M.

A description of the place of use under the right, and to which such right is appurtenant, is as  
follows:

2.5 acres SW $\frac{1}{4}$  SW $\frac{1}{4}$   
Section 20  
T. 39 S., R. 2 W., W. M.

This certificate is issued to confirm a change in place of use approved by an order  
of the State Engineer entered April 21, 1972, and together with the certificate re-  
corded at page 38773, Volume 30, supersedes certificate of water right heretofore  
issued to A. S. Kleinhammer and recorded at page 16400, Volume 13, State Record of  
Water Right Certificates.

And said right shall be subject to all other conditions and limitations contained in said decree.  
The right to the use of the water for the purposes aforesaid is restricted to the lands or place of  
use herein described.

WITNESS the signature of the State Engineer, affixed

this date March 5, 1975

Chris L. Wheeler

State Engineer

Recorded in State Record of Water Right Certificates, Volume 33, page 41777



BEFORE THE STATE ENGINEER OF OREGON

Jackson County

IN THE MATTER OF THE APPLICATION )  
OF STUART V. HINSON FOR THE APPROVAL )  
OF A CHANGE IN PLACE OF USE OF WATER )  
FROM LITTLE APPLGATE RIVER )  
-----

ORDER APPROVING  
TRANSFER NO. 2580

On October 27, 1971, Stuart V. Hinson filed an application in the office of the State Engineer for the approval of a change in place of use of water from Little Applegate River, pursuant to the provisions of ORS 540.510 to 540.530.

By Decree of the Circuit Court for Jackson County, Oregon, entered April 26, 1919, In the Matter of the Determination of the Relative Rights to the Use of the Waters of the Rogue River, a water right was established in the name of A. S. Kleinhammer for the use of waters of the Little Applegate River for the irrigation of, among other lands, 2.2 acres in Lot 2 (SW $\frac{1}{4}$  NW $\frac{1}{4}$ ), 0.3 acres in SE $\frac{1}{4}$  NW $\frac{1}{4}$ , 1.9 acres in NE $\frac{1}{4}$  SW $\frac{1}{4}$ , 0.3 acres in NW $\frac{1}{4}$  SE $\frac{1}{4}$ , Section 19, Township 39 South, Range 2 West, W.M., with date of priority of 1857, being tabulated in the name of A. S. Kleinhammer as evidenced by certificate of water right recorded at page 16400, Volume 13, State Record of Water Right Certificates.

The applicant herein, owner of the land above described proposes to transfer the water right therefrom, without loss of priority, to 4.7 acres in SW $\frac{1}{4}$  SW $\frac{1}{4}$ , Section 20, Township 39 South, Range 2 West, W.M.

Notice by publication as provided by ORS 540.520 was not given in connection with this application for the reason that said section provides notice is not required on an application for a change in place of use of water.



No objections having been filed and it appearing that the proposed change in place of use of water may be made without injury to existing rights, the application should be approved.

NOW, THEREFORE, it hereby is ORDERED that the proposed change in place of use of water is approved and the water right hereinbefore described as appurtenant to 2.2 acres in Lot 2 (SW $\frac{1}{4}$  NW $\frac{1}{4}$ ), 0.3 acres in SE $\frac{1}{4}$  NW $\frac{1}{4}$ , 1.9 acres in NE $\frac{1}{4}$  SW $\frac{1}{4}$ , 0.3 acres in NW $\frac{1}{4}$  SE $\frac{1}{4}$ , Section 19, Township 39 South, Range 2 West, W.M., with date of priority of 1857, be severed therefrom and simultaneously and without loss of priority transferred to 4.7 acres in SW $\frac{1}{4}$  SW $\frac{1}{4}$ , Section 20, Township 39 South, Range 2 West, W.M.

It is FURTHER ORDERED that said water so transferred shall be applied to beneficial use on or before October 1, 1972.

It is FURTHER ORDERED that certificate of water right heretofore issued to A. S. Kleinhammer and recorded at page 16400, Volume 13, State Record of Water Right Certificates is canceled and in lieu thereof a new certificate be issued to A. S. Kleinhammer covering the balance of the lands not involved in this proceeding and upon receipt of proof satisfactory to the State Engineer of application of water to beneficial use, a certificate shall be issued to Stuart V. Hinson confirming the extent to which the water has been applied beneficially.

Dated at Salem, Oregon, this 21st of April, 1972.

/s/ CHRIS L. WHEELER  
State Engineer



## STATE OF OREGON

COUNTY OF JACKSON

## CERTIFICATE OF WATER RIGHT

This Is to Certify, That A. S. Kleinhammer

of Buncom, State of Oregon, has a right to the use of  
the waters of Little Applegate River, a tributary of Applegate River  
for the purpose of irrigation of <sup>116.8</sup>~~121.5~~ acres, and Domestic, and Stock use

and that said right has been confirmed by decree of the Circuit Court of the State of Oregon for Jackson County, and the said decree entered of record at Salem, in the Order Record of the STATE ENGINEER, in Volume 4, at page 1; that the priority of the right thereby confirmed dates from September 1, 1857 for ~~2.19~~ cubic feet per second for the irrigation of ~~99.5~~ acres; 1898 for 0.55 cubic foot per second for the irrigation of 22 acres; and for Domestic and Stock use;

that the amount of water to which such right is entitled, for the purposes aforesaid, is limited to an amount actually beneficially used for said purposes, and shall not exceed ~~3.04~~ cubic feet per second. <sup>2.37</sup>  
2.92

A description of the lands irrigated under such right, and to which the water is appurtenant (or, if for other purposes, the place where such water is put to beneficial use), is as follows:

1.5 acres in SE  $\frac{1}{4}$  SW  $\frac{1}{4}$  ✓  
20.8 ~~23.0~~ acres in SW  $\frac{1}{4}$  NW  $\frac{1}{4}$  ✓  
15.7 ~~16.0~~ acres in SE  $\frac{1}{4}$  NW  $\frac{1}{4}$  ✓  
1.0 acre in NW  $\frac{1}{4}$  SW  $\frac{1}{4}$  ✓  
16.6 ~~18.5~~ acres in NE  $\frac{1}{4}$  SW  $\frac{1}{4}$  ✓  
1.0 acre in NE  $\frac{1}{4}$  SE  $\frac{1}{4}$  ✓  
7.7 ~~8.0~~ acres in NW  $\frac{1}{4}$  SE  $\frac{1}{4}$  ✓  
20.0 acres in SW  $\frac{1}{4}$  SE  $\frac{1}{4}$  ✓  
18.0 acres in SE  $\frac{1}{4}$  SE  $\frac{1}{4}$  ✓  
Section 19,  
8.0 acres in SW  $\frac{1}{4}$  SW  $\frac{1}{4}$  ✓  
Section 20,  
1.5 acres in NW  $\frac{1}{4}$  NW  $\frac{1}{4}$  ✓  
5.0 acres in NE  $\frac{1}{4}$  NW  $\frac{1}{4}$  ✓  
Section 29,  
T. 39 S., R. 2 W., W. M.

Note: This Certificate

Certificate of water right issued to A.S. Kleinhammer and recorded at page 16400,  
Volume 13, State Record of Water Right Certificates, confirms the right to the use of  
water for irrigation of 121.5 acres. A change in the right to the use of water  
~~irrigation~~ appurtenant to 4.7 acres was approved by order of the State Engineer entered April 21,  
1972. This certificate is issued to confirm the remaining right to the use of water for  
irrigation and supersedes the certificate heretofore issued to ASKleinhammer.

WITNESS the signature of the State Engineer, affixed

this 30 day of September, 1949.

CHAS. E. STRICKLIN


State Engineer

Recorded in State Record of Water Right Certificates, Volume 13, page 16400

38773



T.39 S.R.2W.W.M.

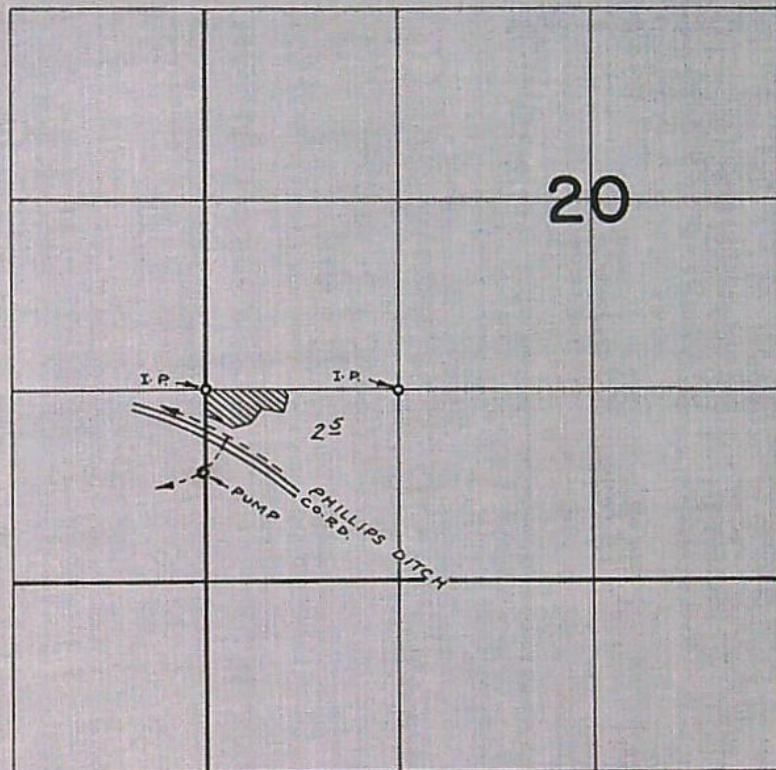

**FINAL PROOF SURVEY**  
UNDER

TRANSFER NO. 2580

Application No. .... Permit No. ....  
IN NAME OF

.....STUART V. HINSON.....

Surveyed SEPT. 26, 1974, by R. MUCKEN