

2939 Kay Davis (TZO)
Bend, Ore

2939

STATUS OF APPLICATION

Change in Place of use
Date filed Nov. 20, 1973
Date of hearing _____
Place of hearing _____
Date of order 7-27-78 Vol. 31, page 74
Date for application of water 10-1-79
Proof mailed _____
Proof received _____
Certificate issued _____ Vol. _____, page _____

DESCRIPTION OF WATER RIGHT

Name of stream Tumalo Cr., Deschutes R., & Lake
Trib. of _____ County of Deschutes
Use Irrigation
Quantity of water _____ No. of acres 67
Name of ditch Tumalo Feed Canal
Date of priority Sept. 1900 April 7, 1911 April 28, 1905
In name of Tumalo I.D. for James Mulvihill
Tumalo Adjudication, Vol. 16, page 191
App. No. _____ Per. No. _____ Cert. No. 26508
Certificate cancelled _____
Notation made on record by _____

FEES PAID

Date	Amount	Receipt No.
<u>11-20-73</u>	<u>25.00</u>	<u>37508</u> <i>ok</i>
TOTAL . . .		
	Cert. Fee	

FEES REFUNDED

Date	Amount	Check No.
	Exam <u>15-</u>	
	POU <u>10-</u>	
	<u>25-</u>	

Surveyed 4/7/86 (Davis & Finch) to survey 3/80


REMARKS

CARD FOR C-DEC 4-1979
SEE T-6238

	INDEX CARDS:		Entered	Checked
	TO BE ENTERED WHEN CHECKED			
<input checked="" type="checkbox"/>	Name		<u>lg</u>	_____
<input checked="" type="checkbox"/>	Stream		<u>lg</u>	_____
<input checked="" type="checkbox"/>	Pt. of Div.		<u>lg</u>	_____
<input checked="" type="checkbox"/>	Calendar		<u>lg</u>	_____
<input checked="" type="checkbox"/>	Twp. & Rce.		<u>lg</u>	_____
<input checked="" type="checkbox"/>	Decree-vault		<u>lg</u>	<u>lg</u>
<input checked="" type="checkbox"/>	Decree-safe		<u>lg</u>	_____
<input checked="" type="checkbox"/>	Cert. of W/R		<u>lg</u>	_____
<input type="checkbox"/>	Per. Folder		_____	_____
<input type="checkbox"/>	Chaindex		_____	_____
<input type="checkbox"/>	Cross Ref.		_____	_____
<input checked="" type="checkbox"/>	Power Claims		<u>lg</u>	_____
<input type="checkbox"/>	Abstracts		_____	_____

465

T.16S., R.12E., W. M.

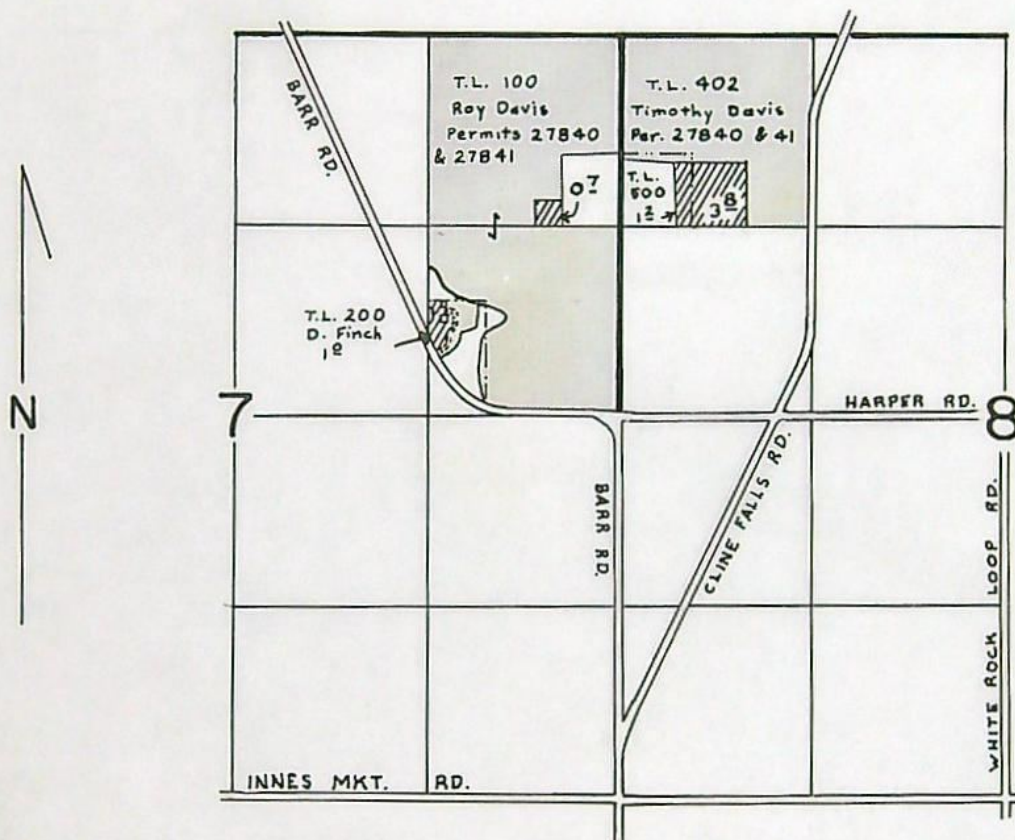

SCALE: 1" = 1320'

FINAL PROOF SURVEY UNDER

TRANSFER NO. 2939

IN NAME OF

ROY DAVIS et al.

Surveyed APRIL 7, 1986, by LESLIE OLSON

BEFORE THE WATER RESOURCES DIRECTOR OF OREGON
DESCHUTES COUNTY

IN THE MATTER OF THE APPLICATION)
OF ROY DAVIS (TUMALO IRRIGATION)
DISTRICT) FOR APPROVAL OF A CHANGE)
IN PLACE OF USE OF WATER)

ORDER APPROVING
TRANSFER NO. 2939

On November 20, 1973, Roy Davis filed an application in the office of the Water Resources Director for approval of a change in place of use of water from Tumalo Creek, Deschutes River, Crater Creek, Little Crater Creek and three spring branches, and Crescent Lake Reservoir, pursuant to the provisions of ORS 540.510 to 540.530.

By Decree of the Circuit Court for Deschutes County, Oregon, entered August 27, 1958, In the Matter of the Determination of the Relative Rights to the Use of the Waters of Tumalo Creek, a tributary of Deschutes River, a water right was established in the name of Tumalo Irrigation District, tabulated in the name of James Mulvahill, for the irrigation of, among other lands, 3.2 acres in SW $\frac{1}{4}$ NE $\frac{1}{4}$ and 3.5 acres in SE $\frac{1}{4}$ NW $\frac{1}{4}$ of Section 8, Township 16 South, Range 12 East, W.M., with a date of priority of September, 1900, as evidenced by certificate recorded at page 26508, Volume 18, State Record of Water Right Certificates.

These lands also have supplemental rights evidenced by certificate recorded at page 31412, Volume 23, State Record of Water Right Certificates, to the use of water from Deschutes River, with a date of priority of 1905; certificate recorded at page 26050, Volume 18, State Record of Water Right Certificates, to the use of water from Tumalo Creek, Crater Creek, Little Crater Creek and three spring branches, with a date of priority of October 29, 1913; certificate recorded at page 26051, Volume 18, State Record of Water Right Certificates, to the use of waters of Crescent Lake Reservoir, with a date of priority of April 7, 1911; and permit No. 27841 for the use of waters of Crescent Lake Reservoir, with a date of priority of December 8, 1961.

The applicant herein, owner of the lands above described, proposes to transfer the water rights therefrom, without loss of priority, to a certain 0.7 acre in NE $\frac{1}{4}$ NE $\frac{1}{4}$, 1.0 acre in SE $\frac{1}{4}$ NE $\frac{1}{4}$ of Section 7, and 5.0 acres in NW $\frac{1}{4}$ NW $\frac{1}{4}$ of Section 8, Township 16 South, Range 12 East, W.M.

The lands involved herein are within the boundaries of the Tumalo Irrigation District and the Board of Directors of said District approved the proposed change in place of use of water at a regular meeting held April 3, 1973.


No objections having been filed and it appearing that the proposed change in place of use may be made without injury to existing rights, the application should be approved.

NOW, THEREFORE, it hereby is ORDERED that the requested change in place of use described herein, without loss of priority, is approved.

It is FURTHER ORDERED that said water so transferred shall be applied to beneficial use on or before October 1, 1979.

It is FURTHER ORDERED that upon receipt of proof satisfactory to the Water Resources Director of complete application of water to beneficial use on the lands to which the water is transferred hereby, certificate of water right shall be issued to Tumalo Irrigation District confirming this and prior changes within the District.

Dated at Salem, Oregon this 27th day of July, 1978.

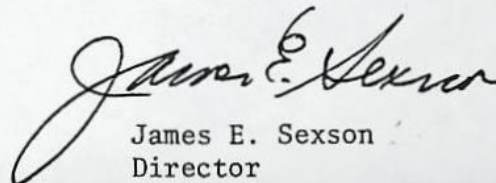

James E. Sexson
Director