


T.32S. R.3W. W.M.

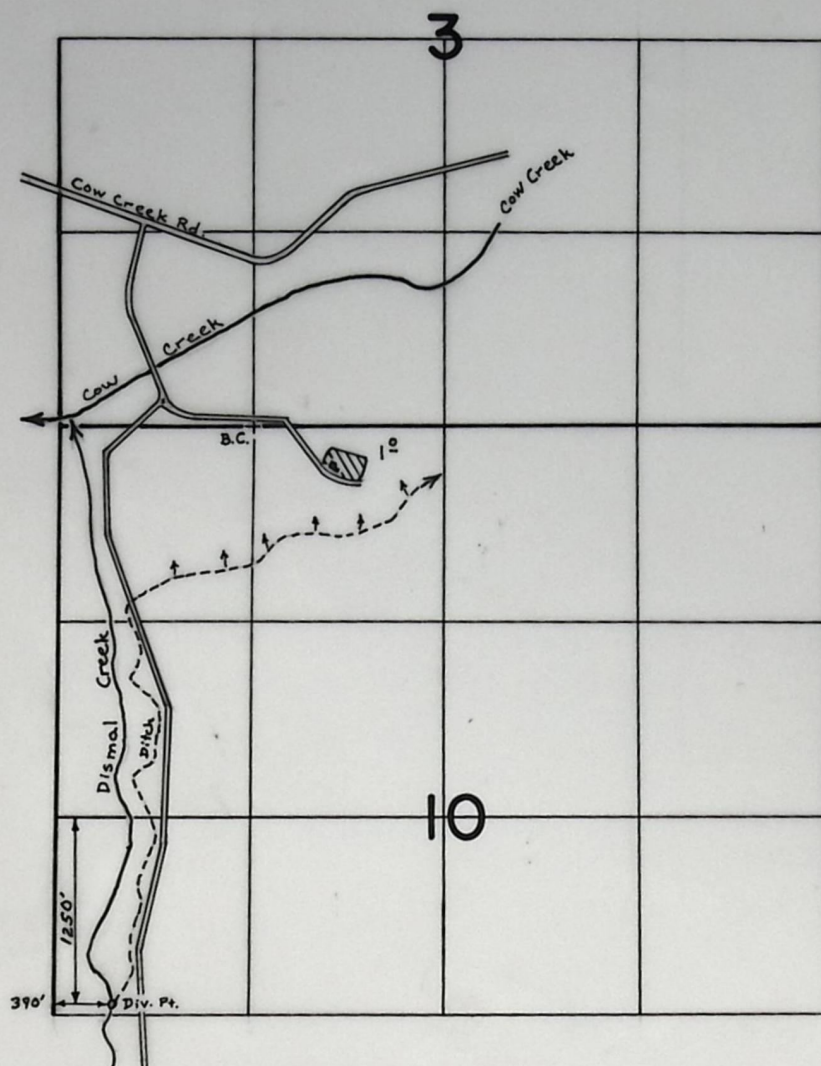

SCALE: 4" = 1 mile

FINAL PROOF SURVEY UNDER

Transfer No. 3282

Application No. Permit No.
IN NAME OF

ANDREW H., MARLINE, & ESTHER KOCH

Surveyed July 15.... 1980., by S. Donaldson....

BEFORE THE WATER RESOURCES DIRECTOR OF OREGON

Douglas County

IN THE MATTER OF THE APPLICATION)
OF CLIFFORD W. AND KATHRYN AUSTIN)
FOR THE APPROVAL OF A CHANGE IN)
PLACE OF USE OF WATER FROM DISMAL)
CREEK)

ORDER APPROVING
TRANSFER NO. 3282

On July 11, 1975, Clifford W. and Kathryn Austin filed an application in the office of the Water Resources Director for the approval of a change in place of use of water from Dismal Creek pursuant to the provisions of ORS 540.510 to 540.530.

Certificate of water right recorded at Page 11320, Volume 10, State Record of Water Right Certificates, in the name of George W. Ives, describes an existing right of record which includes the use of not to exceed 0.015 cubic foot per second from Dismal Creek for the irrigation of 1.0 acre in NW $\frac{1}{4}$ NW $\frac{1}{4}$, Section 10, Township 32 South, Range 3 West, W.M., with a date of priority of September 18, 1933.

Water for the said right is diverted from a point located 2800 feet South and 450 feet East from the Northwest corner of Section 10, being within the NW $\frac{1}{4}$ SW $\frac{1}{4}$ of Section 10, Township 32 South, Range 3 West, W.M.

The applicant herein, owner of the lands above described, proposes to change, without loss of priority, the place of use and to sever the right therefrom and in lieu thereof irrigate a certain 1.0 acre in NE $\frac{1}{4}$ NW $\frac{1}{4}$ of Section 10, Township 32 South, Range 3 West, W.M.

Mr. M. John Youngquist, Watermaster of District No. 15, has filed a statement to the effect that the proposed change in place of use may be made without injury to existing rights.

AFFIDAVIT OF APPLICANT


STATE OF OREGON,
County of Douglas } ss.

I, Clifford W. Austin and Kathryn Austin, the applicant herein, being first duly sworn, depose and say that I have read the above and foregoing application for transfer of water right; that I know the contents thereof and that the statements therein made are true and correct to the best of my knowledge and belief.

In Witness Whereof, I have hereunto set my hand this 1st day of July, 1975.

Clifford W. Austin
Kathryn Austin
(Name of applicant)

Subscribed and sworn to before me this 1st day of July, 1975.

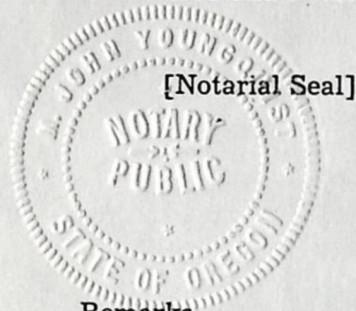

John Young
NOTARY PUBLIC FOR OREGON
My commission expires 4-18-76

Remarks

THIS APPLICATION MUST BE ACCOMPANIED BY A MAP SHOWING THE LOCATION OF THE POINT OF DIVERSION, PLACE OF USE AND WORKS UTILIZED UNDER THE PRESENT WATER RIGHT. THE MAP SHOULD ALSO SHOW THE NEW POINT OF DIVERSION OR PLACE OF USE, AS THE CASE MAY BE.