

3127

# STATUS OF APPLICATION

Change in place of use  
Date filed 9-9-74  
Date of hearing \_\_\_\_\_  
Place of hearing \_\_\_\_\_  
Date of order 12-2-77 Vol. 30, page 149  
Date for application of water 10-1-79  
Proof mailed JUN 29 1987  
Proof received \_\_\_\_\_  
Certificate issued \_\_\_\_\_ Vol. \_\_\_\_\_, page \_\_\_\_\_

# DESCRIPTION OF WATER RIGHT

Name of stream Tumalo Cr., Deschutes R, Crescent Lake  
Trib. of \_\_\_\_\_ County of Deschutes  
Use irrigation  
Quantity of water \_\_\_\_\_ No. of acres <sup>(1)</sup> 4.5 <sub>(2)</sub> 0.5  
Name of ditch \_\_\_\_\_  
Date of priority \_\_\_\_\_  
In name of <sup>(1)</sup> C.P. Becker ; <sup>(2)</sup> Wm Kirkpatrick  
Tumalo Creek Adjudication, Vol. <sup>(1)</sup> 1 <sub>(2)</sub> 16, page 137  
App. No. \_\_\_\_\_ Per. No. \_\_\_\_\_ Cert. No. <sup>(1)</sup> 31410 <sub>(2)</sub> 26508  
Certificate cancelled \_\_\_\_\_  
Notation made on record by \_\_\_\_\_

# FEES PAID

Date	Amount	Receipt No.
9-9-74	25.00	42838 OK
TOTAL . . .		
	Cert. Fee	

# FEES REFUNDED

Date	Amount	Check No.

Survey 3/80

Surveyed 5/10/85 (Drvorak)

# REMARKS

CARD FOR C DEC 26 1979

4.5 acres Sep 1900 (cont 31410) & 0.5 acre Sep 1900 (cont 26508)


— finis —

TO BE ENTERED WHERE CHECKED	INDEX CARDS:		Entered	Checked
<input checked="" type="checkbox"/>	Name		<u>lg</u>	—
<input checked="" type="checkbox"/>	Stream		<u>lg</u>	—
<input checked="" type="checkbox"/>	Pt. of Div.		<u>lg</u>	—
<input checked="" type="checkbox"/>	Calendar		<u>lg</u>	—
CHECKED TO RECORDS:				
<input checked="" type="checkbox"/>	Twp. & Rge.		<u>lg</u>	<u>lg</u>
<input checked="" type="checkbox"/>	Decree-vault		<u>lg</u>	—
<input checked="" type="checkbox"/>	Decree-safe		<u>lg</u>	—
<input checked="" type="checkbox"/>	Cert. of W/R		—	—
<input checked="" type="checkbox"/>	Per. Folder		—	—
<input checked="" type="checkbox"/>	Chaindex		—	—
<input checked="" type="checkbox"/>	Cross Ref.		—	—
<input checked="" type="checkbox"/>	Power Claim		—	—
<input checked="" type="checkbox"/>	Abstracts		<u>lg</u>	—



T.16 S., R.11 E., W.M.

N

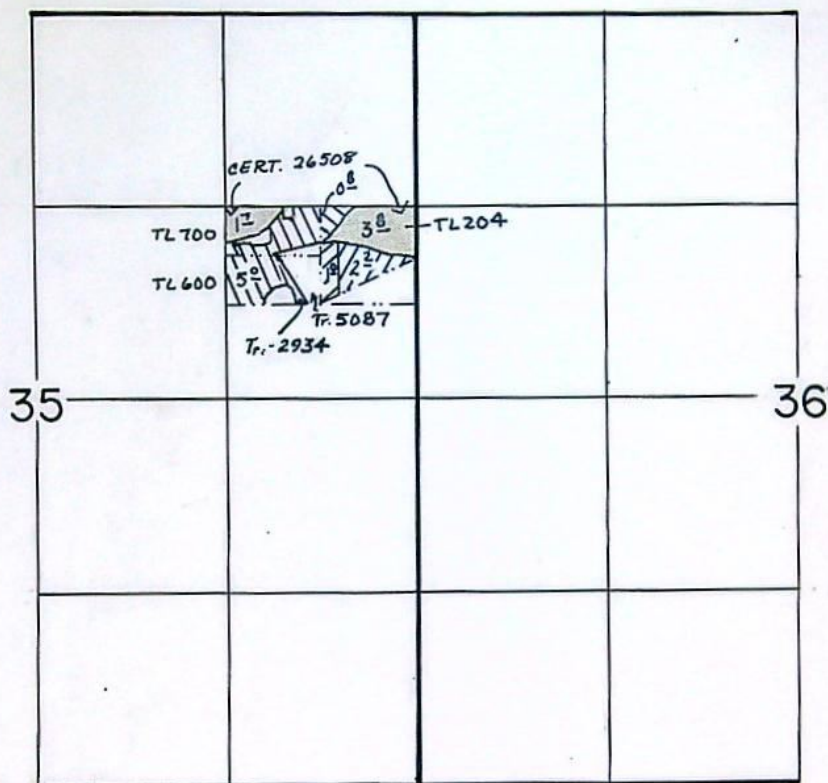

SCALE: 1"=1320'

# FINAL PROOF SURVEY

UNDER

TRANSFERS 3127, 5569, 5597, 5641  
1/3

IN NAME OF

LOUIS DVORAK

Surveyed MAY 10, 1985, by L. OLSON  
JUNE 2, 1986



BEFORE THE WATER RESOURCES DIRECTOR OF OREGON

DESCHUTES COUNTY

IN THE MATTER OF THE APPLICATION OF )  
WALL INVESTMENT CORPORATION (TUMALO )  
IRRIGATION DISTRICT) FOR APPROVAL OF )  
A CHANGE IN PLACE OF USE OF WATER )  
FROM TUMALO CREEK, DESCHUTES RIVER, )  
CRATER CREEK, LITTLE CRATER CREEK, )  
AND THREE SPRINGS AND CRESCENT LAKE )  
RESERVOIR )  
-----

ORDER APPROVING  
TRANSFER NO. 3127

On September 9, 1974, Wall Investment Corporation filed an application in the office of the Water Resources Director for the approval of a change in place of use of water from Tumalo Creek, Deschutes River, Crater Creek, Little Crater Creek and Three Springs and Crescent Lake Reservoir, pursuant to the provisions of ORS 540.510 to 540.530.

31410  
26508  
By Decree of the Circuit Court for Crook County, Oregon, entered May 11, 1911, In the Matter of the Determination of the Relative Rights to the use of the Waters of Tumalo Creek, a tributary of Deschutes River, a water right was established in the name of Tumalo Irrigation District, tabulated in the name of C. P. Becker at Volume 1, page 137, for irrigation of, among other lands, 4.5 acres in NE $\frac{1}{4}$  NE $\frac{1}{4}$  of Section 19, Township 16 South, Range 12 East, W.M., with a date of priority of September, 1900, as evidenced by certificate recorded at page 31410, Volume 23, State Record of Water Right Certificates.

By Decree of the Circuit Court for Deschutes County, Oregon, entered August 27, 1958, In the Matter of the Determination of the Relative Rights to the Use of the Waters of Tumalo Creek, a tributary of Deschutes River, a water right was established in the name of Tumalo Irrigation District, tabulated in the name of William Kirkpatrick at Volume 16, page 193, for irrigation of, among other lands, 0.5 acre in NE $\frac{1}{4}$  NE $\frac{1}{4}$  of Section 19, Township 16 South, Range 12 East, W.M., with a date of priority of September, 1900, as evidenced by certificate recorded at page 26508, Volume 18, State Record of Water Right Certificates.

These lands also have supplemental rights evidenced by certificate recorded at page 31412, Volume 23, State Record of Water Right Certificates, to the use of water from Deschutes River, with a date of priority of 1905; certificate recorded at page 26050, Volume 18, State Record of Water Right Certificates, to the use of water from Tumalo Creek, Crater Creek, Little Crater Creek and Three Springs, with a date of



priority of October 29, 1913; certificate recorded at page 26051, Volume 18, State Record of Water Right Certificates, to the use of the waters of Crescent Lake Reservoir, with a date of priority of April 7, 1911; and permit No. 27841 for the use of waters of Crescent Lake Reservoir, with a date of priority of December 8, 1961.

The applicant herein, owner of the lands above described, proposes to transfer the water rights therefrom, without loss of priority, to a certain 5.0 acres in NW $\frac{1}{4}$  SE $\frac{1}{4}$  NE $\frac{1}{4}$  of Section 35, Township 16 South, Range 11 East, W.M.

Notice by publication as provided by ORS 540.520 was not given in connection with this application for the reason that said section provides notice is not required on an application for a change in place of use of water.

The lands involved herein are within the boundries of the Tumalo Irrigation District and the Board of Directors of said District approved the proposed change in place of use of water at a regular meeting held June 4, 1974.


No objections having been filed and it appearing that the proposed change in place of use of water may be made without injury to existing rights, the application should be approved.

NOW, THEREFORE, it hereby is ORDERED that the proposed changes in place of use of water, as described herein, without loss of priority, are approved.

It is FURTHER ORDERED that said water so transferred shall be applied to beneficial use on or before October 1, 1979.

It is FURTHER ORDERED that upon receipt of proof satisfactory to the Water Resources Director of complete application of water to beneficial use on the lands to which the water is transferred hereby, certificate of water right shall be issued to Tumalo Irrigation District confirming this and prior changes within the District.

Dated at Salem, Oregon, this 2nd day of December, 1977.

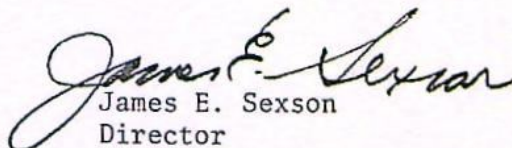  
James E. Sexson  
Director