

Lyle E. Klampe
7206 Lakeside Dr.
Salem, Ore.

2766

STATUS OF APPLICATION

Change in Point of Diversion
Date filed Feb. 20, 1973
Date of hearing _____
Place of hearing _____
Date of order April 18, 1973 Vol. 23, page 125
Date for application of water October 1, 1973
Proof mailed _____
Proof received _____
Certificate issued FEB 4 1975 Vol. 33, page 41622

DESCRIPTION OF WATER RIGHT

Name of stream A Well
Trib. of _____ County of MARION
Use Irrigation
Quantity of water _____ No. of acres 85
Name of ditch _____
Date of priority MARCH 30, 1962
In name of Lyle E. Klampe
_____ Adjudication, Vol. _____, page _____
App. No. G-2277 Per. No. G-2105 Cert. No. 34193
Certificate cancelled _____
Notation made on record by _____

FEES PAID

Date	Amount	Receipt No.
<u>2-20-73</u>	<u>25.00</u>	<u>32502</u>
TOTAL . . .		
<u>2-20-73</u>	<u>1.50</u> Cert. Fee	<u>32503</u>


FEES REFUNDED

Date	Amount	Check No.
------	--------	-----------

REMARKS

	INDEX CARDS:	Entered	Checked
✓	Name	<u>ST</u>	_____
✓	Stream	<u>ST</u>	_____
✓	Pt. of Div.	_____	_____
✓	Calendar	<u>ST</u>	_____
	CHECKED & RECORDED:		
✓	Twp. & Rg.	<u>ST</u>	_____
✓	Decree-vol.	_____	_____
✓	Decree-sa.	_____	_____
✓	Cert. of W. R.	<u>ST</u>	_____
✓	Per. Folder	<u>ST</u>	_____
✓	Chaindex	_____	_____
✓	Cross Ref.	_____	_____
✓	Power Grant	_____	_____
✓	Abstracts	_____	_____

T.6S.R.2W.W.M.

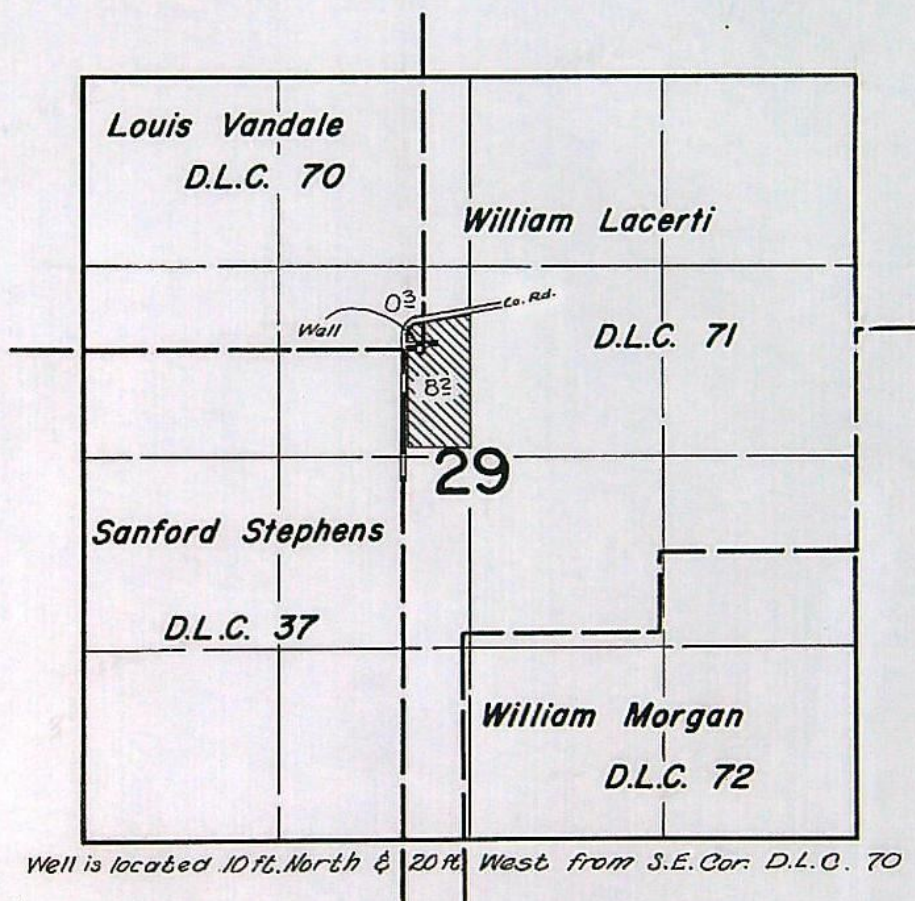

FINAL PROOF SURVEY
UNDER

Application No. G-2277. Permit No. G-2105.
IN NAME OF

LYLE E. KLAMPE

Surveyed June 15, 1965, by *H. Jackson*

STATE OF OREGON

COUNTY OF

MARION

CERTIFICATE OF WATER RIGHT

This Is to Certify, That LYLE E. KLAMPE
 of 7206 Lakeside Dr. Salem, State of Oregon, has made proof
 to the satisfaction of the STATE ENGINEER of Oregon, of a right to the use of the waters of
 a well

a tributary of Pudding River
 irrigation of 8.5 acres

for the purpose of

under Permit No. G-2105 of the State Engineer, and that said right to the use of said waters
 has been perfected in accordance with the laws of Oregon; that the priority of the right hereby
 confirmed dates from March 30, 1962

that the amount of water to which such right is entitled and hereby confirmed, for the purposes
 aforesaid, is limited to an amount actually beneficially used for said purposes, and shall not exceed
 0.11 cubic foot per second

or its equivalent in case of rotation, measured at the point of diversion from the stream.
 The point of diversion is located in the SE $\frac{1}{4}$ NW $\frac{1}{4}$, as projected within Vandale DLC 70,
 Section 29, T. 6 S., R. 2 W., W. M. Well located 10 feet North and 20 feet West
 from the SE Corner, DLC 70. 140 South 50 East

The amount of water used for irrigation, together with the amount secured under any other
 right existing for the same lands, shall be limited to one-eightieth of one cubic foot per second
 per acre, or its equivalent for each acre irrigated and shall be further limited
 to a diversion of not to exceed $2\frac{1}{2}$ acre feet per acre for each acre irrigated
 during the irrigation season of each year;

and shall
 conform to such reasonable rotation system as may be ordered by the proper state officer.

A description of the place of use under the right hereby confirmed, and to which such right is
 appurtenant, is as follows:

0.3 acre SE $\frac{1}{4}$ NW $\frac{1}{4}$ as projected within Vandale DLC 70
 8.2 acres SE $\frac{1}{4}$ NW $\frac{1}{4}$ as projected within Lacerti DLC 71
 Section 29
 T. 6 S., R. 2 W., W. M.


This certificate is issued to confirm a change in Pt. of Dir. approved by an order
 of the State Engineer entered April 18, 1973, and supersedes certificate of water right
 heretofore issued to Lyle E. Klampe and recorded at page 34193, Volume 26,
 State Record of Water Right Certificates.

WITNESS the signature of the State Engineer, affixed
 this date. July 31, 1967

CHRIS. L. WHEELER
 State Engineer

Recorded in State Record of Water Right Certificates, Volume 26, page 34193

T.6S.,R.2W.,W.M.

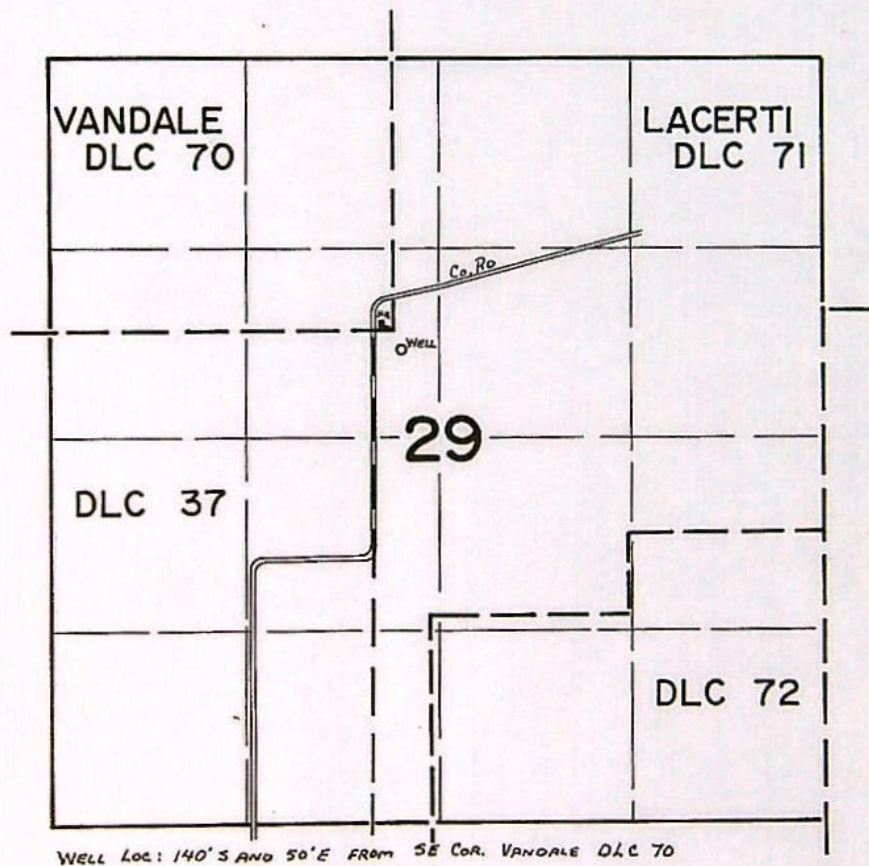

FINAL PROOF SURVEY
UNDER

Transfer No. 2766
Application No. _____ Permit No. _____
IN NAME OF
LYLE E. KLAMPE
Surveyed SEPT. 6 1974, by L. Toth

BEFORE THE STATE ENGINEER OF OREGON

Marion County

IN THE MATTER OF THE APPLICATION)
OF LYLE E. KLAMPE FOR THE APPROVAL)
OF A CHANGE IN POINT OF DIVERSION)
OF WATER FROM A WELL)
-----)

ORDER APPROVING
TRANSFER NO. 2766

On February 20, 1973, Lyle E. Klampe filed an application in the office of the State Engineer for the approval of a change in point of diversion of water from a well, pursuant to the provisions of ORS 540.510 to 540.530.

Certificate of water right issued to Lyle E. Klampe and recorded at page 34193, Volume 26, State Record of Water Right Certificates, confirms a right to the use of not to exceed 0.11 cubic foot per second of water from a well for the irrigation of 8.5 acres in SE¼ NW¼, Section 29, Township 6 South, Range 2 West, W.M., with a date of priority of March 30, 1962. These lands are irrigated from a well located 10 feet North, 20 feet West from the SE corner of DLC No. 70, being within the SE¼ NW¼, Section 29, Township 6 South, Range 2 West, W.M.

The applicant herein, owner of the lands above described, proposes to irrigate these lands from a well to be located 140 feet South and 20 feet West from the SE corner of DLC No. 70, being within the SE¼ NW¼, Section 29, Township 6 South, Range 2 West, W.M.

Notice by publication as provided by ORS 540.520 was not given in connection with this application for the reason said Section provides notice is not required on an application for a change in point of diversion of water of less than one-fourth mile where there are no intervening diversions.

Mr. Wm. B. McCall, Geologist for this department, has filed a report to the effect that the proposed change in point of diversion of water may be made without injury to existing rights if the new well will be developing water from the same ground water reservoir.

Mr. Mike Ricks, Watermaster of District No. 16, has filed a report to the effect that the proposed change in point of diversion of water may be made without injury to existing rights.

No objections having been filed and it appearing that the proposed change in point of diversion may be made without injury to existing rights, the application should be approved.

NOW, THEREFORE, it hereby is ORDERED that the change in point of diversion of water, to-wit:

From a well located 10 feet North and 20 feet West from the SE corner of DLC No. 70, being within the SE $\frac{1}{4}$ NW $\frac{1}{4}$ of Section 29, Township 6 South, Range 2 West, W.M.

To a well to be located 140 feet South and 20 feet West from the SE corner of DLC No. 70, being within the SE $\frac{1}{4}$ NW $\frac{1}{4}$ of Section 29, Township 6 South, Range 2 West, W.M.

for the irrigation of 8.5 acres in the SE $\frac{1}{4}$ NW $\frac{1}{4}$, Section 29, Township 6 South, Range 2 West, W.M., with a date of priority of March 30, 1962, is approved.

It is FURTHER ORDERED that the construction work shall be completed and the change in point of diversion of water made on or before October 1, 1973.

It is FURTHER ORDERED that the new well shall be so constructed that water will be withdrawn only from the ground water reservoir which supplied the old well.

It is FURTHER ORDERED that the quantity of water diverted at the new point of diversion shall not exceed the quantity of water

available at the old point of diversion and shall not exceed 0.11 cubic foot per second.

It is FURTHER ORDERED that the following provisions shall be effective when in the judgement of the watermaster it becomes necessary to install headgates and measuring devices.

That the diversion works shall include an in-line flow meter, a weir, or other suitable device for measuring the water to which the applicant is entitled.

That the type and plans of the measuring device be approved by the watermaster before the beginning of construction work and that the weir or measuring device be installed under the general supervision of said watermaster.

It is FURTHER ORDERED that certificate of water right heretofore issued to Lyle E. Klampe and recorded at page 34193, Volume 26, State Record of Water Right Certificates, is canceled, and upon receipt of proof satisfactory to the State Engineer of completion of the authorized change in point of diversion, a certificate of water right shall be issued to Lyle E. Klampe confirming the change in point of diversion.

Dated at Salem, Oregon, this 18th day of April, 1973.

/s/ CHRIS L. WHEELER
State Engineer