

2769

2769 Sno. Engr. & Hydr.
Cedar
Route 1, Box 1260 Hood

STATUS OF APPLICATION

Change in Place of Use
 Date filed MARCH 7, 1973
 Date of hearing _____
 Place of hearing _____
 Date of order May 31, 1973 Vol. 23, page 197
 Date for application of water October 1, 1973
 Proof mailed 11-17-78
 Proof received _____
 Certificate issued 11/29/78 Vol. 39, page 46952

Hood River Adjudication

11-28-78

~~3-29-78~~ T E S

DESCRIPTION OF WATER RIGHT

Name of stream East Fork of Hood River
 Trib. of _____ County of Hood River
 Use Irrigation
 Quantity of water _____ No. of acres 3^e
 Name of ditch _____
 Date of priority Nov. 25, 1895 + May 1, 1915
 In name of East Fork Irrigation District
Hood River Adjudication, Vol. 6, page 264
 App. No. _____ Per. No. _____ Cert. No. None issued
 Certificate cancelled _____
 Notation made on record by _____

FEES PAID

Date	Amount	Receipt No.
<u>3-7-73</u>	<u>20.00</u>	<u>32715</u>
TOTAL . . .		
	Cert. Fee	

FEES REFUNDED


Date	Amount	Check No.

REMARKS

TO BE ENTERED WHERE CHECKED	INDEX CARDS:	
	Entered	Checked
<input checked="" type="checkbox"/> Name	<input checked="" type="checkbox"/>	<input type="checkbox"/>
<input type="checkbox"/> Section	<input type="checkbox"/>	<input type="checkbox"/>
<input type="checkbox"/> Pl. or Div.	<input type="checkbox"/>	<input type="checkbox"/>
<input checked="" type="checkbox"/> Calendar	<input checked="" type="checkbox"/>	<input type="checkbox"/>
CHECKED TO RECORDS:		
<input checked="" type="checkbox"/> Twp. & Rge.	<input checked="" type="checkbox"/>	<input type="checkbox"/>
<input checked="" type="checkbox"/> Decree Grant	<input checked="" type="checkbox"/>	<input type="checkbox"/>
<input checked="" type="checkbox"/> Decree Sale	<input checked="" type="checkbox"/>	<input type="checkbox"/>
<input checked="" type="checkbox"/> Cert. of W/R	<input checked="" type="checkbox"/>	<input type="checkbox"/>
<input type="checkbox"/> Per. Folder	<input type="checkbox"/>	<input type="checkbox"/>
<input type="checkbox"/> Chainindex	<input type="checkbox"/>	<input type="checkbox"/>
<input type="checkbox"/> Cross Ref.	<input type="checkbox"/>	<input type="checkbox"/>
<input type="checkbox"/> Power Claim	<input type="checkbox"/>	<input type="checkbox"/>
<input type="checkbox"/> Abstracts	<input type="checkbox"/>	<input type="checkbox"/>

6627

T.2N., R.10E., W.M.

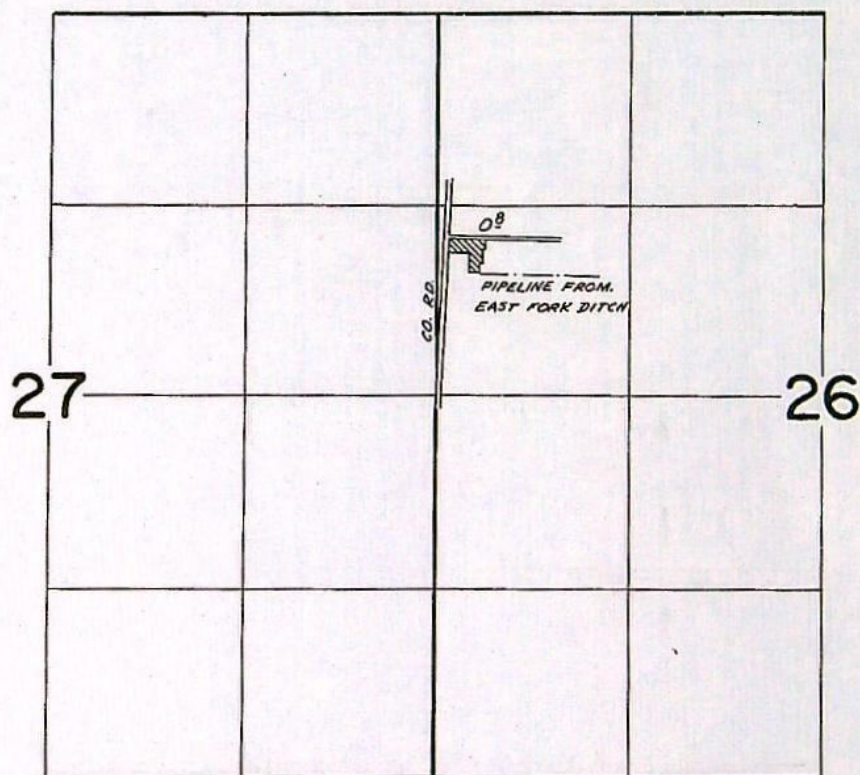

DIV. PT. LOC: 3750'S & 430'E FROM NW COR SEC. 4, T.1S., R.10E.

FINAL PROOF SURVEY
UNDER

Transfer No. 2769

Application No. _____ Permit No. _____
IN NAME OF

CLIFFORD L. WHITTEN

Surveyed April 16 1975, by D. Norby

BEFORE THE STATE ENGINEER OF OREGON

Hood River County

IN THE MATTER OF THE APPLICATION)
OF SHO ENDOW, JR. AND AYA ENDOW)
FOR THE APPROVAL OF A CHANGE IN)
PLACE OF USE OF WATER FROM EAST)
FORK HOOD RIVER)

ORDER APPROVING
TRANSFER NO. 2769

On March 7, 1973, Sho Endow, Jr. and Aya Endow filed an application in the office of the State Engineer for the approval of a change in place of use of water from East Fork Hood River, pursuant to the provisions of ORS 540.510 to 540.530.

By Decree of the Circuit Court for Hood River, County, Oregon, entered October 24, 1921, In the Matter of the Determination of the Relative Rights to the Use of the Waters of Hood River and its Tributaries, an ^{vested} inchoate water right was established in the name of East Fork Irrigation District for the use of the waters of East Fork Hood River for the irrigation of, among other lands, 3.0 acres in NE¼ SE¼, Section 3, Township 1 North, Range 10 East, W.M., with a date of priority of November 25, 1895 and May 1, 1915. These lands are irrigated by means of the East Fork Irrigation District ditch.

The applicants herein, owners of the lands above described, propose to transfer the water right therefrom, without loss of priority to 3.0 acres in SW¼ NW¼, Section 26, Township 2 North, Range 10 East, W.M.

Notice by publication as provided by ORS 540.520 was not given in connection with this application for the reason that said section provides notice is not required on an application for a change in place of use of water.

The lands involved herein are within the boundaries of the

East Fork Irrigation District and the Board of Directors of said District approved the proposed change in place of use at a regular meeting held March 13, 1973.

No objections having been filed and it appearing that the proposed change in place of use of water may be made without injury to existing rights, the application should be approved.

NOW, THEREFORE, it hereby is ORDERED that the proposed change in place of use of water is approved and the water right hereinbefore described as appurtenant to 3.0 acres in NE $\frac{1}{4}$ SE $\frac{1}{4}$, Section 3, Township 1 North, Range 10 East, W.M., with dates of priority of November 25, 1895 and May 1, 1915, be severed therefrom and simultaneously and without loss of priority transferred to 3.0 acres in SW $\frac{1}{4}$ NW $\frac{1}{4}$, Section 26, Township 2 North, Range 10 East, W.M.

It is FURTHER ORDERED that said water so transferred shall be applied to beneficial use on or before October 1, 1973.

It is FURTHER ORDERED that upon receipt of proof satisfactory to the State Engineer of complete application of water to beneficial use on the lands to which the water is transferred hereby, a certificate of water right shall be issued to the East Fork Irrigation District confirming this and prior changes within the District at the time certificates are issued in the Hood River Adjudication proceedings.

Dated at Salem, Oregon, this 31st day of May, 1973.

/s/ CHRIS L. WHEELER
State Engineer