

2488 G.R. & W.M. Hallin
(COT)
Bend Ore. 97701

2488

STATUS OF APPLICATION

Change in Place of Use
 Date filed February 17, 1971
 Date of hearing _____
 Place of hearing _____
 Date of order 6-10-71 Vol. 21, page 123
 Date for application of water 10-1-72
 Proof mailed _____
 Proof received _____
 Certificate issued _____ Vol. _____, page _____

DESCRIPTION OF WATER RIGHT

Name of stream Deschutes River
 Trib. of - County of Deschutes
 Use Irrigation
 Quantity of water - No. of acres 10
 Name of ditch Central Oregon Canal
 Date of priority 10-31-00 & 12-4-02
 In name of Harold E Smith
Deschutes Riv. Adjudication, Vol. 16, page 60
 App. No. _____ Per. No. _____ Cert. No. 29052
 Certificate cancelled _____
 Notation made on record by slw

FEES PAID

Date	Amount	Receipt No.
<u>2-17-71</u>	<u>20.00</u>	<u>22697</u>
TOTAL . . .		
	\$1 Cert. Fee	

FEES REFUNDED

Date	Amount	Check No.

REMARKS

TO BE ENTERED WHERE CHECKED	INDEX CARDS:	
	Entered	Checked
<input checked="" type="checkbox"/> Name	<u>slw</u>	_____
<input checked="" type="checkbox"/> Stream	<u>slw</u>	_____
<input checked="" type="checkbox"/> Pt. of Div.	<u>slw</u>	_____
<input checked="" type="checkbox"/> Calendar	<u>slw</u>	_____
CHECKED TO RECORDS:		
<input checked="" type="checkbox"/> Twp. & Rge.	<u>slw</u>	_____
<input checked="" type="checkbox"/> Decree-vault	<u>slw</u>	_____
<input checked="" type="checkbox"/> Decree-safe	<u>slw</u>	_____
<input checked="" type="checkbox"/> Cert. of W/R	<u>slw</u>	_____
<input type="checkbox"/> Per. Folder	_____	_____
<input type="checkbox"/> Chainindex	_____	_____
<input type="checkbox"/> Cross Ref.	_____	_____
<input type="checkbox"/> Power Claim	_____	_____
<input type="checkbox"/> Abstracts	_____	_____

SECTION


TOWNSHIP 175, RANGE 13E, W. M.

RECEIVED

MAY 18 1971

STATE ENGINEER
SALEM, OREGON

North

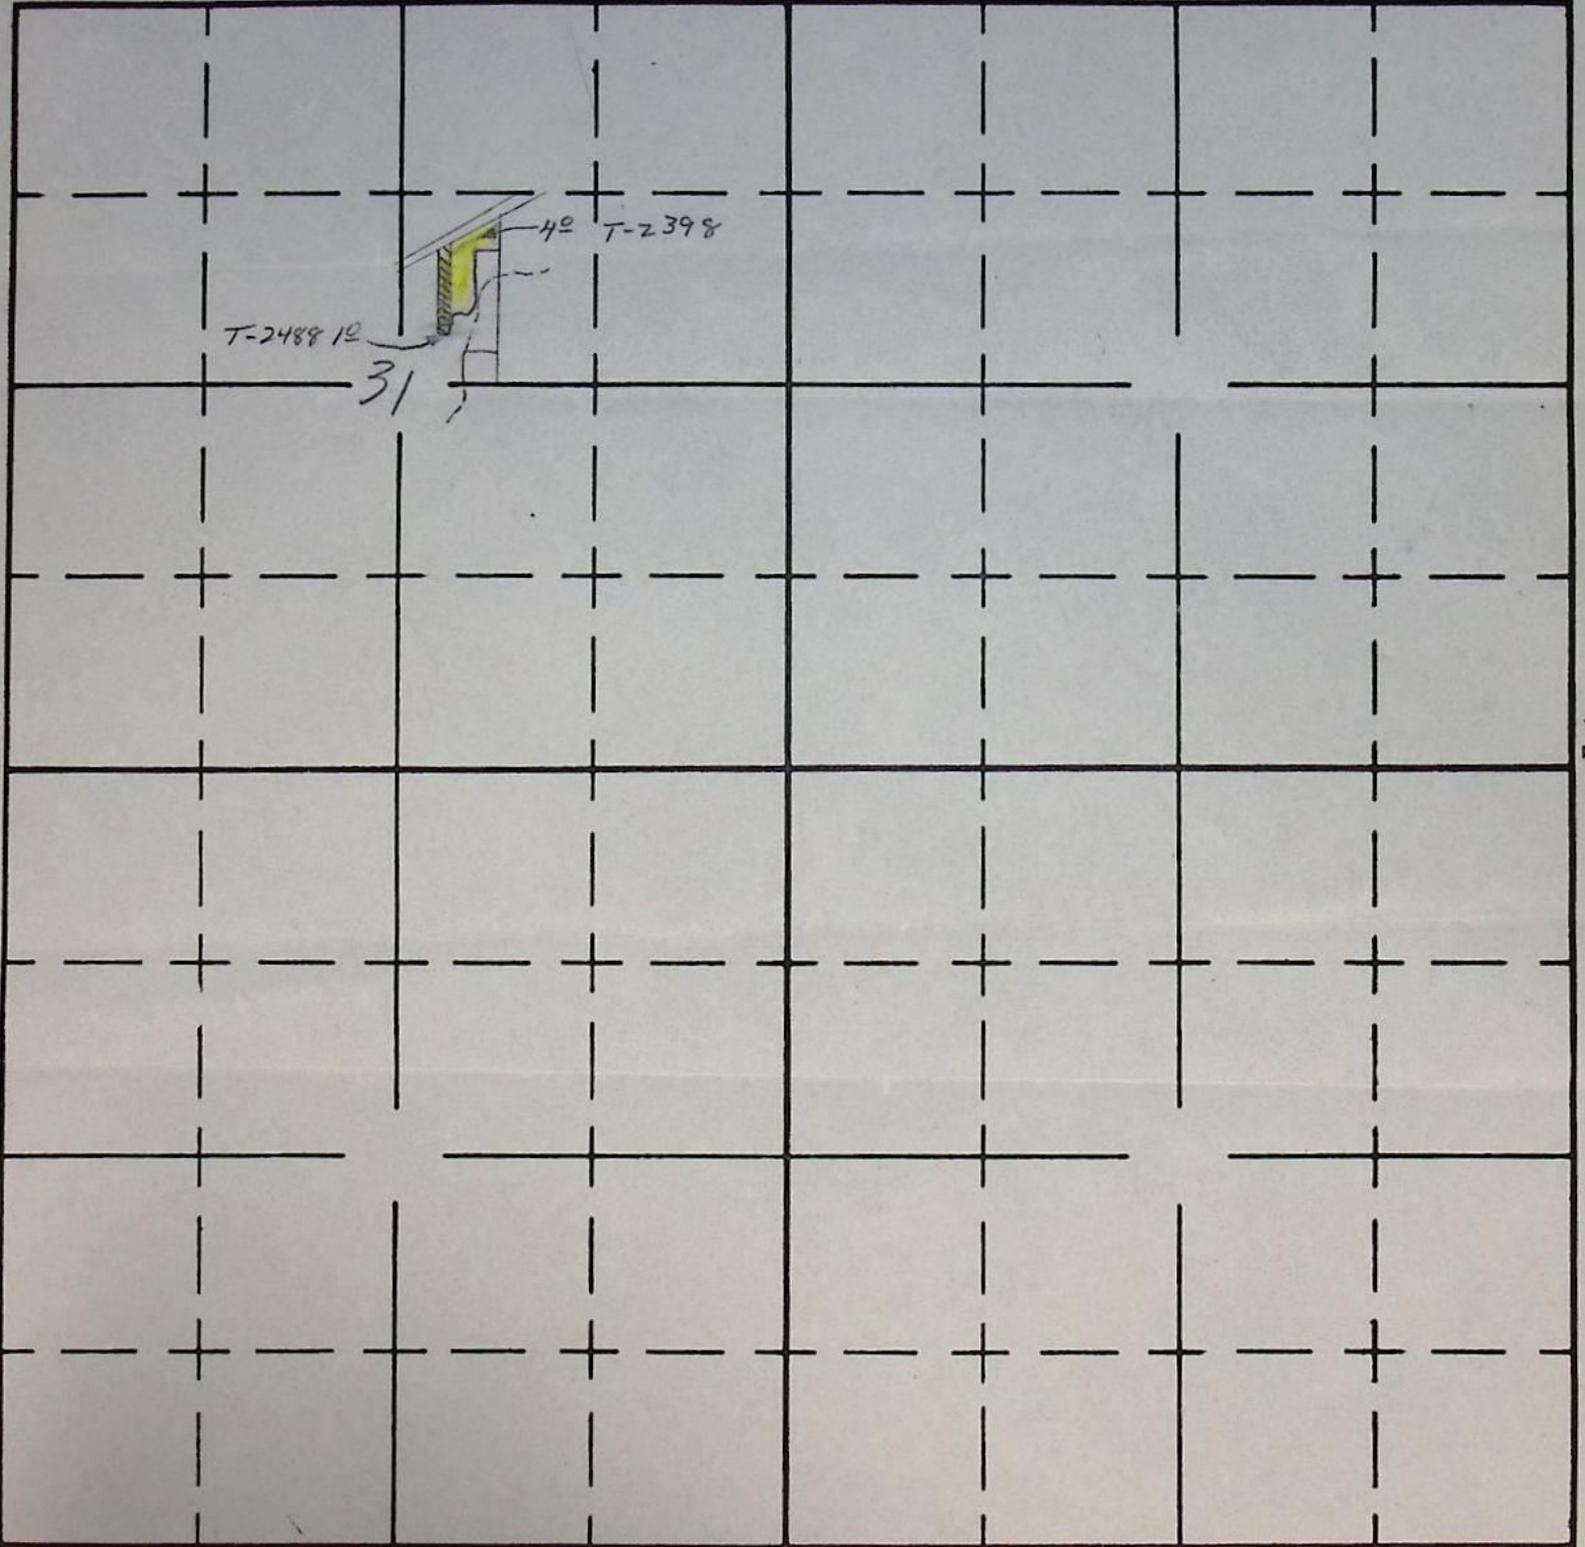

West

East

South

APPLICATION No.

PERMIT No.

BEFORE THE STATE ENGINEER OF OREGON

Deschutes County

IN THE MATTER OF THE APPLICATION)
OF GORDON R. AND WILMA M. HALLIN)
(CENTRAL OREGON IRRIGATION DIS-)
TRICT) FOR THE APPROVAL OF A)
CHANGE IN PLACE OF USE OF WATER)
FROM DESCHUTES RIVER)

ORDER APPROVING
TRANSFER NO. 2488

On February 17, 1971, Gordon R. and Wilma M. Hallen filed an application in the office of the State Engineer for the approval of a change in place of use of water from Deschutes River, pursuant to the provisions of ORS 540.510 to 540.530.

By Decree of the Circuit Court for Deschutes County, Oregon, entered September 30, 1958, In the Matter of the Determination of the Relative Rights to the Use of the Waters of the Deschutes River and its Tributaries, a water right was established in the name of Central Oregon Irrigation District for the use of the waters of Deschutes River for the irrigation of, among other lands, 1.0 acre in SW¼ NE¼, Section 31, Township 17 South, Range 13 East, W.M., with dates of priority of October 31, 1900, and December 2, 1907, being tabulated in the name of Harold E. Smith as evidenced by certificate of water right recorded at page 29052, Volume 21, State Record of Water Right Certificates. These lands also have a supplemental right under permit No. 23256 to the use of the water stored in Crane Prairie Reservoir with a date of priority of February 28, 1913.

The applicants herein, contract purchasers of the lands above described, propose to transfer the water right therefrom, without loss of priority, to 1.0 acre in SW¼ NE¼, being southeasterly of the canal, Section 31, Township 17 South, Range 13 East, W.M.

Notice by publication as provided by ORS 540.520 was not

given in connection with this application for the reason that said section provides notice is not required on an application for a change in place of use of water.

The lands involved herein are within the boundaries of the Central Oregon Irrigation District and the Board of Directors of said District approved the proposed change in place of use of water.

Kieth Ramsay, Sr., contract seller of the lands involved, has submitted written approval of the change in place of use of water.

No objections having been filed and it appearing that the proposed change in place of use of water may be made without injury to existing rights, the application should be approved.

NOW, THEREFORE, it hereby is ORDERED that the proposed change in place of use of water is approved and the water right hereinbefore described as appurtenant to 1.0 acre in SW $\frac{1}{4}$ NE $\frac{1}{4}$, being northwesterly of the canal, Section 31, Township 17 South, Range 13 East, W.M., with dates of priority of October 31, 1900, and December 2, 1907, be severed therefrom and simultaneously and without loss of priority transferred to 1.0 acre in SW $\frac{1}{4}$ NE $\frac{1}{4}$, being southeasterly of the canal, Section 31, Township 17 South, Range 13 East, W.M.

It is FURTHER ORDERED that said water so transferred shall be applied to beneficial use on or before October 1, 1972.

It is FURTHER ORDERED that upon receipt of proof satisfactory to the State Engineer of complete application of water to beneficial use on the lands to which the water is transferred hereby, certificate of water right shall be issued to Central Oregon Irrigation District at the time certificate is issued to the District confirming other transfers within the District.

Dated at Salem, Oregon, this 10th day of June, 1971.

/s/ CHRIS L. WHEELER
State Engineer

RECEIVED
MAY 18 1971
STATE ENGINEER
SALEM, OREGON

RECEIVED
FEB 17 1971
STATE ENGINEER
SALEM, OREGON

Dec. 30, 1970


COI Irrigation District
Redmond, Oregon

Dear Sirs:

It is OK with me as title holder on the SW $\frac{1}{4}$ of the NE $\frac{1}{4}$ of Section 31, TWP 17, Range 13 EWM for Mr. & Mrs. Gordon Hallin to transfer one acre of water from its present use location to another in the same above described property.

Yours truly,

Kieth Ramsay
Kieth Ramsay Sr.
1609 Ramsay Rd.
Bend, Oregon

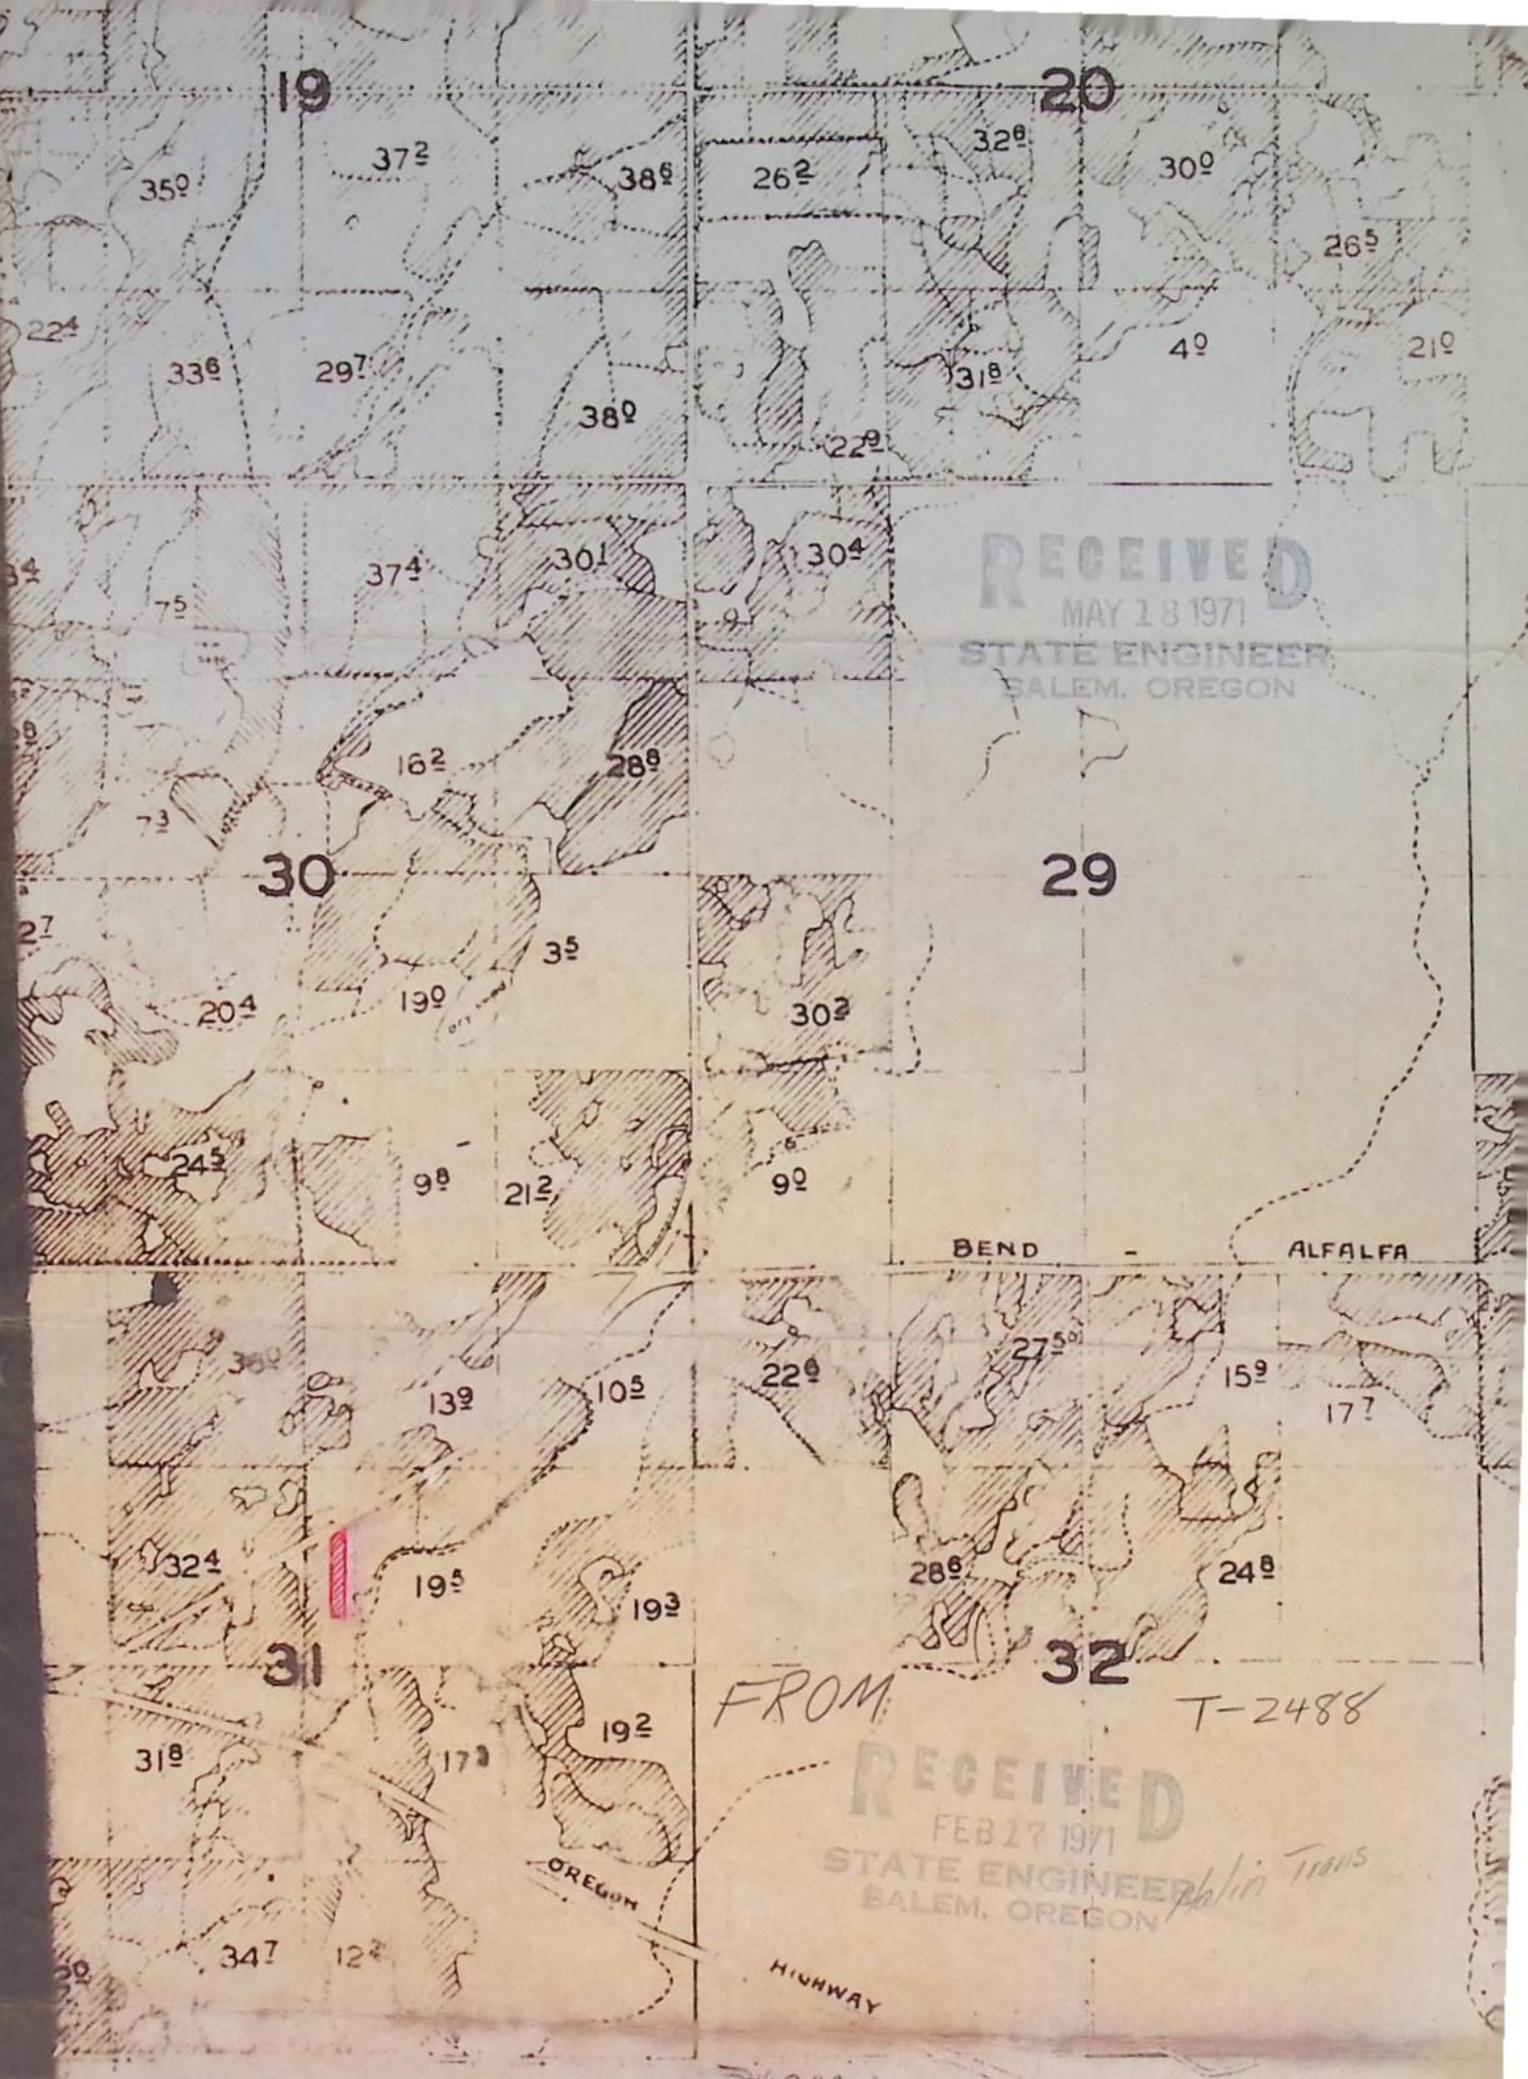

RECEIVED
MAY 18 1971
STATE ENGINEER
SALEM, OREGON

BEND - ALFALFA

FROM


T-2488

RECEIVED
FEB 17 1971
STATE ENGINEER
SALEM, OREGON

Palin Trans

HIGHWAY

Palin

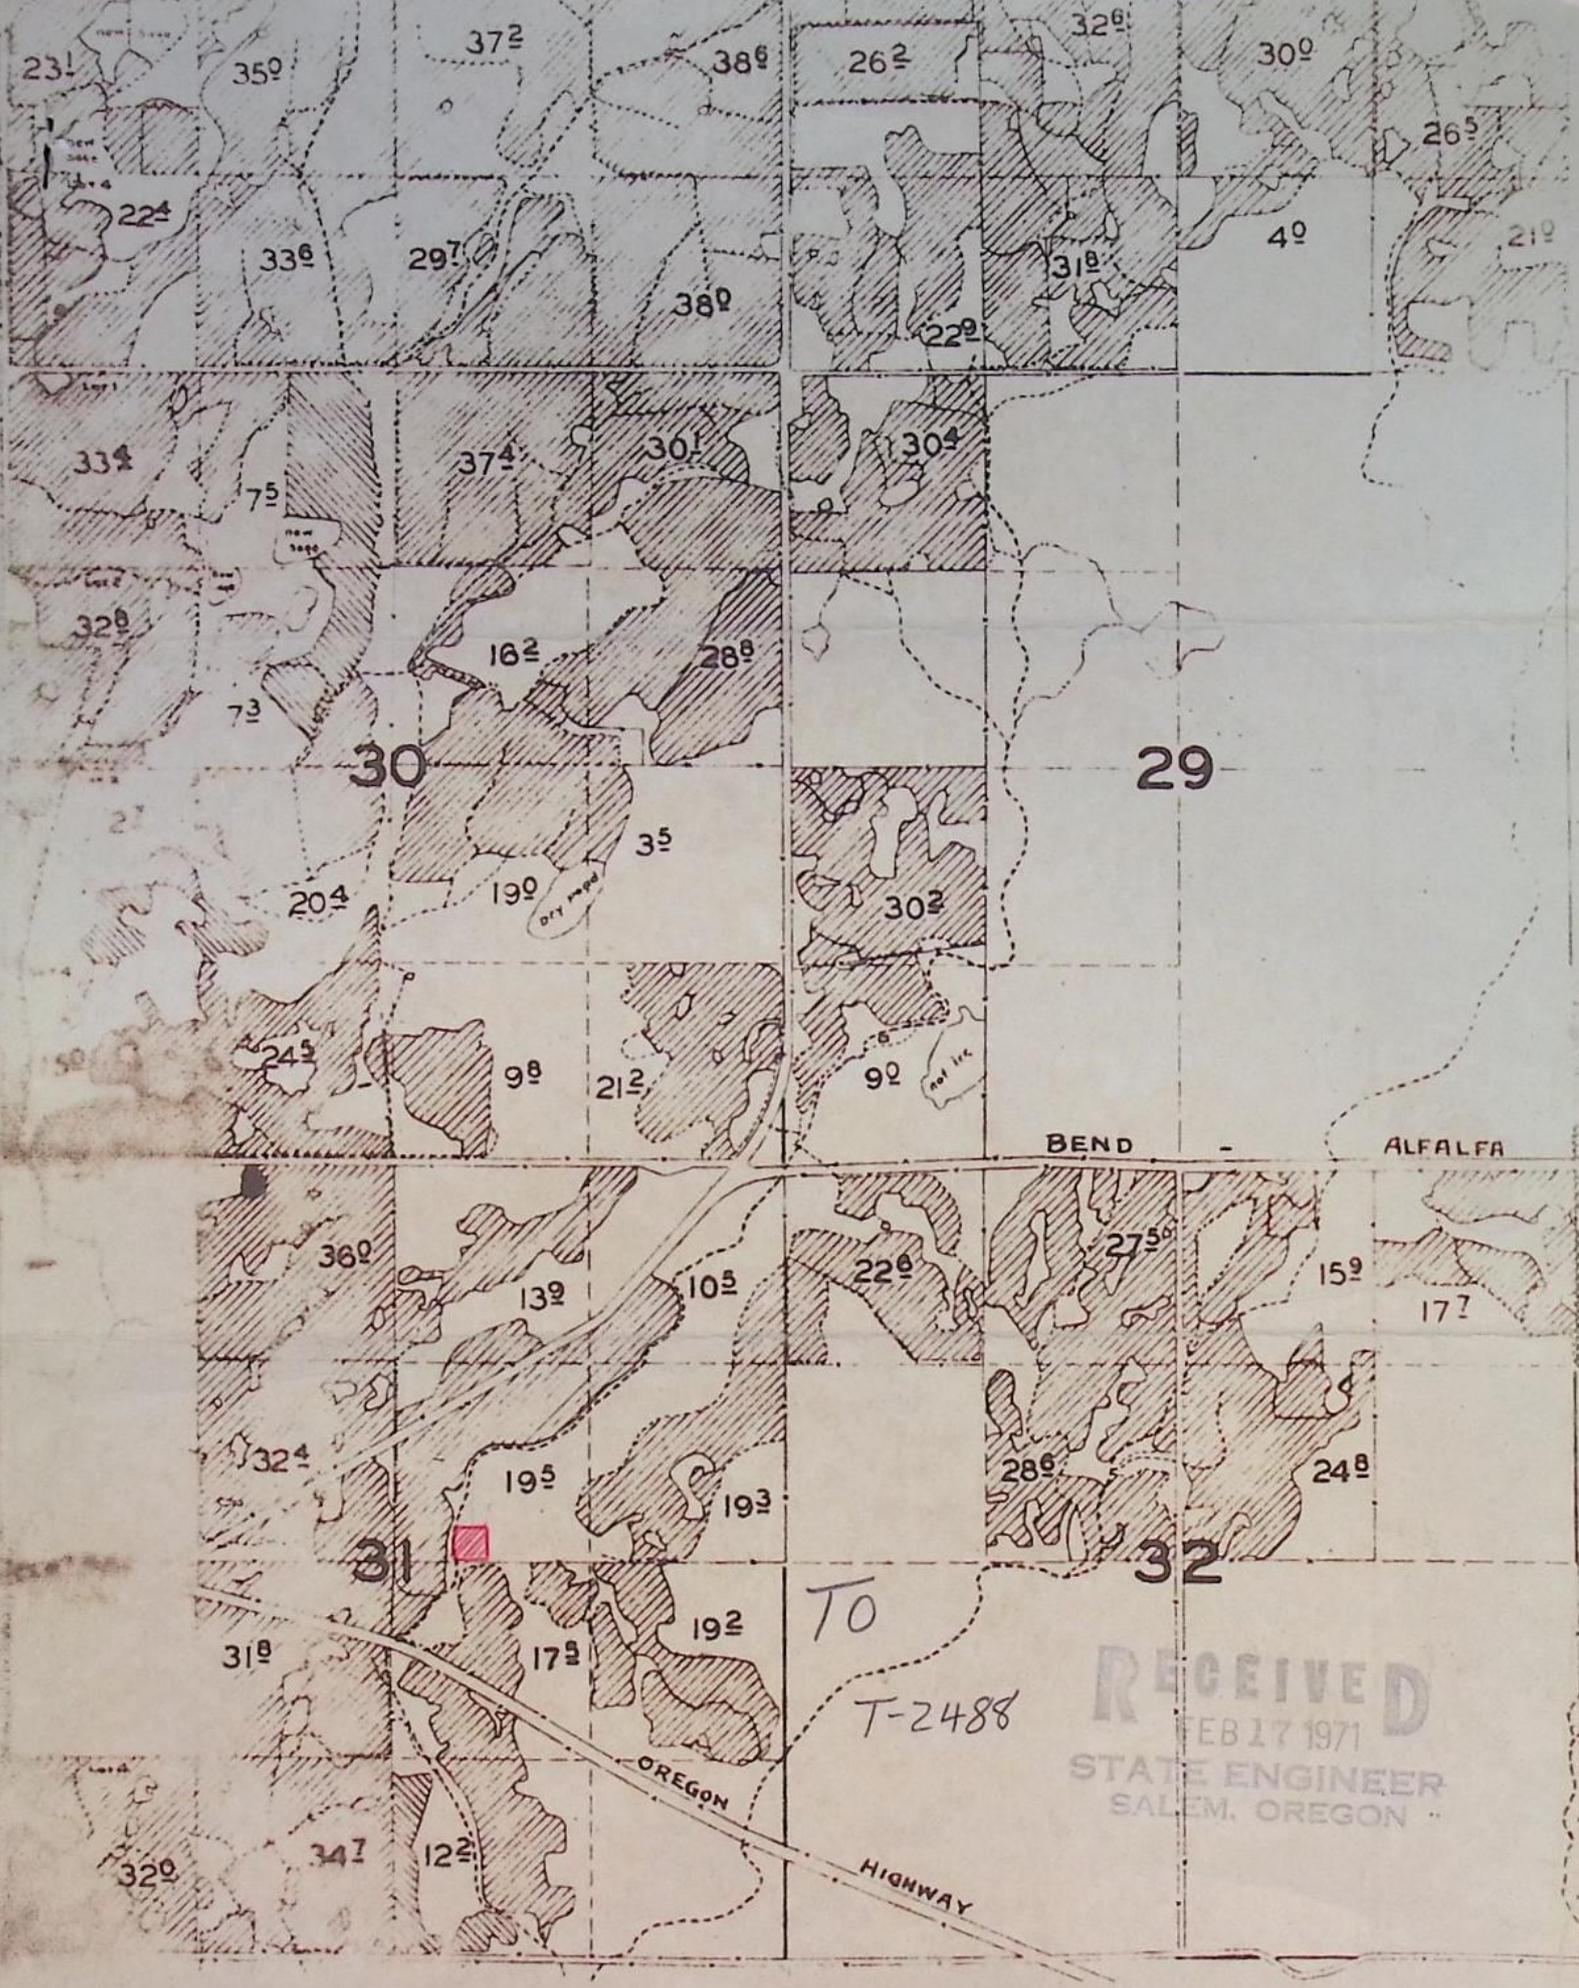

To
T-2488

RECEIVED
FEB 17 1971
STATE ENGINEER
SALEM, OREGON

RECEIVED
 FEB 17 1971
 STATE ENGINEER
 SALEM, OREGON

RECEIVED
 MAY 18 1971
 STATE ENGINEER
 SALEM, OREGON

Application for Transfer of Water Right

To the STATE ENGINEER OF OREGON:

I, Gordon R. Hallin, Wilma M. Hallin
(Name of applicant)

of Bend, County of Deschutes
(Postoffice)

State of Oregon, do hereby make application for change

place of use
(In point of diversion; place of use; use heretofore made of the water)

1. The source of present water right is Daschutes River
(Name of stream)
2. The use to which the water is applied is irrigation
(Irrigation; Mining; Power; Manufacturing; etc.)
3. The name of the ditch, canal or pipe line is Central Oregon Canal
4. The point of diversion is located _____ ft. _____ and _____ ft. _____ from the _____
(N. or S.) (E. or W.)

corner of _____ being within the _____
(Section or subdivision)

of Section _____ Tp. _____ R. _____ W. M., in the County of _____
(No. N. or S.) (No. E. or W.)

5. List the number of acres irrigated in each smallest legal subdivision (40-acre tract) involved in this transfer. If for any other use, indicate place of use.

Twp.	Range	Sec.	NE 1-4				NW 1-4				SW 1-4				SE 1-4			
			NE $\frac{1}{4}$	NW $\frac{1}{4}$	SW $\frac{1}{4}$	SE $\frac{1}{4}$	NE $\frac{1}{4}$	NW $\frac{1}{4}$	SW $\frac{1}{4}$	SE $\frac{1}{4}$	NE $\frac{1}{4}$	NW $\frac{1}{4}$	SW $\frac{1}{4}$	SE $\frac{1}{4}$	NE $\frac{1}{4}$	NW $\frac{1}{4}$	SW $\frac{1}{4}$	SE $\frac{1}{4}$
17	13	31			1													
			<u>(Northwesterly of canal)</u>															

NOTE: If you own less than 40-acre tracts, attach a description of your land as it appears in your deed.
 (Attach separate sheet if necessary)

6. Are you the legal owner of the above described lands? Contract purchaser
(If not owner, explain your interest)

7. Has water been used beneficially for the purposes indicated herein during the past 5 years? Yes

8. What is the date of priority of your water right? Oct. 31, 1900 & Dec. 4, 1907

9. Was your water right acquired by State Engineer's Permit? No If so, give number
(Yes or No)

of permit _____

10. Do you hold a water right certificate? No If so, give number of certificate 29052
(Yes or No)

11. Was your water right determined by State Engineer's order of Determination or Decree of Court?

Yes If so, give title of proceedings Adjudication of Deschutes River
(Yes or No)

12. Is the water right recorded in your name? Harold E. Smith - page 60 of decree
(If not, give name)

13. I propose to transfer the water right to the following described lands: (Do not answer if your application is for change in point of diversion only.)

Twp.	Range	Sec.	NE 1-4				NW 1-4				SW 1-4				SE 1-4			
			NE $\frac{1}{4}$	NW $\frac{1}{4}$	SW $\frac{1}{4}$	SE $\frac{1}{4}$	NE $\frac{1}{4}$	NW $\frac{1}{4}$	SW $\frac{1}{4}$	SE $\frac{1}{4}$	NE $\frac{1}{4}$	NW $\frac{1}{4}$	SW $\frac{1}{4}$	SE $\frac{1}{4}$	NE $\frac{1}{4}$	NW $\frac{1}{4}$	SW $\frac{1}{4}$	SE $\frac{1}{4}$
17	13	31			1													
			(Southeasterly of canal)															

(Attach separate sheet if necessary)

NOTE: Answer questions 14, 15, 16 and 17, if the application is for change in point of diversion.

14. The proposed point of diversion is located ft. and ft. from the
(N. or S.) (E. or W.)
 corner of being within the of Section Tp. R. W. M.,
(Smallest legal subdivision) (No. N. or S.) (No. E. or W.)
 in the county of The name of the ditch to be used is

15. Are you the owner of the land on which the proposed point of diversion is to be located?

16. If not the owner of the land on which the proposed point of diversion is to be located, give the name and address of owner and submit evidence of your right-of-way for your proposed ditch, canal, or pipe line.

17. Are there any diversions between your present point of diversion and the proposed point of diversion?

NOTE: Answer questions 18 and 19 if application is for change in use or place of use.

18. Are the lands from which you propose to transfer your water right free of all encumbrances, including taxes, mortgages, liens, etc.? No
(Answer Yes or No)

19. If not, give below a description of existing encumbrances:

NATURE OF ENCUMBRANCE	HELD BY	AMOUNT
Title	K. Ramsey	Letter of permission attached.

20. Reasons for the proposed changes are More beneficial use

AFFIDAVIT OF APPLICANT

STATE OF OREGON,

County of Deschutes.....

} ss.

I, Wilma Hallin, the applicant herein, being first duly sworn, depose and say that I have read the above and foregoing application for transfer of water right; that I know the contents thereof and that the statements therein made are true and correct to the best of my knowledge and belief.

In Witness Whereof, I have hereunto set my hand this 16th day of December, 1970.

Gordon R. Hallin

Gordon R. Hallin
Wilma M. Hallin
(Name of applicant)

Subscribed and sworn to before me this 16th day of December, 1970.

[Notarial Seal]

Peggy J. Mice
NOTARY PUBLIC FOR OREGON

My commission expires May 3, 1974

Remarks

THIS APPLICATION MUST BE ACCOMPANIED BY A MAP SHOWING THE LOCATION OF THE POINT OF DIVERSION, PLACE OF USE AND WORKS UTILIZED UNDER THE PRESENT WATER RIGHT. THE MAP SHOULD ALSO SHOW THE NEW POINT OF DIVERSION OR PLACE OF USE, AS THE CASE MAY BE.

STATE OF OREGON,

County of Deschutes } ss.

BE IT REMEMBERED, That on this 9th day of February, 1971, before me, the undersigned, a Notary Public in and for said County and State, personally appeared the within named Gordon R. Hallin

known to me to be the identical individual described in and who executed the within instrument and acknowledged to me that he executed the same freely and voluntarily.

IN TESTIMONY WHEREOF, I have hereunto set my hand and affixed my official seal the day and year last above written.

Telma M. Gandy

Notary Public for Oregon.

My Commission expires Feb. 3, 1975

